

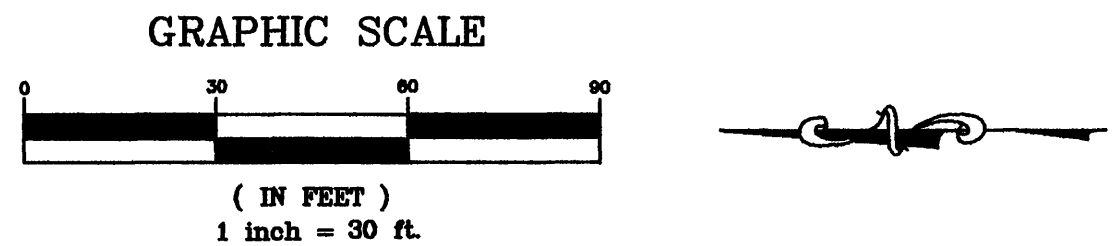


1:\Draw\WVA\12307.01\Drawings\AS-BUILTS\C108.dwg, 3/4/22, 2008:12:22 1:47:57 PM, cldg

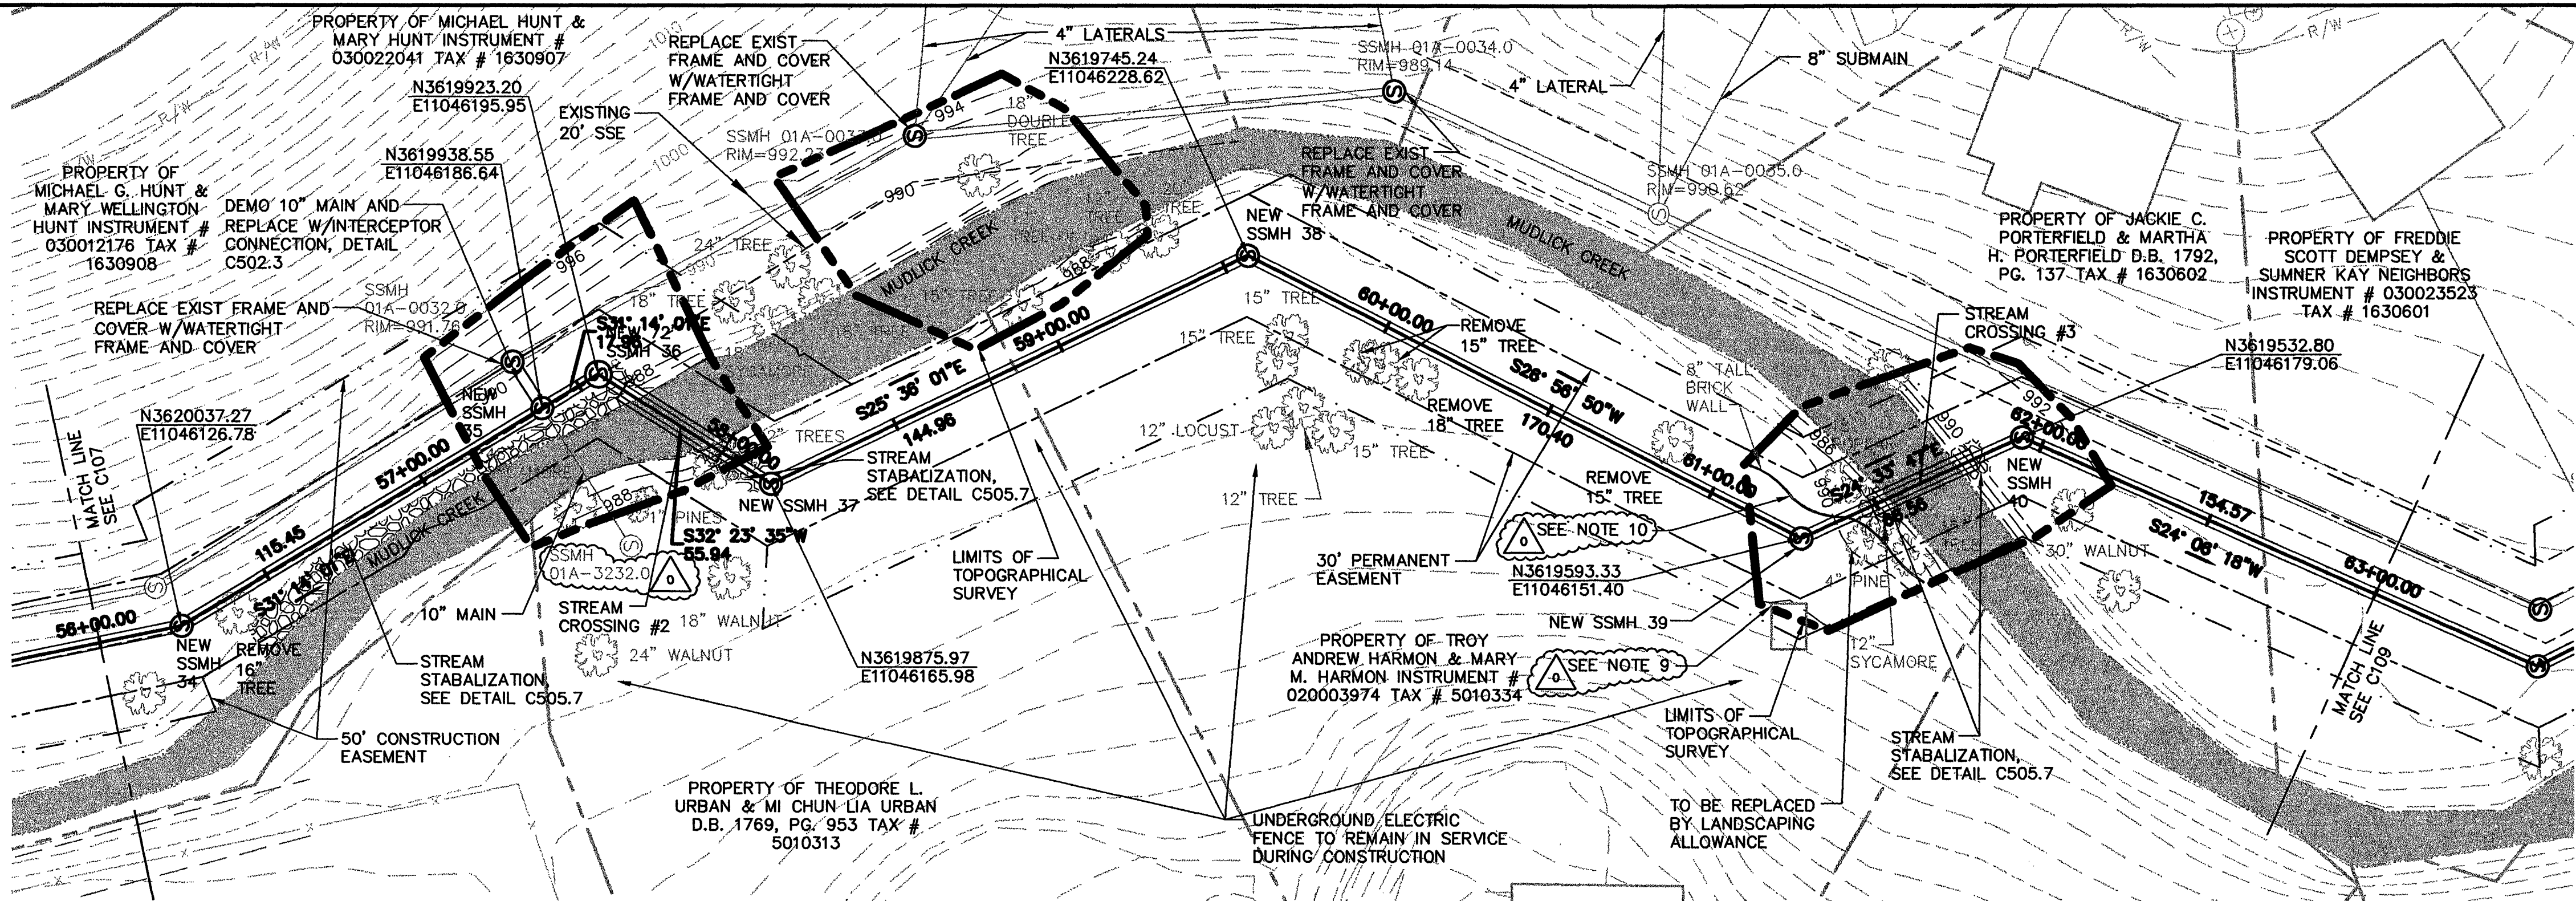

- NOTES:
1. SURVEY PROVIDED BY CALDWELL WHITE AND ASSOCIATES.
 2. BASE MAPPING BASED UPON AERIAL MAPPING PROVIDED BY ROANOKE COUNTY AND CITY OF ROANOKE.
 3. CONTRACTOR SHALL FIELD VERIFY SIZE & INVERT OF ALL LATERALS, SUBMAINS, & MAINS AND PROVIDE INFORMATION AS PART OF SHOP DRAWING SUBMITTAL.
 4. LATERALS IN POOR CONDITION AS IDENTIFIED BY THE AUTHORITY CONNECTING TO THE EXISTING INTERCEPTOR SHALL BE REPLACED TO THE PERMANENT EASEMENT. PAYMENT SHALL BE IN ACCORDANCE WITH SPECIFICATION 01026. SEWER SERVICE LATERALS SHALL BE REPLACED TO THE PERMANENT EASEMENT BOUNDARY. CONTRACTOR SHALL CONFIRM SIZE AND LOCATION AND REPLACE W/IDENTICAL SIZE.
 5. ALL LATERALS TO HAVE A CLEANOUT INSTALLED AT THE PROPERTY LINE AS SHOWN IN DETAIL C503.5/TYP.
 6. CONTRACTOR SHALL REMOVE ONLY THOSE TREES REQUIRED FOR SEWER INTERCEPTOR CONSTRUCTION. ALL TREES WITHIN THE EASEMENT 12" AND LARGER SHALL BE PROTECTED IN ACCORDANCE WITH DETAIL C505.5. ONLY THOSE TREES NOTED ON THE DRAWINGS SHALL BE REMOVED IF REQUIRED. ALL COSTS FOR TREE REMOVAL, DISPOSAL & PROTECTION SHALL BE INCLUDED IN THE COST FOR SEWER LINE INSTALLATION.
 7. EXIST LATERALS, SUBMAINS, & MAINS HAVE BEEN IDENTIFIED BY MANHOLE INSPECTIONS PERFORMED BY OI AND FIELD INVESTIGATION BY THE AUTHORITY'S SSER GROUP. ALL ACTIVE SEWER LATERALS SHALL REMAIN IN SERVICE AND BE RECONNECTED BY THE CONTRACTOR.
 8. LIMITS OF CLEARING & GRADING ARE LIMITED TO WITHIN THE PERMANENT EASEMENT.
 9. CONTRACTOR SHALL PROTECT OR REMOVE AND REPLACE EXIST STORAGE SHED AS NECESSARY. COORDINATE UTILITY CONNECTIONS TO SHED IF REQUIRED.
 10. BRICK WALL TO BE DEMOLISHED WITHOUT REPLACEMENT.
 11. THE PROPOSED LINE FROM STATION 58+00 TO STATION 61+50 RUNS IN CLOSE PROXIMITY TO AN EXISTING 8" COLLECTOR LINE. THIS COLLECTOR DISCHARGES INTO MANHOLE 01A-3232.0 FROM THE SOUTH AND SERVES THREE PARCELS. IF ENCOUNTERED, REDIRECT AS FOLLOWS: LATERAL FROM PARCEL #5010334 TO PROPOSED MANHOLE 37, LATERAL FROM PARCEL #5010334 TO PROPOSED MANHOLE 38, AND REDIRECT EXISTING LINE TO PROPOSED MANHOLE 39. NEW LATERALS SHALL BE PAID IN ACCORDANCE WITH BID ITEM NOS. 28 AND 29.

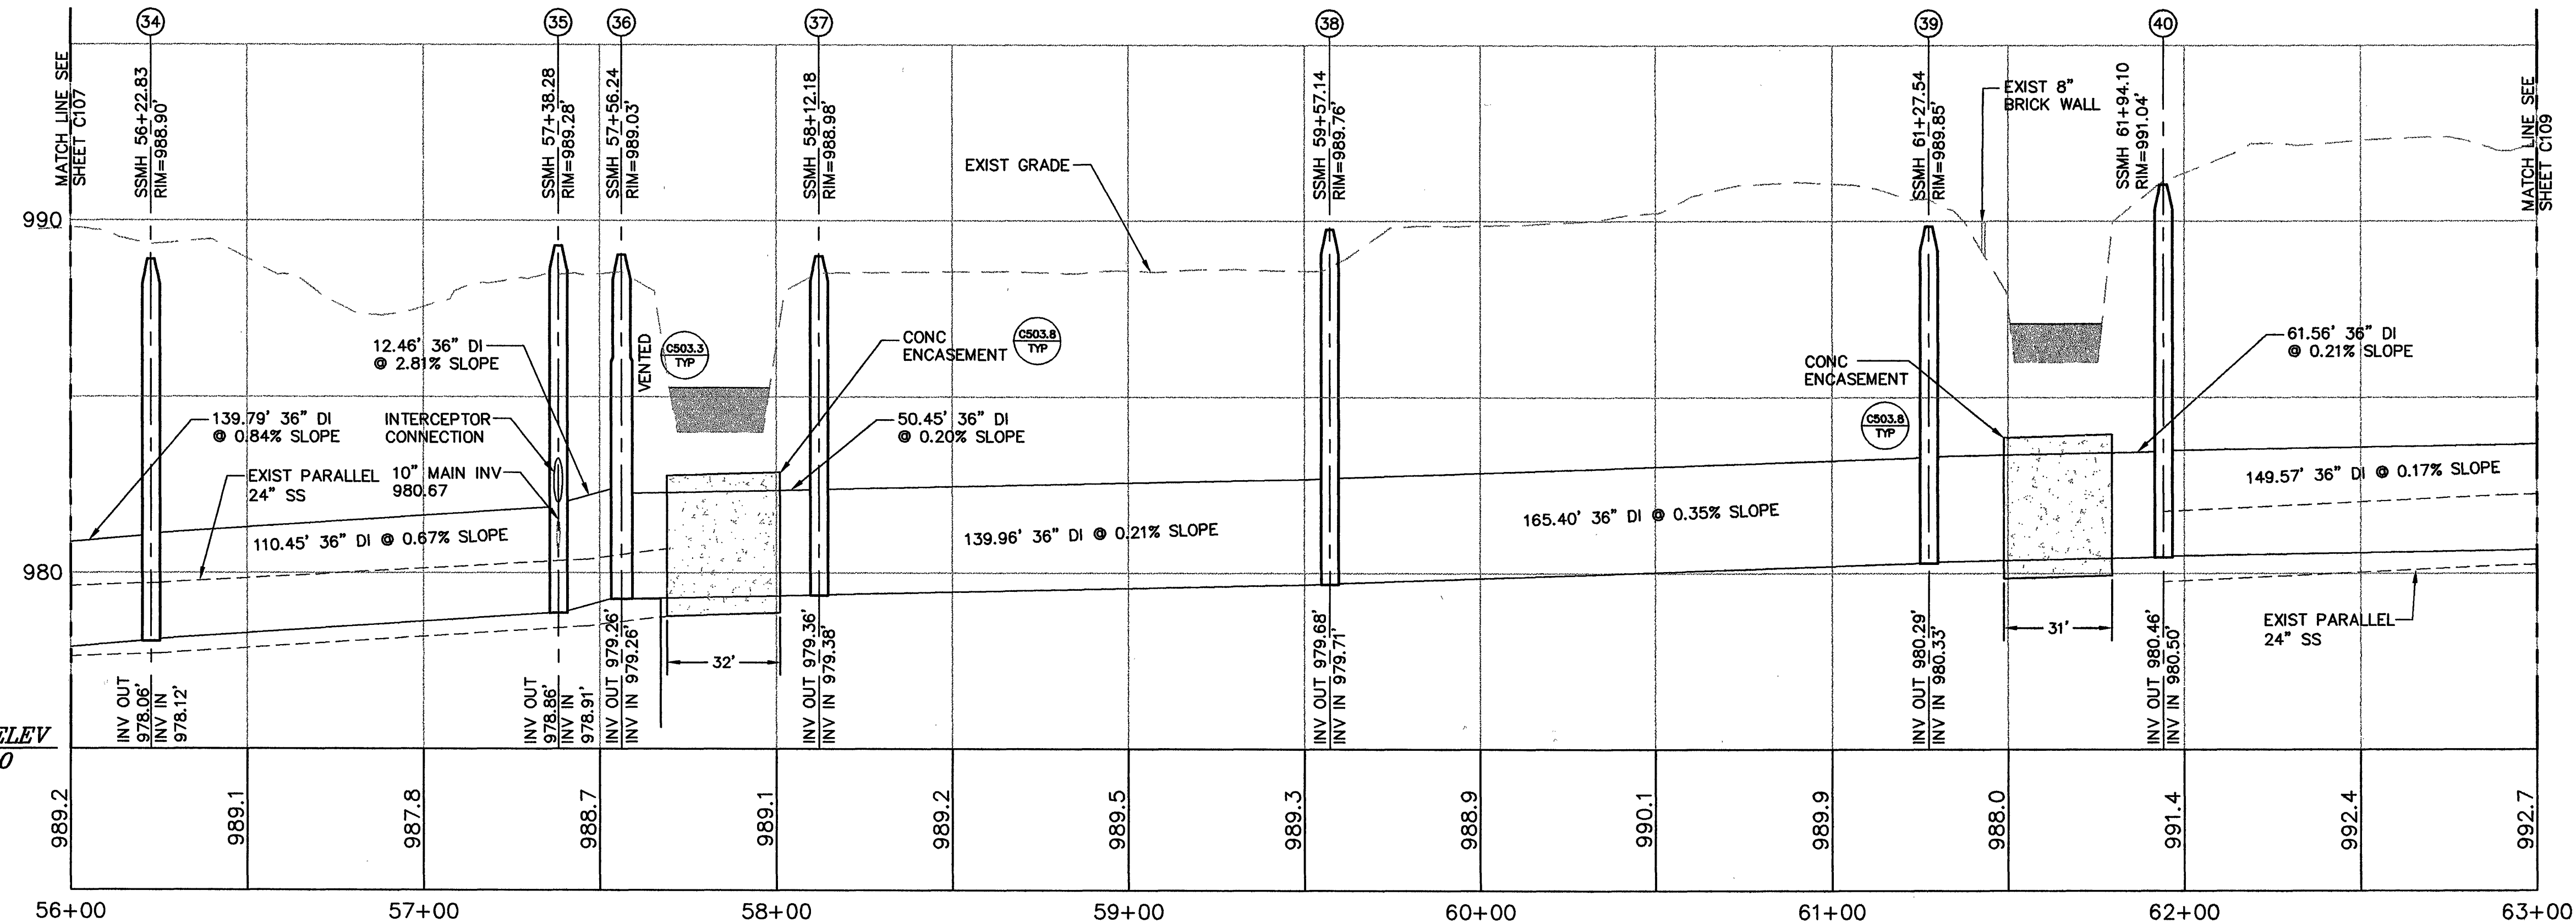

VERIFY SCALE

Bar Scale measures 1" on original drawing

0" 1"

WESTERN VIRGINIA WATER AUTHORITY

MUDDLICK CREEK INTERCEPTOR

PLAN

STATION 56+00.00 THRU 63+00.00

Designed: BYP

Drawn: RJH

Checked: DBH

Date: FEB 2006

Scale: AS SHOWN

Job No. 12307.01

Archived File Name:

3

AS-BUILTS

1

FIELD ORDER NO. 2

0

AS-BID DOCUMENTS

Rev.

Date

Description

By

C108

COMMONWEALTH OF VIRGINIA

DOUGLAS B. HUDGINS

No. 034694

9/18/06

PROFESSIONAL ENGINEER

OLIVER INCORPORATED

Consulting Engineers & Planners

1116 SOUTH MAIN STREET, SUITE 100

BLACKSBURG, VIRGINIA 24060

(840) 552-5548