

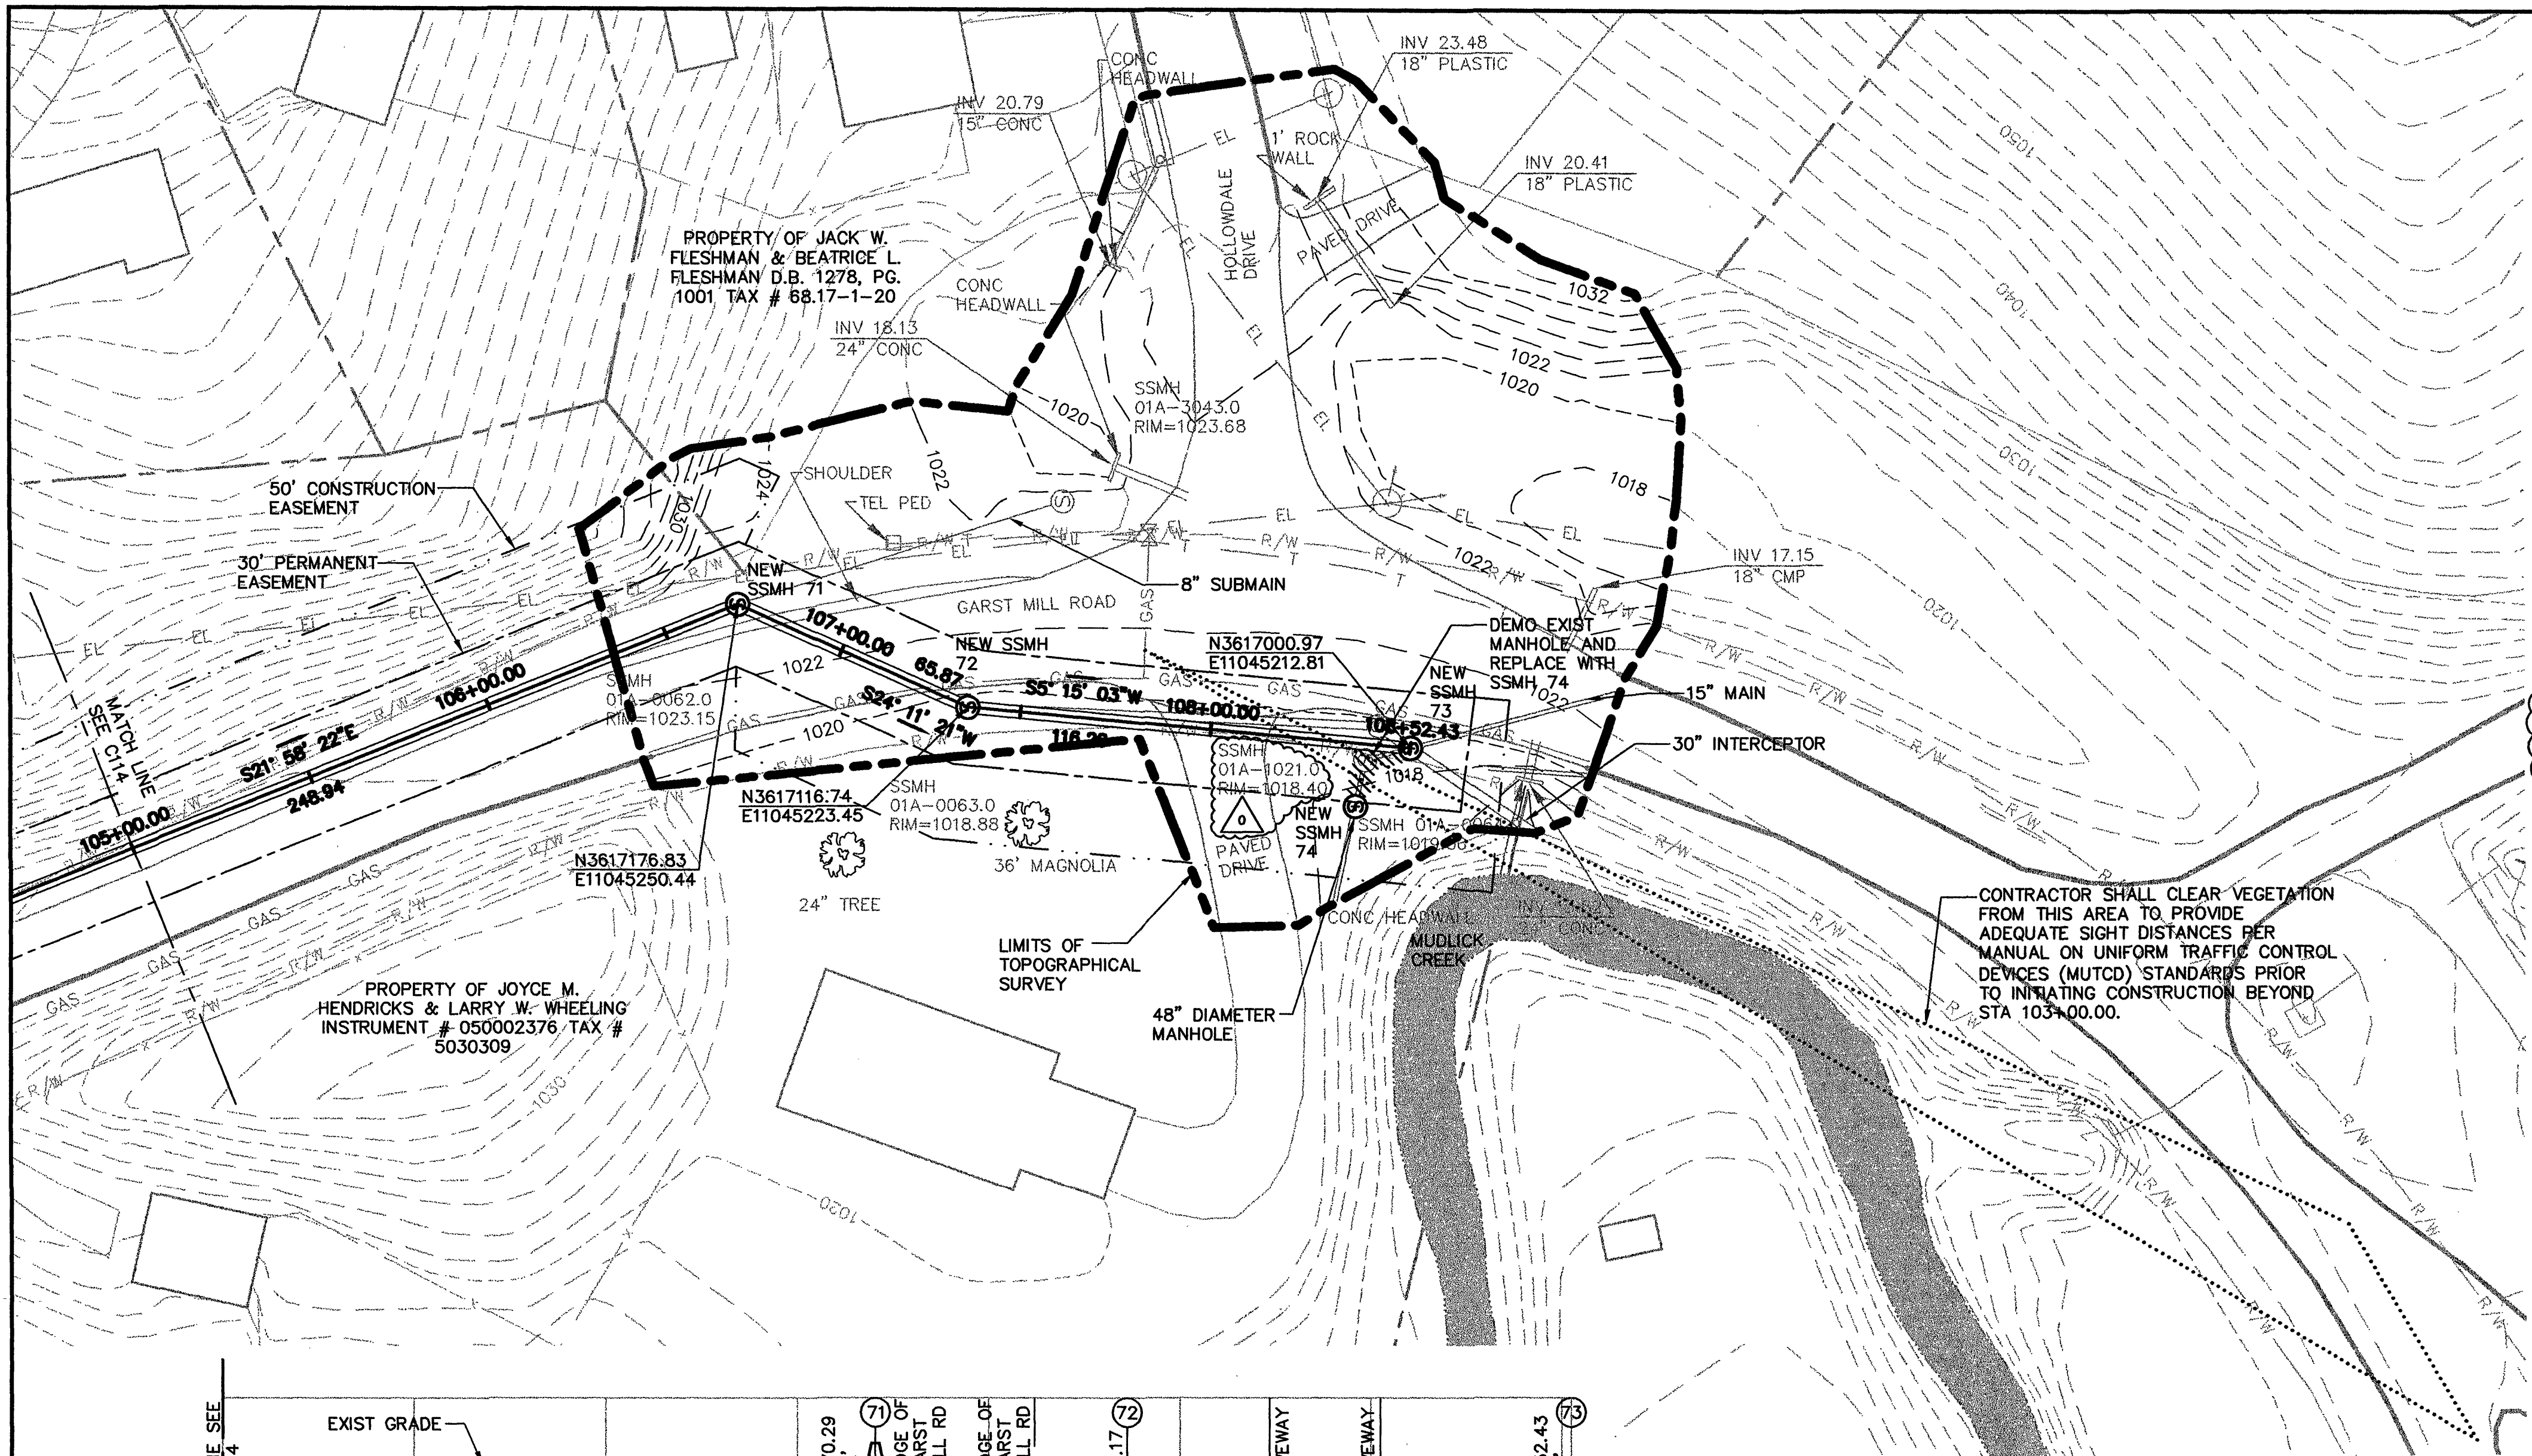
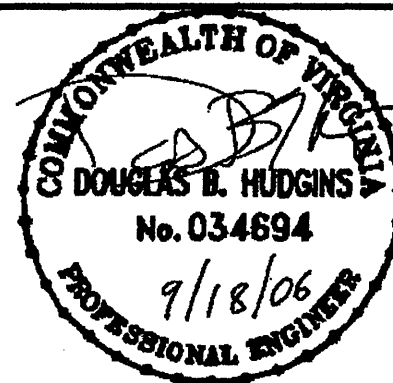
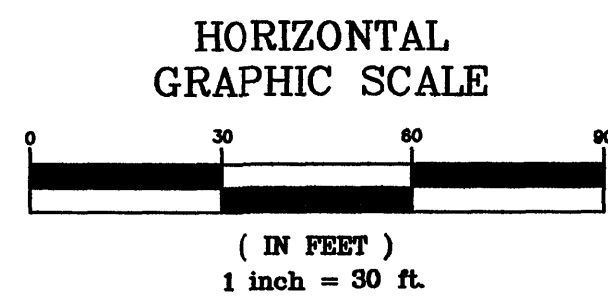
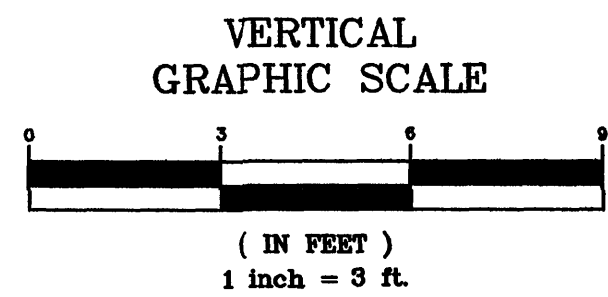



I:\DWG\WVA\12307\01\00\Production\WVA-BUILD\SS-C115.dwg, 3/4/22, 2026-12-22 2:22:37 PM, cbsage

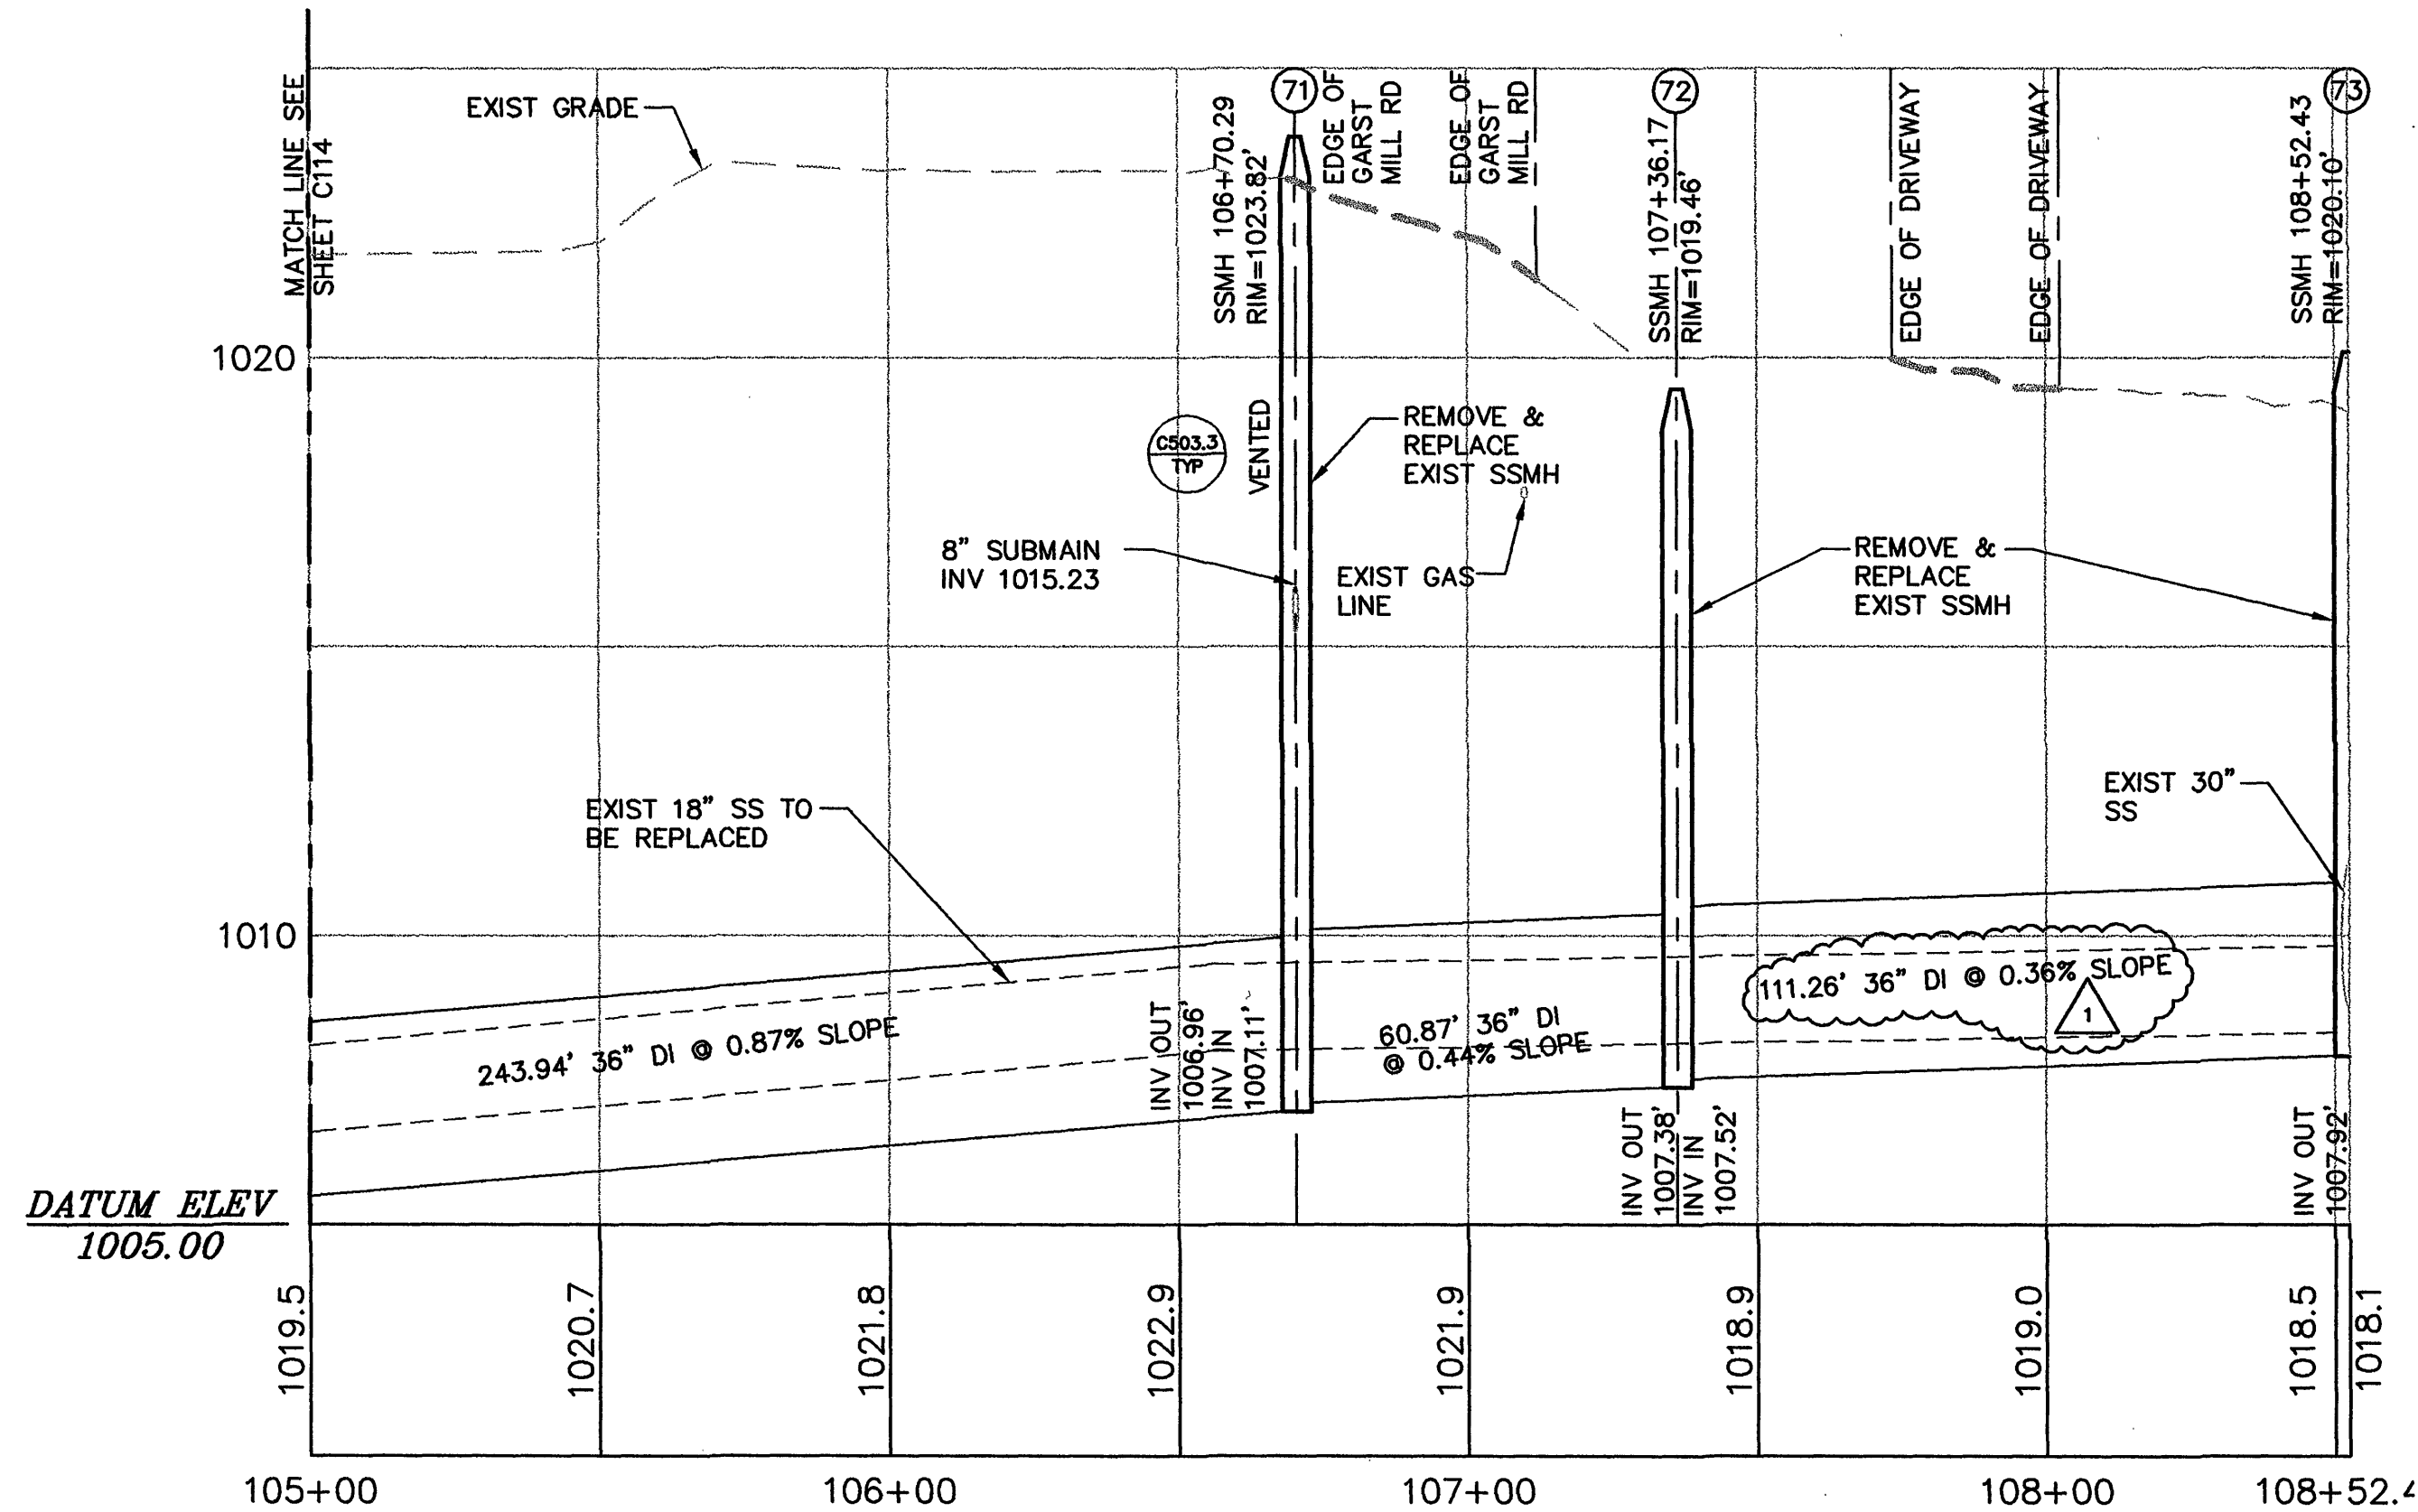

- NOTES:
1. SURVEY PROVIDED BY CALDWELL WHITE AND ASSOCIATES.
 2. BASE MAPPING BASED UPON AERIAL MAPPING PROVIDED BY ROANOKE COUNTY AND CITY OF ROANOKE.
 3. CONTRACTOR SHALL FIELD VERIFY SIZE & INVERT OF ALL LATERALS, SUBMAINS, & MAINS AND PROVIDE INFORMATION AS PART OF SHOP DRAWING SUBMITTAL.
 4. LATERALS IN POOR CONDITION AS IDENTIFIED BY THE AUTHORITY CONNECTING TO THE EXISTING INTERCEPTOR SHALL BE REPLACED TO THE PERMANENT EASEMENT. PAYMENT SHALL BE IN ACCORDANCE WITH SPECIFICATION 01026. SEWER SERVICE LATERALS SHALL BE REPLACED TO THE PERMANENT EASEMENT BOUNDARY. CONTRACTOR SHALL CONFIRM SIZE AND LOCATION AND REPLACE W/IDENTICAL SIZE.
 5. ALL LATERALS TO HAVE A CLEANOUT INSTALLED AT THE PROPERTY LINE AS SHOWN IN DETAIL C503.5/TYP.
 6. CONTRACTOR SHALL REMOVE ONLY THOSE TREES REQUIRED FOR SEWER INTERCEPTOR CONSTRUCTION. ALL TREES WITHIN THE EASEMENT 12" AND LARGER SHALL BE PROTECTED IN ACCORDANCE WITH DETAIL C505.5. ONLY THOSE TREES NOTED ON THE DRAWINGS SHALL BE REMOVED IF REQUIRED. ALL COSTS FOR TREE REMOVAL, DISPOSAL & PROTECTION SHALL BE INCLUDED IN THE COST FOR SEWER LINE INSTALLATION.
 7. EXIST LATERALS, SUBMAINS, & MAINS HAVE BEEN IDENTIFIED BY MANHOLE INSPECTIONS PERFORMED BY OI AND FIELD INVESTIGATION BY THE AUTHORITY'S SSER GROUP. ALL ACTIVE SEWER LATERALS SHALL REMAIN IN SERVICE AND BE RECONNECTED BY THE CONTRACTOR.
 8. LIMITS OF CLEARING & GRADING ARE LIMITED TO WITHIN THE PERMANENT EASEMENT.
 9. THE CITY MAY NOT ALLOW DIAGONAL PATCHING OF THE ASPHALT. THE ENTIRE PROJECTION (FULL WIDTH OF ROADWAY) MUST BE REPAVED. CONTRACTOR SHALL TAKE THIS INTO ACCOUNT WHEN DETERMINING A PRICE FOR THE WORK ON A UNIT PRICE BASIS AS DEFINED IN SPECIFICATION SECTION 01026, MEASUREMENT AND PAYMENT.
 10. SSMH 74 IS TO BE SET AT THE PROPOSED END OF AN EXISTING SEWER MAIN. INVERT ASSUMED TO BE 1007.5'. INVERT AND PIPE DIAMETER TO BE FIELD VERIFIED BY CONTRACTOR PRIOR TO SHOP SUBMITTAL. MANHOLE SHALL HAVE ONE 15" PIPE PENETRATING ON THE WEST SIDE OF MANHOLE.

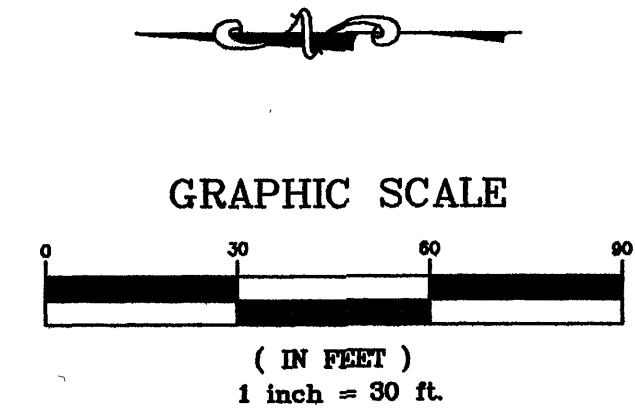

OLVER INCORPORATED
Consulting Engineers & Planners
1116 SOUTH MAIN STREET, SUITE 100
BLACKSBURG, VIRGINIA 24060
(540) 552-5546

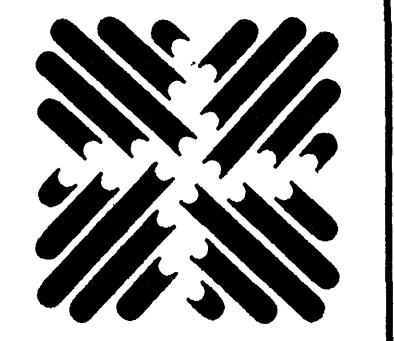

WESTERN VIRGINIA WATER AUTHORITY
MUDLICK CREEK INTERCEPTOR
PLAN
STATION 105+00.00 THRU 108+61.09

Rev.	Description	Date	By
3	AS-BUILT	10/16/08	DBH
1	FIELD ORDER NO. 2	2/21/07	DBH
0	AS-BID DOCUMENTS	11/20/06	DBH

Designed: BYP
Drawn: RJH
Checked: DBH
Date: FEB 2006
Scale: AS SHOWN
Job No. 12307.01
Archived File Name:

VERIFY SCALE
Bar Scale measures 1" on original drawing
0" 1"

C115