
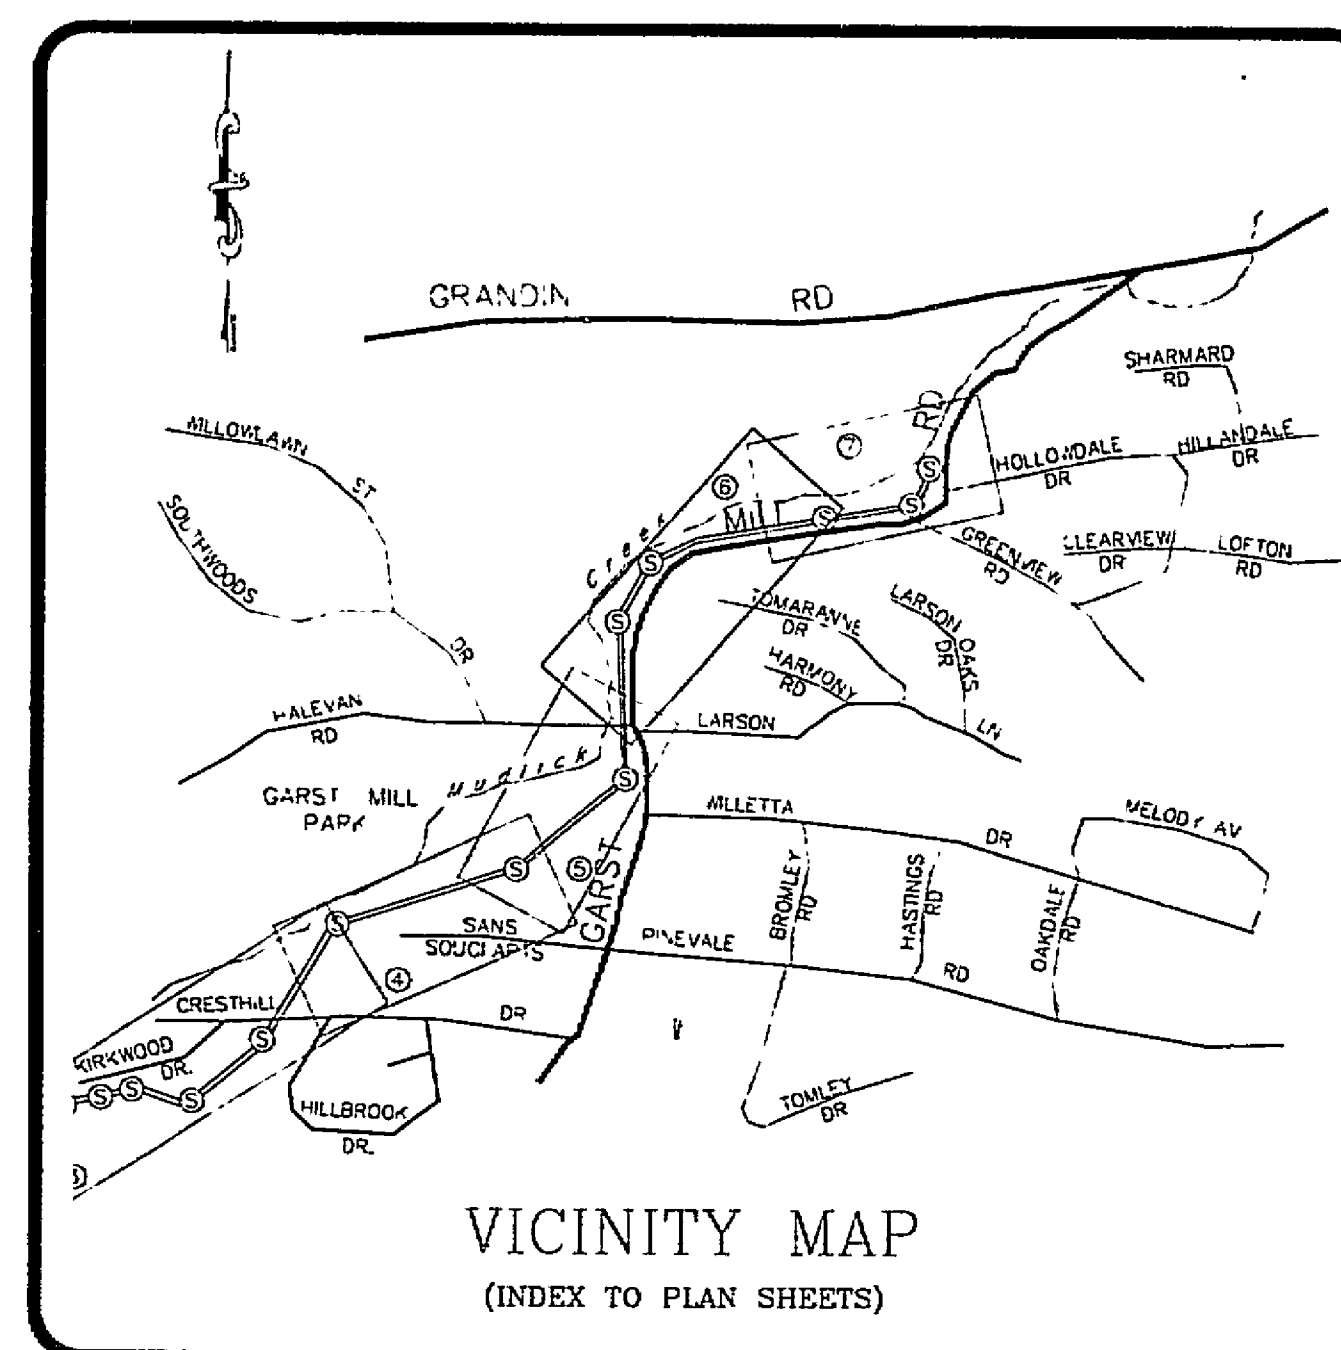


ROANOKE COUNTY
DEPARTMENT OF ENGINEERING AND INSPECTIONS

MUDLICK INTERCEPTOR
PHASE I

SEWER LINE REPLACEMENT

APPROVE "AS-BUILT"
PLANS DATE 2-29-97

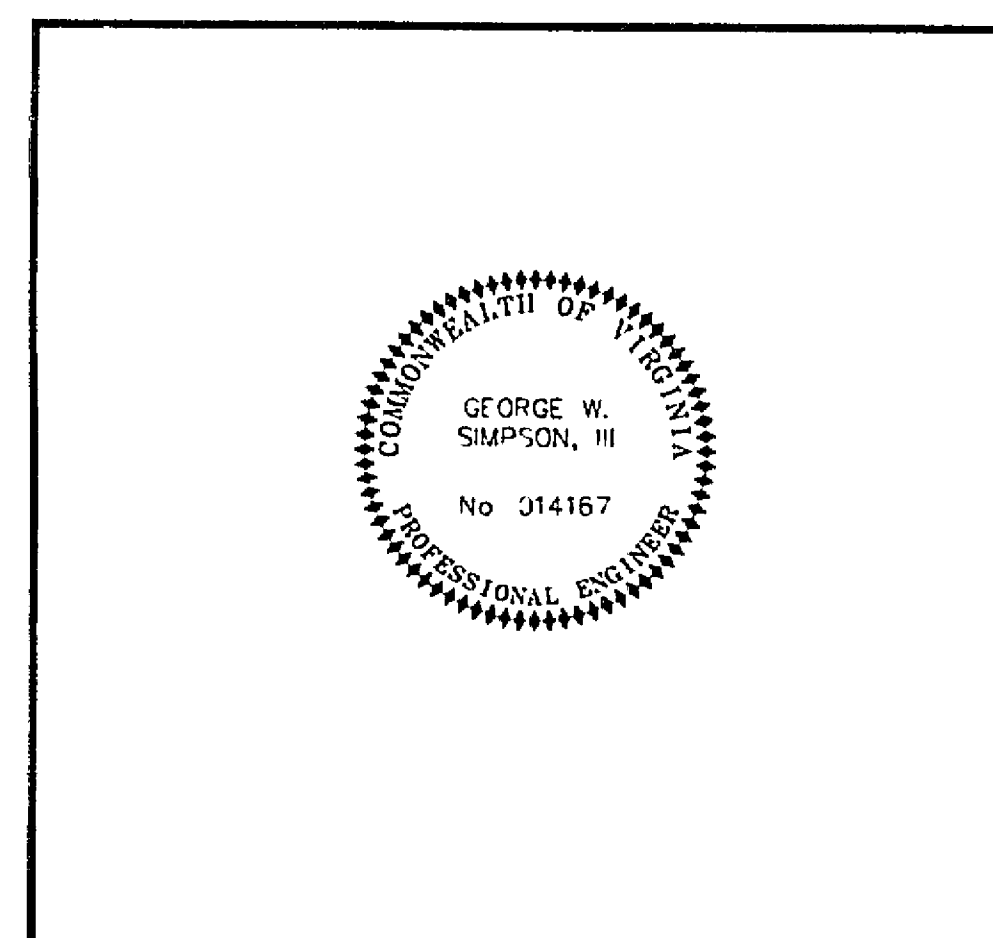

SCHEDULE OF DRAWINGS

SHEET	TITLE	STATION
1	COVER SHEET	
2	COUNTY COVER	
3	S PLAN & PRO	10+42.31-21+99.99
4	S PLAN & PRO	22+00.00-34+99.99
5	S PLAN & PRO	35+00.00-45+99.99
6	S PLAN & PRO	46+00.00-59+99.99
7	S PLAN & PRO	60+00.00-74+62.70
8	TRANSITION PROFILES & DETAILS	
9	SEWER DETAIL SHEET	
10	EROSION & SEDIMENT CONTROL DETAIL SHEET	