



|          |  |
|----------|--|
| DATE     |  |
| BY       |  |
| CHECKED  |  |
| APPROVED |  |
| NO.      |  |

|          |  |
|----------|--|
| DATE     |  |
| BY       |  |
| CHECKED  |  |
| APPROVED |  |
| NO.      |  |

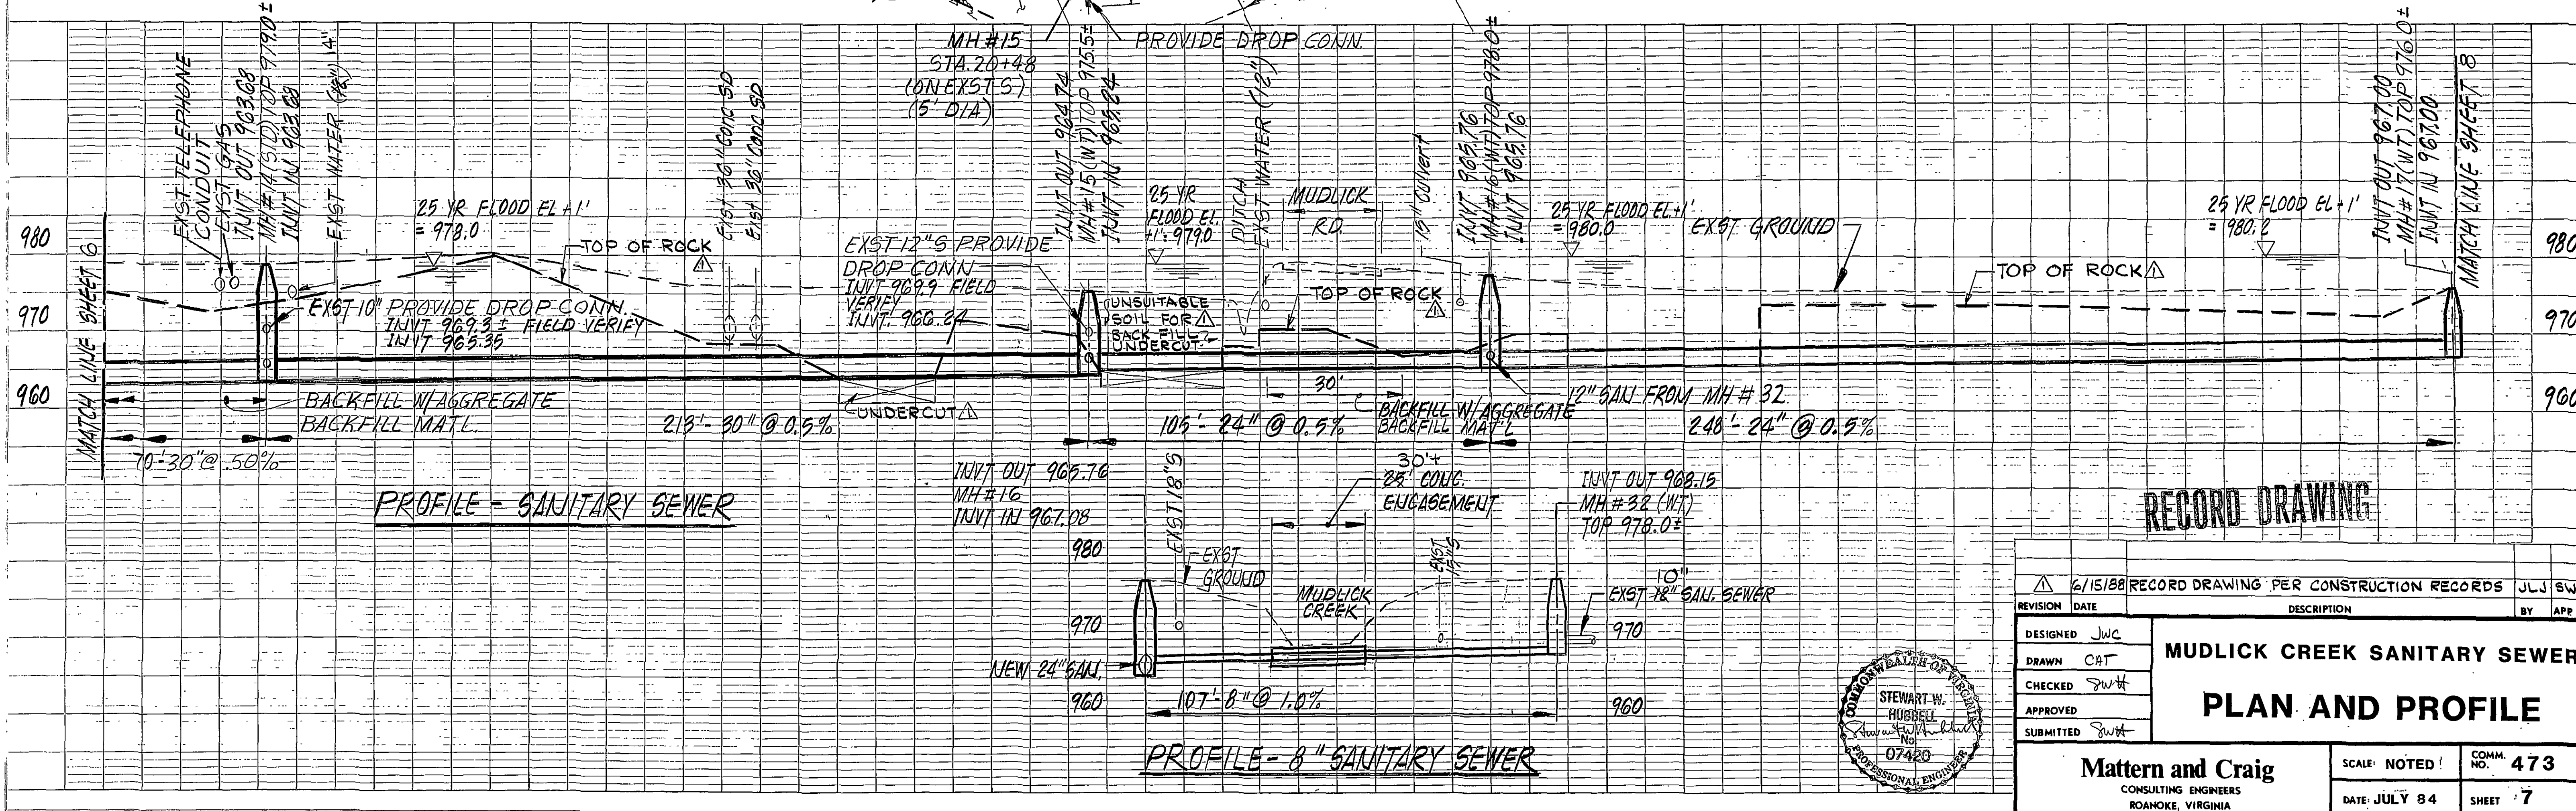

|                                                                                       |      |                                                                     |                                         |               |     |
|---------------------------------------------------------------------------------------|------|---------------------------------------------------------------------|-----------------------------------------|---------------|-----|
|  |      | 6/15/88                                                             | RECORD DRAWING PER CONSTRUCTION RECORDS | JLJ           | SWH |
| REVISION                                                                              | DATE | DESCRIPTION                                                         |                                         | BY            | APP |
| DESIGNED                                                                              | JWC  | <div>MUDLICK CREEK SANITARY SEWER</div> <div>PLAN AND PROFILE</div> |                                         |               |     |
| DRAWN                                                                                 | CAT  |                                                                     |                                         |               |     |
| CHECKED                                                                               | SWH  |                                                                     |                                         |               |     |
| APPROVED                                                                              |      |                                                                     |                                         |               |     |
| SUBMITTED                                                                             | SWH  |                                                                     |                                         |               |     |
| Mattern and Craig                                                                     |      |                                                                     | SCALE: NOTED!                           | COMM. NO. 473 |     |
| CONSULTING ENGINEERS<br>ROANOKE, VIRGINIA                                             |      |                                                                     | DATE: JULY 84                           | SHEET 7       |     |

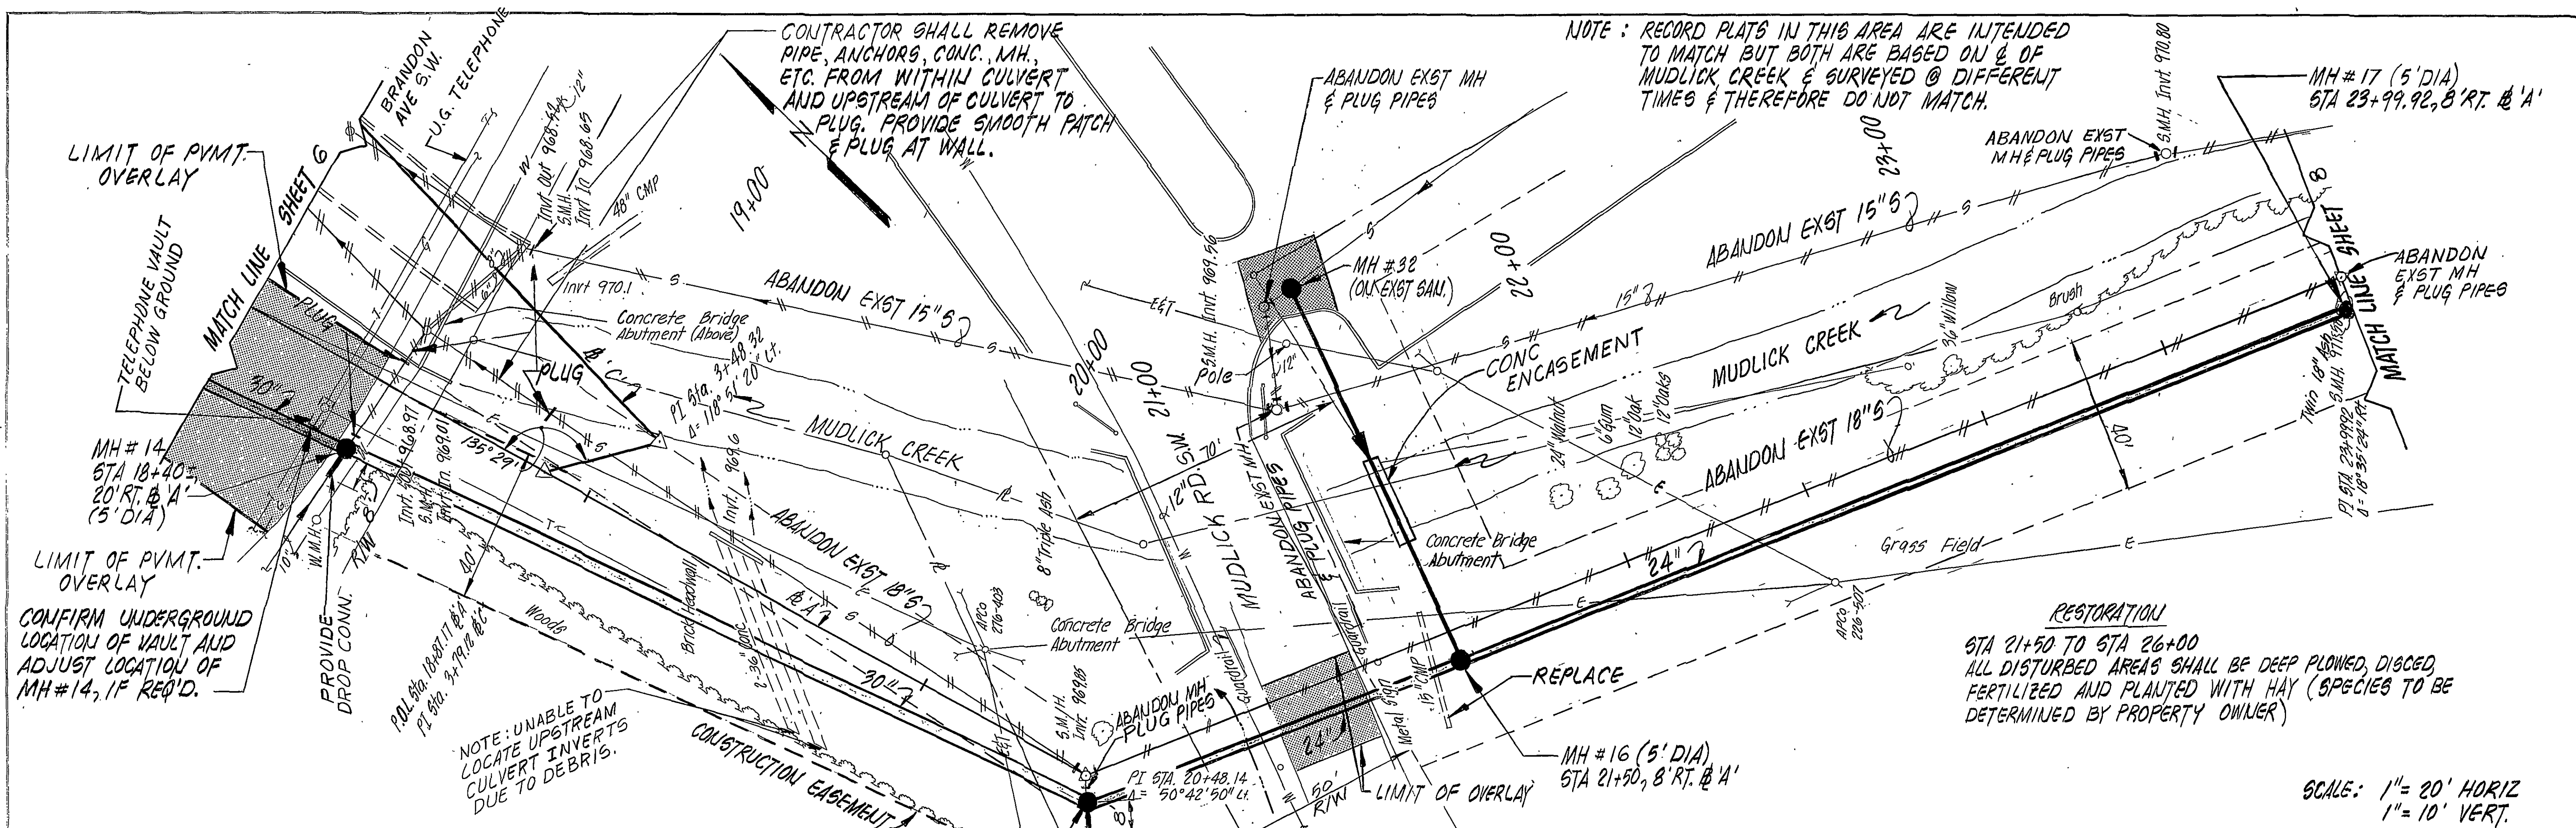