


DATE	
REVISION	
NOTES	
NO.	


DATE	
REVISION	
NOTES	
NO.	

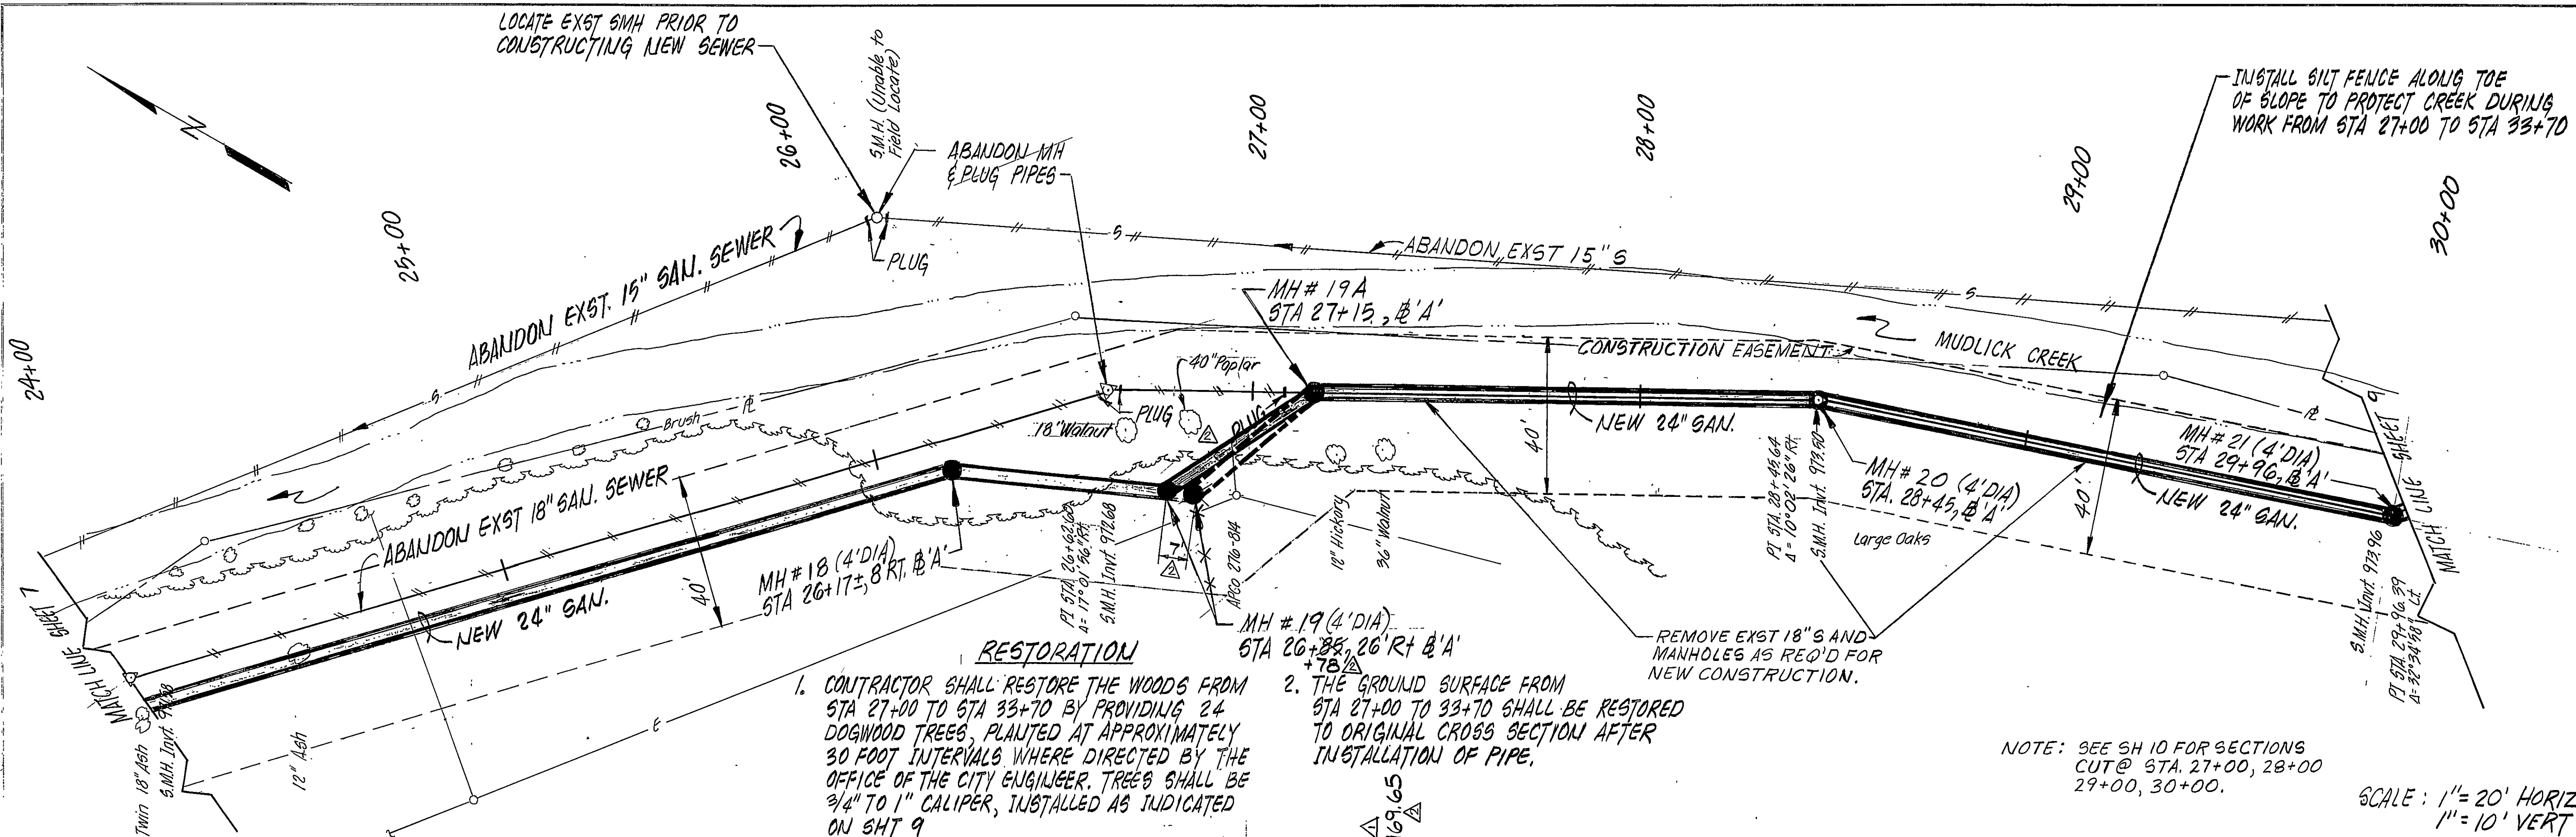

- RESTORATION**
1. CONTRACTOR SHALL RESTORE THE WOODS FROM STA 27+00 TO STA 33+70 BY PROVIDING 24 DOGWOOD TREES, PLANTED AT APPROXIMATELY 30 FOOT INTERVALS WHERE DIRECTED BY THE OFFICE OF THE CITY ENGINEER. TREES SHALL BE 3/4" TO 1" CALIPER, INSTALLED AS INDICATED ON SHT 9
 2. THE GROUND SURFACE FROM STA 27+00 TO 33+70 SHALL BE RESTORED TO ORIGINAL CROSS SECTION AFTER INSTALLATION OF PIPE.


NOTE: SEE SH 10 FOR SECTIONS CUT @ STA. 27+00, 28+00, 29+00, 30+00.

SCALE: 1" = 20' HORIZ
1" = 10' VERT

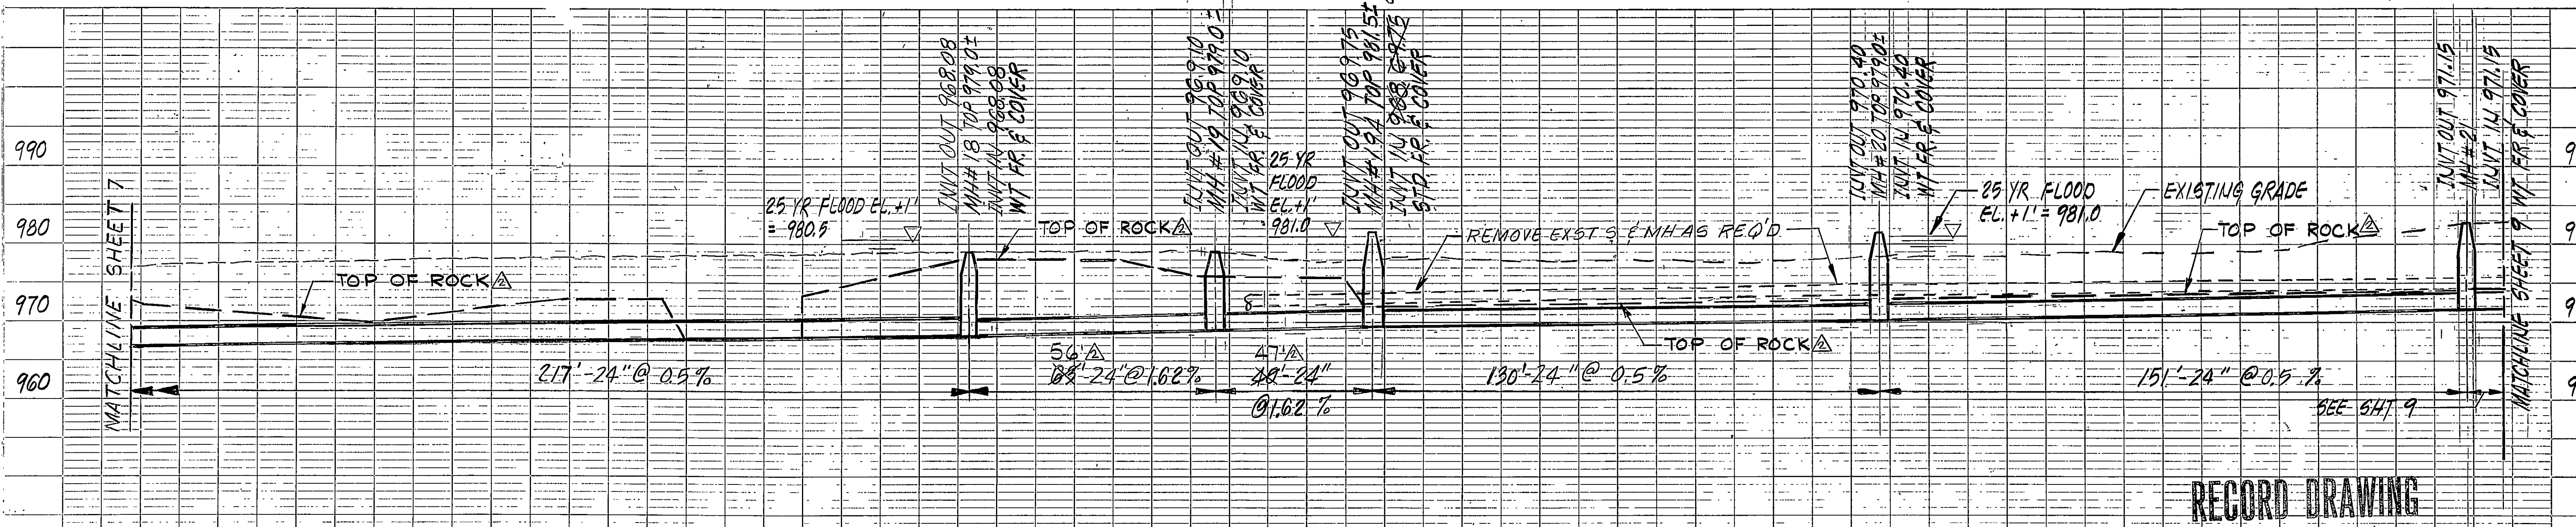

PROFILE 24" SANITARY SEWER

RECORD DRAWING

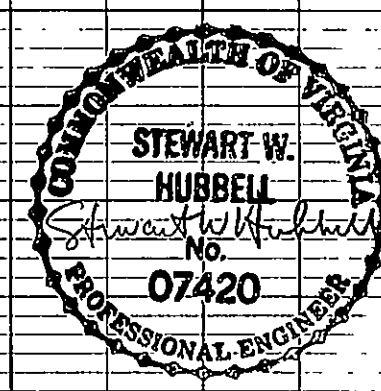

		6/15/88	RECORD DRAWING PER CONSTRUCTION RECORDS	JLJ	SWH
		10/30/84	REV PER SDH COMMENTS		
REVISION	DATE	DESCRIPTION			BY APP
DESIGNED	JWC	MUDLICK CREEK SANITARY SEWER PLAN AND PROFILE			
DRAWN	CAT				
CHECKED	SWH				
APPROVED					
SUBMITTED	SWH				
Mattern and Craig CONSULTING ENGINEERS ROANOKE, VIRGINIA			SCALE: NOTED	COMM. NO. 473	
			DATE: JULY 84	SHEET 8	