



DATE	
BY	
CHECKED	
APPROVED	
SUBMITTED	
NOTED	
REVISION	
DATE	
BY	
CHECKED	
APPROVED	
SUBMITTED	
NOTED	
REVISION	

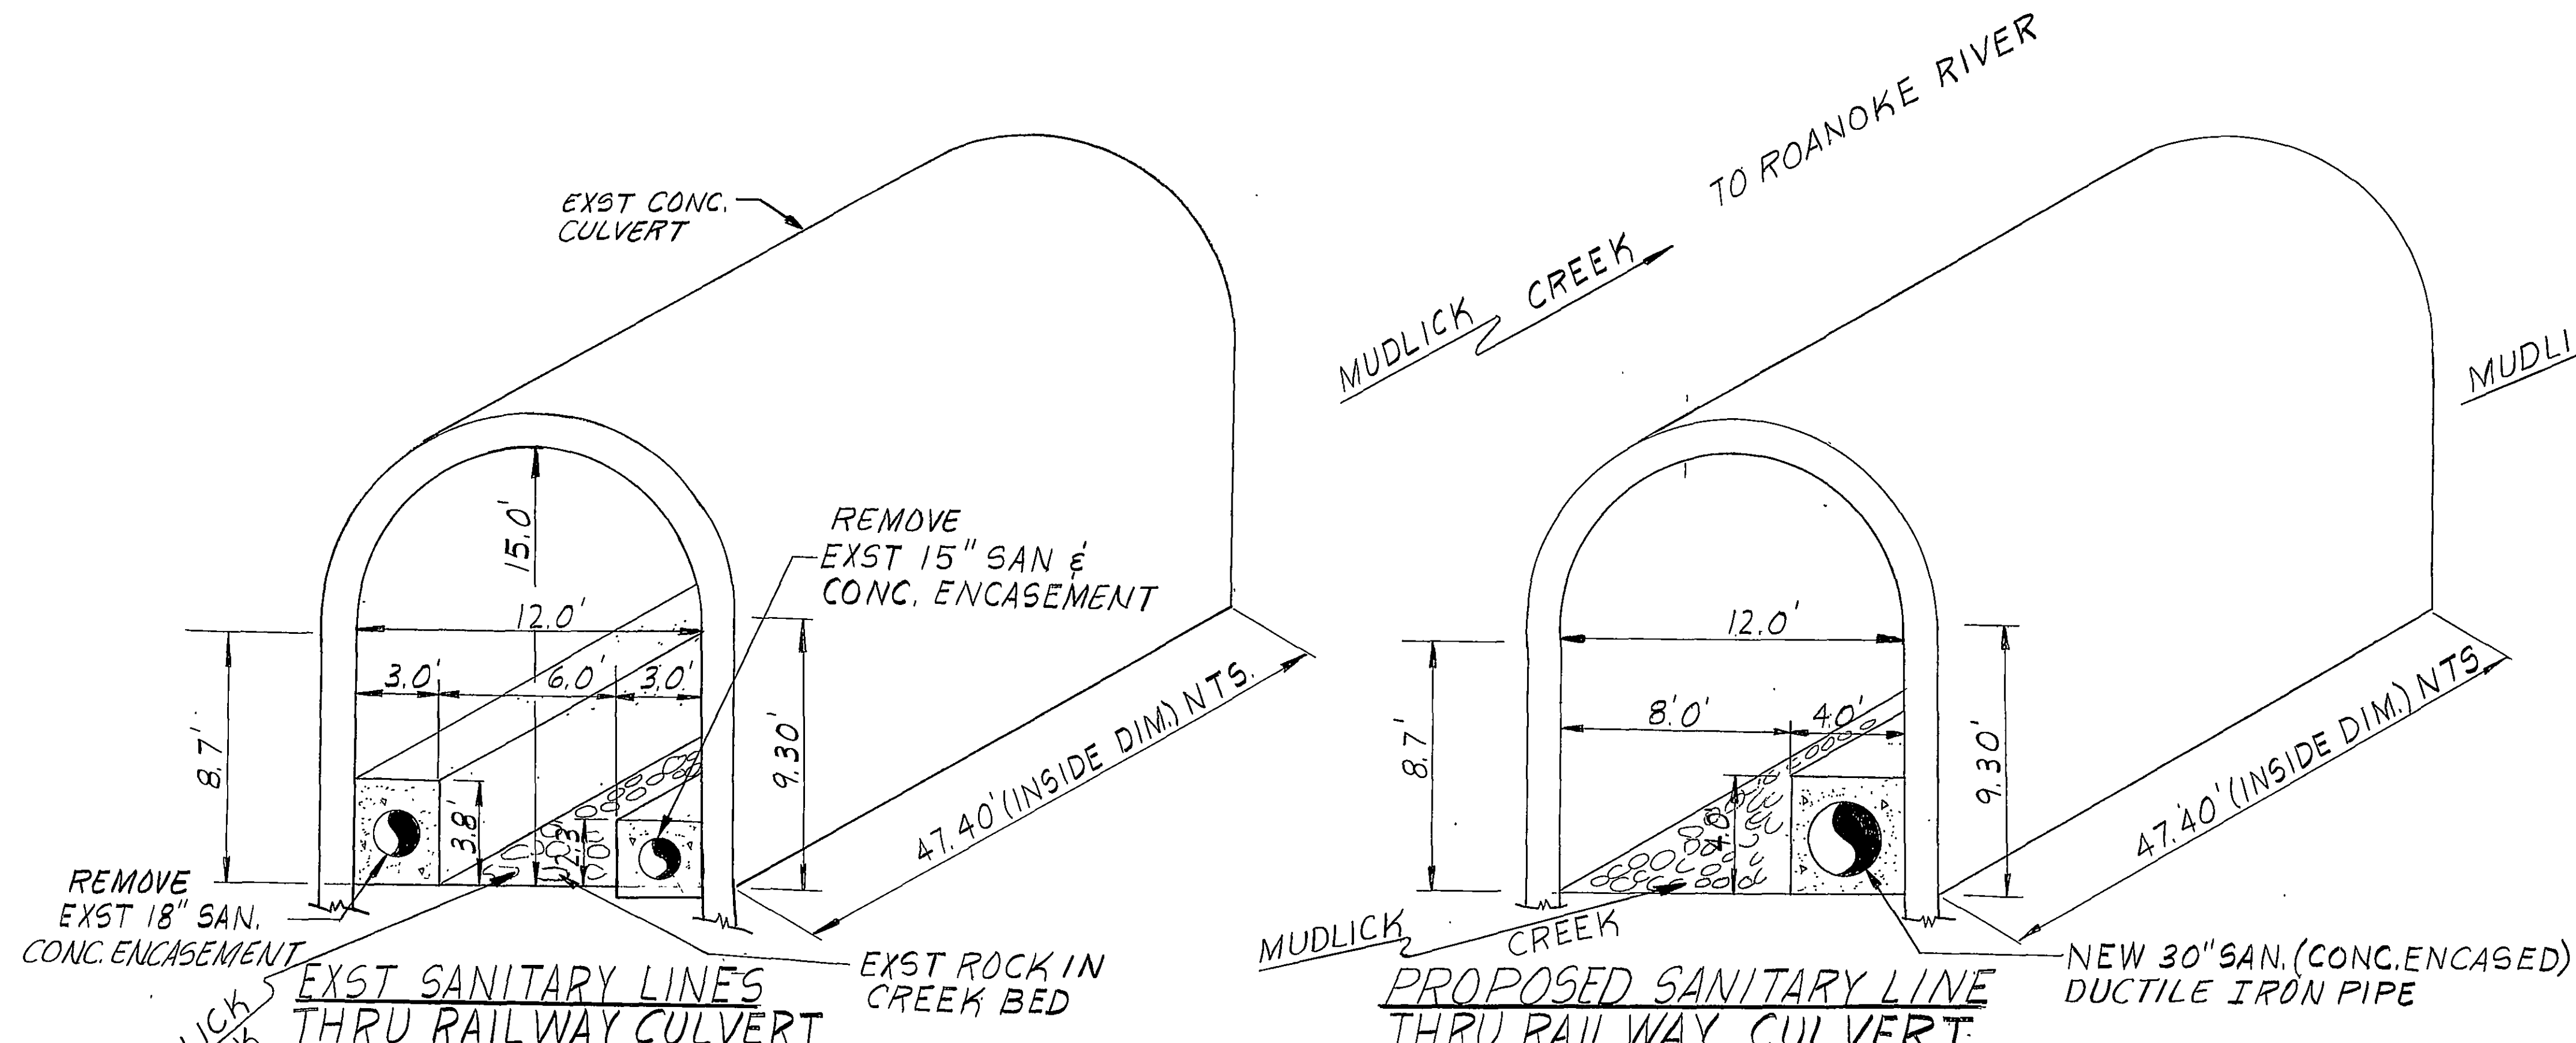

ISOMETRIC SKETCHES - RAILWAY CULVERT (SCALE: 1/4" = 1'-0")
(REPLACEMENT OF EXST SANITARY LINES WITH NEW 30" SANITARY LINE)

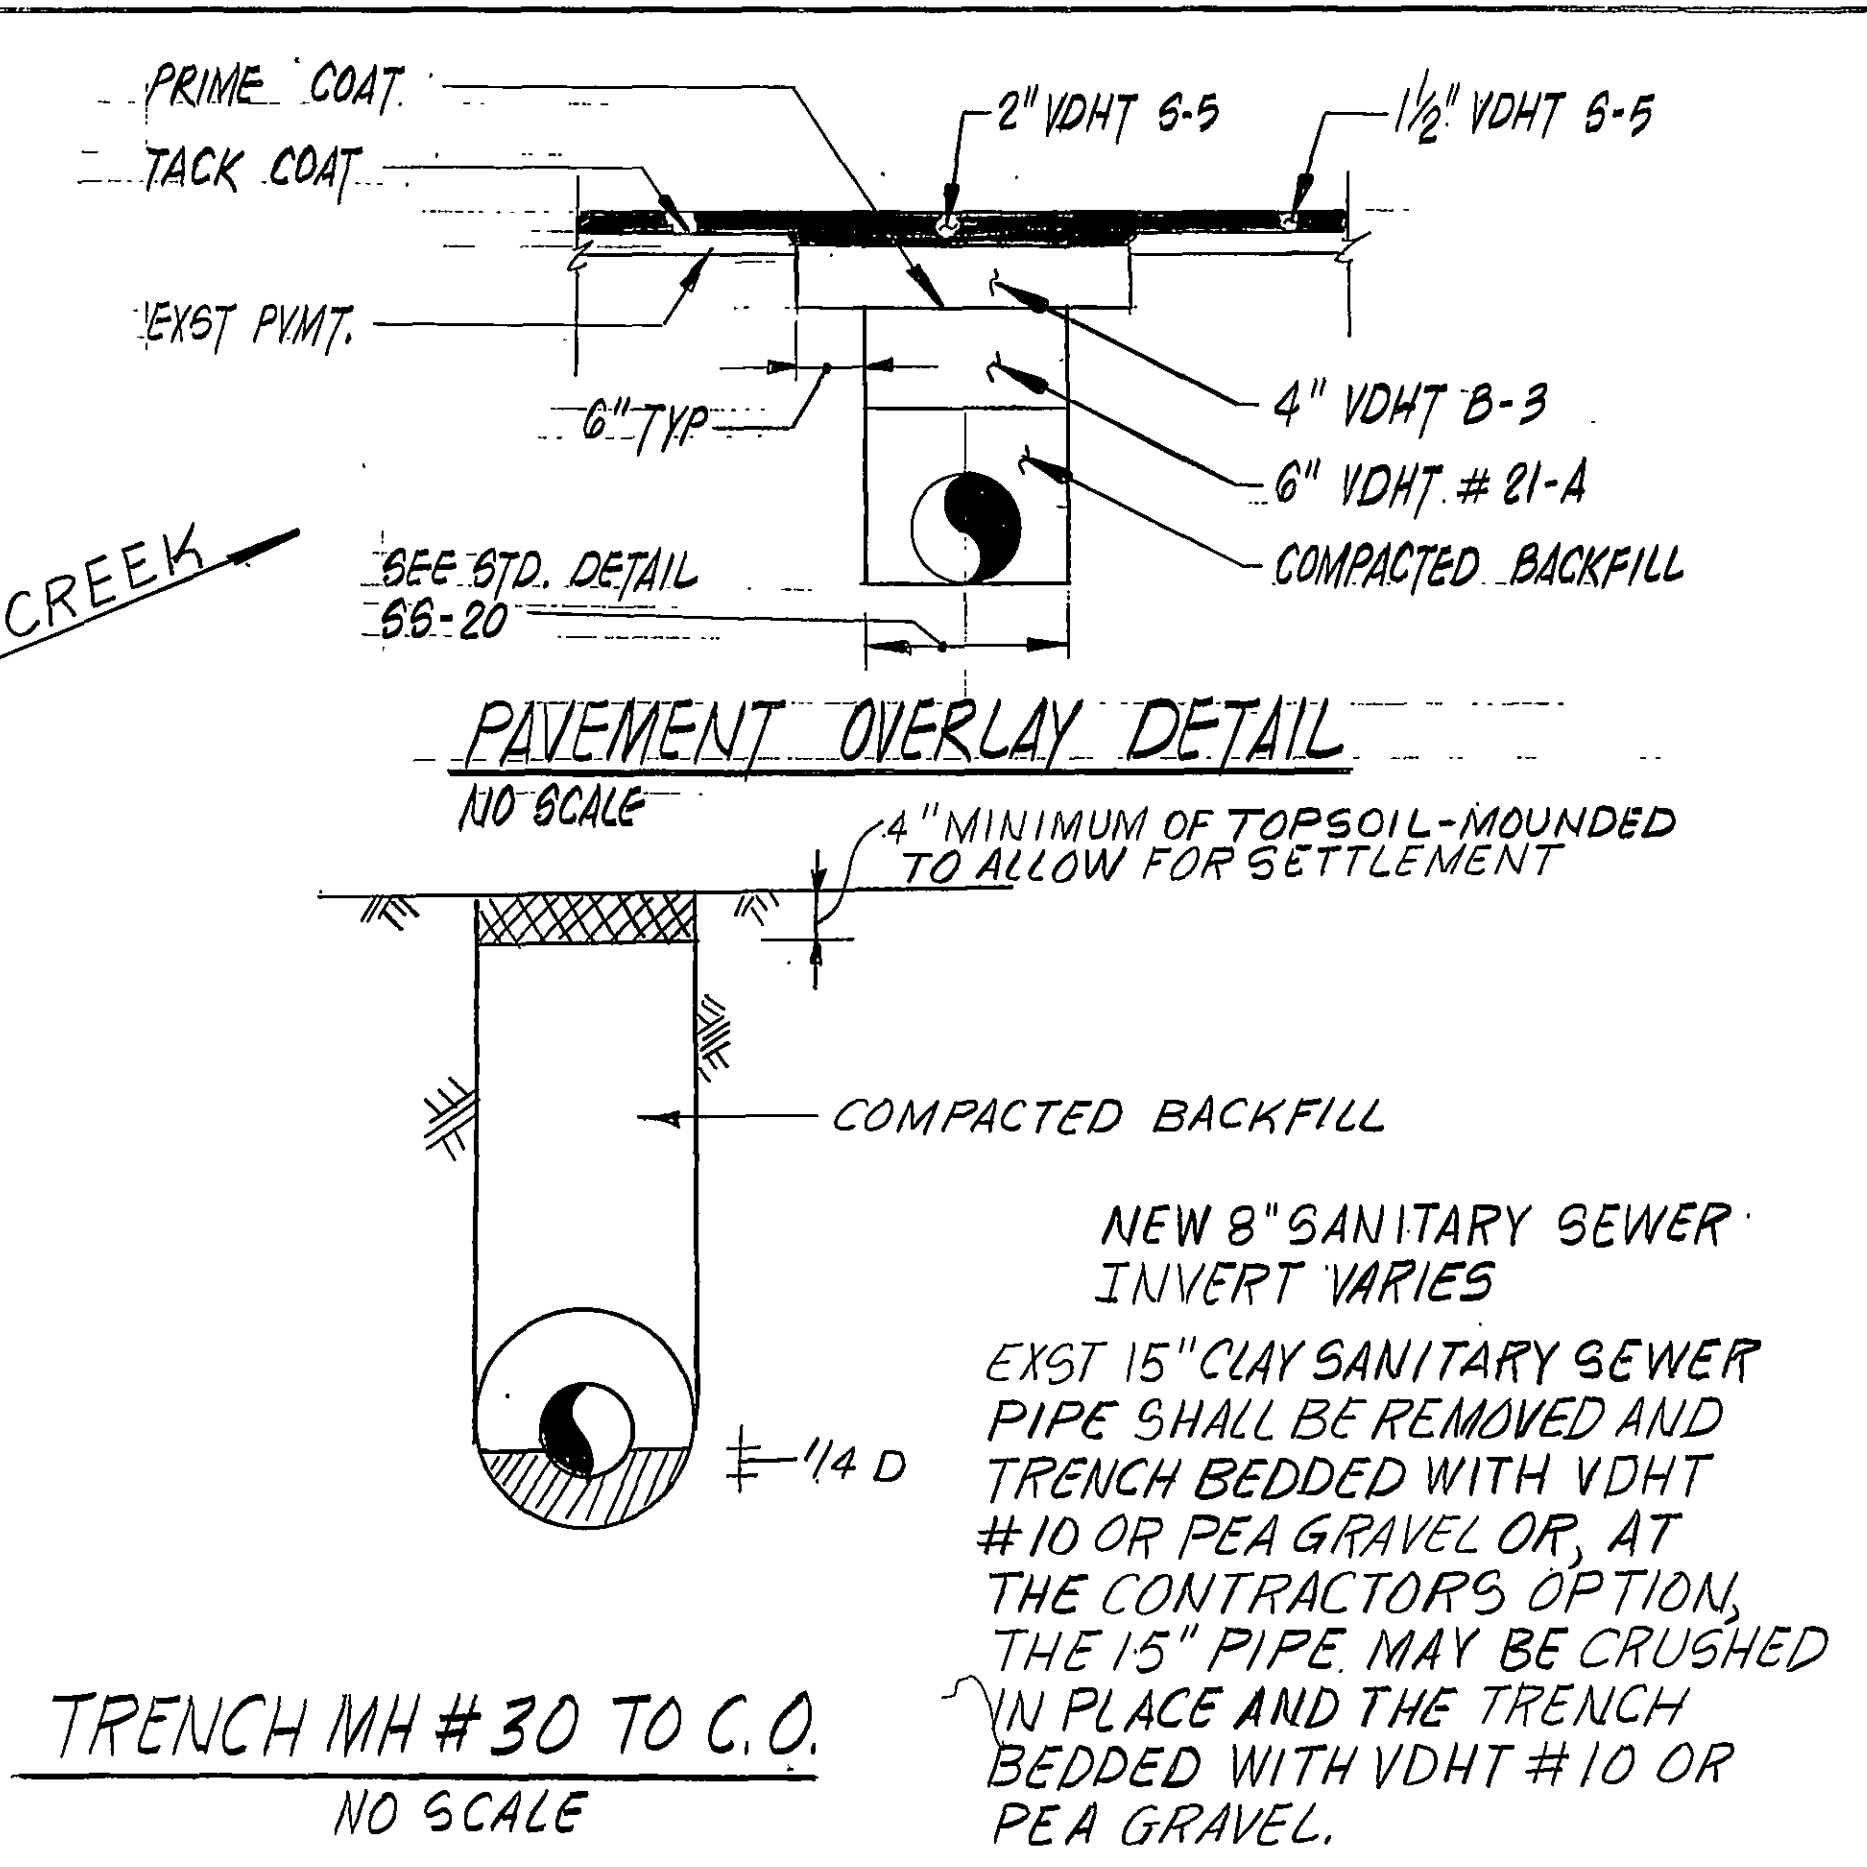


PAVEMENT OVERLAY DETAIL
NO SCALE


TRENCH MH #30 TO C.O.
NO SCALE

NEW 8" SANITARY SEWER INVERT VARIES
EXST 15" CLAY SANITARY SEWER PIPE SHALL BE REMOVED AND TRENCH BEDDED WITH VDHT #10 OR PEA GRAVEL OR, AT THE CONTRACTORS OPTION, THE 15" PIPE MAY BE CRUSHED IN PLACE AND THE TRENCH BEDDED WITH VDHT #10 OR PEA GRAVEL.

SCALE: 1 1/2" = 20' HORIZ.
1" = 10' VERT.

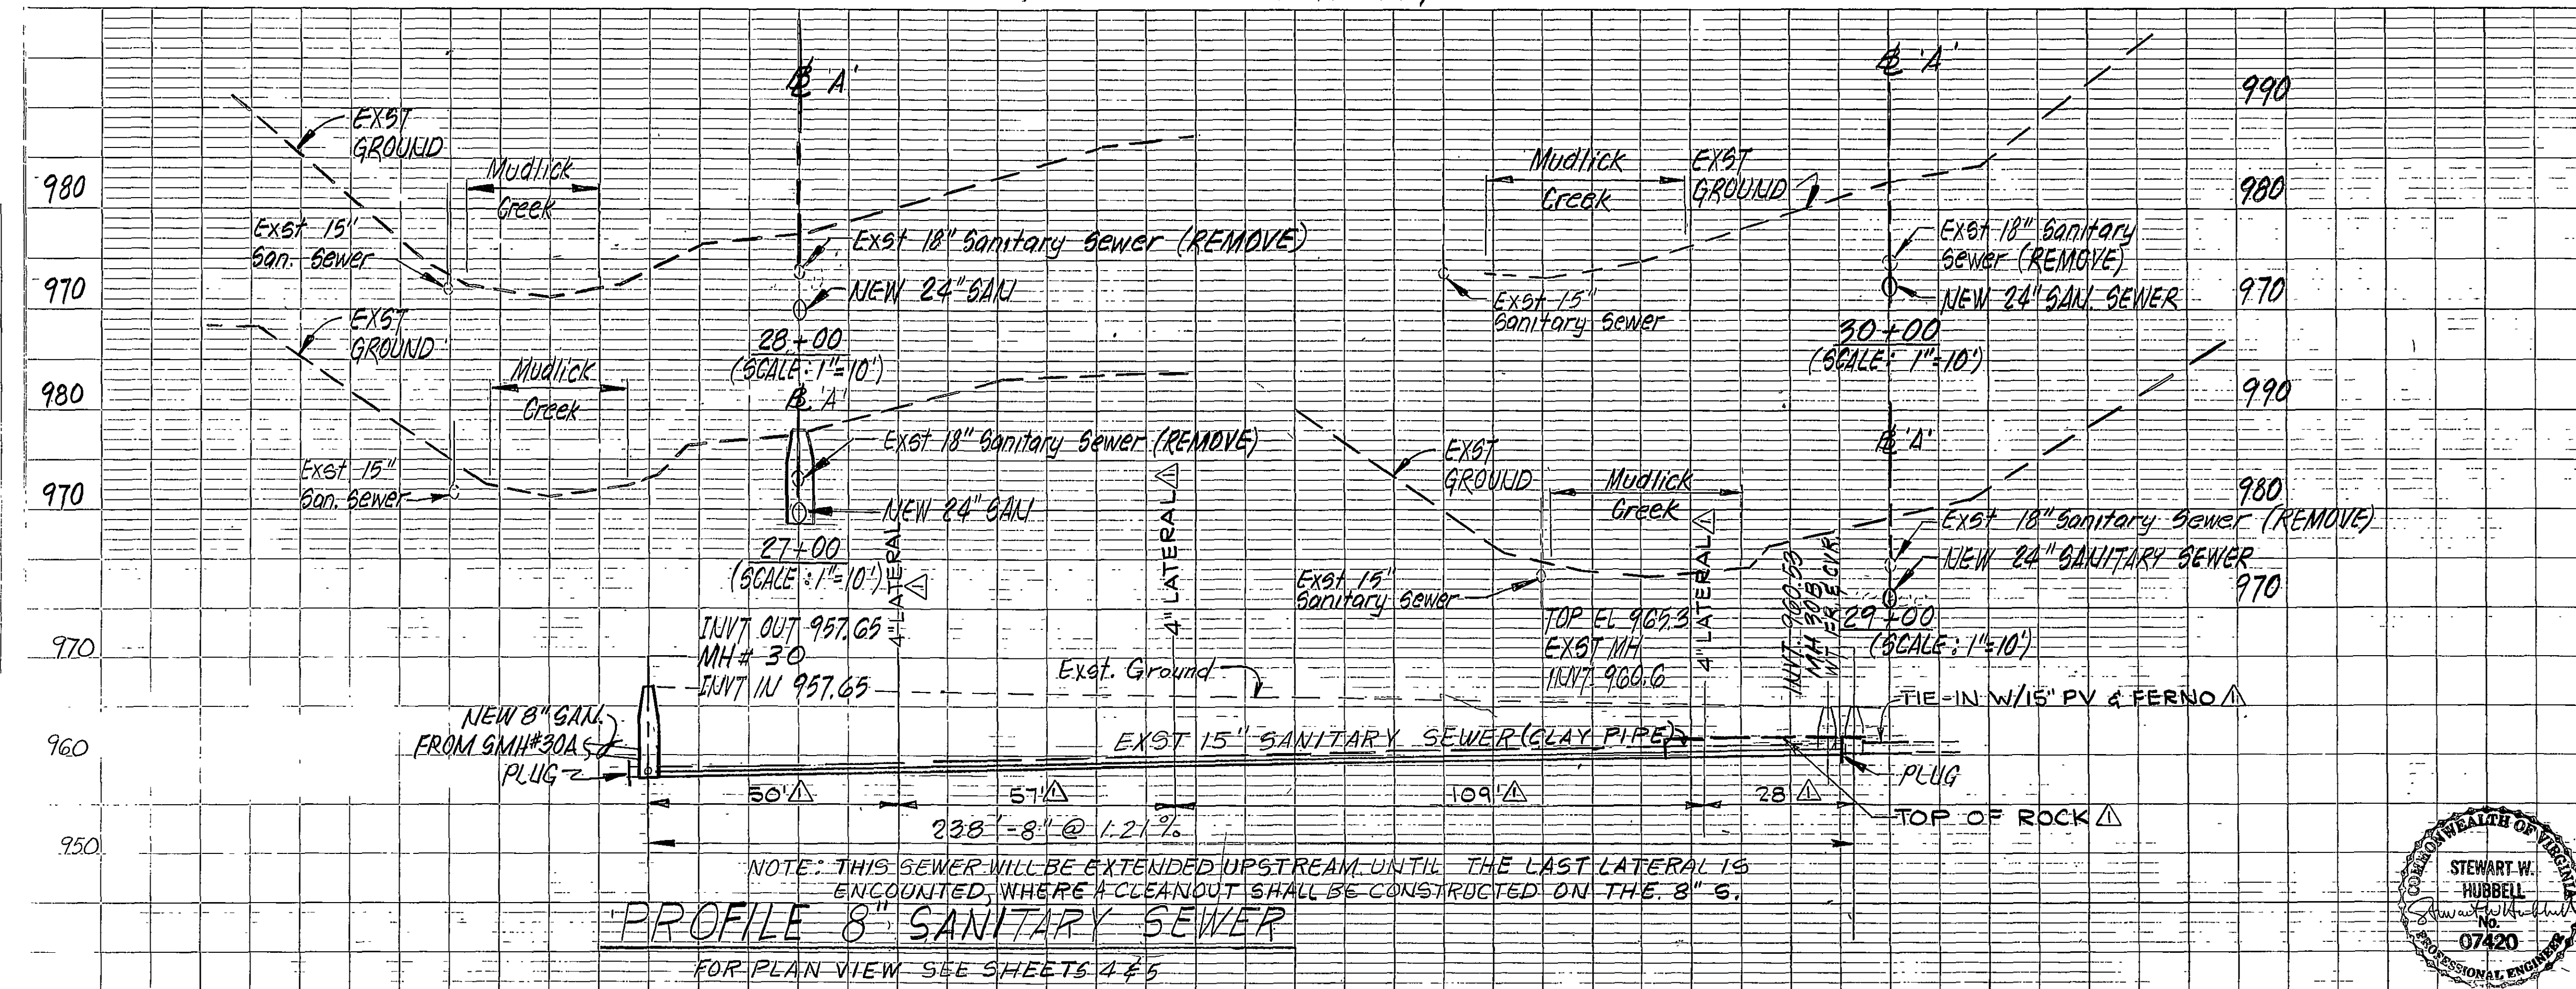

PROFILE 8" SANITARY SEWER
FOR PLAN VIEW SEE SHEETS 4 & 5

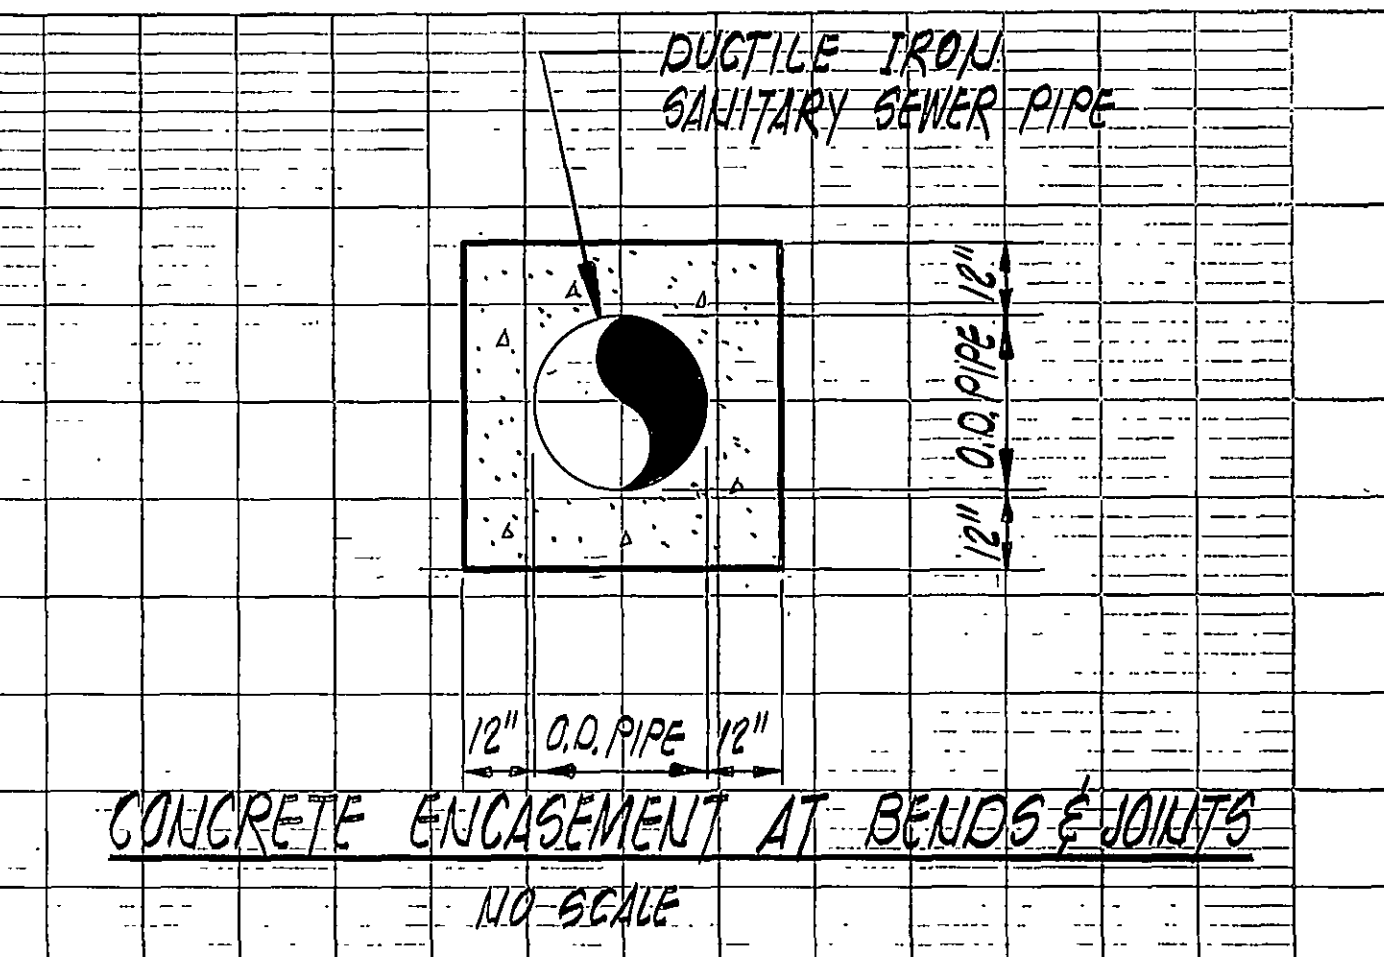

RECORD DRAWING

REVISION	DATE	DESCRIPTION	BY	APP
1	6/15/88	RECORD DRAWING PER CONSTRUCTION RECORD	JLJ	SWH
DESIGNED	JWC			
DRAWN	CAT			
CHECKED	SWH			
APPROVED				
SUBMITTED	SWH			
MUDLICK CREEK SANITARY SEWER				
PROFILES & DETAILS				
Mattern and Craig		SCALE: NOTED	COMM. NO. 473	
CONSULTING ENGINEERS		DATE: JULY 84	SHEET 10	
ROANOKE, VIRGINIA				

