

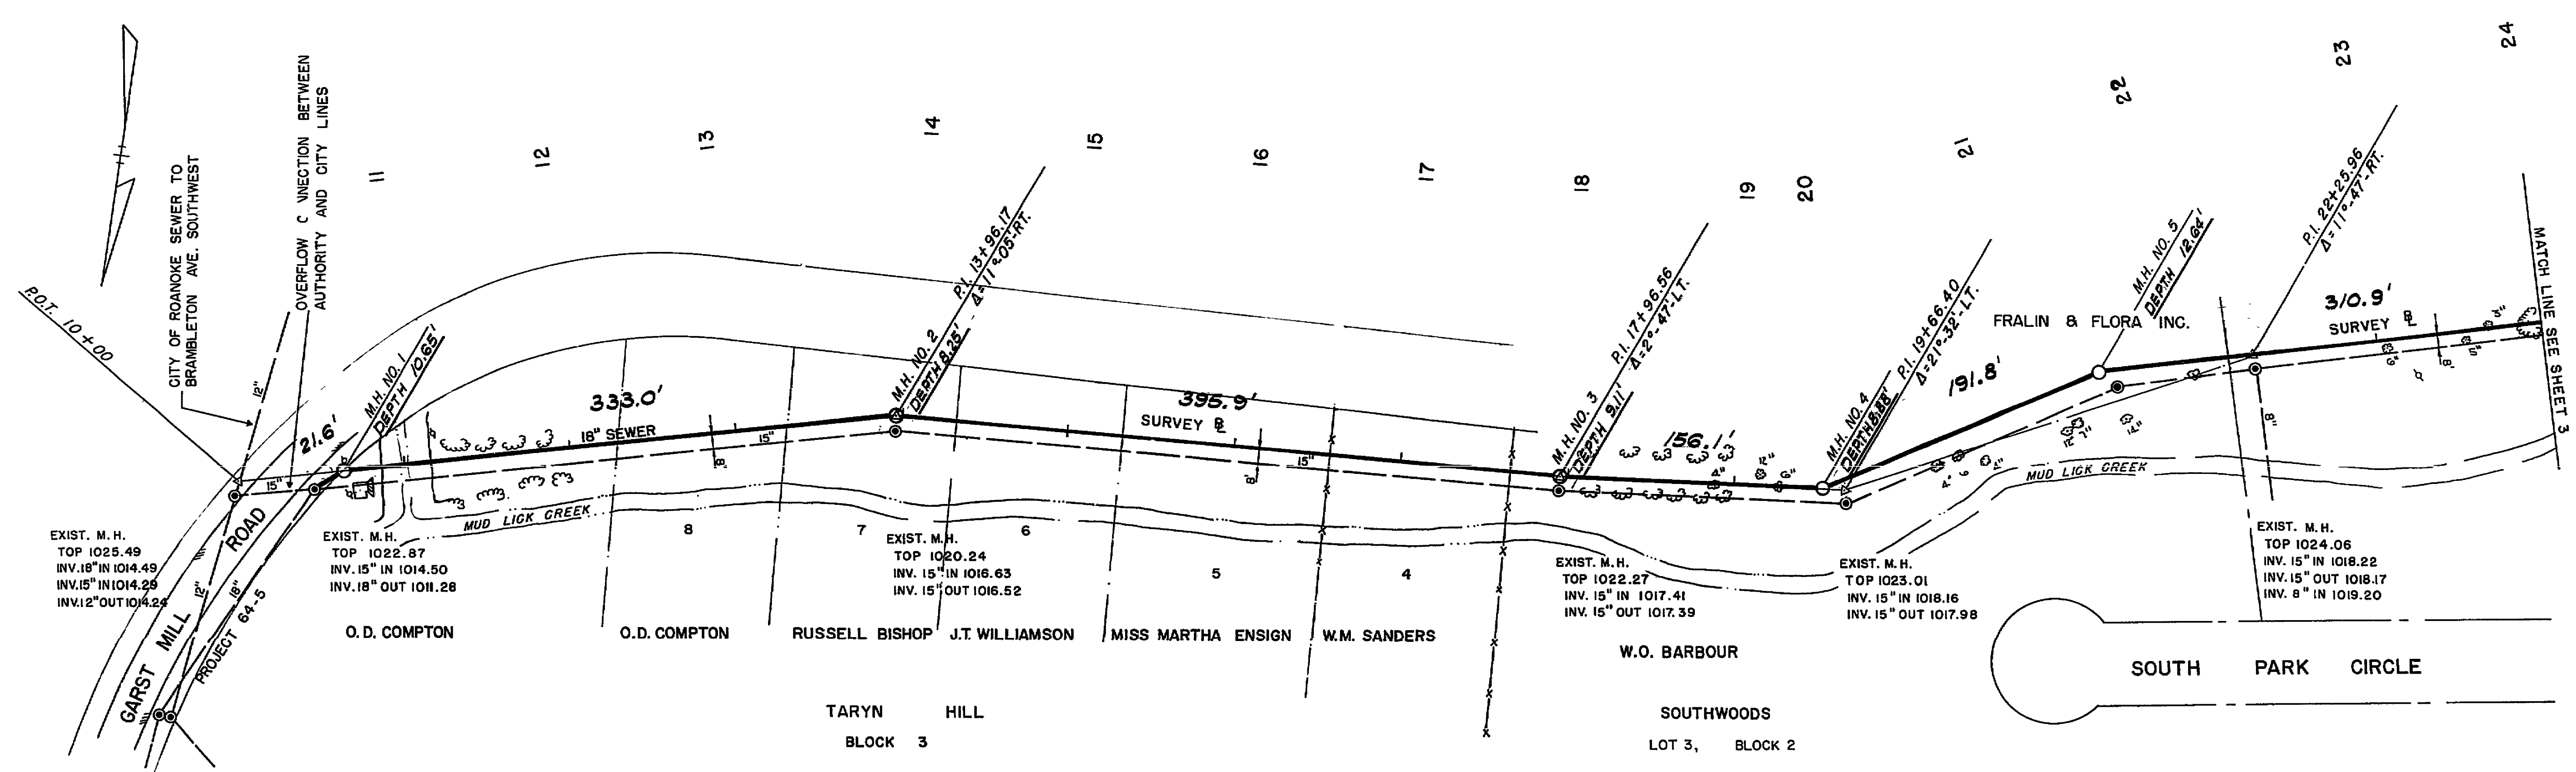


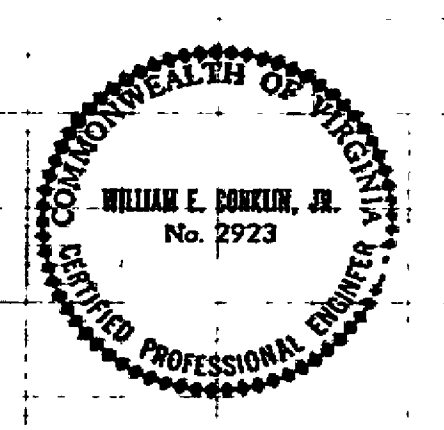


AS BUILT

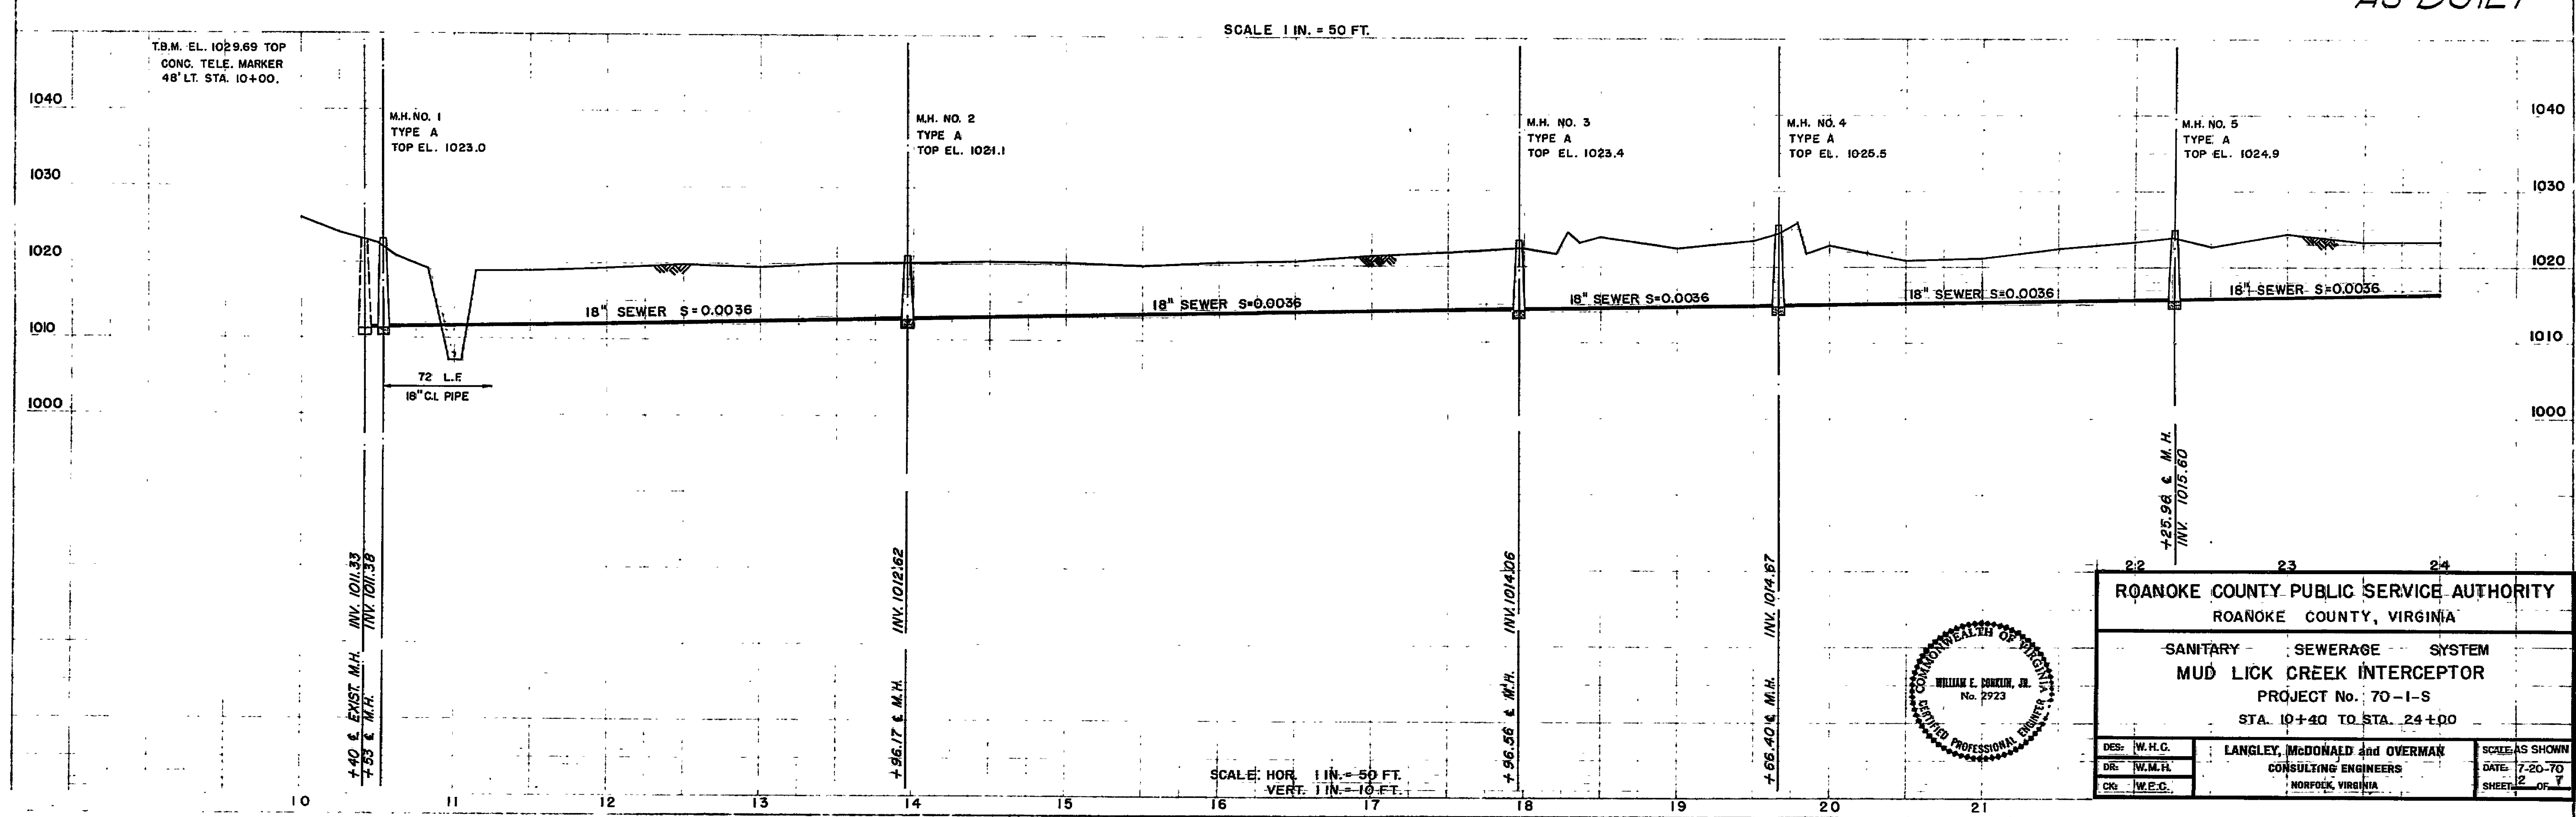

ROANOKE COUNTY PUBLIC SERVICE AUTHORITY ROANOKE COUNTY, VIRGINIA	
SANITARY SEWERAGE SYSTEM MUD LICK CREEK INTERCEPTOR	
PROJECT No. 70-1-S STA. 10+40 TO STA. 24+00	
DES: W.H.C.	SCALE: AS SHOWN
DR: W.M.H.	DATE: 7-20-70
CR: W.E.C.	SHEET: 2 OF 7
LANGLEY, McDONALD and OVERMAN CONSULTING ENGINEERS NORFOLK, VIRGINIA	

SCALE: HOR. 1 IN. = 50 FT.
VERT. 1 IN. = 10 FT.

K-E PLAT 1, PLAN-PROFILE
KUEPPEL & ISSER CO.

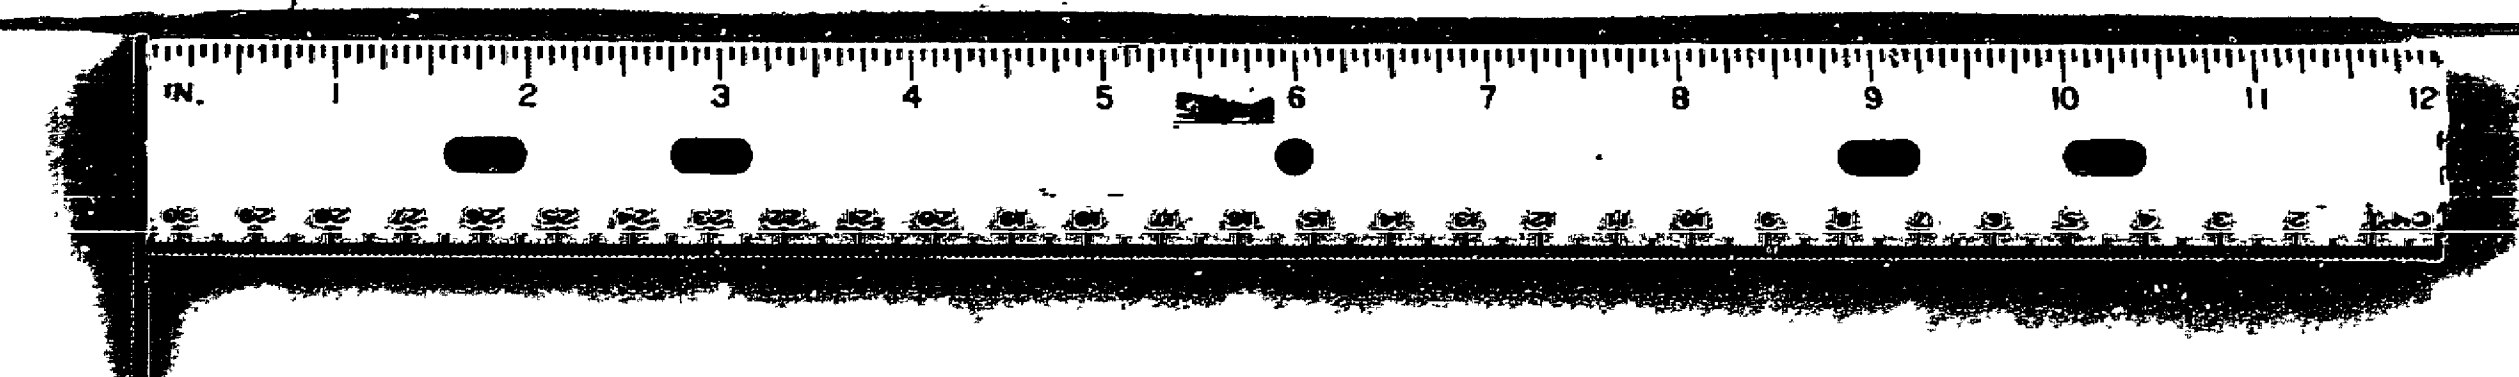

3373
SI-0141