

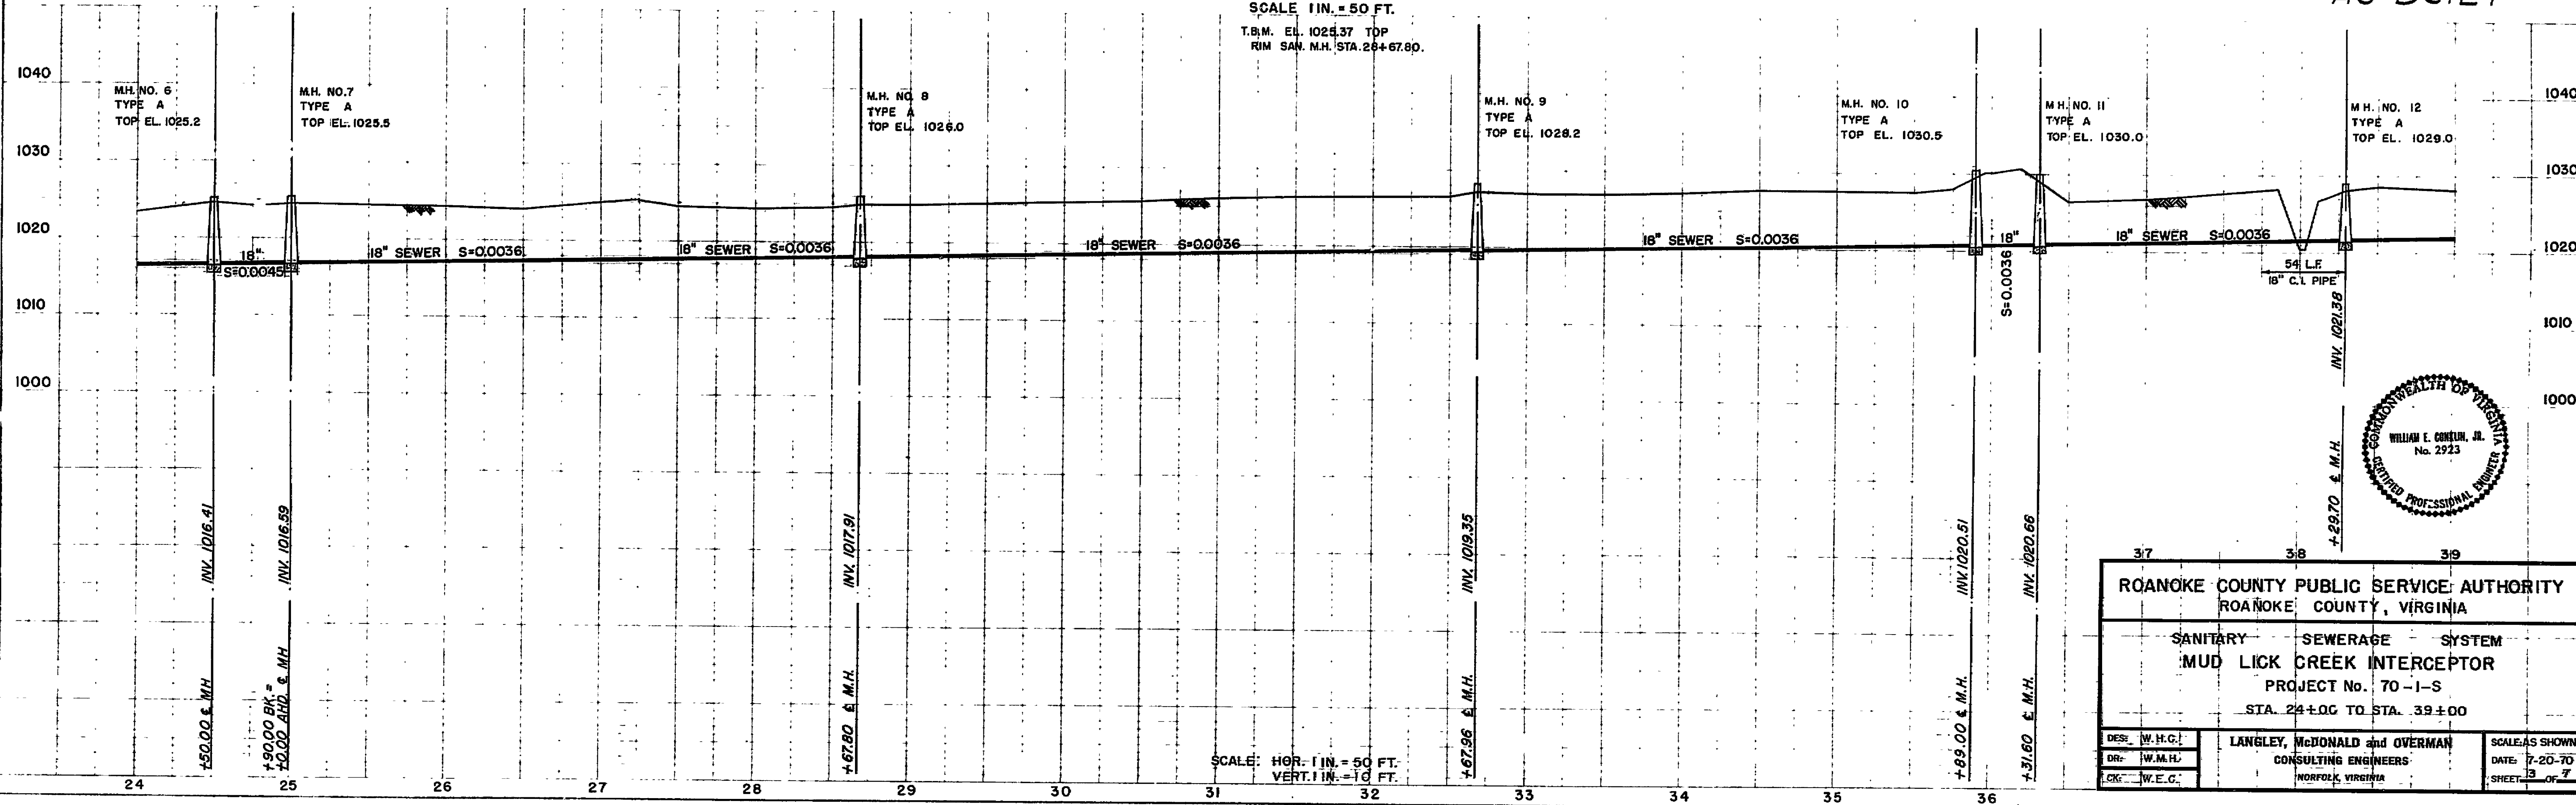


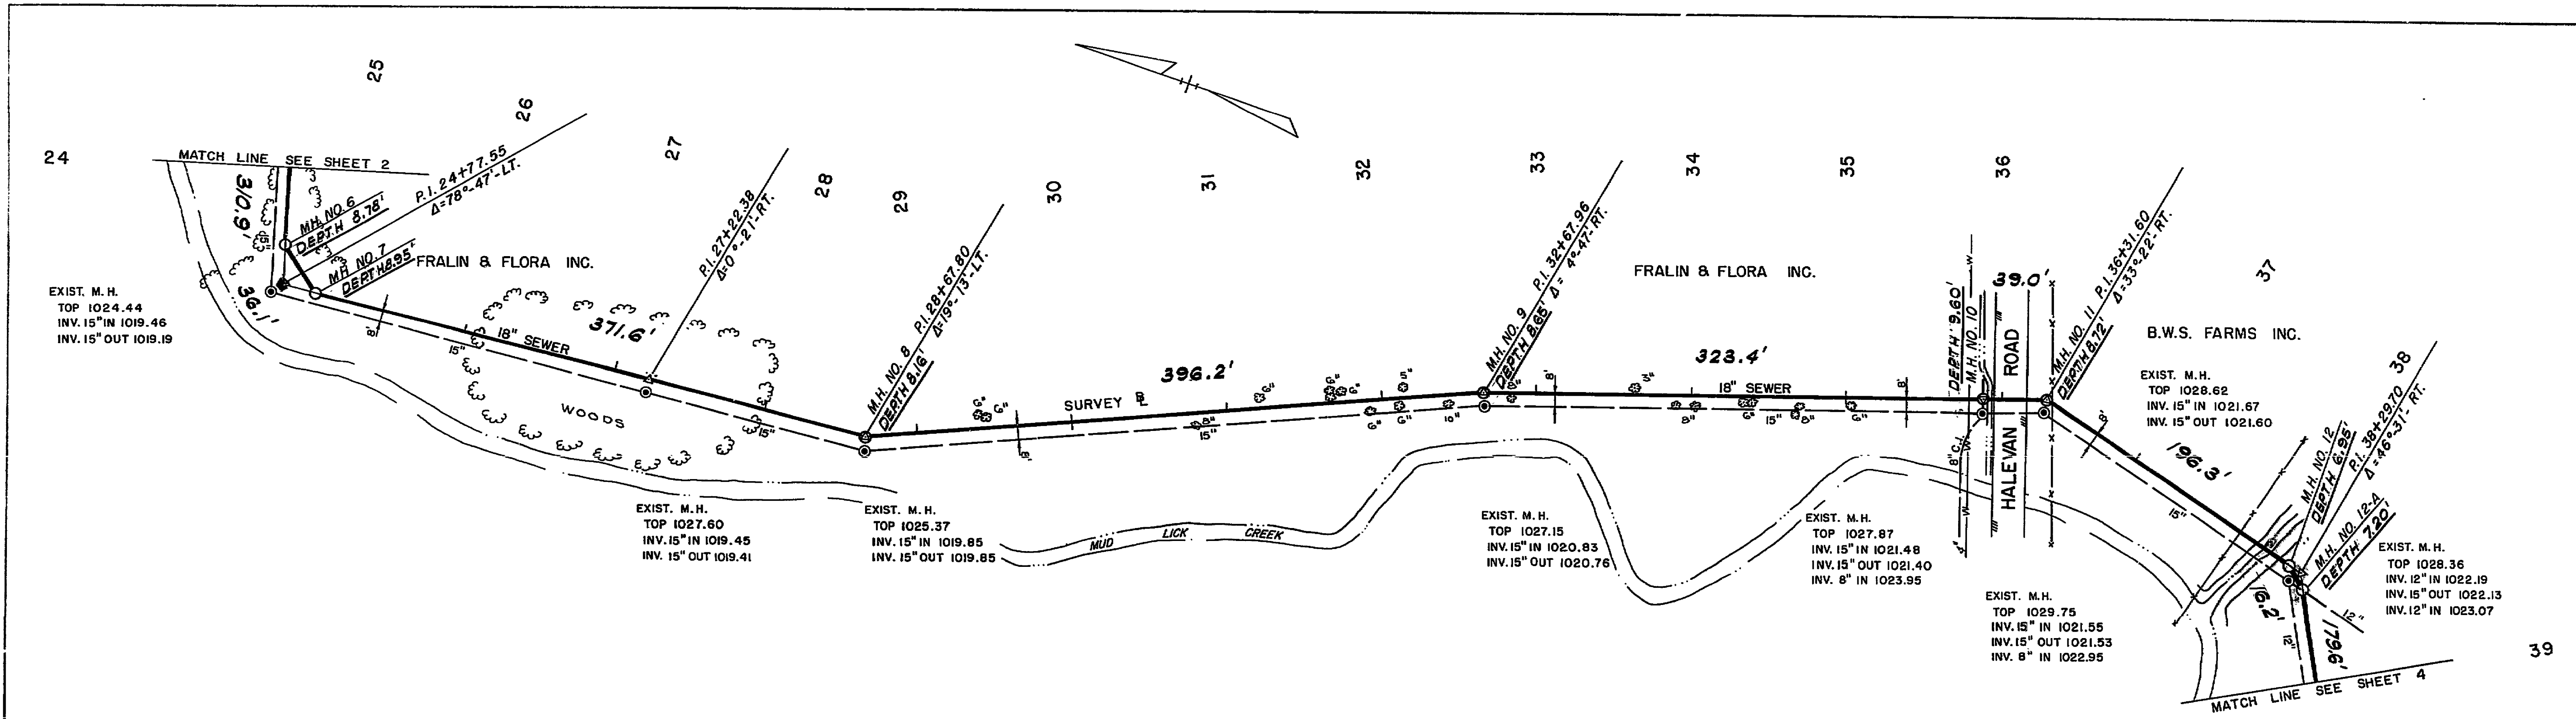

BOARD OF SUPERVISORS
ROANOKE COUNTY

AS BUILT

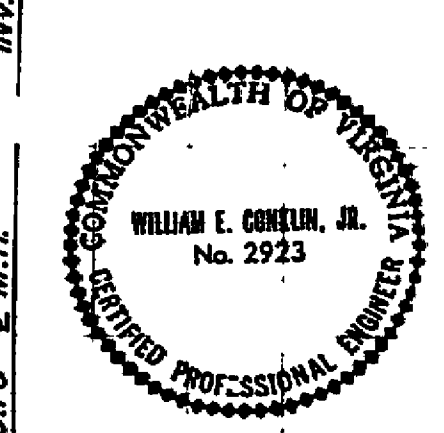

ROANOKE COUNTY PUBLIC SERVICE AUTHORITY ROANOKE COUNTY, VIRGINIA	
SANITARY SEWERAGE SYSTEM MUD LICK CREEK INTERCEPTOR PROJECT No. 70-1-S STA. 24+00 TO STA. 39+00	
DESIGN: W.H.C.	LANGLEY, McDONALD and OVERMAN
DRAWN: W.M.H.	CONSULTING ENGINEERS
CHECK: W.E.C.	NORFOLK, VIRGINIA
SCALE: AS SHOWN DATE: 7-20-70 SHEET 13 OF 17	

3374-
SE-0142