

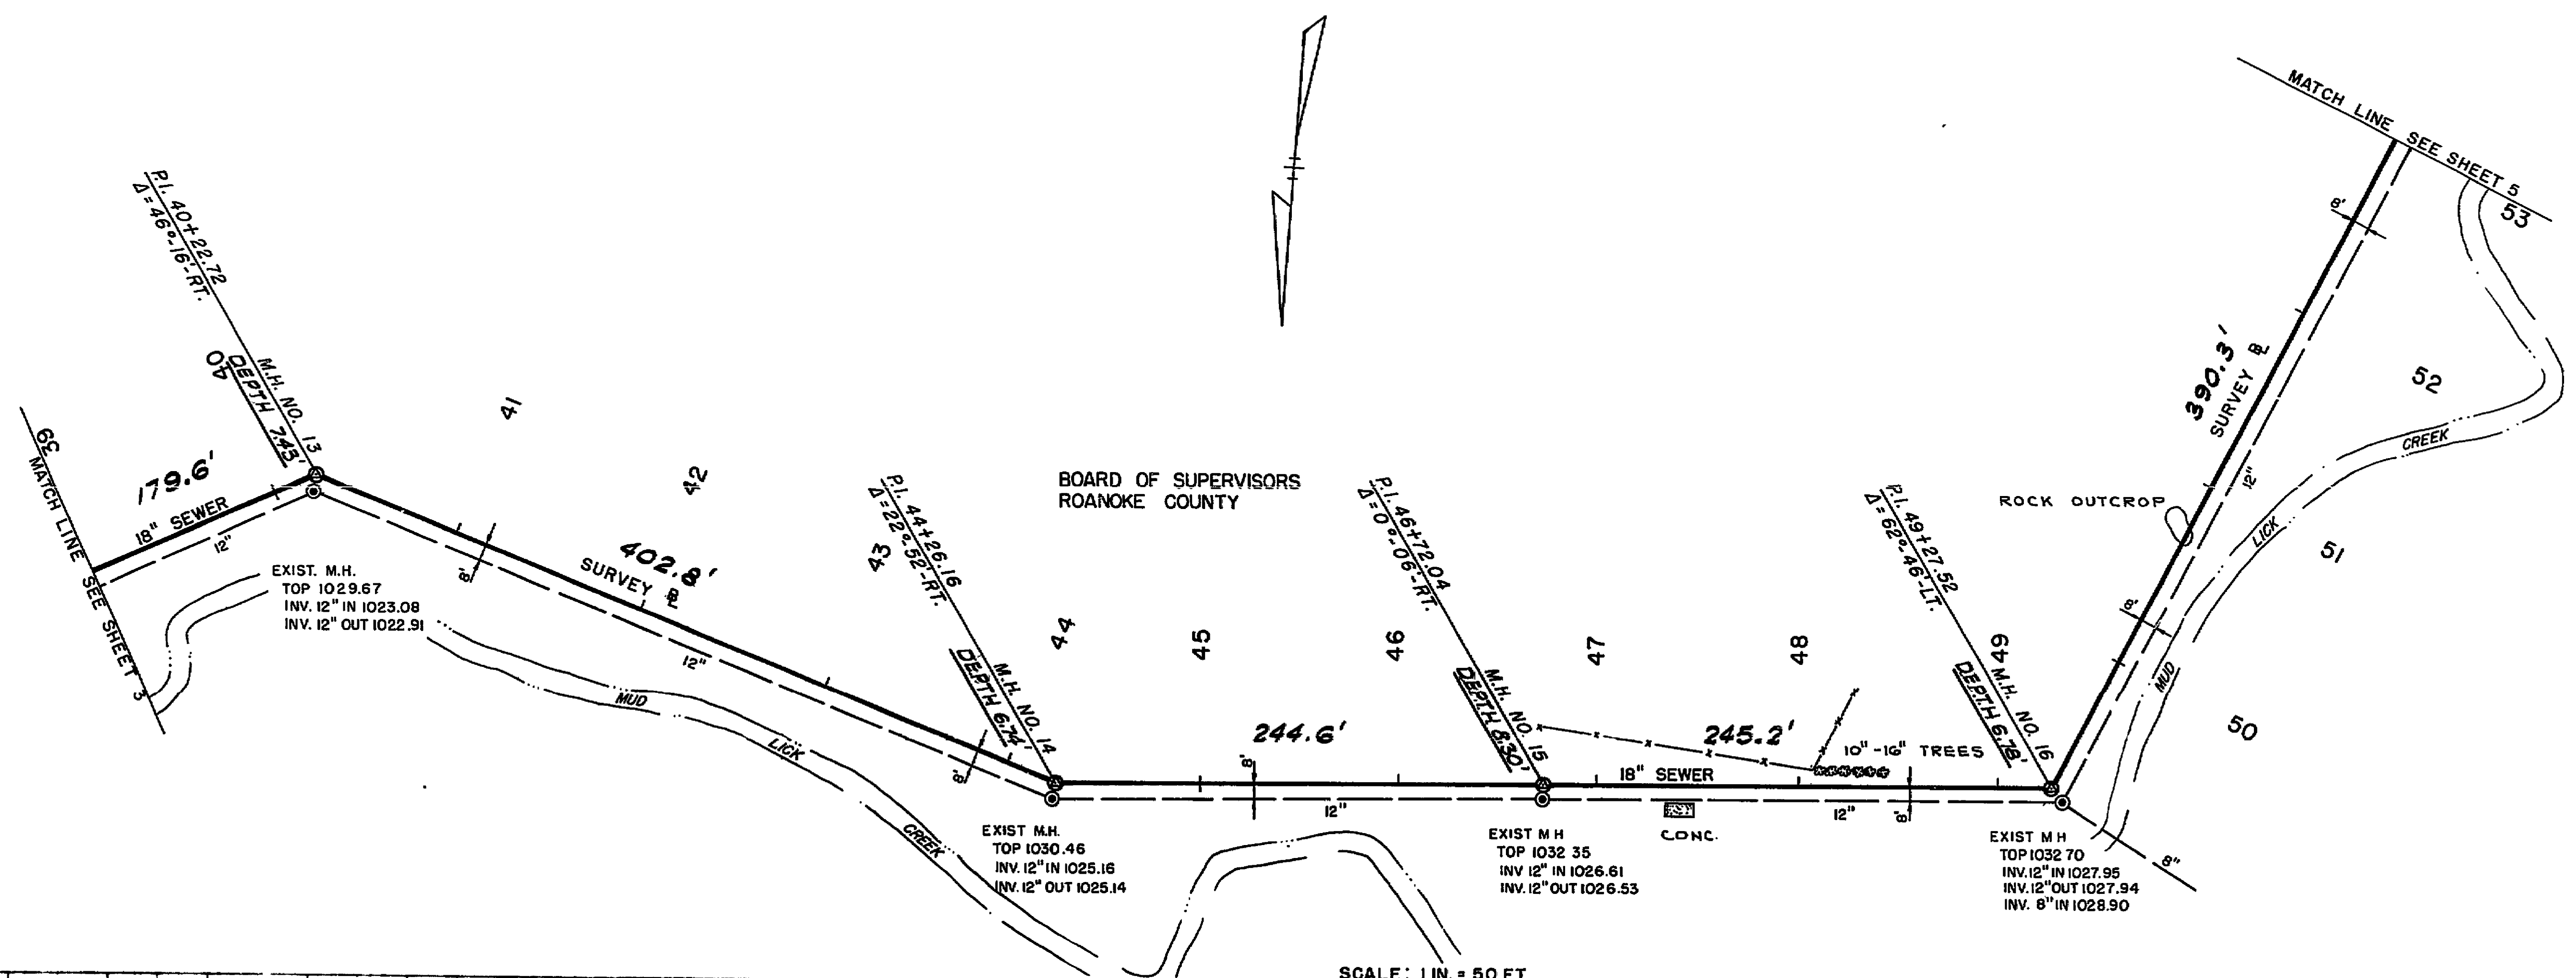


PLAN

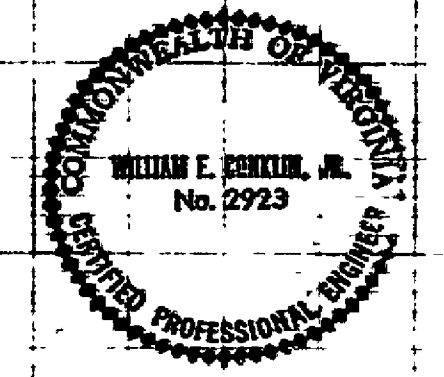

AS BUILT

PROFILE

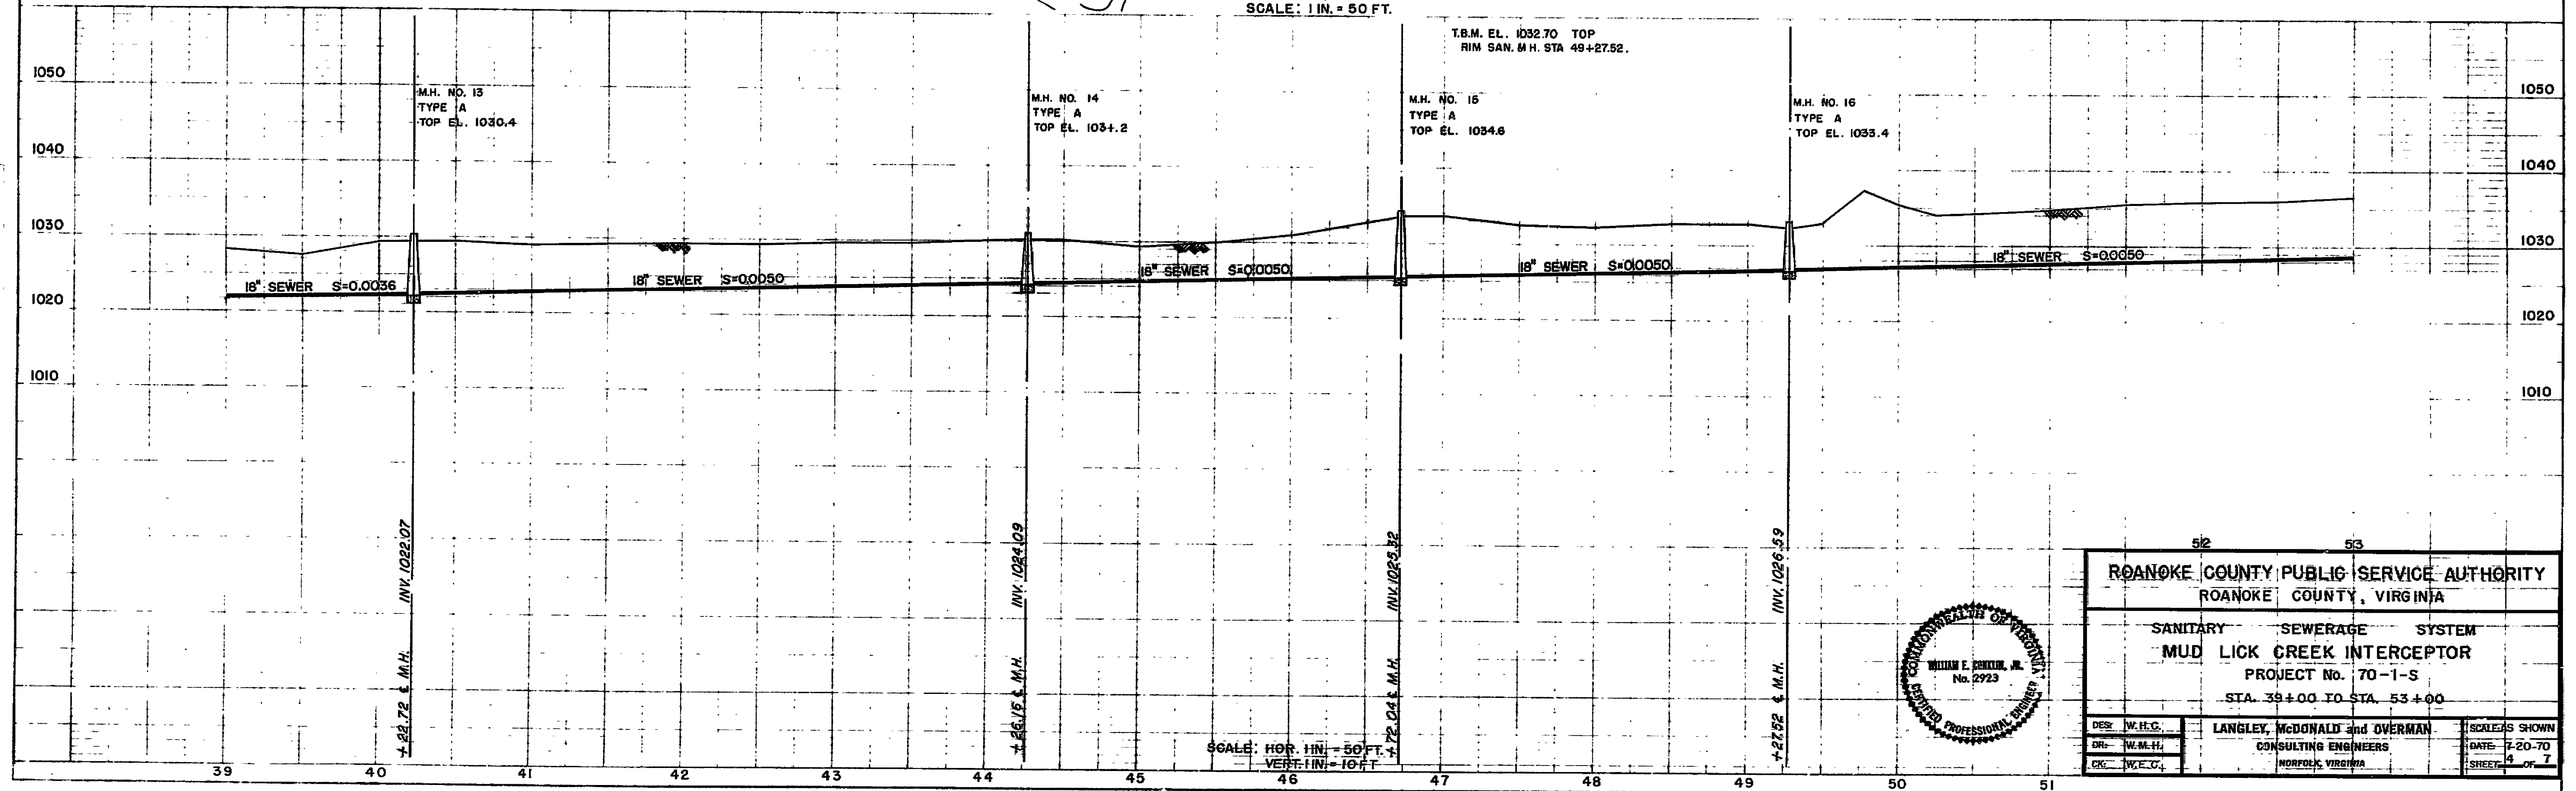

ROANOKE COUNTY PUBLIC SERVICE AUTHORITY ROANOKE COUNTY, VIRGINIA		
SANITARY SEWERAGE SYSTEM		
MUD LICK CREEK INTERCEPTOR		
PROJECT No. 70-1-S		
STA. 39+00 TO STA. 53+00		
DES. W.H.C.	LANGLEY, McDONALD and OVERMAN	SCALE: AS SHOWN
DR. W.M.H.	CONSULTING ENGINEERS	DATE: 7-20-70
CK. W.C.G.	NORFOLK, VIRGINIA	SHEET: 4 OF 7

K&E PLATE 1, PLAN-PROFILE
K&E & ESSER CO.

3375
SI-0143