

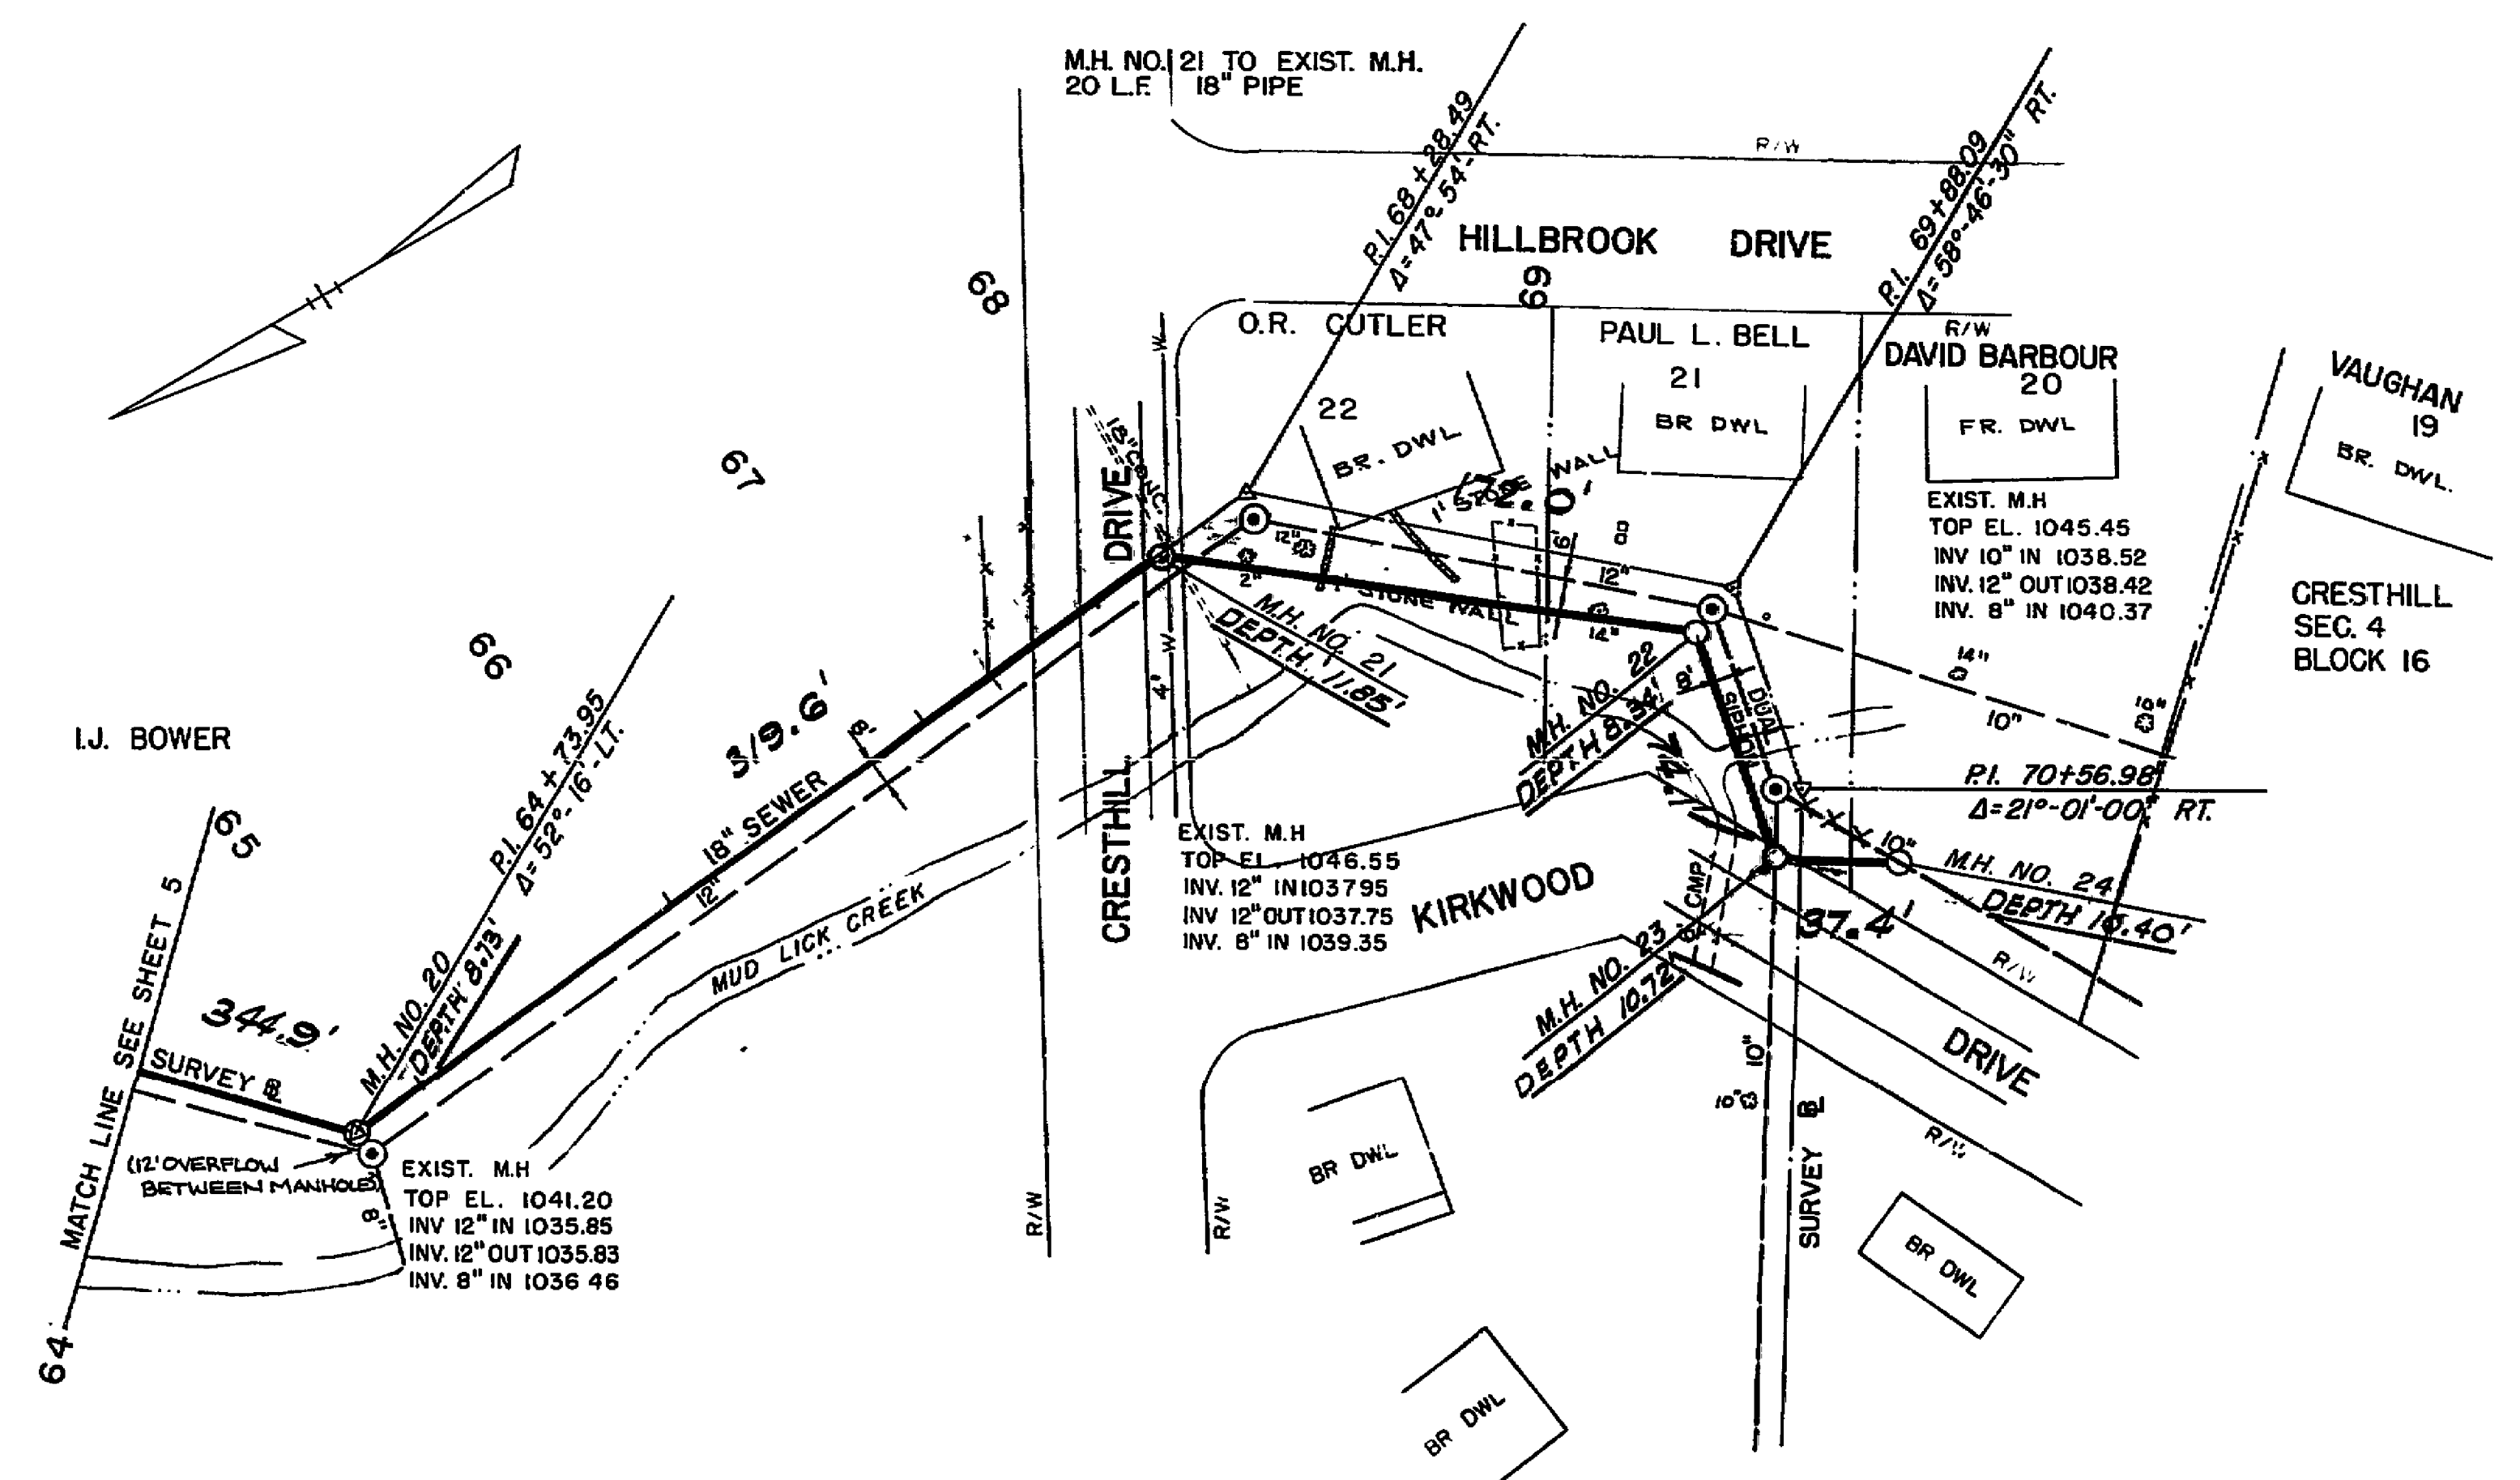


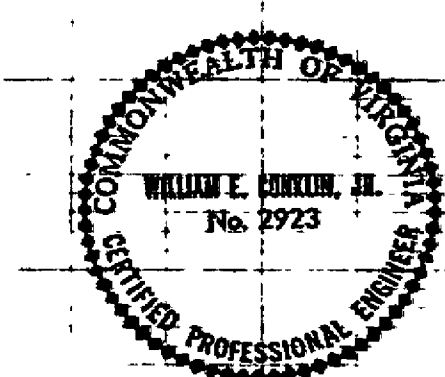

AS BUILT

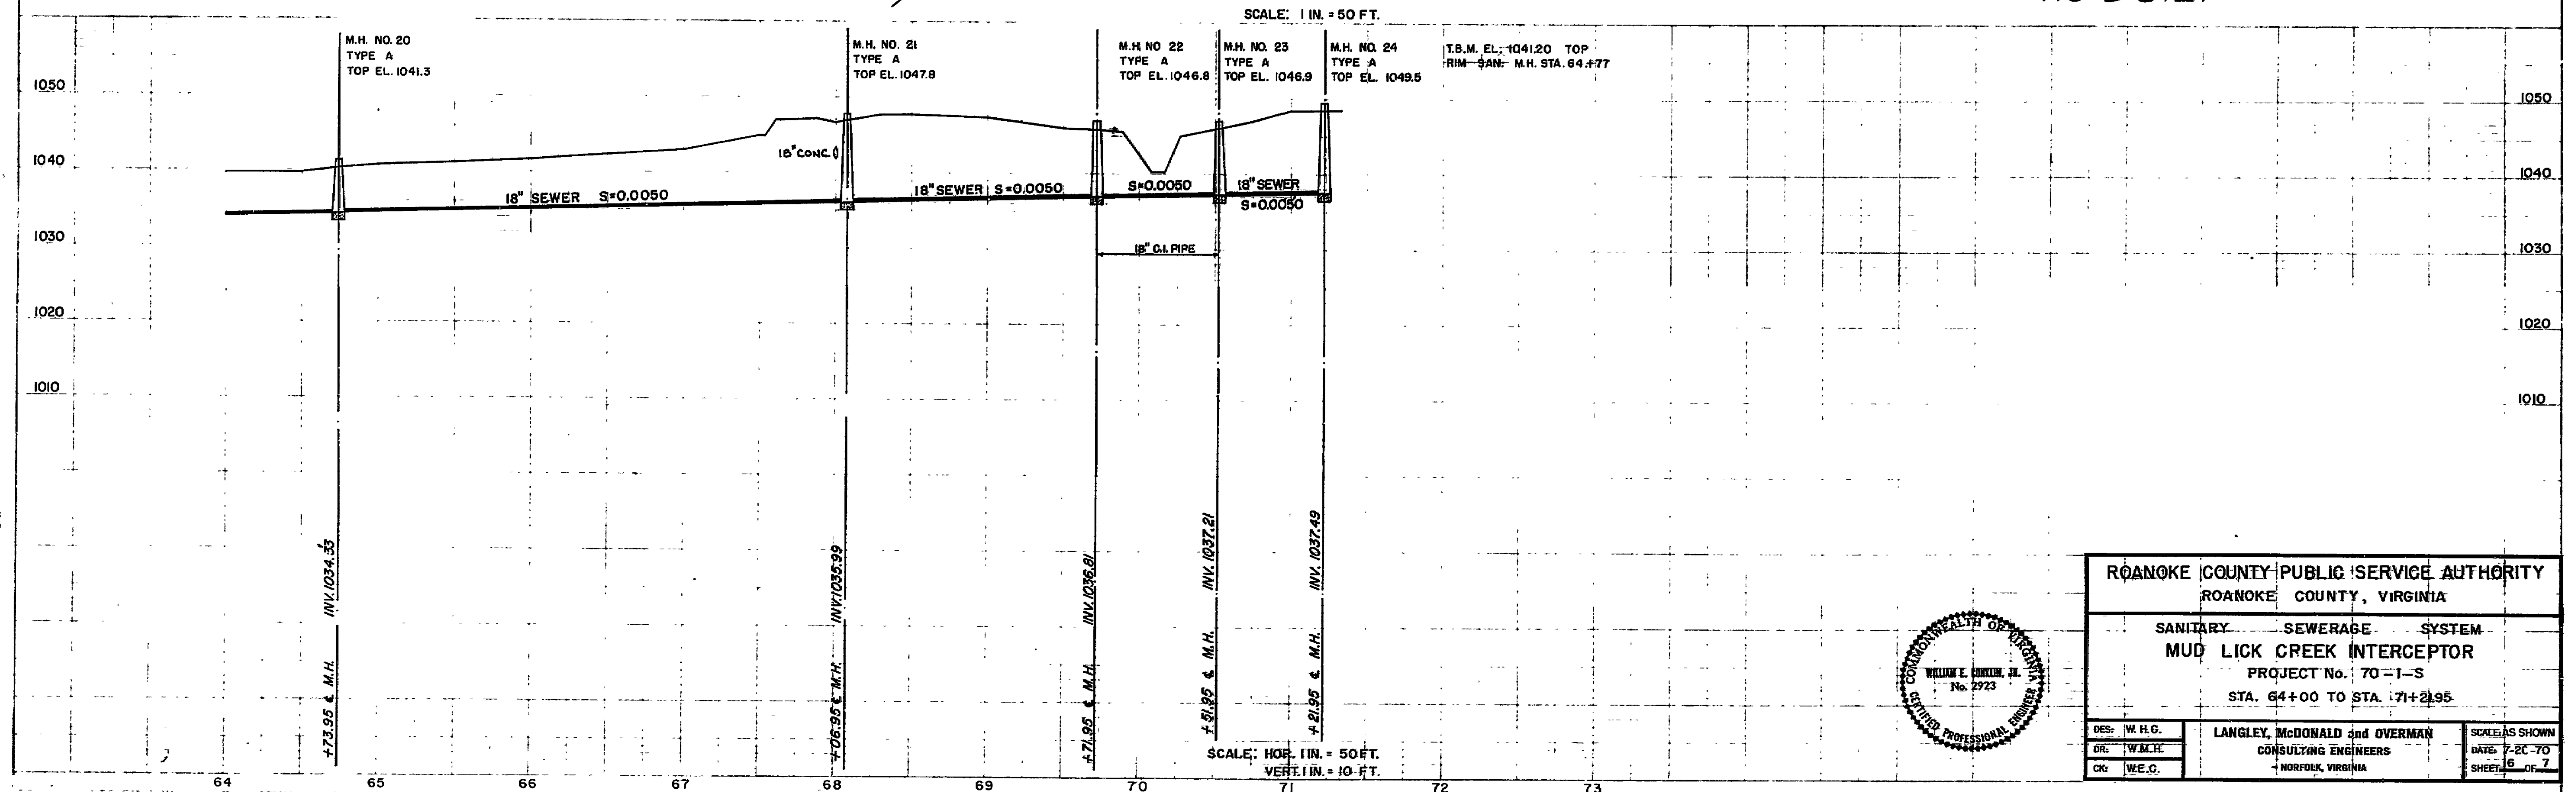

ROANOKE COUNTY PUBLIC SERVICE AUTHORITY ROANOKE COUNTY, VIRGINIA		
SANITARY SEWERAGE SYSTEM MUD LICK CREEK INTERCEPTOR		
PROJECT No. 70-1-S STA. 64+00 TO STA. 71+21.95		
DES: W.H.G.	LANGLEY, McDONALD and OVERMAN CONSULTING ENGINEERS NORFOLK, VIRGINIA	SCALE: AS SHOWN
DWG: W.M.H.		DATE: 7-20-70
CRT: W.E.C.		SHEET: 6 OF 7

PLATE 1, PLAN-PROFILE
K&E
48 "008 ALBANESE 2" X 10" PAPER

