

DATE: NOVEMBER 11, 2008

*PREPARED FOR*

WESTERN VIRGINIA WATER AUTHORITY

8x4"  
National  
SDR 35

- 
- COLONIAL AVE.
- WINDING WAY RD. S.W.
- DOGWOOD LANE S.W.
- HERITAGE RD. S.W.
- SITE**
- NORFOLK SOUTHERN
- 220
- JEFFERSON HILLS
- LOCATION MAP
- NOT TO SCALE


RECEIVED  
FEB 04 2009  
CITY OF ROANOKE  
ANNING BUILDING AND DEVELOPMENT

SIGNATURE: . . . . .  
PRINTED NAME: . . . . .  
CERTIFICATE No.: . . . . .  
EXPIRATION DATE: . . . . .  
TELEPHONE No.: . . . . .  
ADDRESS: . . . . .  
.




**LUMSDEN ASSOCIATES, P.C.**  
**ENGINEERS-SURVEYORS-PLANNERS**

PHONE: (540) 774-4411  
FAX: (540) 772-9445  
E-MAIL: MAIL@LUMSDENPC.COM

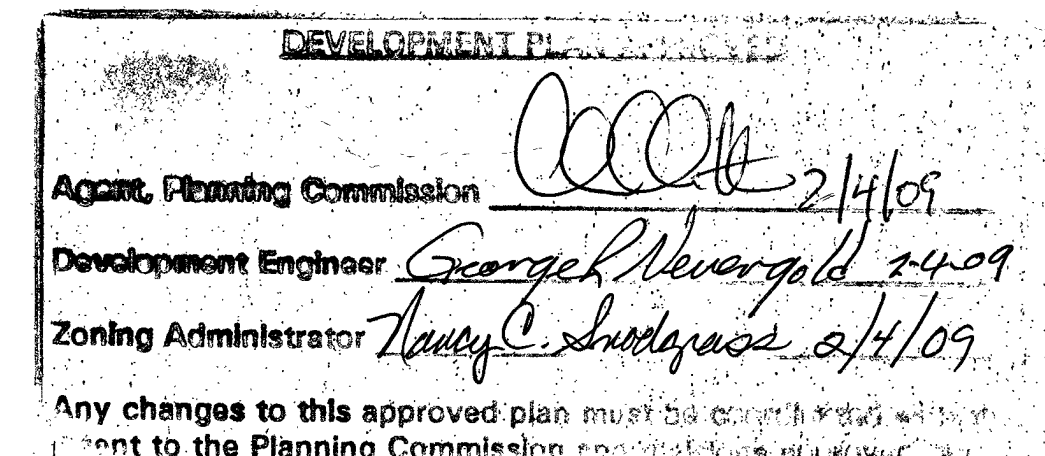

AS-Built 10/16/2009

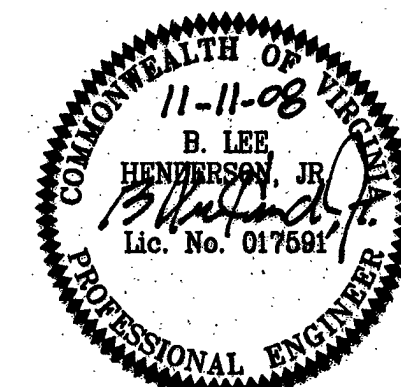

REVISIONS	
DATE	SHEETS

COMMISSION NO. 06-030

SHEET 1 OF 4