

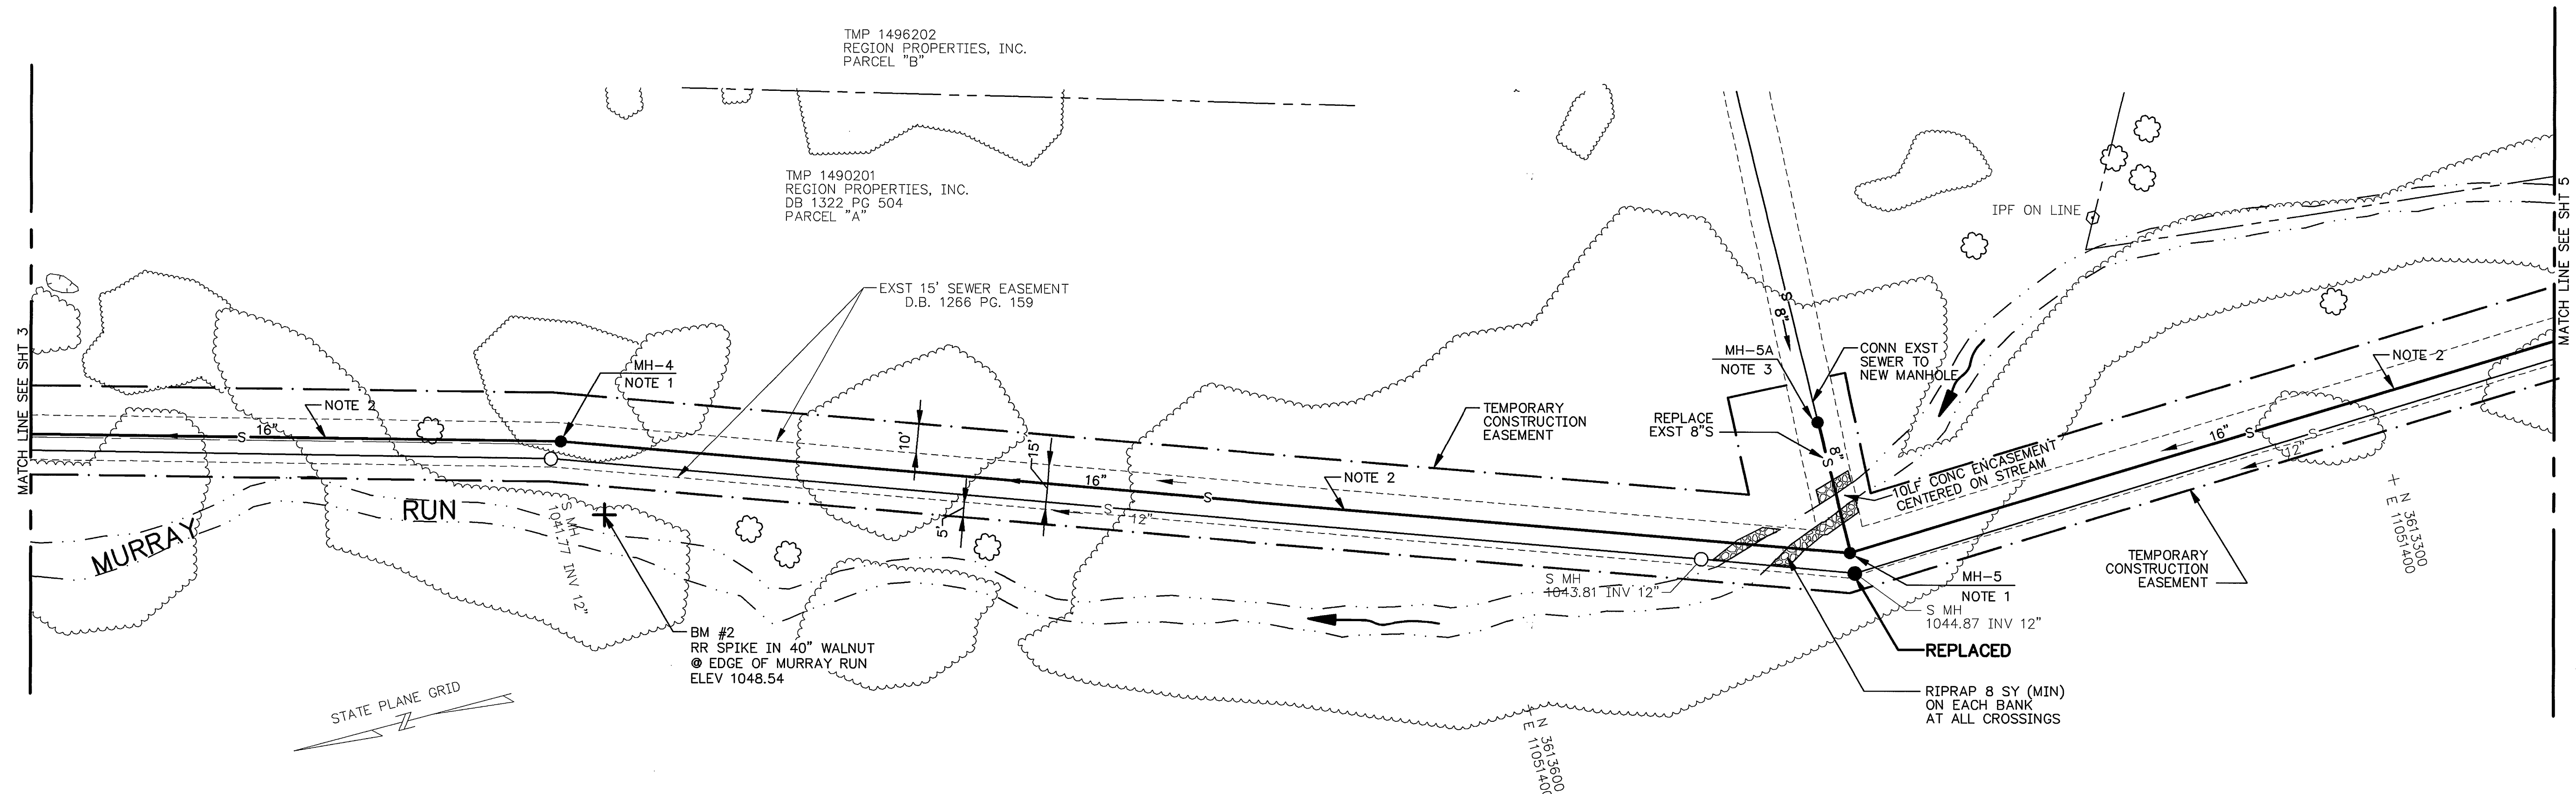


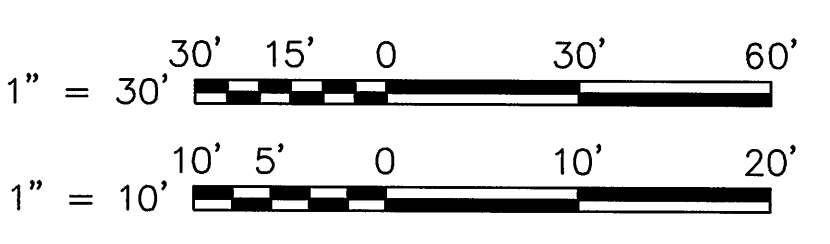


- NOTES:
1. REMOVE EXST MANHOLE AND CONSTRUCT NEW MANHOLE.
 2. REMOVE EXST 12" SEWER AND BEDDING MATERIAL AND CONSTRUCT NEW 16" SEWER.
 3. MATCH INVERT OF EXST PIPE, DROP INVERT 0.2' THROUGH MANHOLE.
 4. SEE PROJECT MANUAL FOR SUPPLEMENTARY DRAWINGS.
 5. DISTANCE BETWEEN MANHOLES ARE FROM ϕ OF MANHOLE TO ϕ OF MANHOLE.
 6. INVERTS AND PIPE SLOPES ARE FROM INSIDE FACE OF MANHOLE TO INSIDE FACE OF MANHOLE.

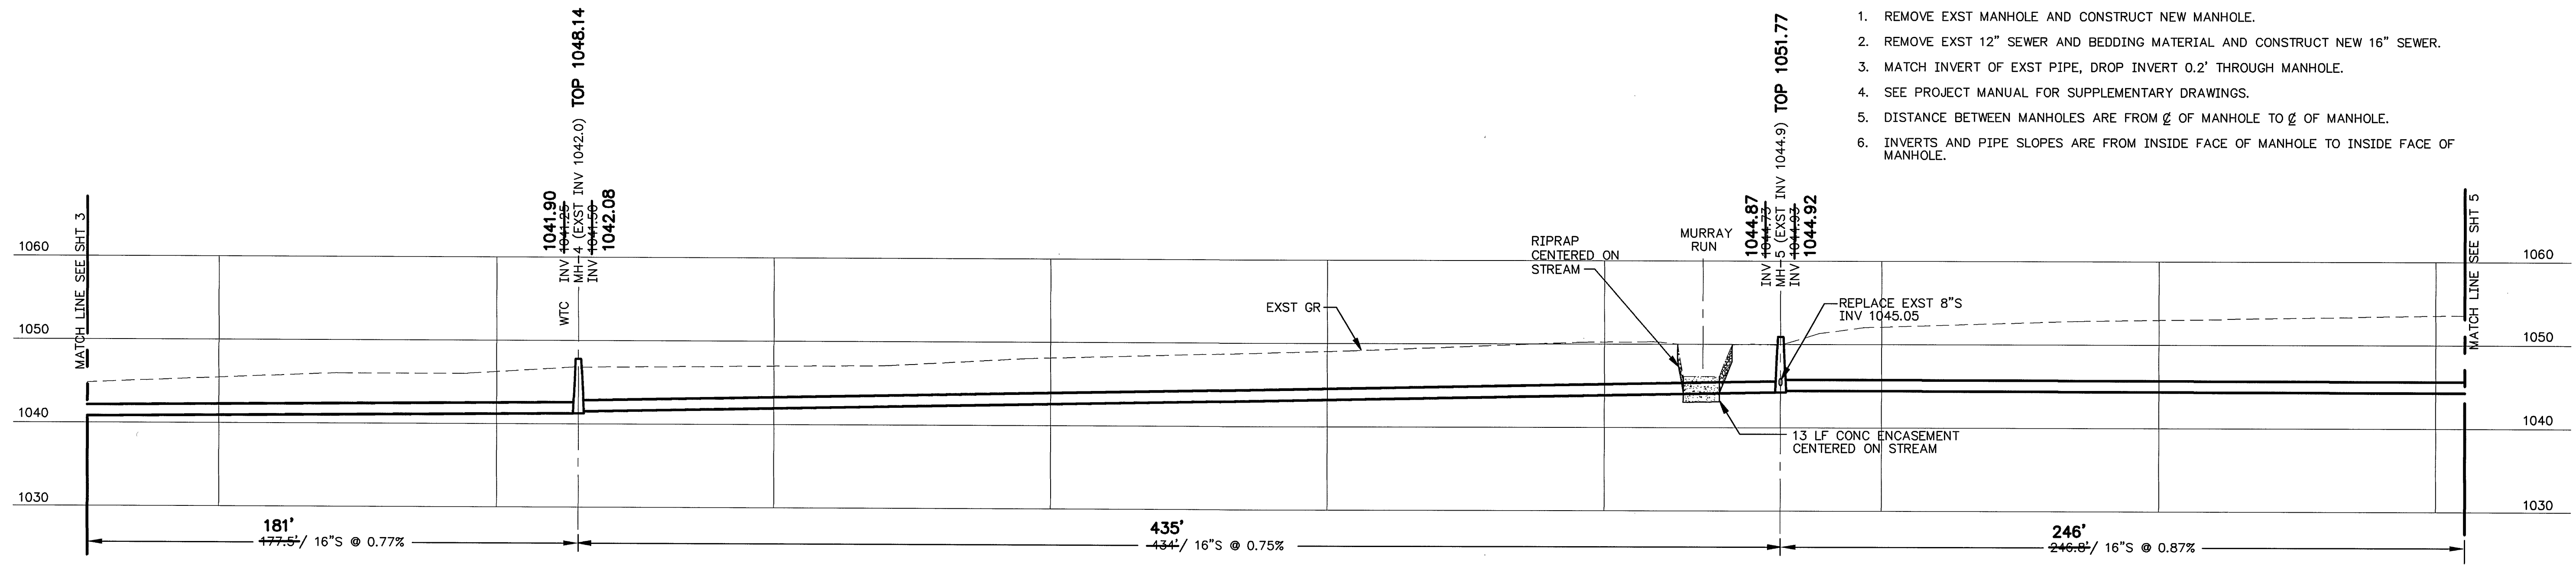

HAYES, SEAY, MATTERN AND MATTERN
ARCHITECTS/ENGINEERS/PLANNERS

DESIGNED: DMH
DRAWN: ACF
CHECKED: SJP
APPROVED: WMZ

REVISIONS		
DATE	BY	DESCRIPTION
8/1/96	DMH	RECORD DRAWING PREPARED BASED ON INFORMATION PROVIDED BY AARON J. CONNER GENERAL CONTRACTOR, INC., NOT FIELD VERIFIED BY HSM, INC.

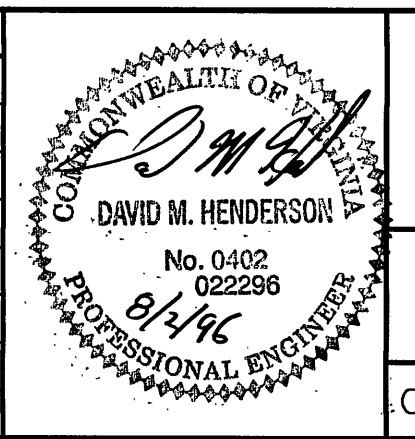

SEWER REPLACEMENT MR-1
ROANOKE, VIRGINIA
PLAN AND PROFILE

COMM. NO.: 7122E SCALE: AS SHOWN DATE: 5 JAN 1995

SHEET NO.
4