



VICINITY MAP

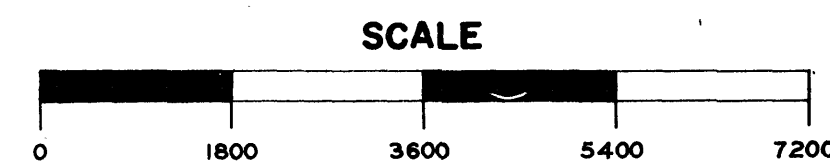

INDEX OF SHEETS

SHEET NO.	DESCRIPTION
1	COVER SHEET
2	SUMMARY SHEET
3	PLAN & PROFILE SHEET
4	
5	
18	TYPICAL SECTIONS METERING CHAMBER METERING CHAMBER

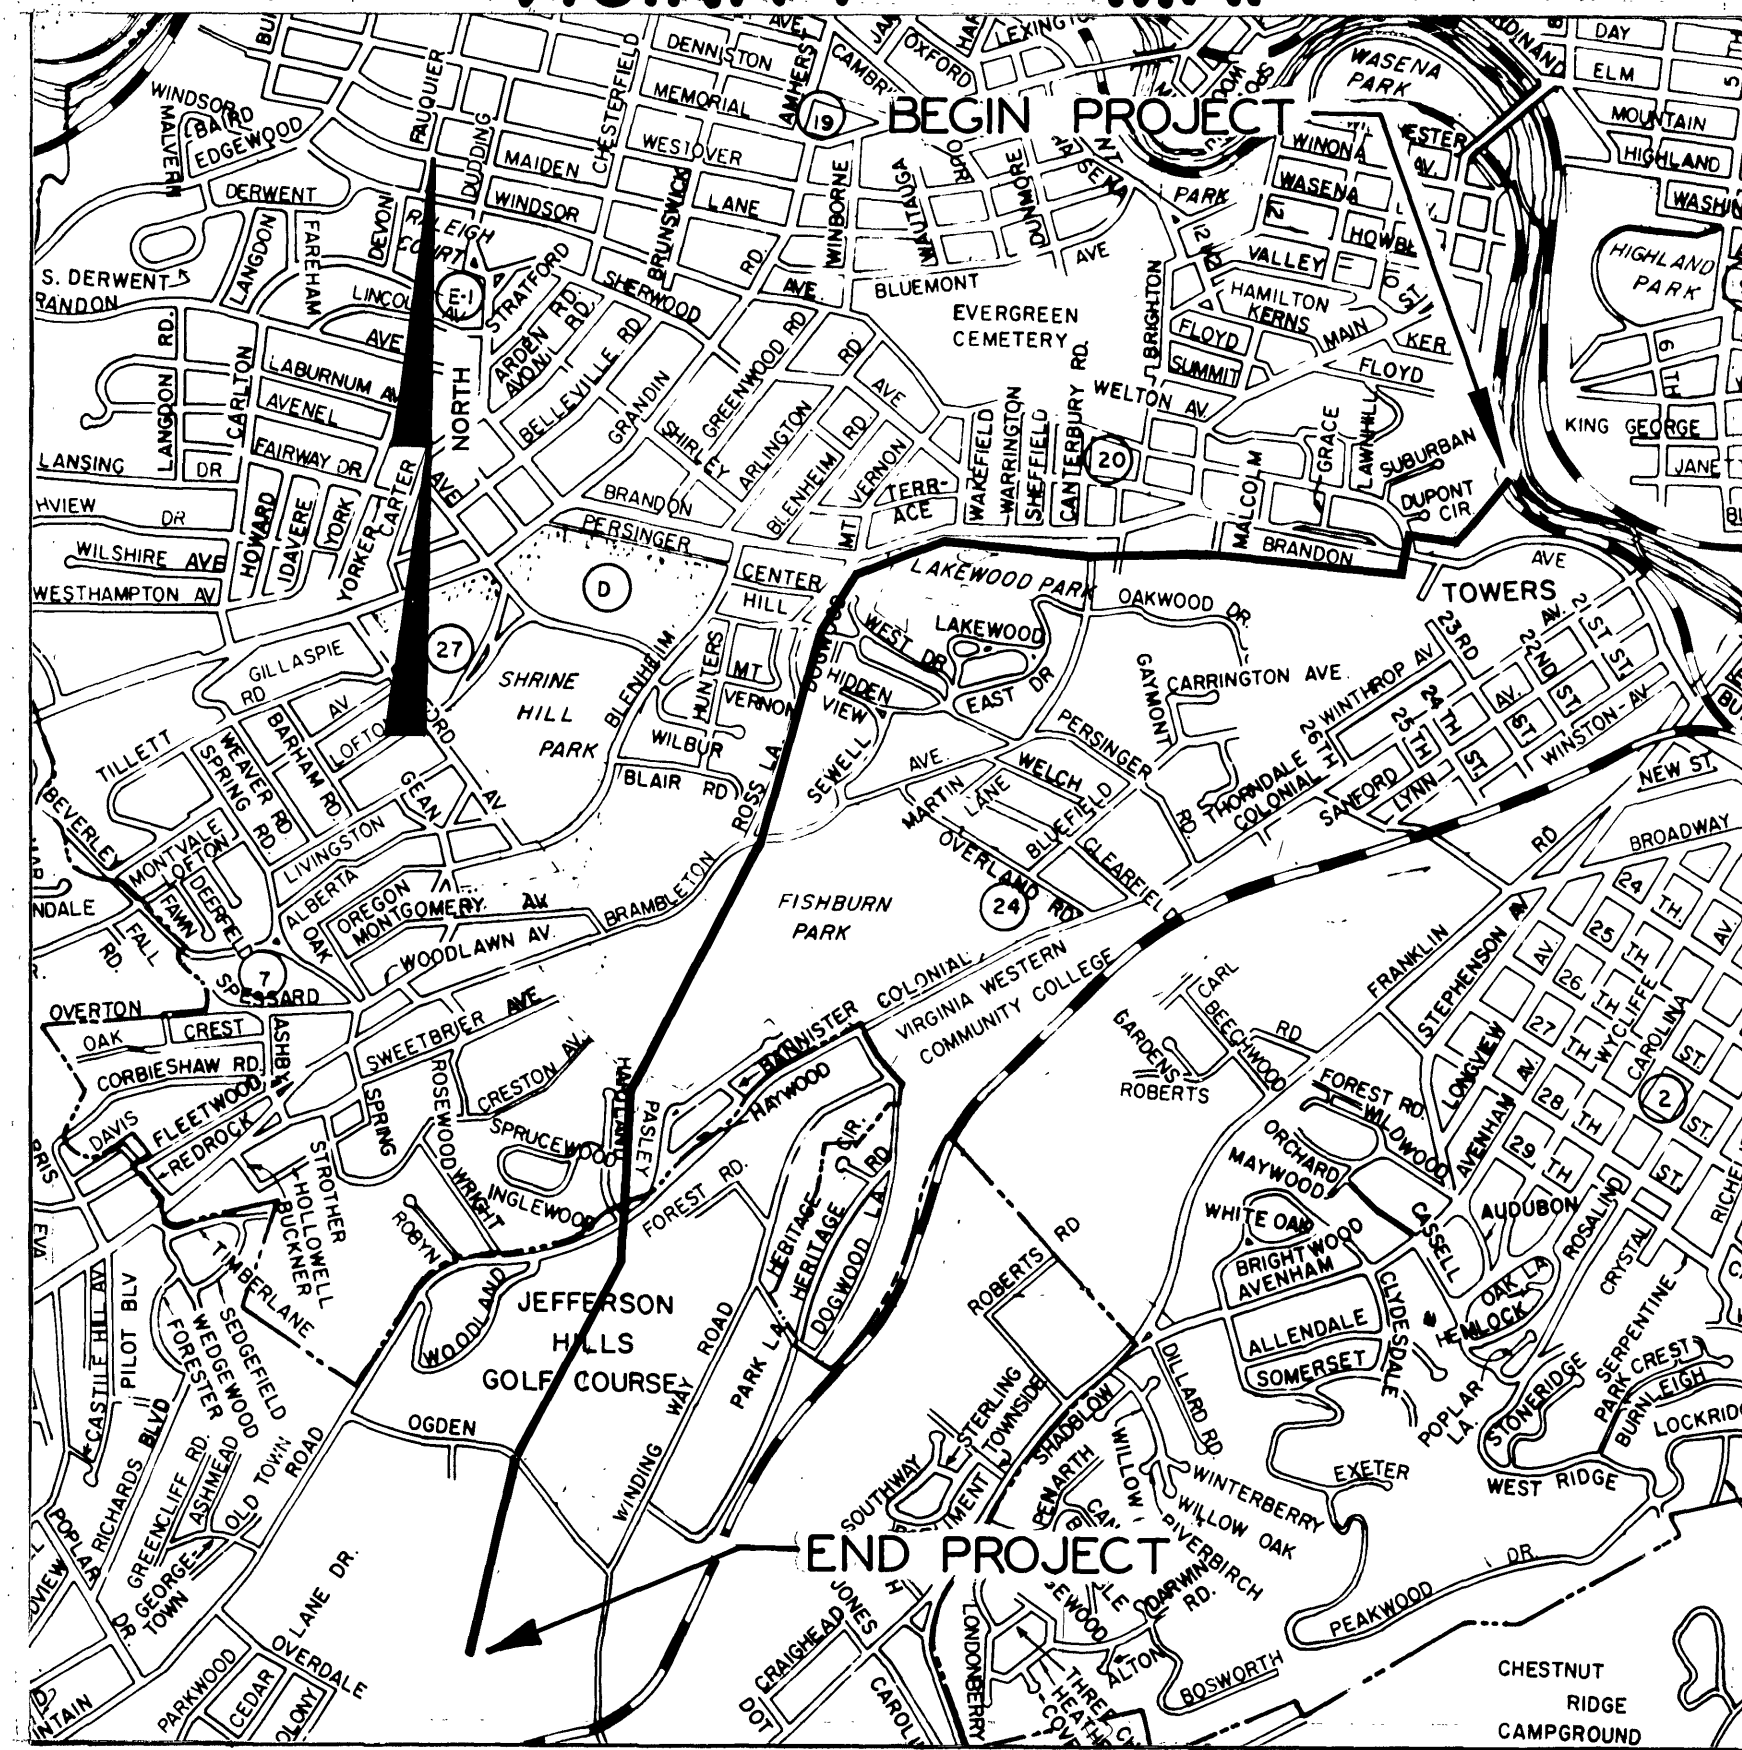

ROANOKE , VIRGINIA

OFFICE OF CITY ENGINEER CONSTRUCTION PLAN

PROPOSED MURRAY RUN SANITARY SEWER REPLACEMENT
FROM: ROANOKE RIVER INTERCEPTOR LINE
TO: 0.397 MILE SOUTH OGDEN ROAD

AS BUILT

F.B. 597

APPROVED FOR CONSTRUCTION	
8-5-74	Charles D. Hutchins
DATE	CITY ENGINEER
DATE	
DATE	
APPROVED
DATE
APPROVED
DATE

4	9-20-74		
6	9-20-74		
7	9-20-74		
13	9-20-74		
14	9-20-74		
SHEET NO.	DATE	SHEET NO.	DATE
PLANS REVISED			

SHEET 1 OF 18

PLAN NO. 5412