

PLAN	SURVED	DATE
NOTE BOOK	ALIGNMENT CHECKED	
No.	BY	

PROFILE	SURVED	DATE
NOTE BOOK	GRADES CHECKED	
No.	BY	

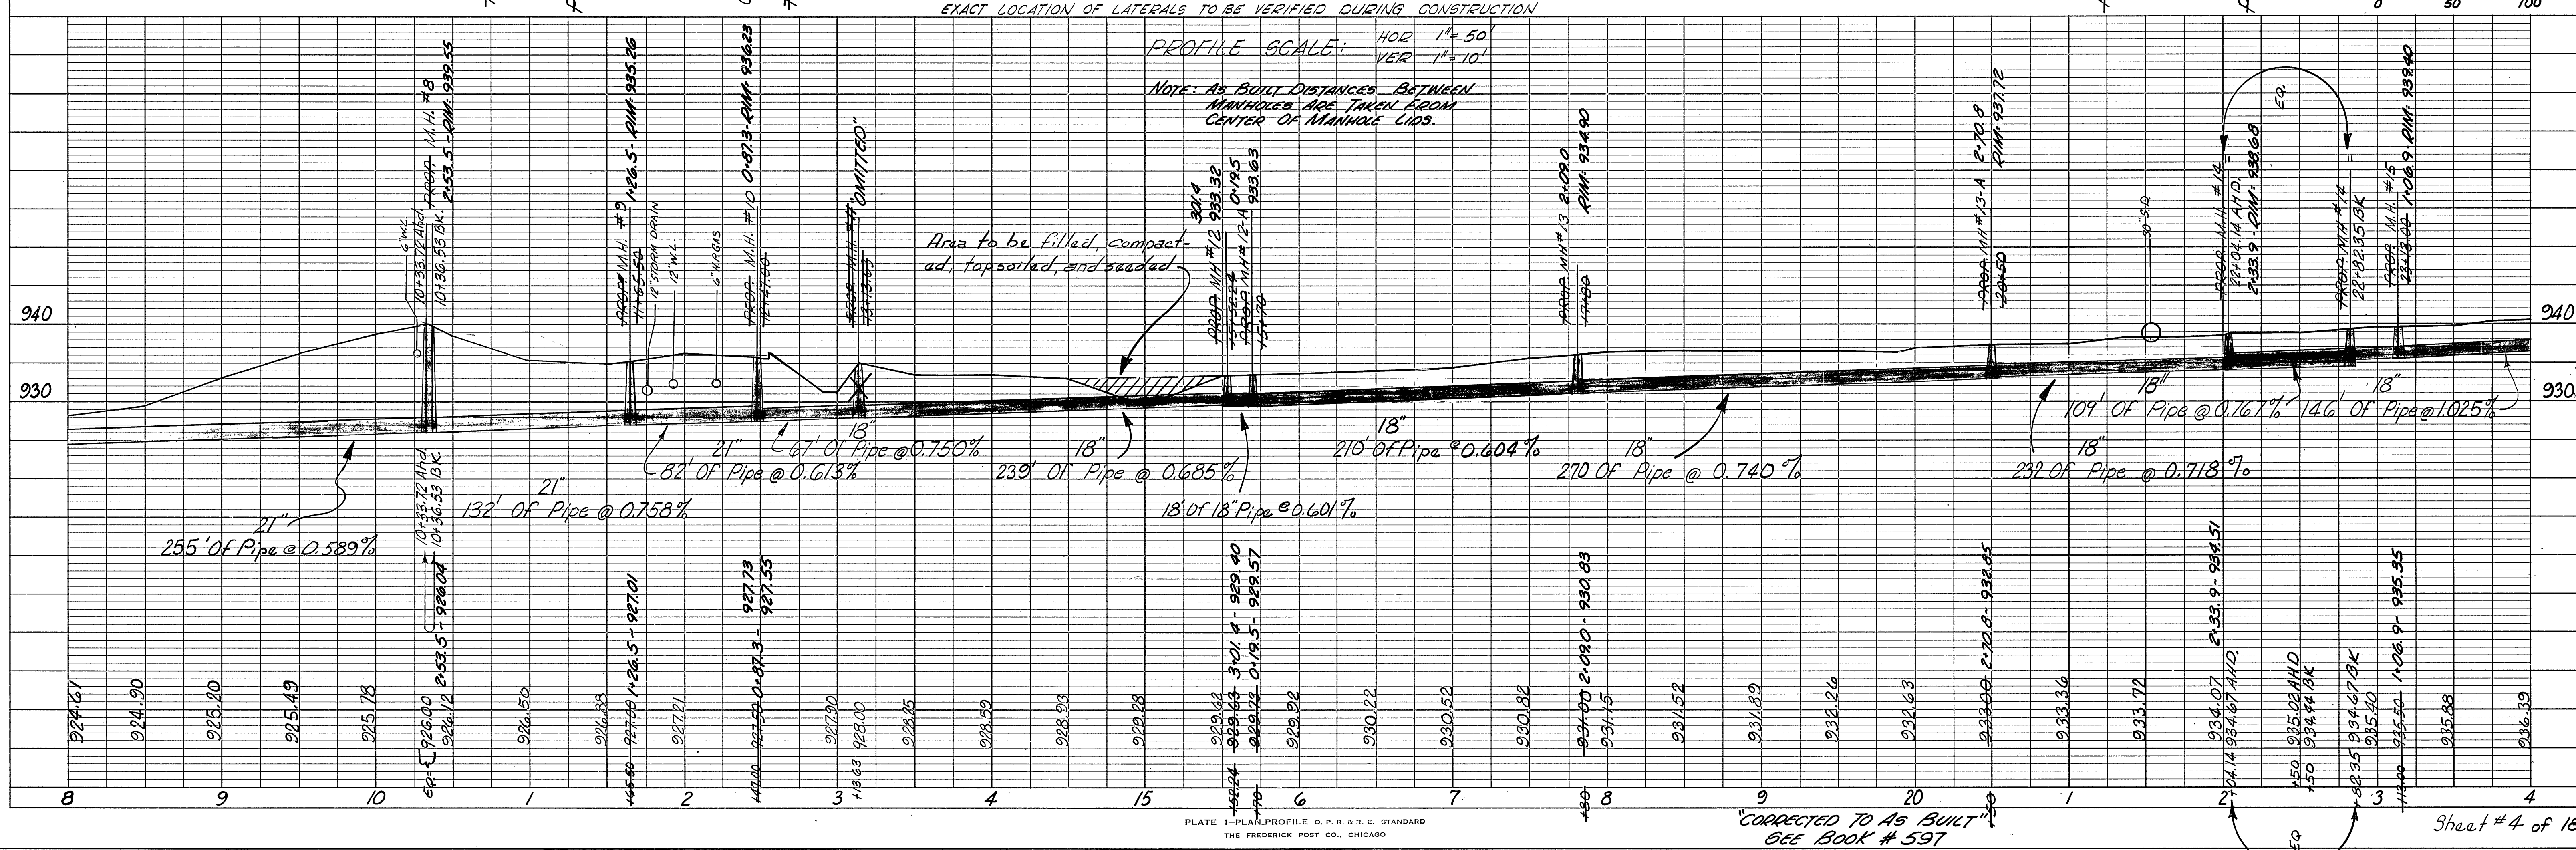
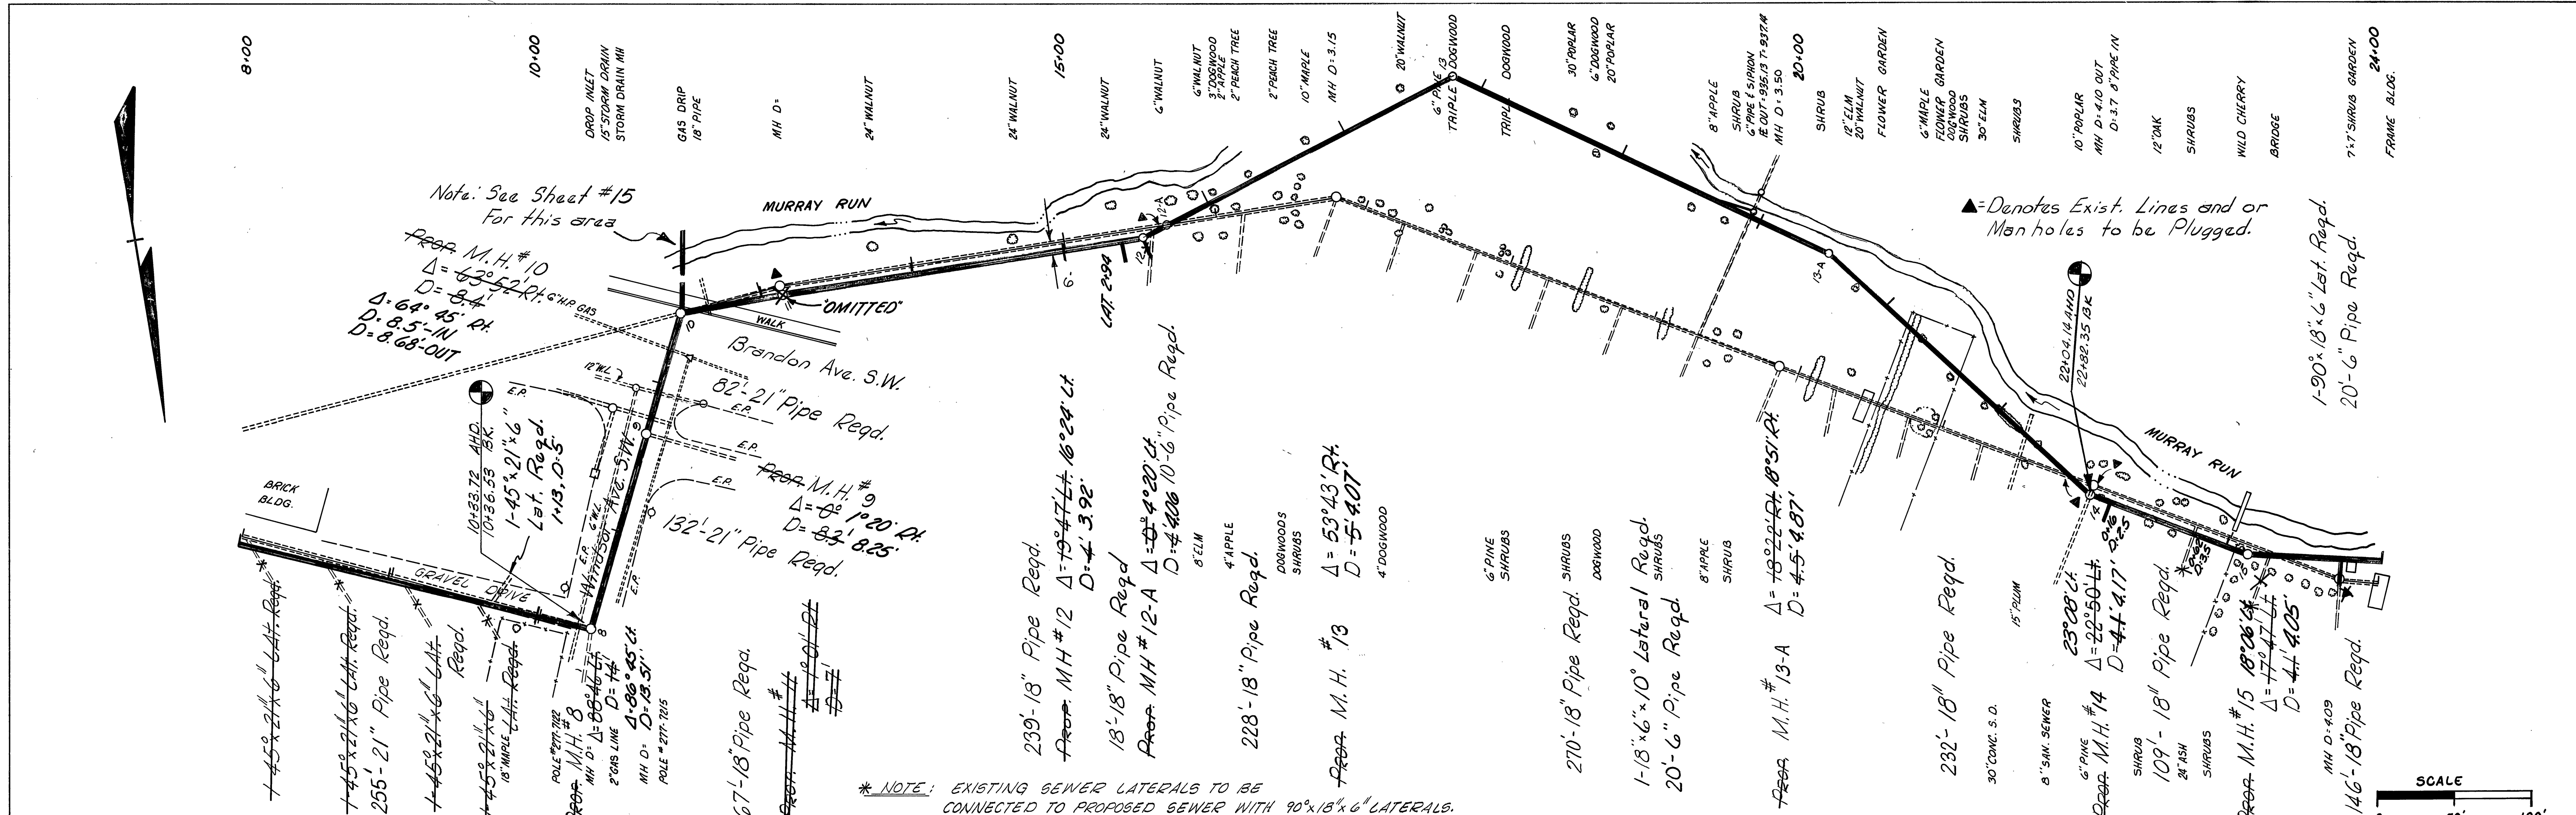


PLATE 1-PLAN PROFILE O. P. & R. E. STANDARD
THE FREDERICK POST CO., CHICAGO

"CORRECTED TO AS BUILT"
SEE BOOK # 597

Sheet # 4 of 18

PLAN No. 54/2