

PLAN	SURVEYED _____		BY _____	DATE _____
	PLOTTED _____			
	ALIGNMENT CHECKED _____			
	RT. OF WAY CHECKED _____			
No. _____				

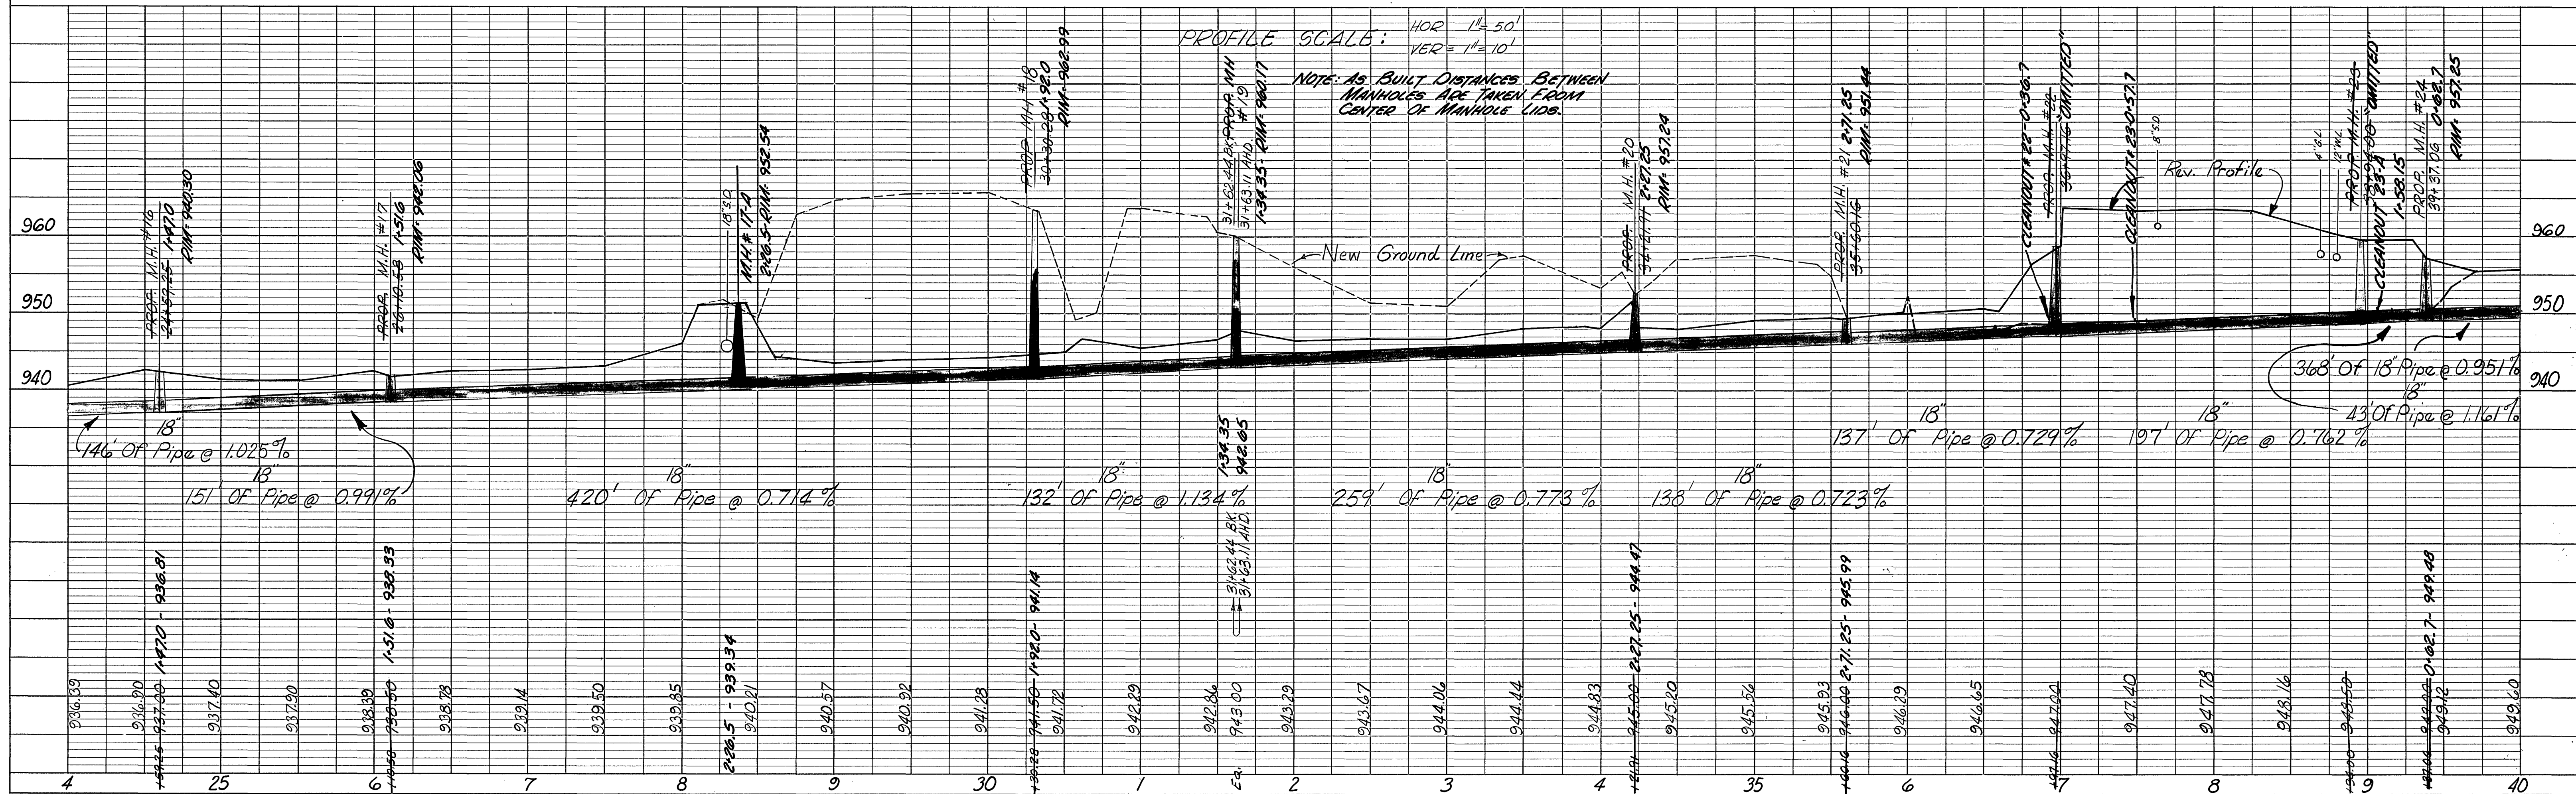


PLATE 1-PLAN PROFILE O. P. R. & R. E. STANDARD
THE FREDERICK POST CO., CHICAGO

"CORRECTED TO AS BUILT"
SEE BOOK # 597

"ADDENDUM No: 2" Sheet #5 of 18
"ITEM 5" PLAN No. 5412