



PLAN	SURVEYED	DATE
NO.	BY	
NOTE: AS BUILT DISTANCES BETWEEN MANHOLES WERE TAKEN FROM CENTER OF MANHOLE LIDS.		

PROFILE	SURVEYED	DATE
NO.	BY	
NOTE: AS BUILT DISTANCES BETWEEN MANHOLES WERE TAKEN FROM CENTER OF MANHOLE LIDS.		

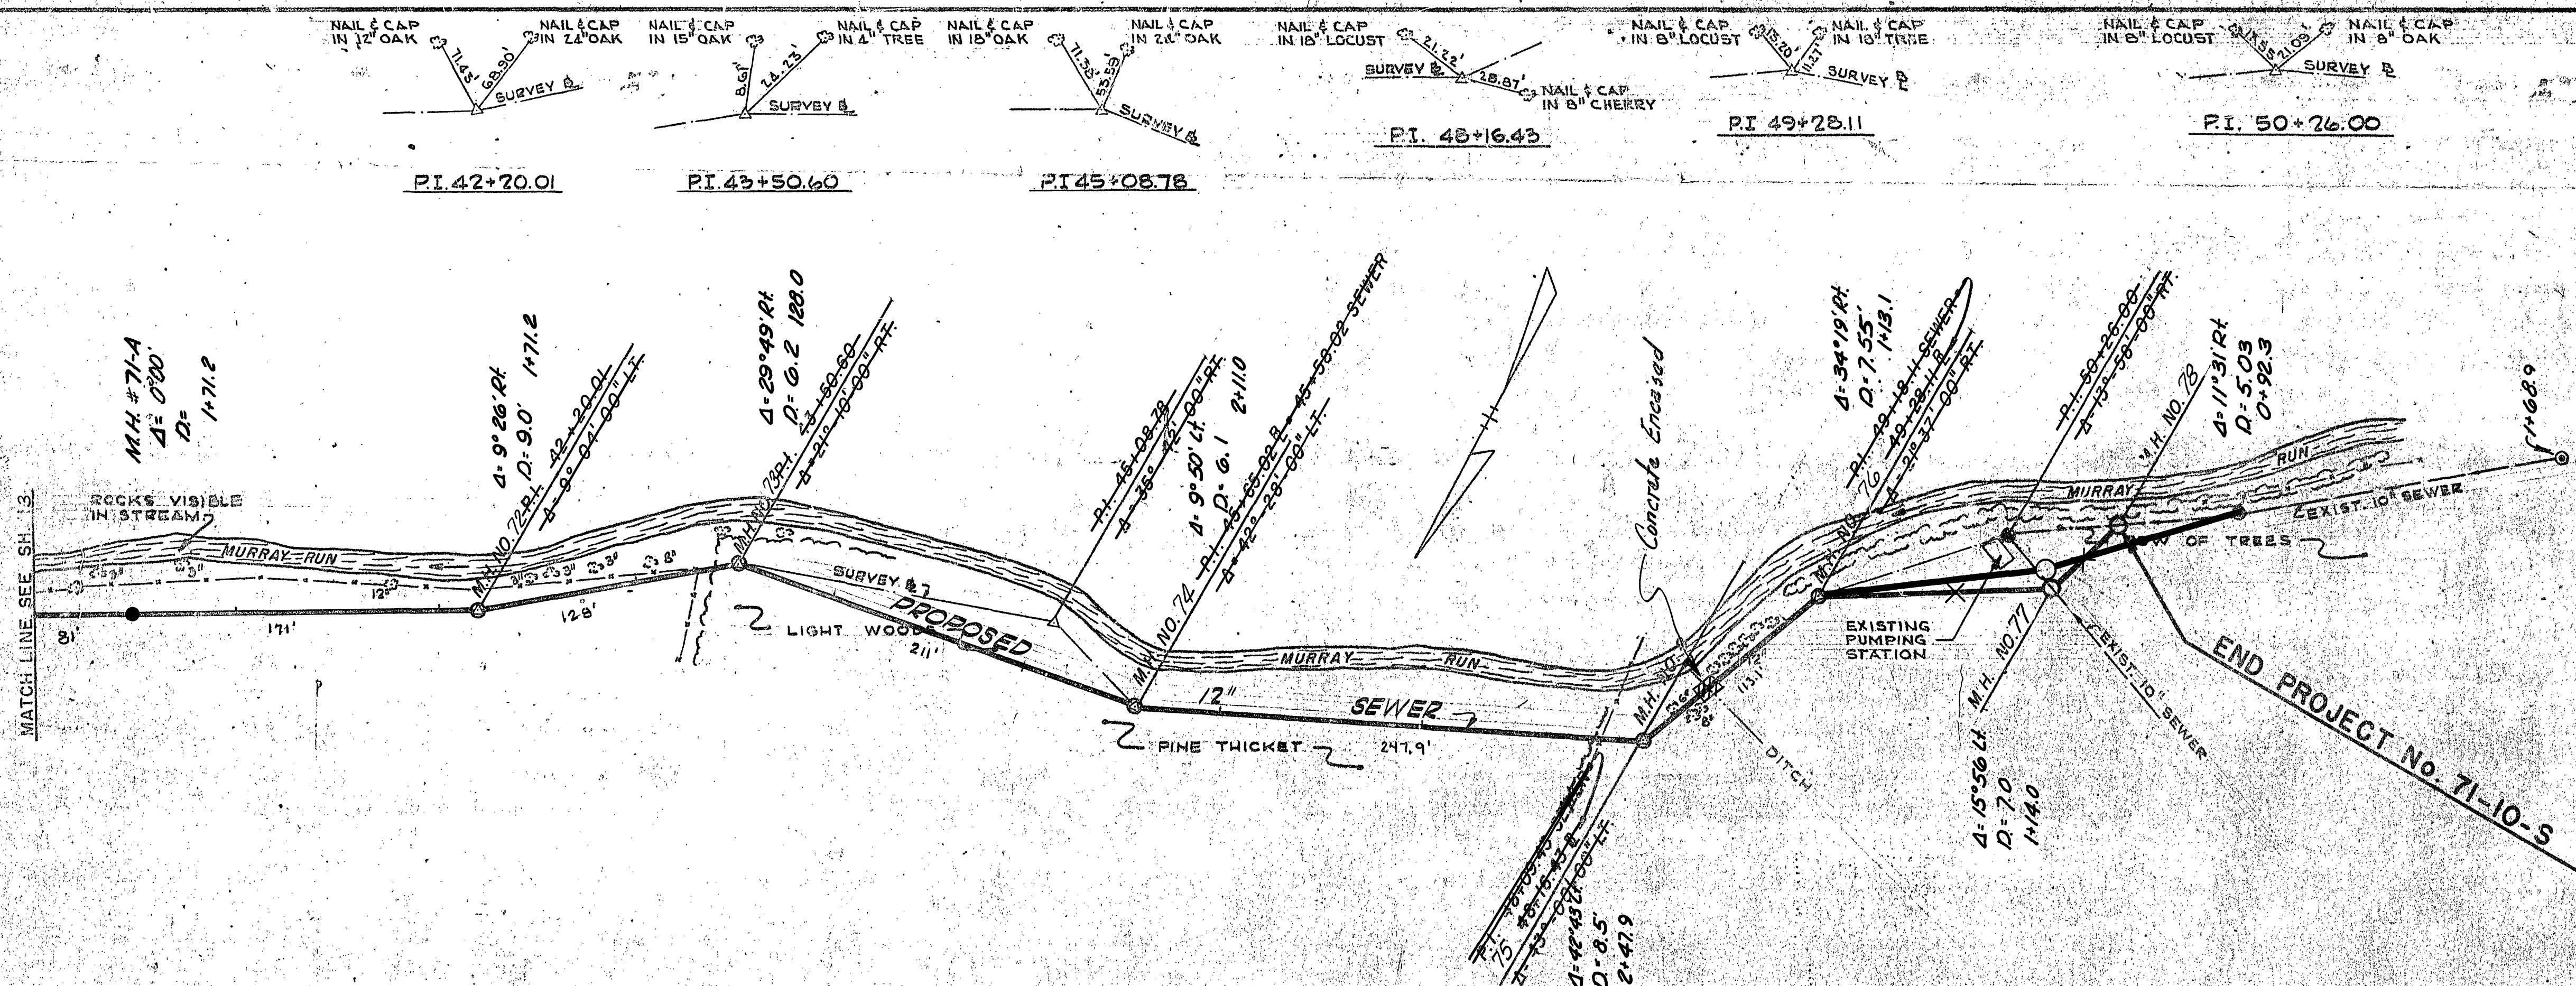


NOTE: AS BUILT DISTANCES BETWEEN MANHOLES WERE TAKEN FROM CENTER OF MANHOLE LIDS.

SCALE: 1 IN = 50 FT

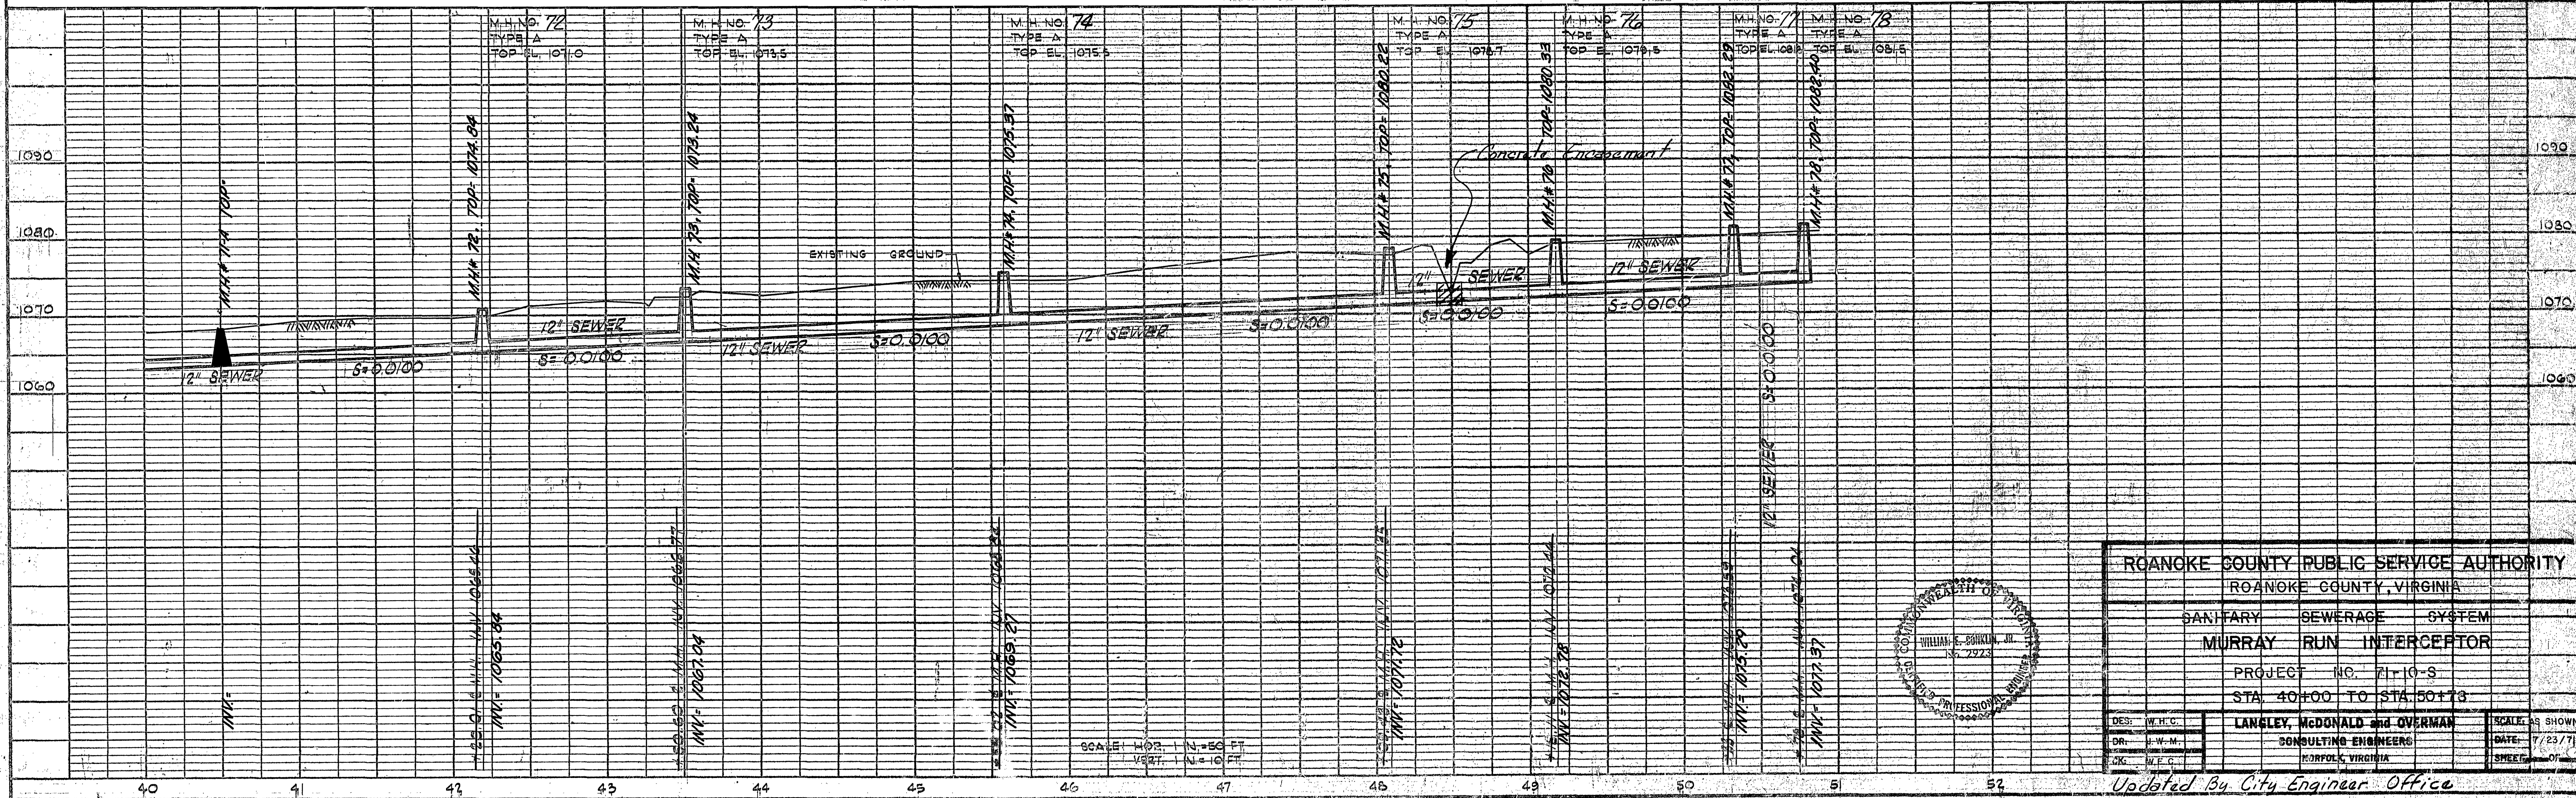

SCALE: 1 IN = 50 FT
VERT. 1 IN = 10 FT

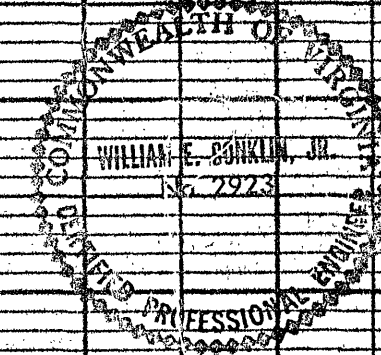

ROANOKE COUNTY PUBLIC SERVICE AUTHORITY ROANOKE COUNTY, VIRGINIA		
SANITARY	SEWERAGE	SYSTEM
MURRAY RUN INTERCEPTOR		
PROJECT NO. 71-10-S		
STA. 40+00 TO STA. 50+73		
DESIGNED BY	W.H.C.	LANGLEY, McDONALD and OVERMAN CONSULTING ENGINEERS KORFOLK, VIRGINIA
DRAWN BY	J.W.M.	
CHECKED BY	W.E.B.	
Updated By City Engineer Office		SCALE: AS SHOWN
"CORRECTED TO AS BUILT"		DATE: 7/23/71
SEE BOOK # 597		SHEET: 14 OF 18