



PLAN	SURVEYED	DATE
	NOTE BOOK	BY
	No. 532	

PROFILE	SURVEYED	DATE
	NOTE BOOK	BY
	No. 532	

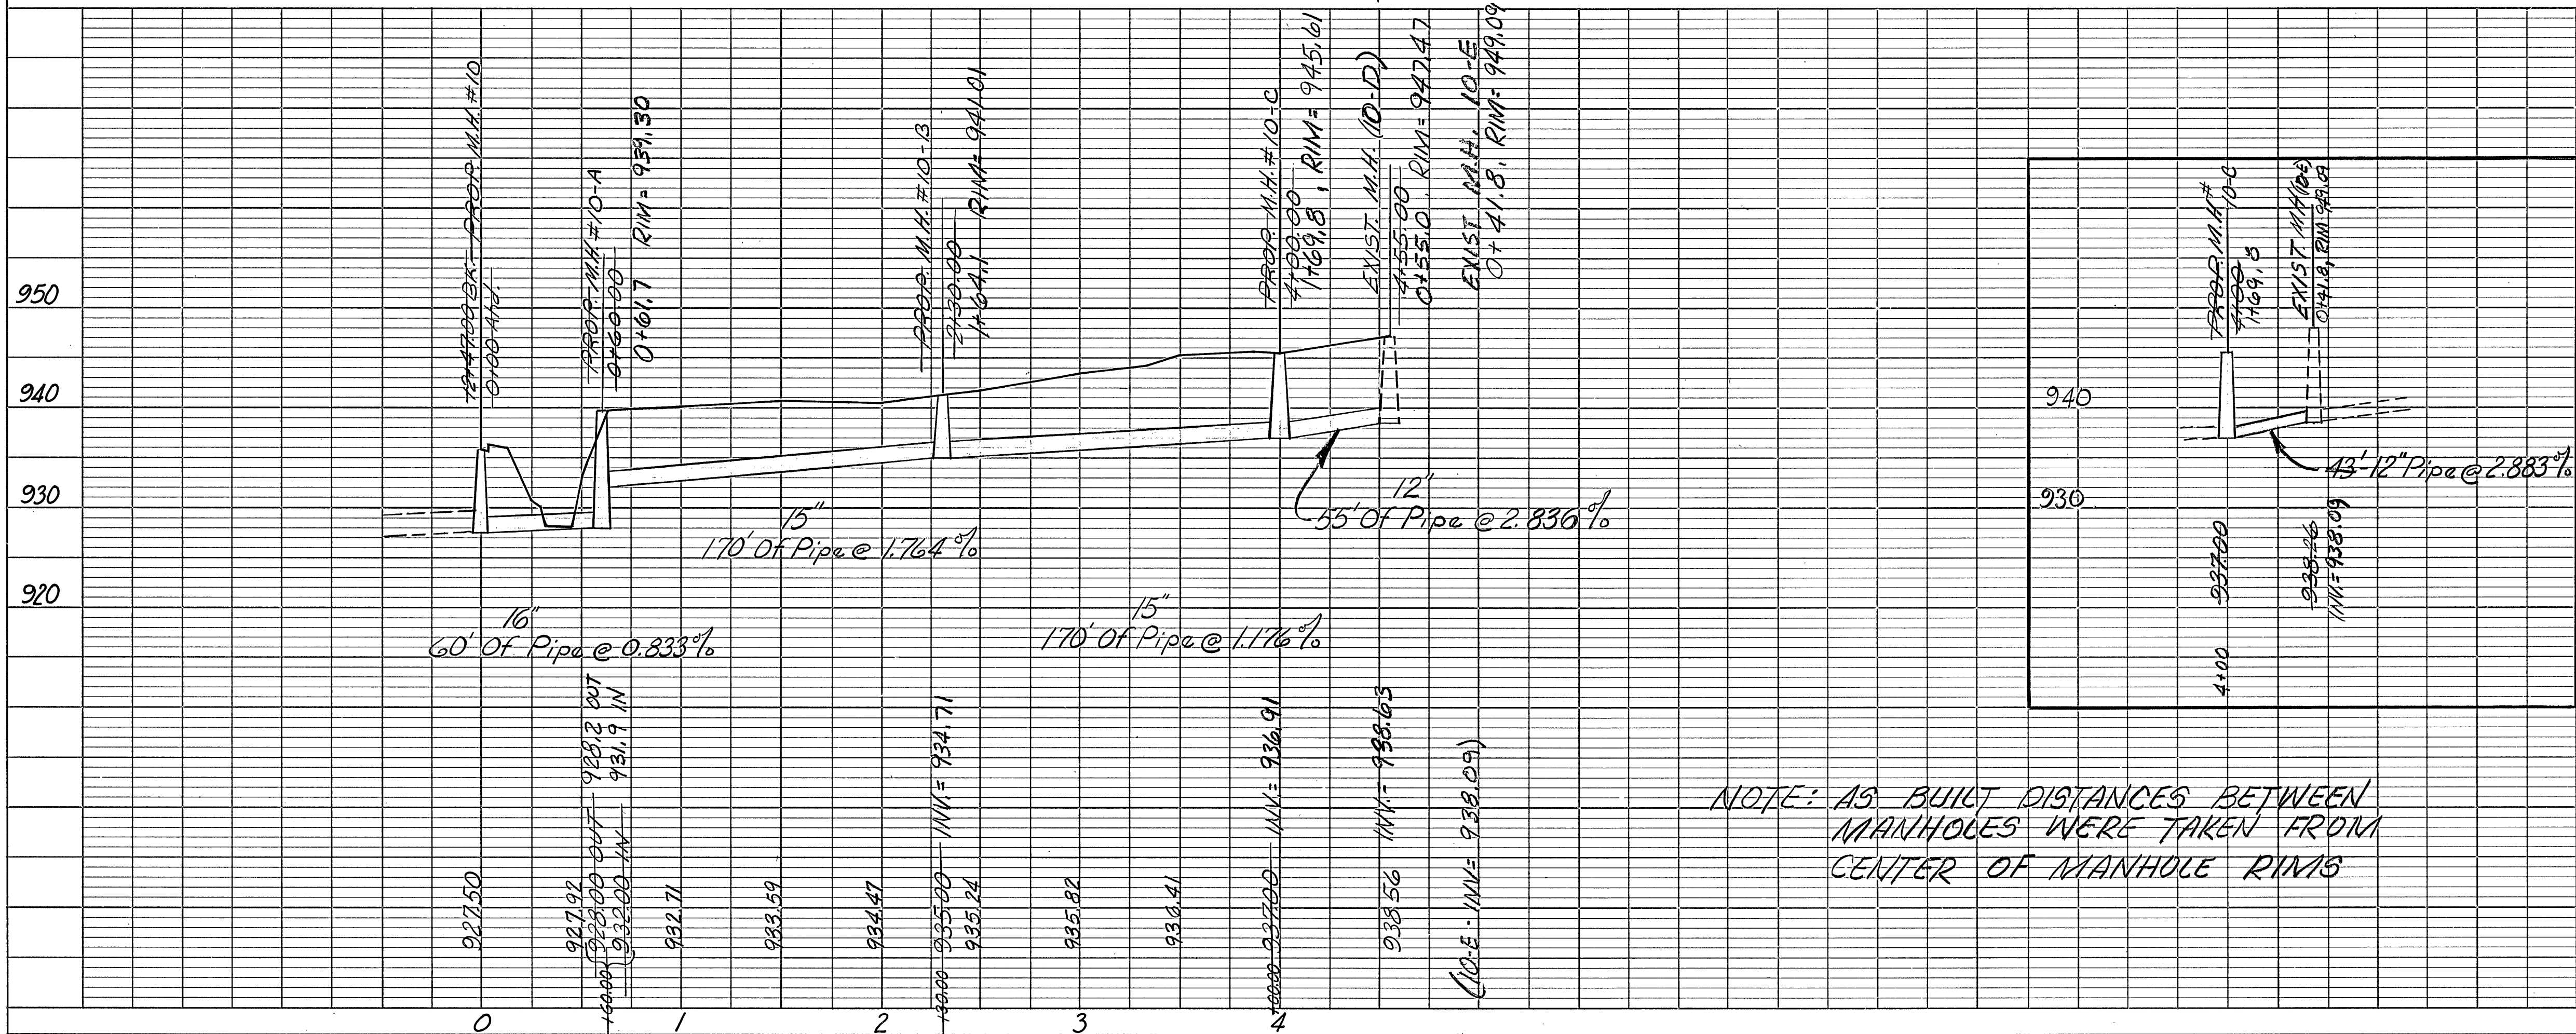

NOTE: AS BUILT DISTANCES BETWEEN MANHOLES WERE TAKEN FROM CENTER OF MANHOLE RIMS

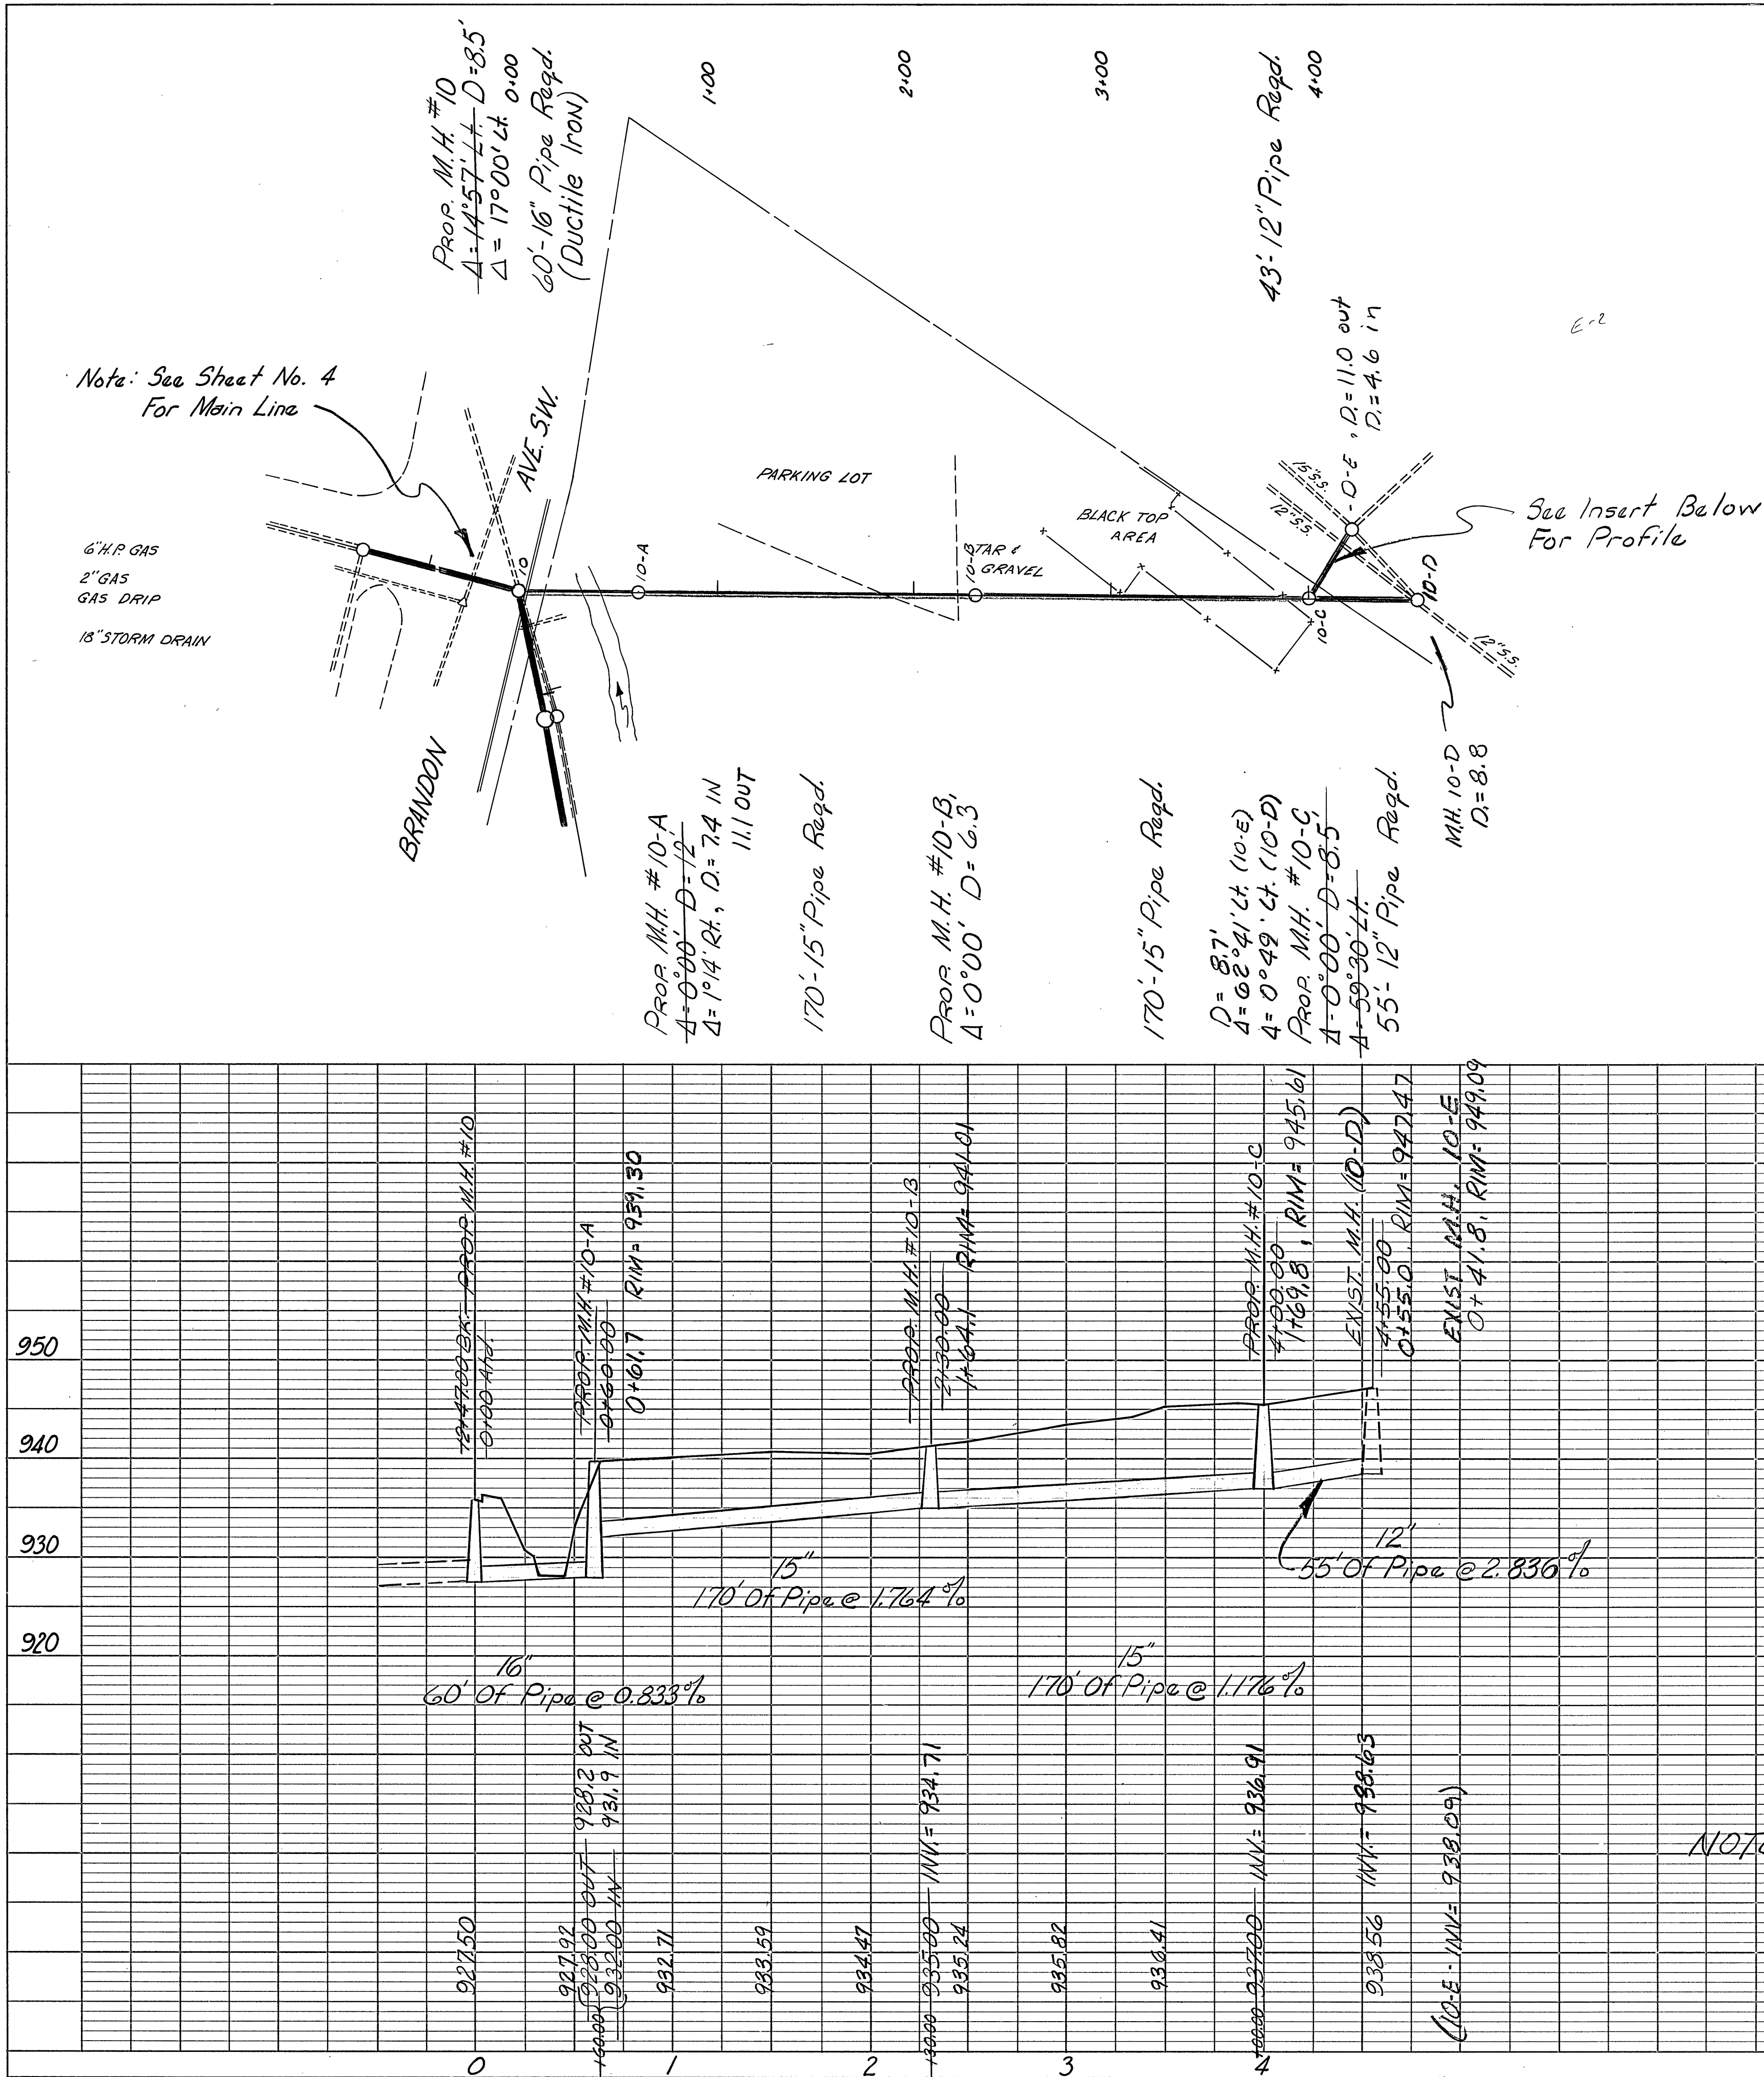