
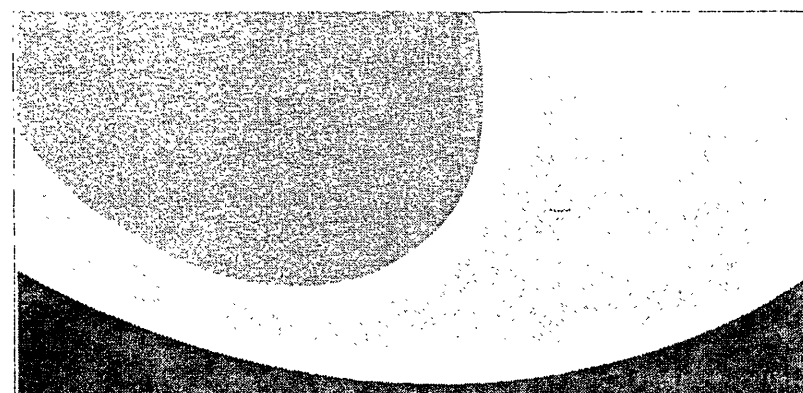


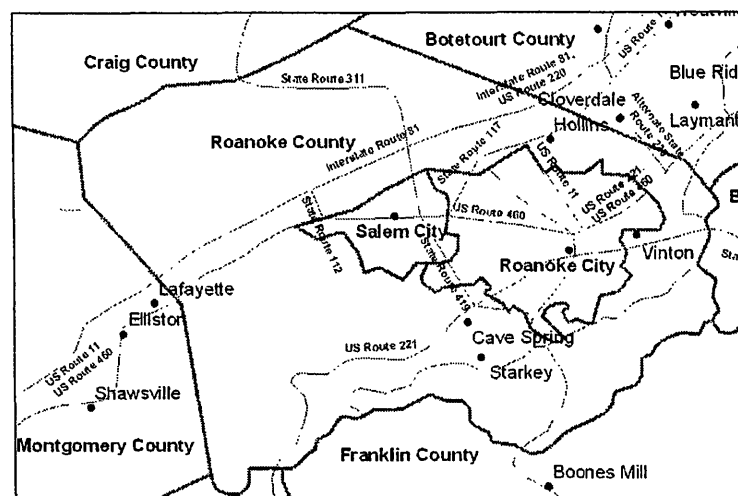

DRAWING INDEX	
SHEET NO.	DESCRIPTION
100	TITLE SHEET AND INDEX
101	PROJECT LOCATION MAP
102	SUGAR LOAF MOUNTAIN ROAD – SEWER REHABILITATION
103	LAKELAND DRIVE – SEWER REHABILITATION
104	PENN FOREST – SEWER REHABILITATION
105	BUCKHORN ROAD EASEMENT – SEWER REHABILITATION
106	MANHOLE REPAIRS – WPCP TO RIVERVIEW ROAD
107	MANHOLE REPAIRS – RIVERVIEW RD TO WILEY DR
108	MANHOLE REPAIRS – WILEY DR TO PATTERSON AVE
109	CIVIL DETAILS
110	CIVIL DETAILS

MURRAY RUN AREA SEWER REHABILITATION

PREPARED FOR:
WESTERN VIRGINIA WATER AUTHORITY
601 SOUTH JEFFERSON STREET, ROANOKE, VIRGINIA 24011
PHONE: 540-853-5700

PREPARED BY:
OLVER INCORPORATED
1116 SOUTH MAIN STREET, BLACKSBURG, VIRGINIA 24060
PHONE: 540-552-5548

AS-BUILT
EES 10/01/10

WESTERN VIRGINIA WATER AUTHORITY MURRAY RUN AREA SEWER REHABILITATION								
Designed: JSB								
Drawn: CDH								
Checked: DBH								
Date: AUG 2008								
Scale: AS SHOWN								
Job No. 12307.07								
File Name:								