


AS-BUILTS
National Pools
Jack St. Clair Inc.

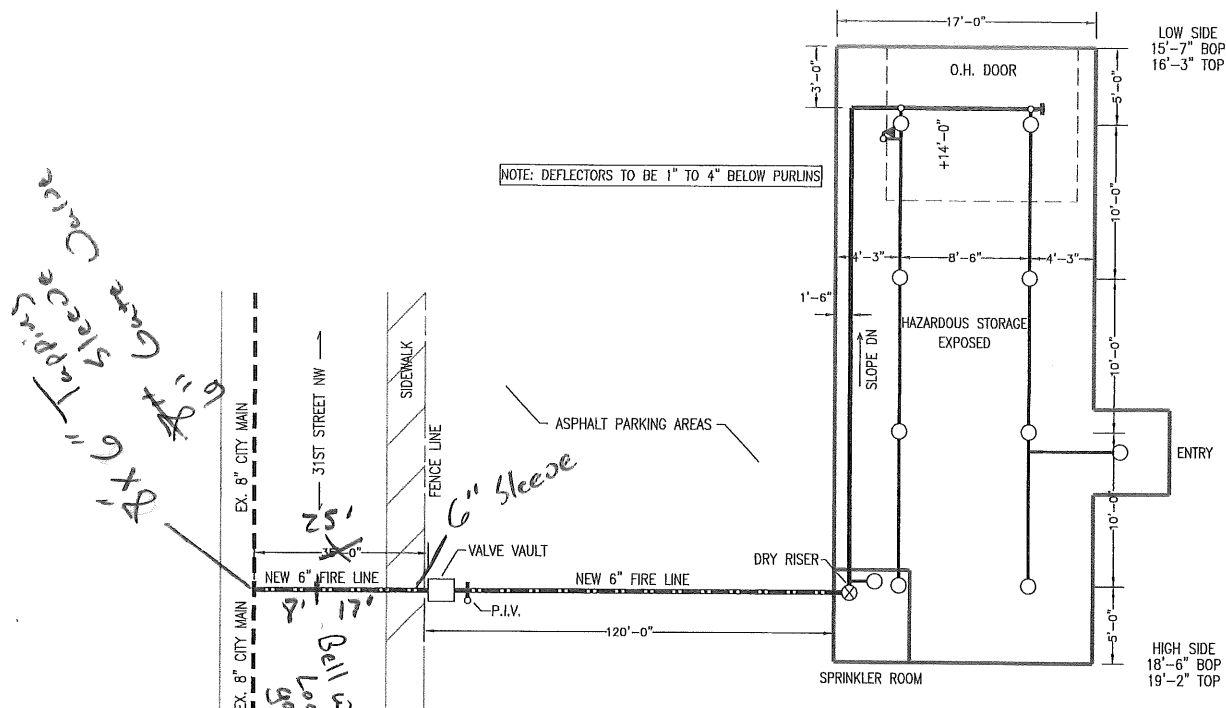

INSTALLING SPRINKLER CONTRACTOR:

ROANOKE SPRINKLER, INC.
1334 7TH STREET NE
ROANOKE, VIRGINIA 24012
540-981-0009
STATE LICENSE #2705168458A

DRAWN BY: REGGIE MCGHEE 9-3-19
NICET CERT. NO. 95963

NATIONAL POOLS

3112 MELROSE AVENUE ROANOKE, VA.

GENERAL CONTRACTOR: R.L. LUCAS CONSTRUCTION

6" Pipe U.S. Pipe DIP
6" Tapping Valve American Flow
Control

Installed 12/17/19
Jack St. Clair Inc