


NOTED	SURVEYED	BY	DATE
NOTE BOOK	PLOTTED	H. PAXTON	2-75
	GRADES CHECKED	GRU. AND SSG.	"
	B. M.'S NOTED	G. NEUGOLD	"
No. 593	STRUCTURE NOTATIONS CHECKED		

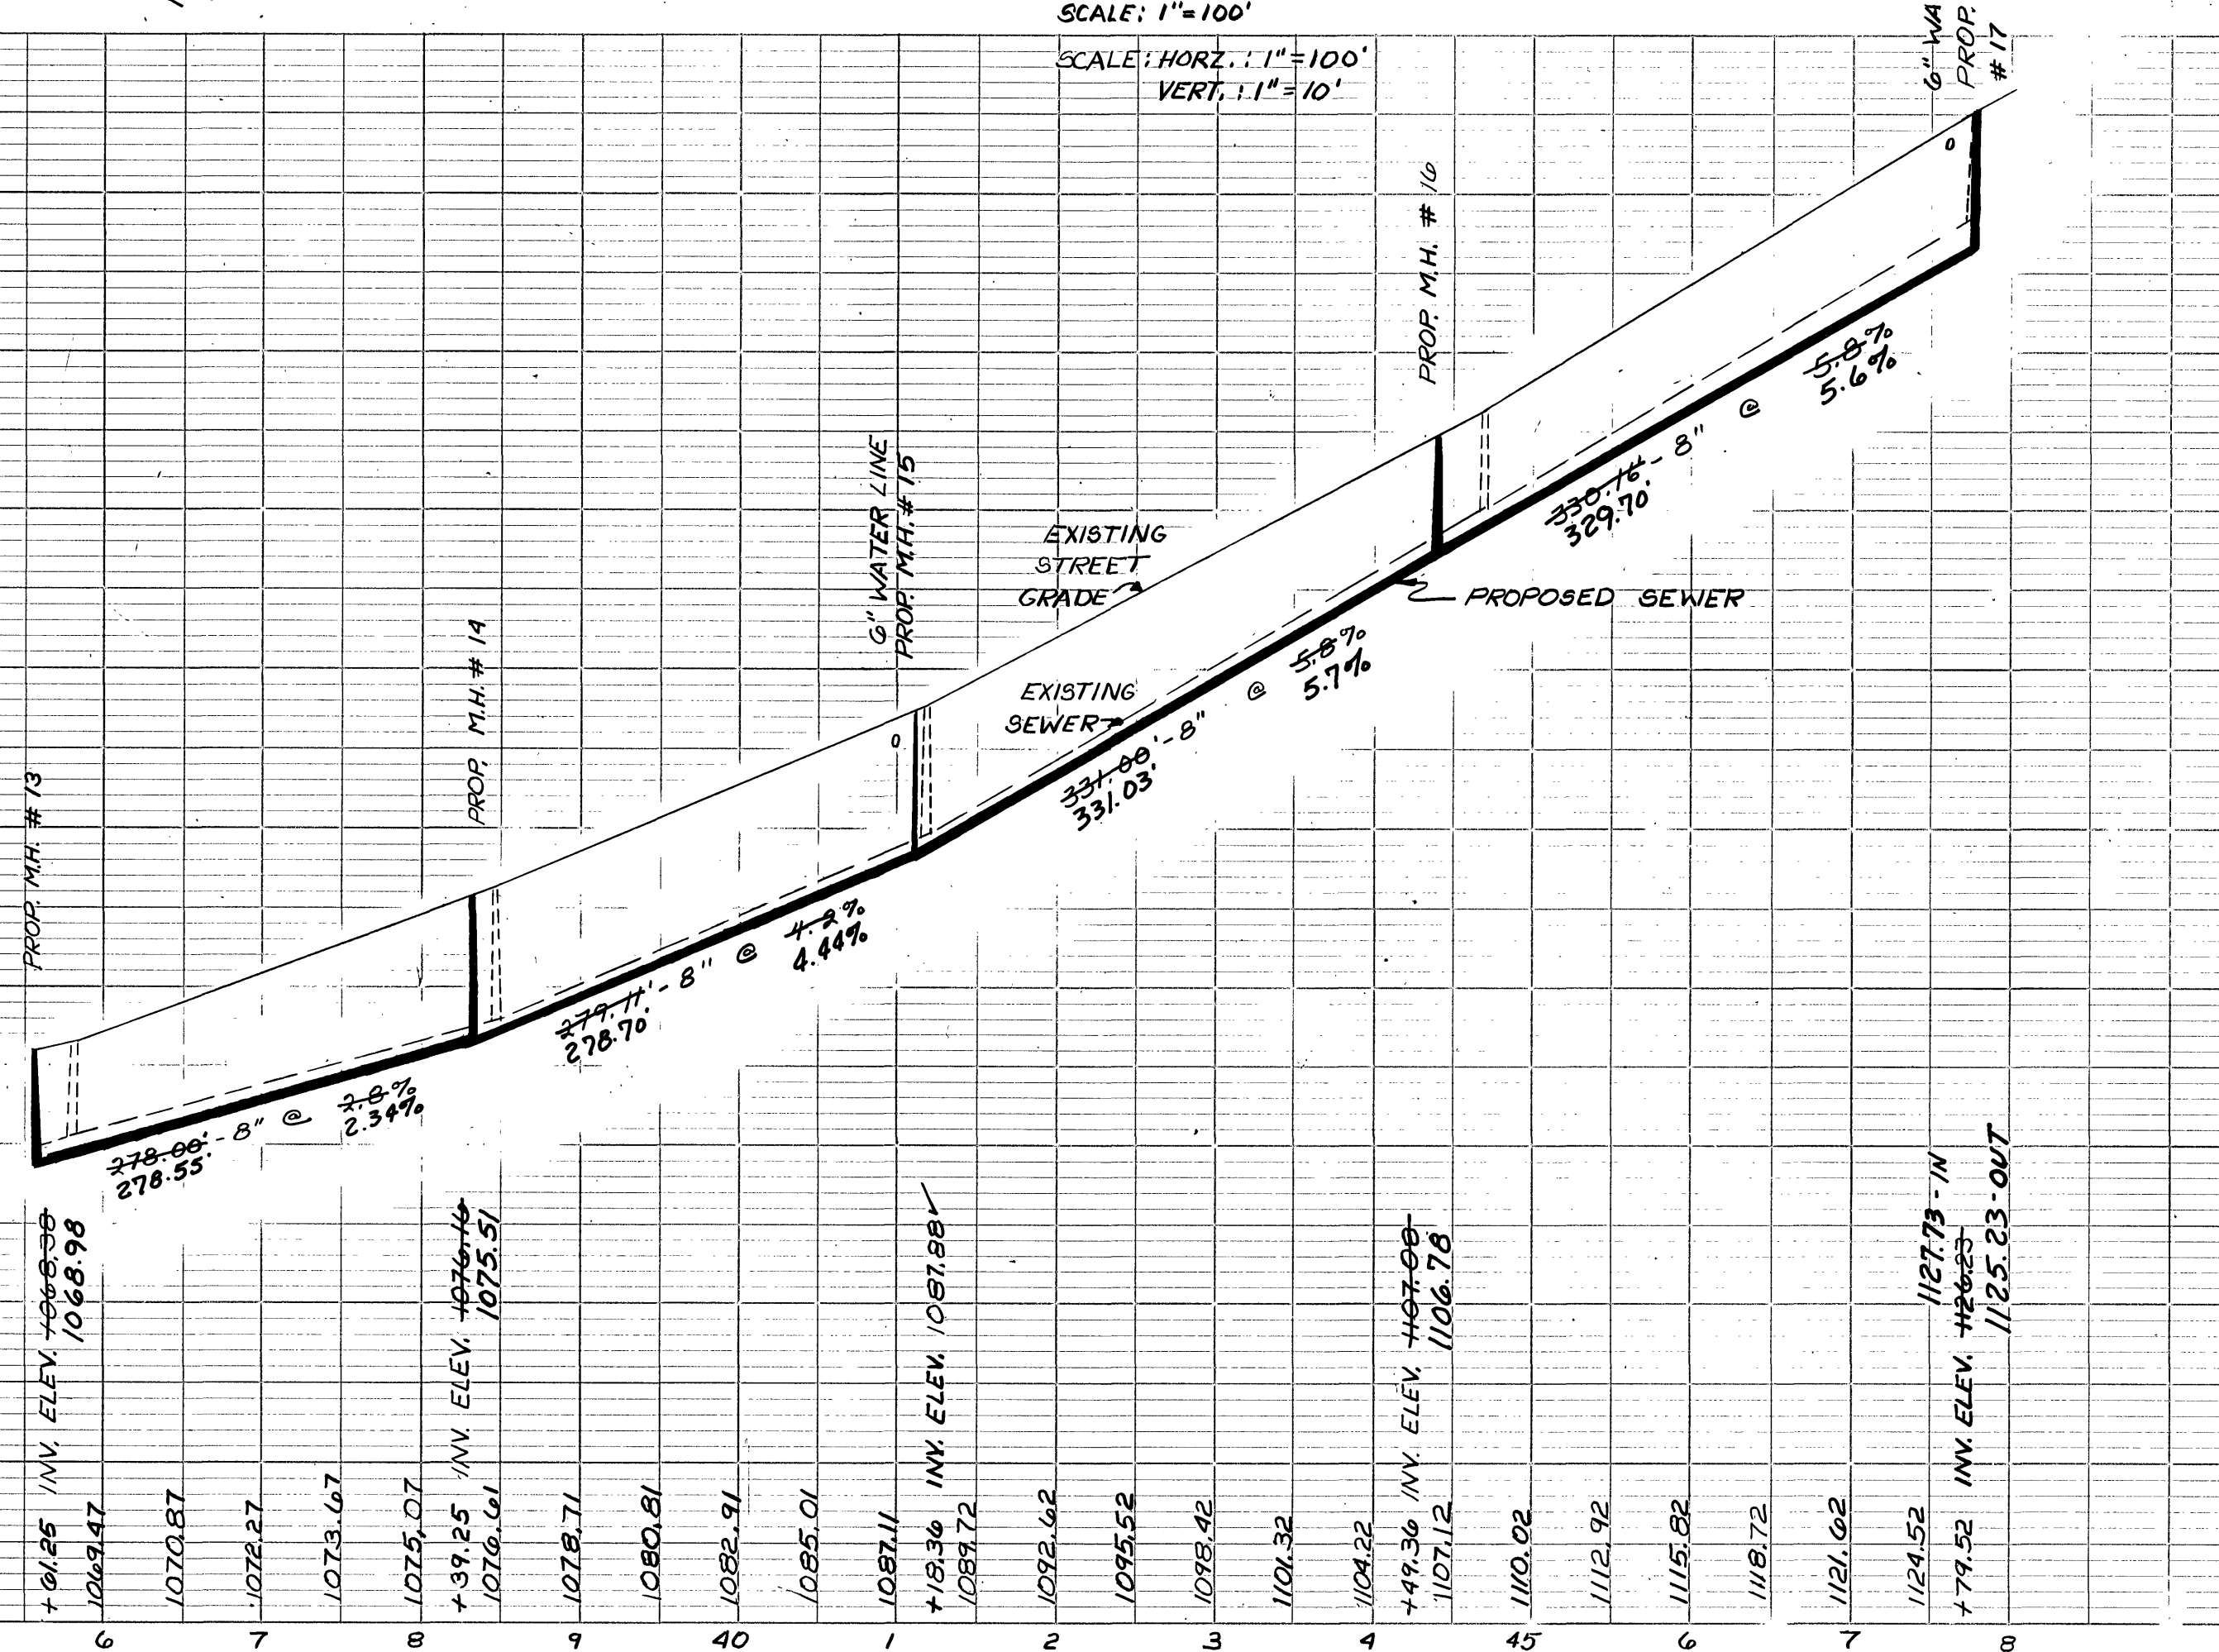

AS BUILT

DIVISION	FHWA REGION	STATE	FEDERAL AID		STATE		SHEET NO.
			PROJECT	ROUTE	PROJECT		
	11	MA				4 of 4	

PLAN NO. 5457	PROJECT	FILE NO.	SHEET NO. 4 of 4
------------------	---------	----------	---------------------