





ROANOKE, VIRGINIA

PROPOSED SERVICING FACILITY – ALBEMARLE AVENUE

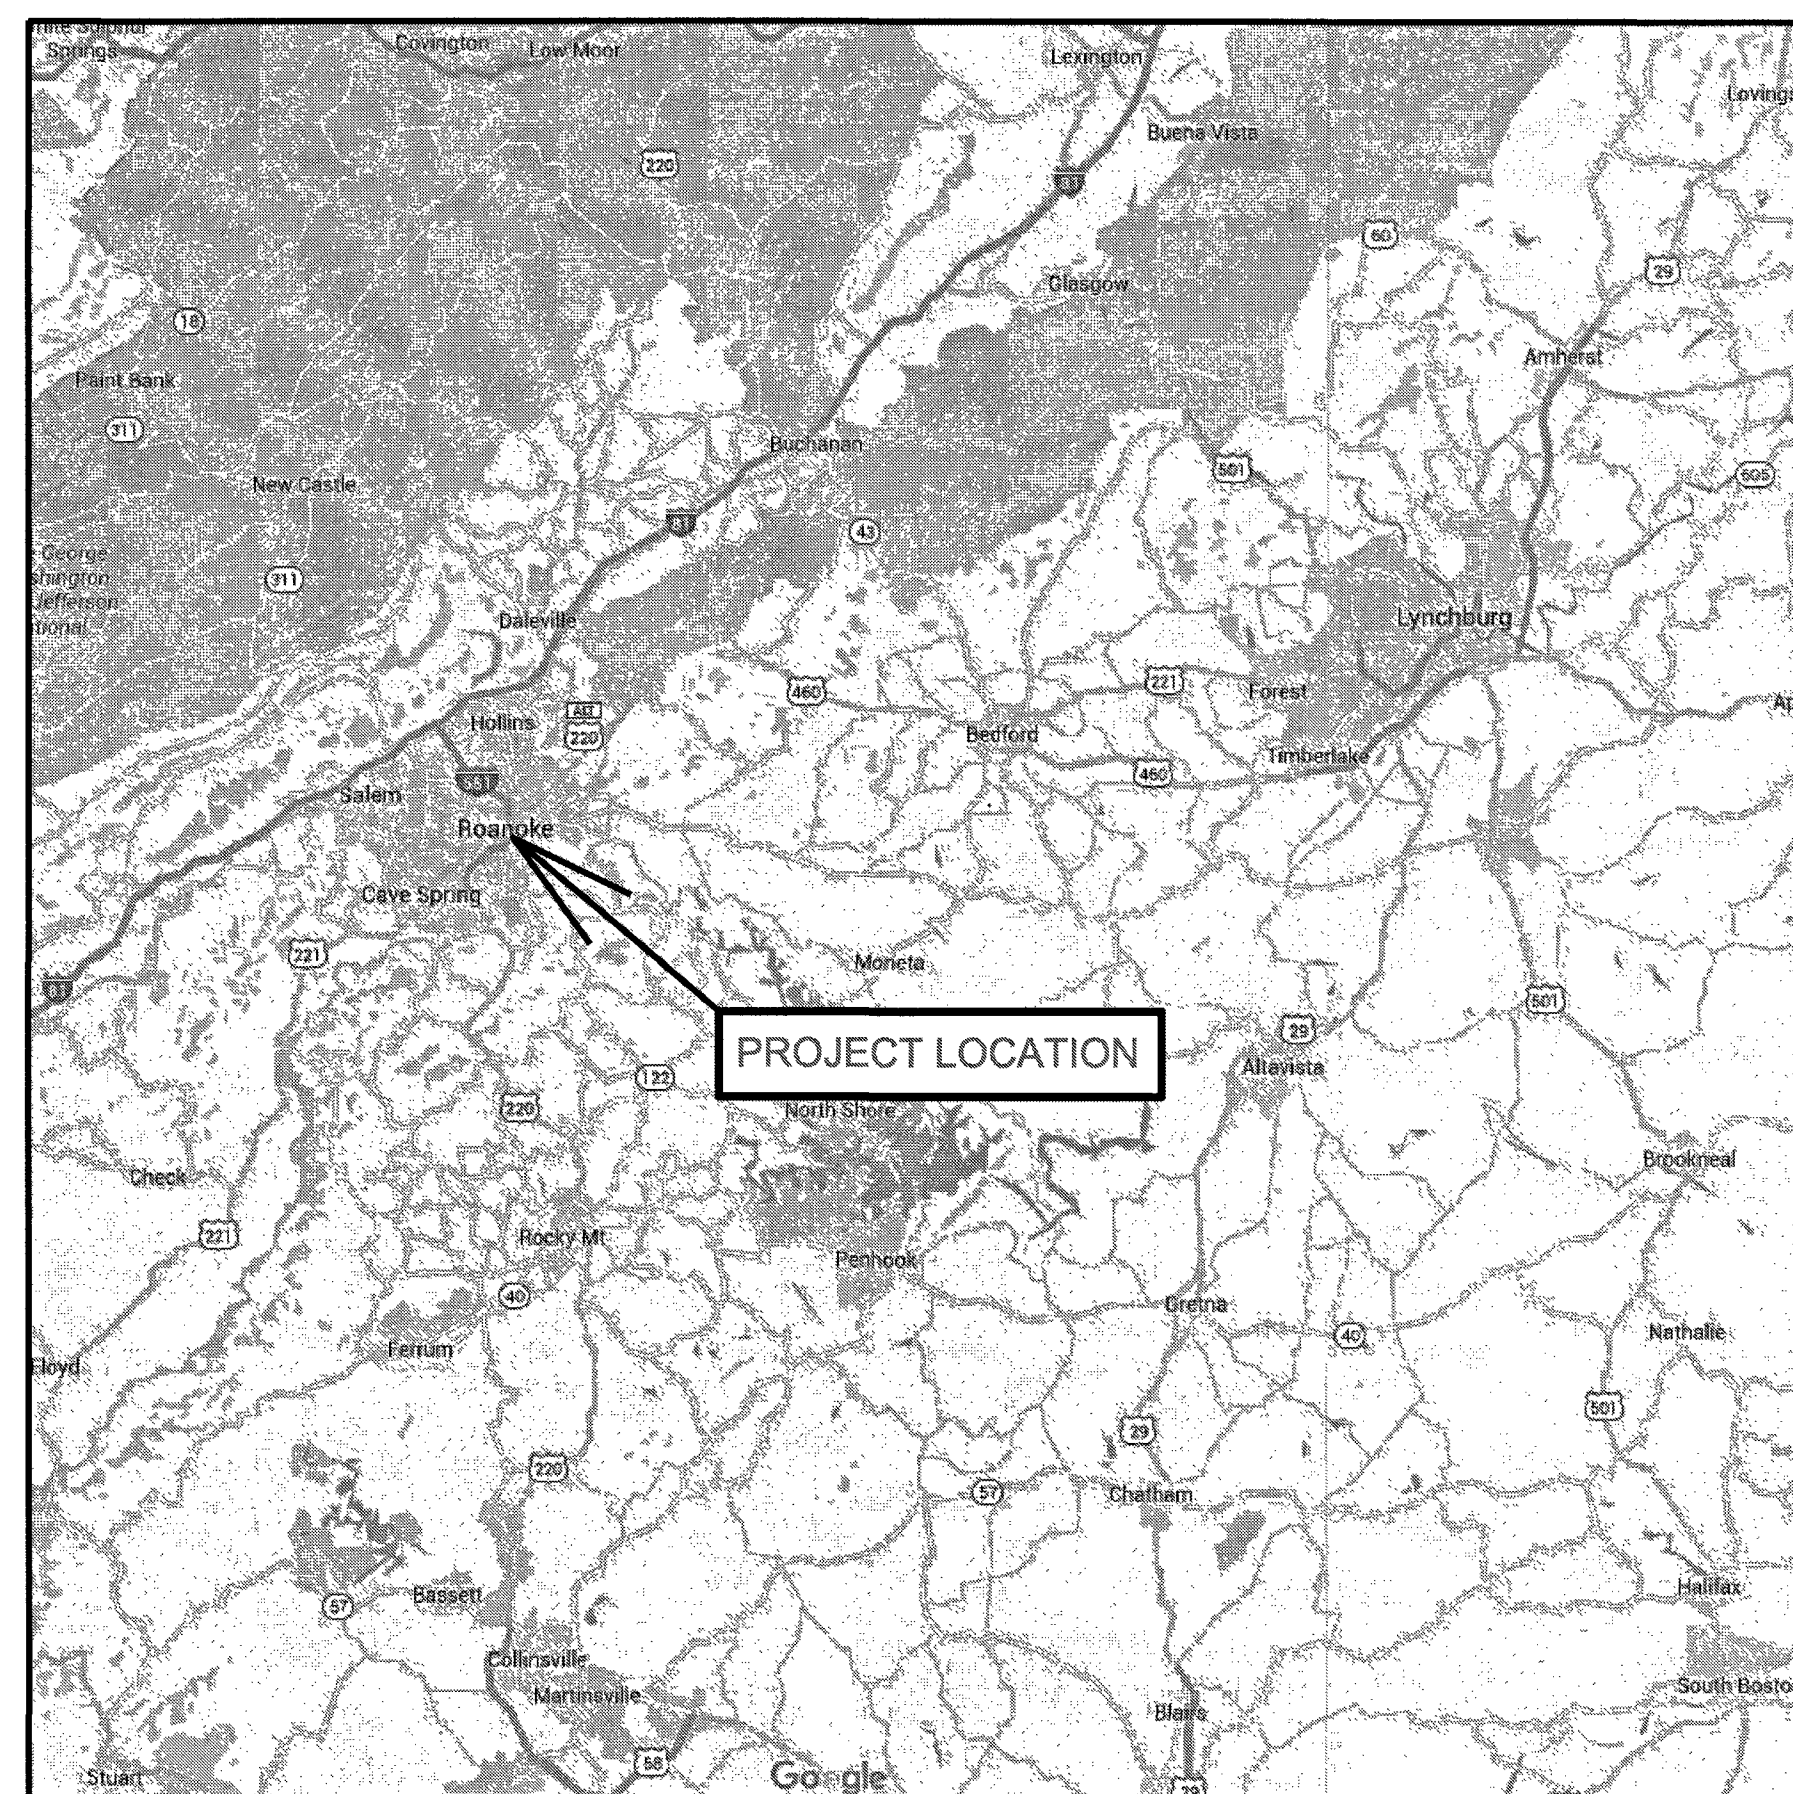

VICINITY MAP

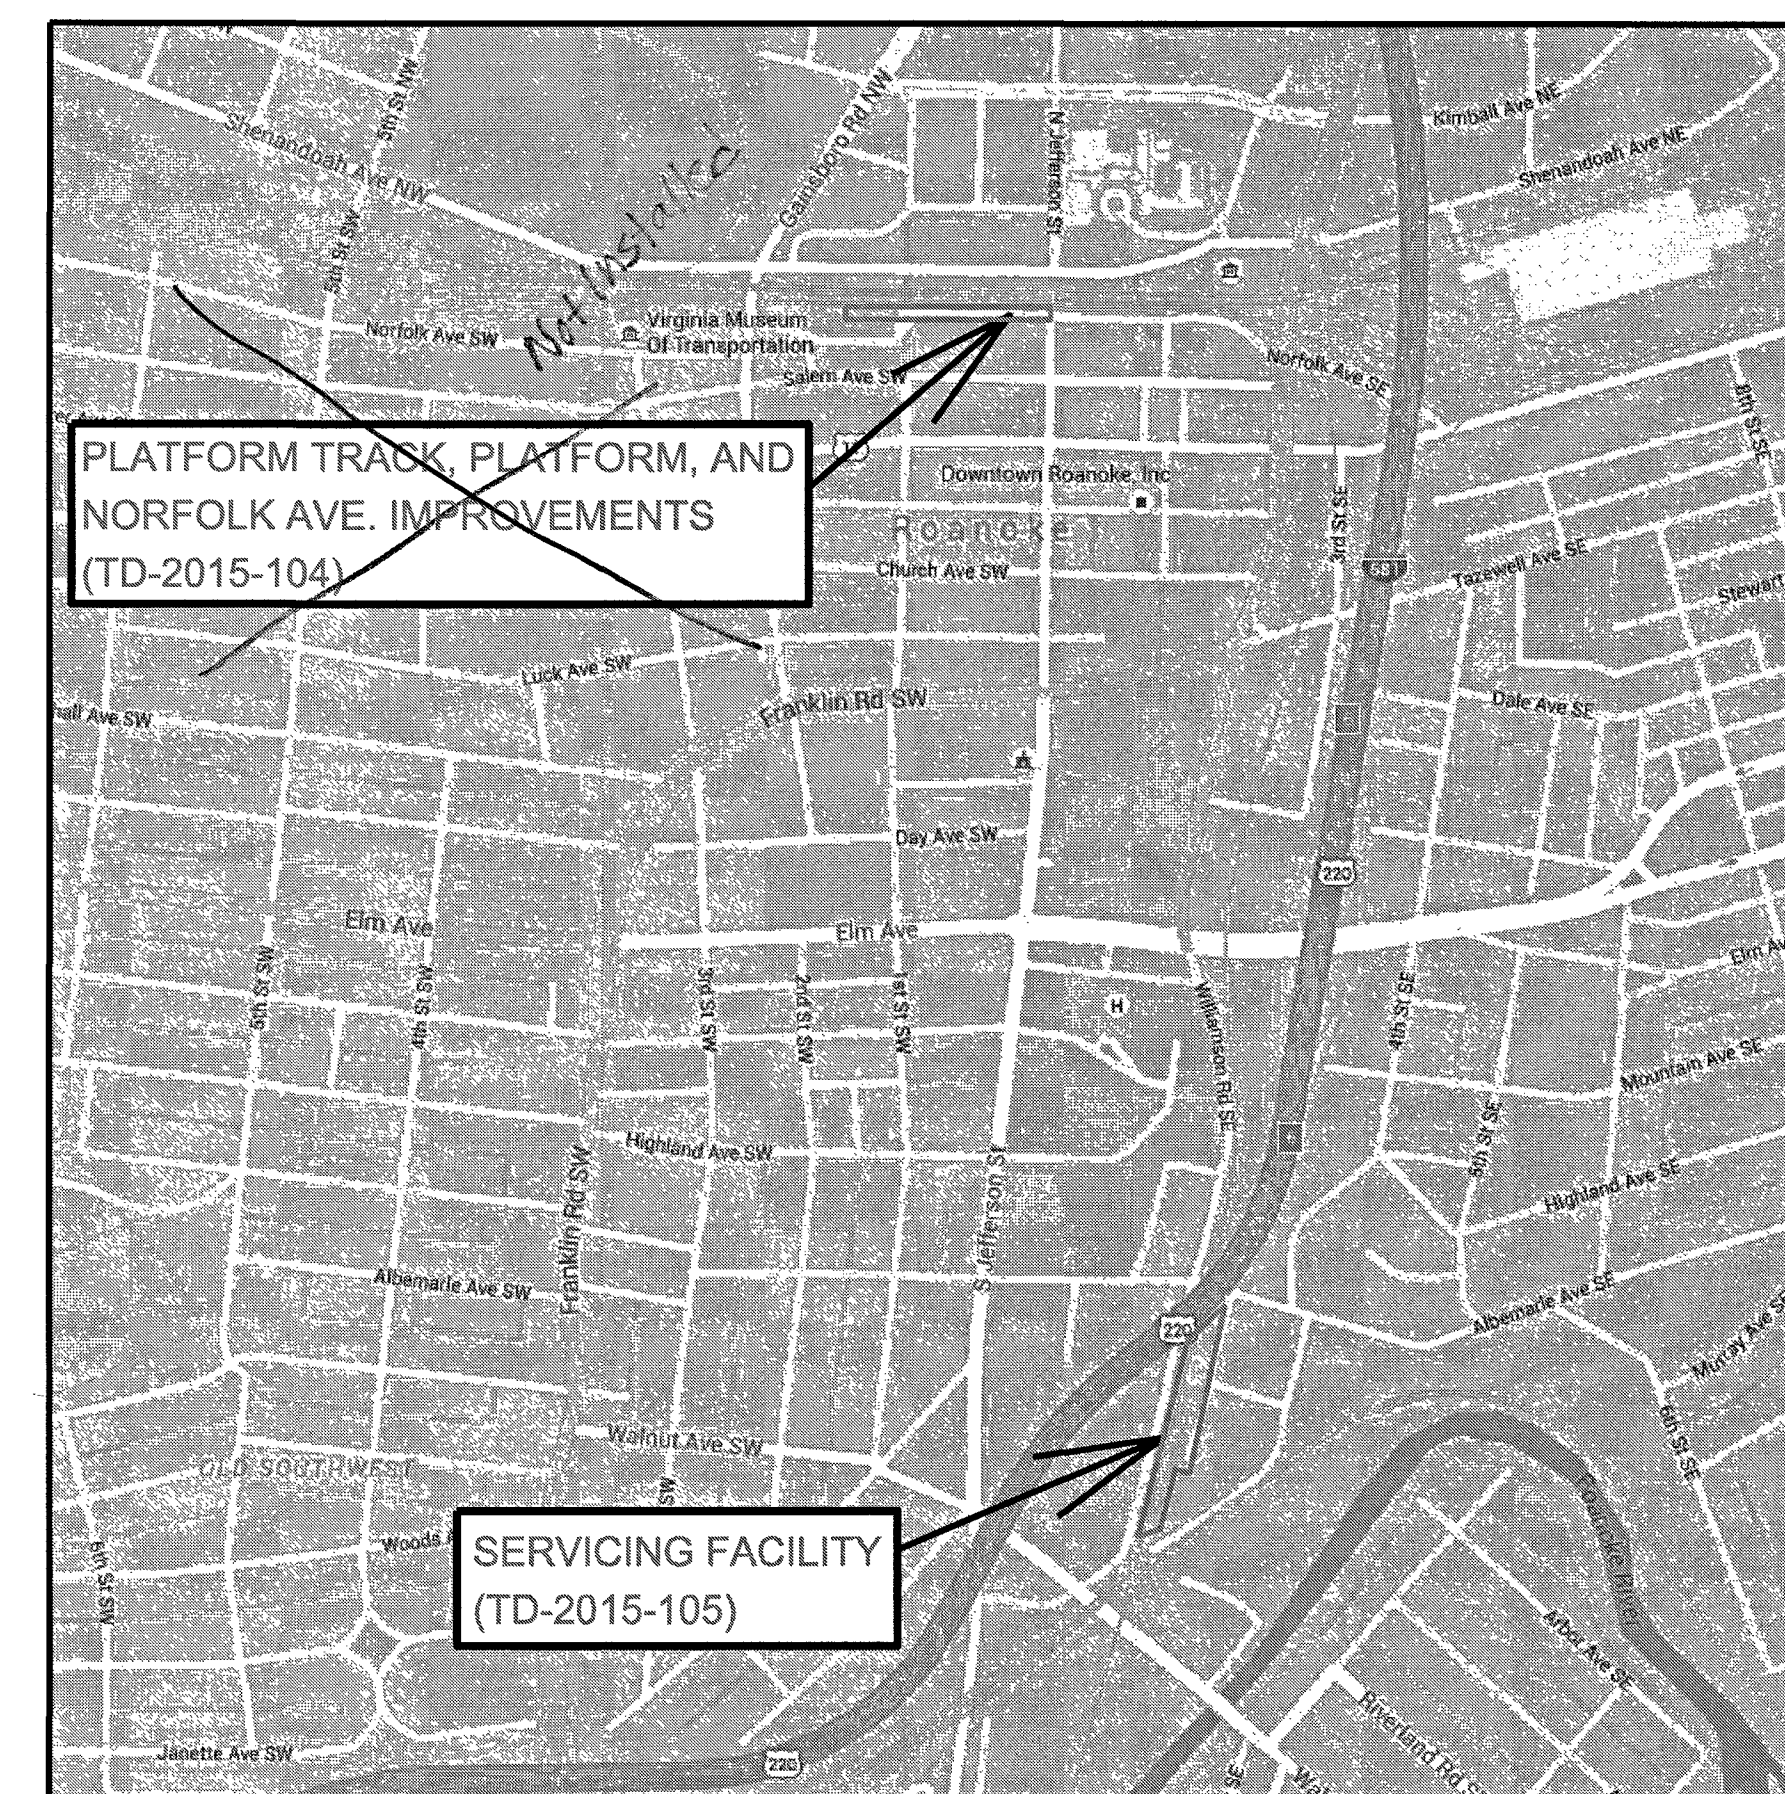


PROJECT SITE MAP



RELEASED FOR CONSTRUCTION

PROJECT NO.	13016
DATE	
DRAWN BY	EVU
CHECKED BY	HAC
REVISIONS	

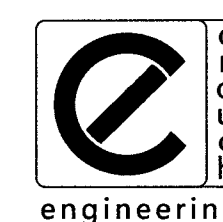

CROUCH ENGINEERING®
428 WILSON PIKE CIRCLE
BRENTWOOD, TN 37027
PHONE NO. (615) 791-0630

COPYRIGHT © CROUCH ENGINEERING. ALL RIGHTS RESERVED.
REPRODUCTION AND DISTRIBUTION ONLY UNDER PERMISSION AND LICENSE BY CROUCH ENGINEERING.
FOR PERMISSION, CONTACT HARVEY A. CROUCH.

SCALE: NONE

DO NOT SCALE THIS DRAWING FOR DIMENSIONS NOT GIVEN



POCAHONTAS

OFFICE OF THE CHIEF ENGINEER - DESIGN AND CONSTRUCTION - ATLANTA, GA.

REV.	BY	DATE	DESCRIPTION
1	EVU	08/26/14	REVISED SEWER LATERAL, CRASH WALL, AND ADDED COORDINATE SHEET
LOCATION			
ROANOKE, VIRGINIA			
TITLE			
PROPOSED SERVICING FACILITY – ALBEMARLE AVENUE COVER SHEET			
DSH	EVU	FILE NO.	FILE POST
		CRS0129781	V-10-VA2A (15380) WR 0.73
CHK	BLP	DATE	DATE
		APRIL 28, 2016	TD-2015-105-R1

CADD FILE

SHEET 1 OF 46

12/9/16 completed Inspector: Brian Whitteack Ser sheet 5 As-built