
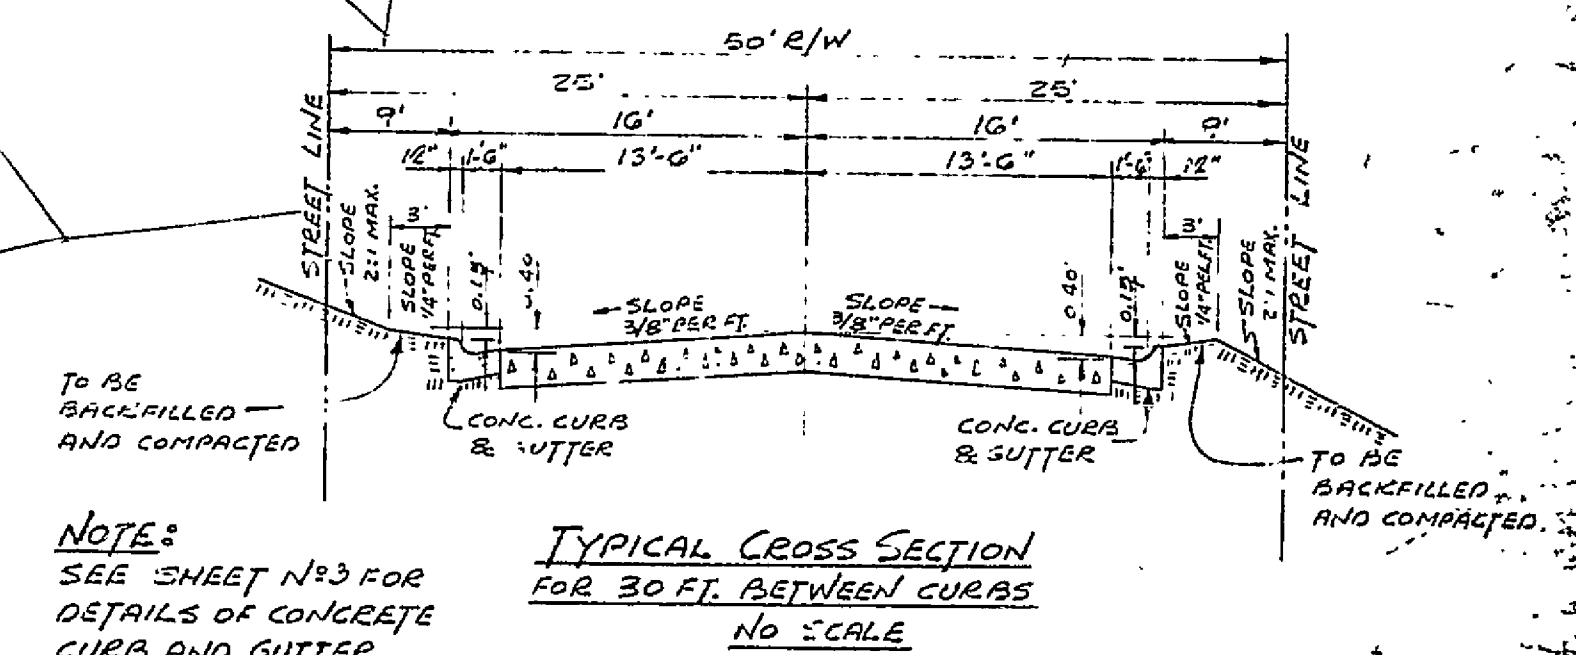
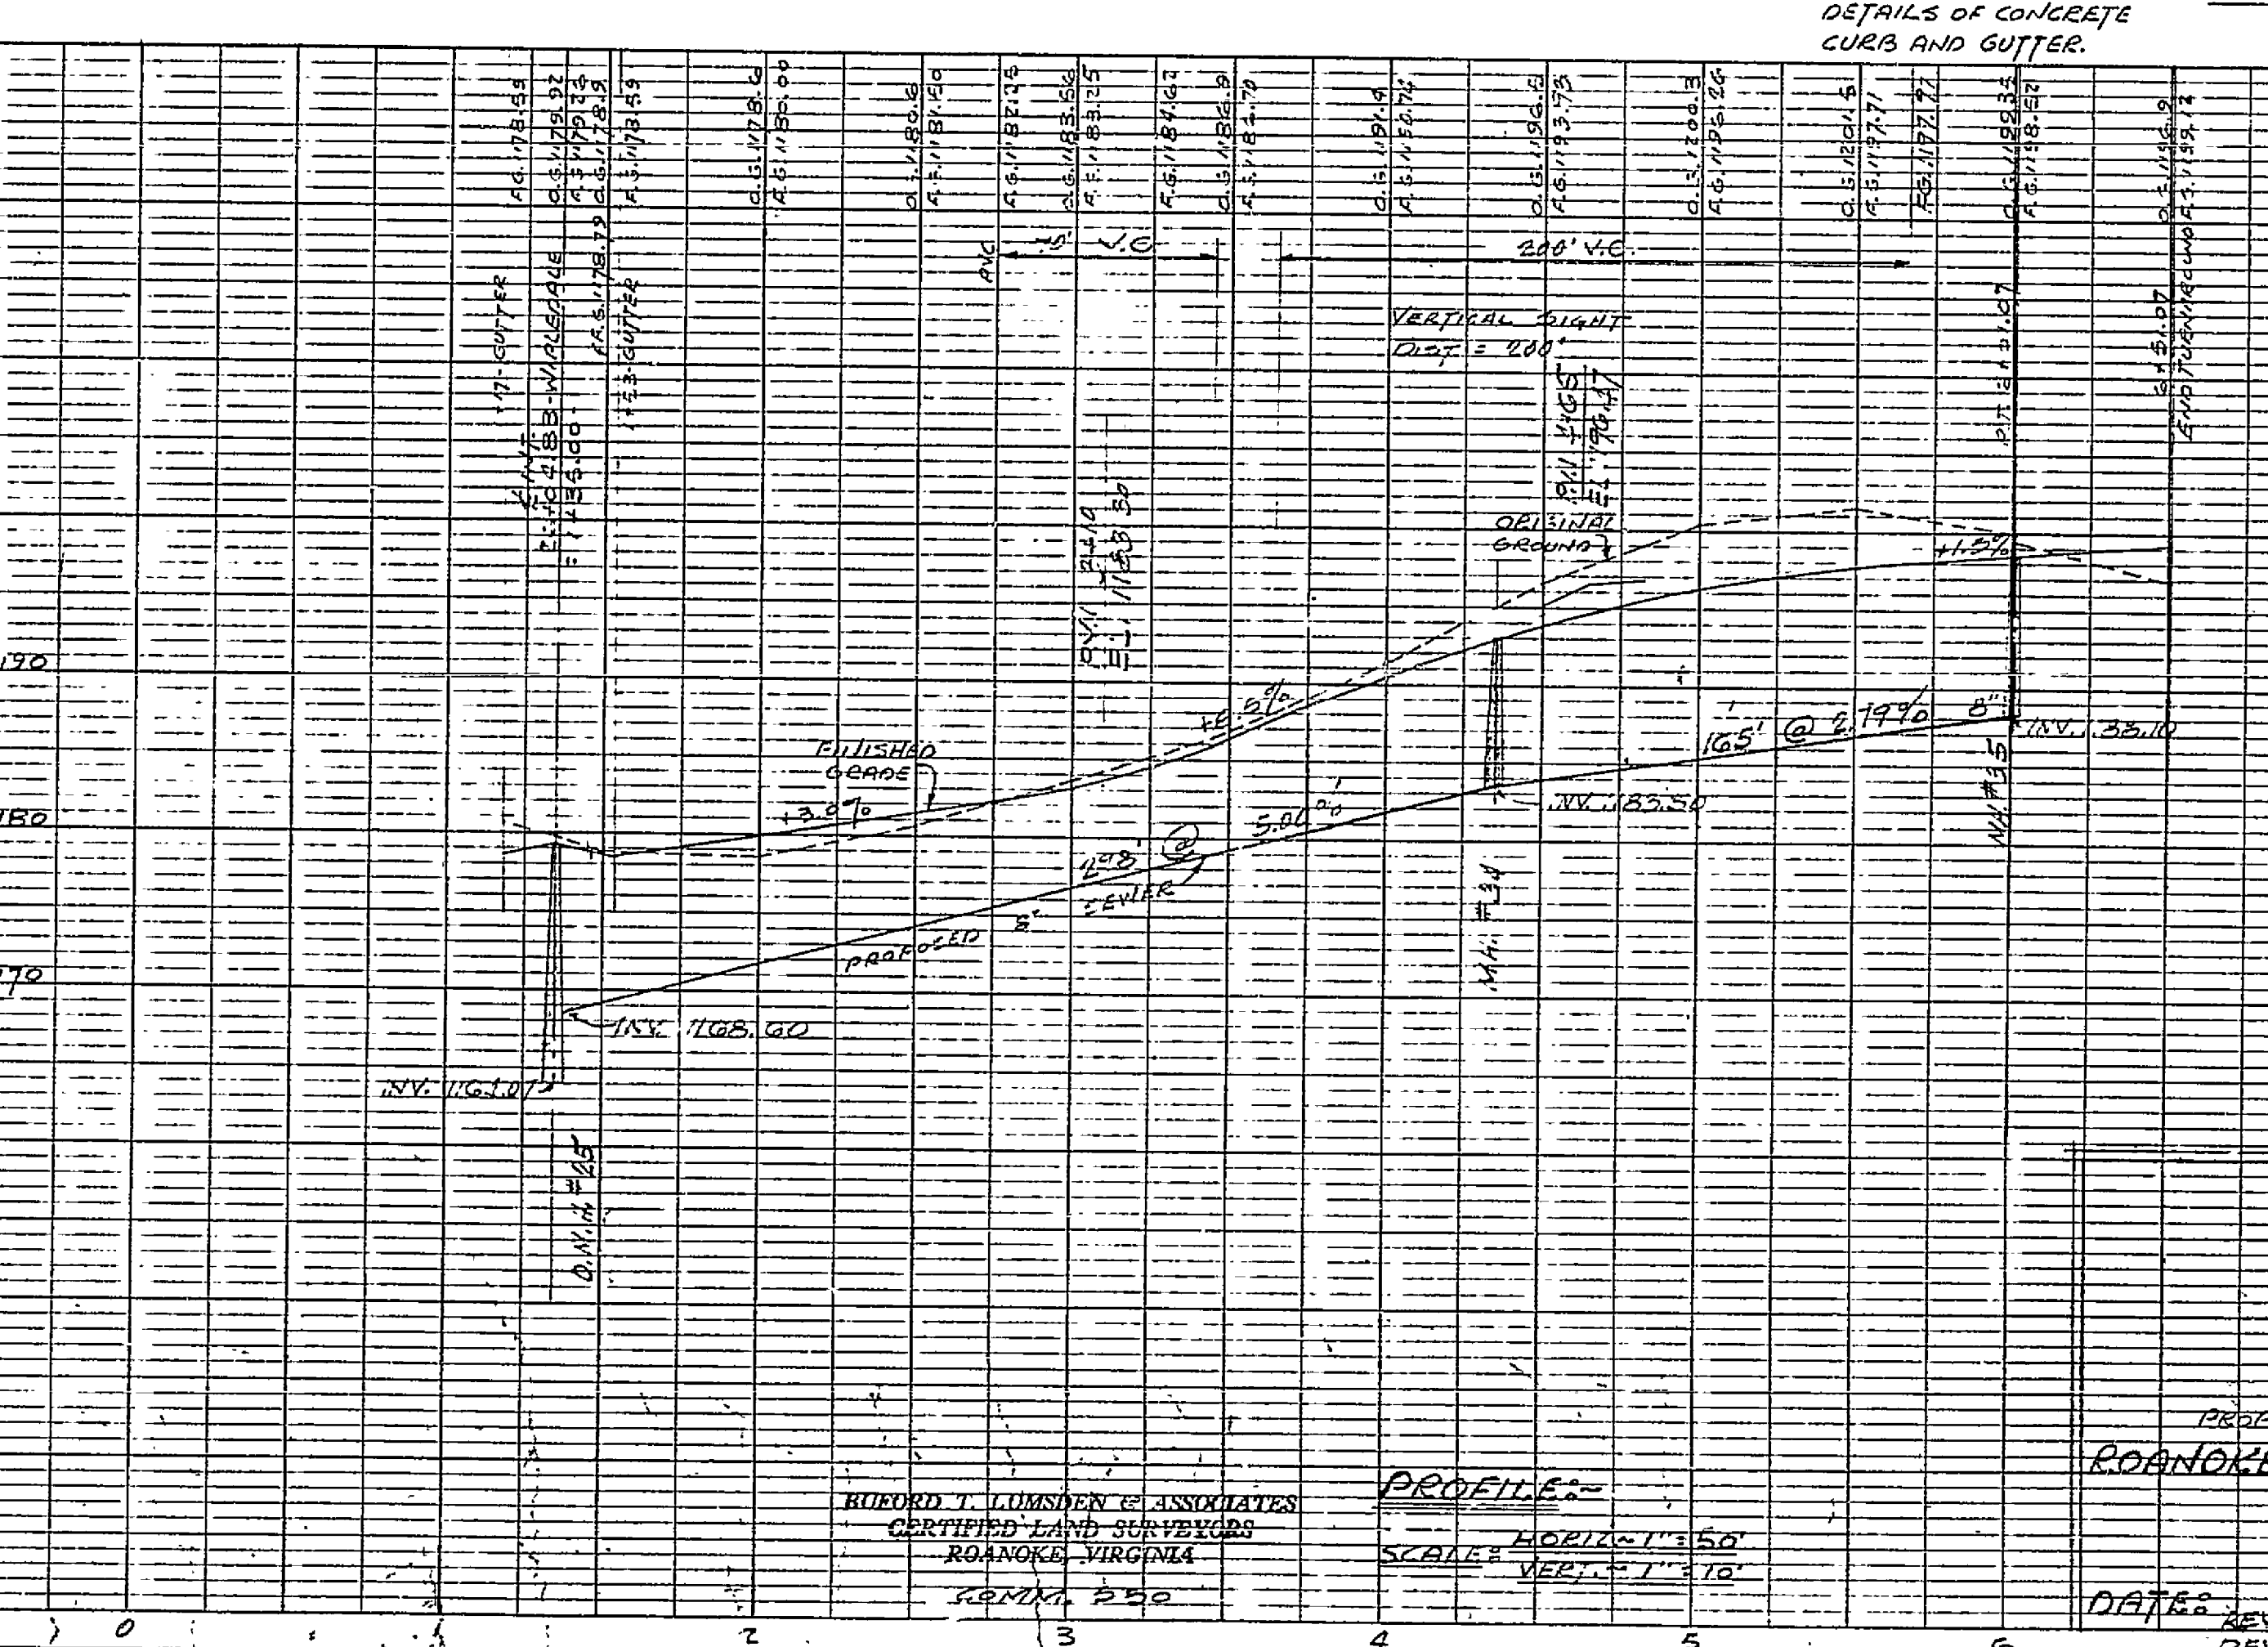
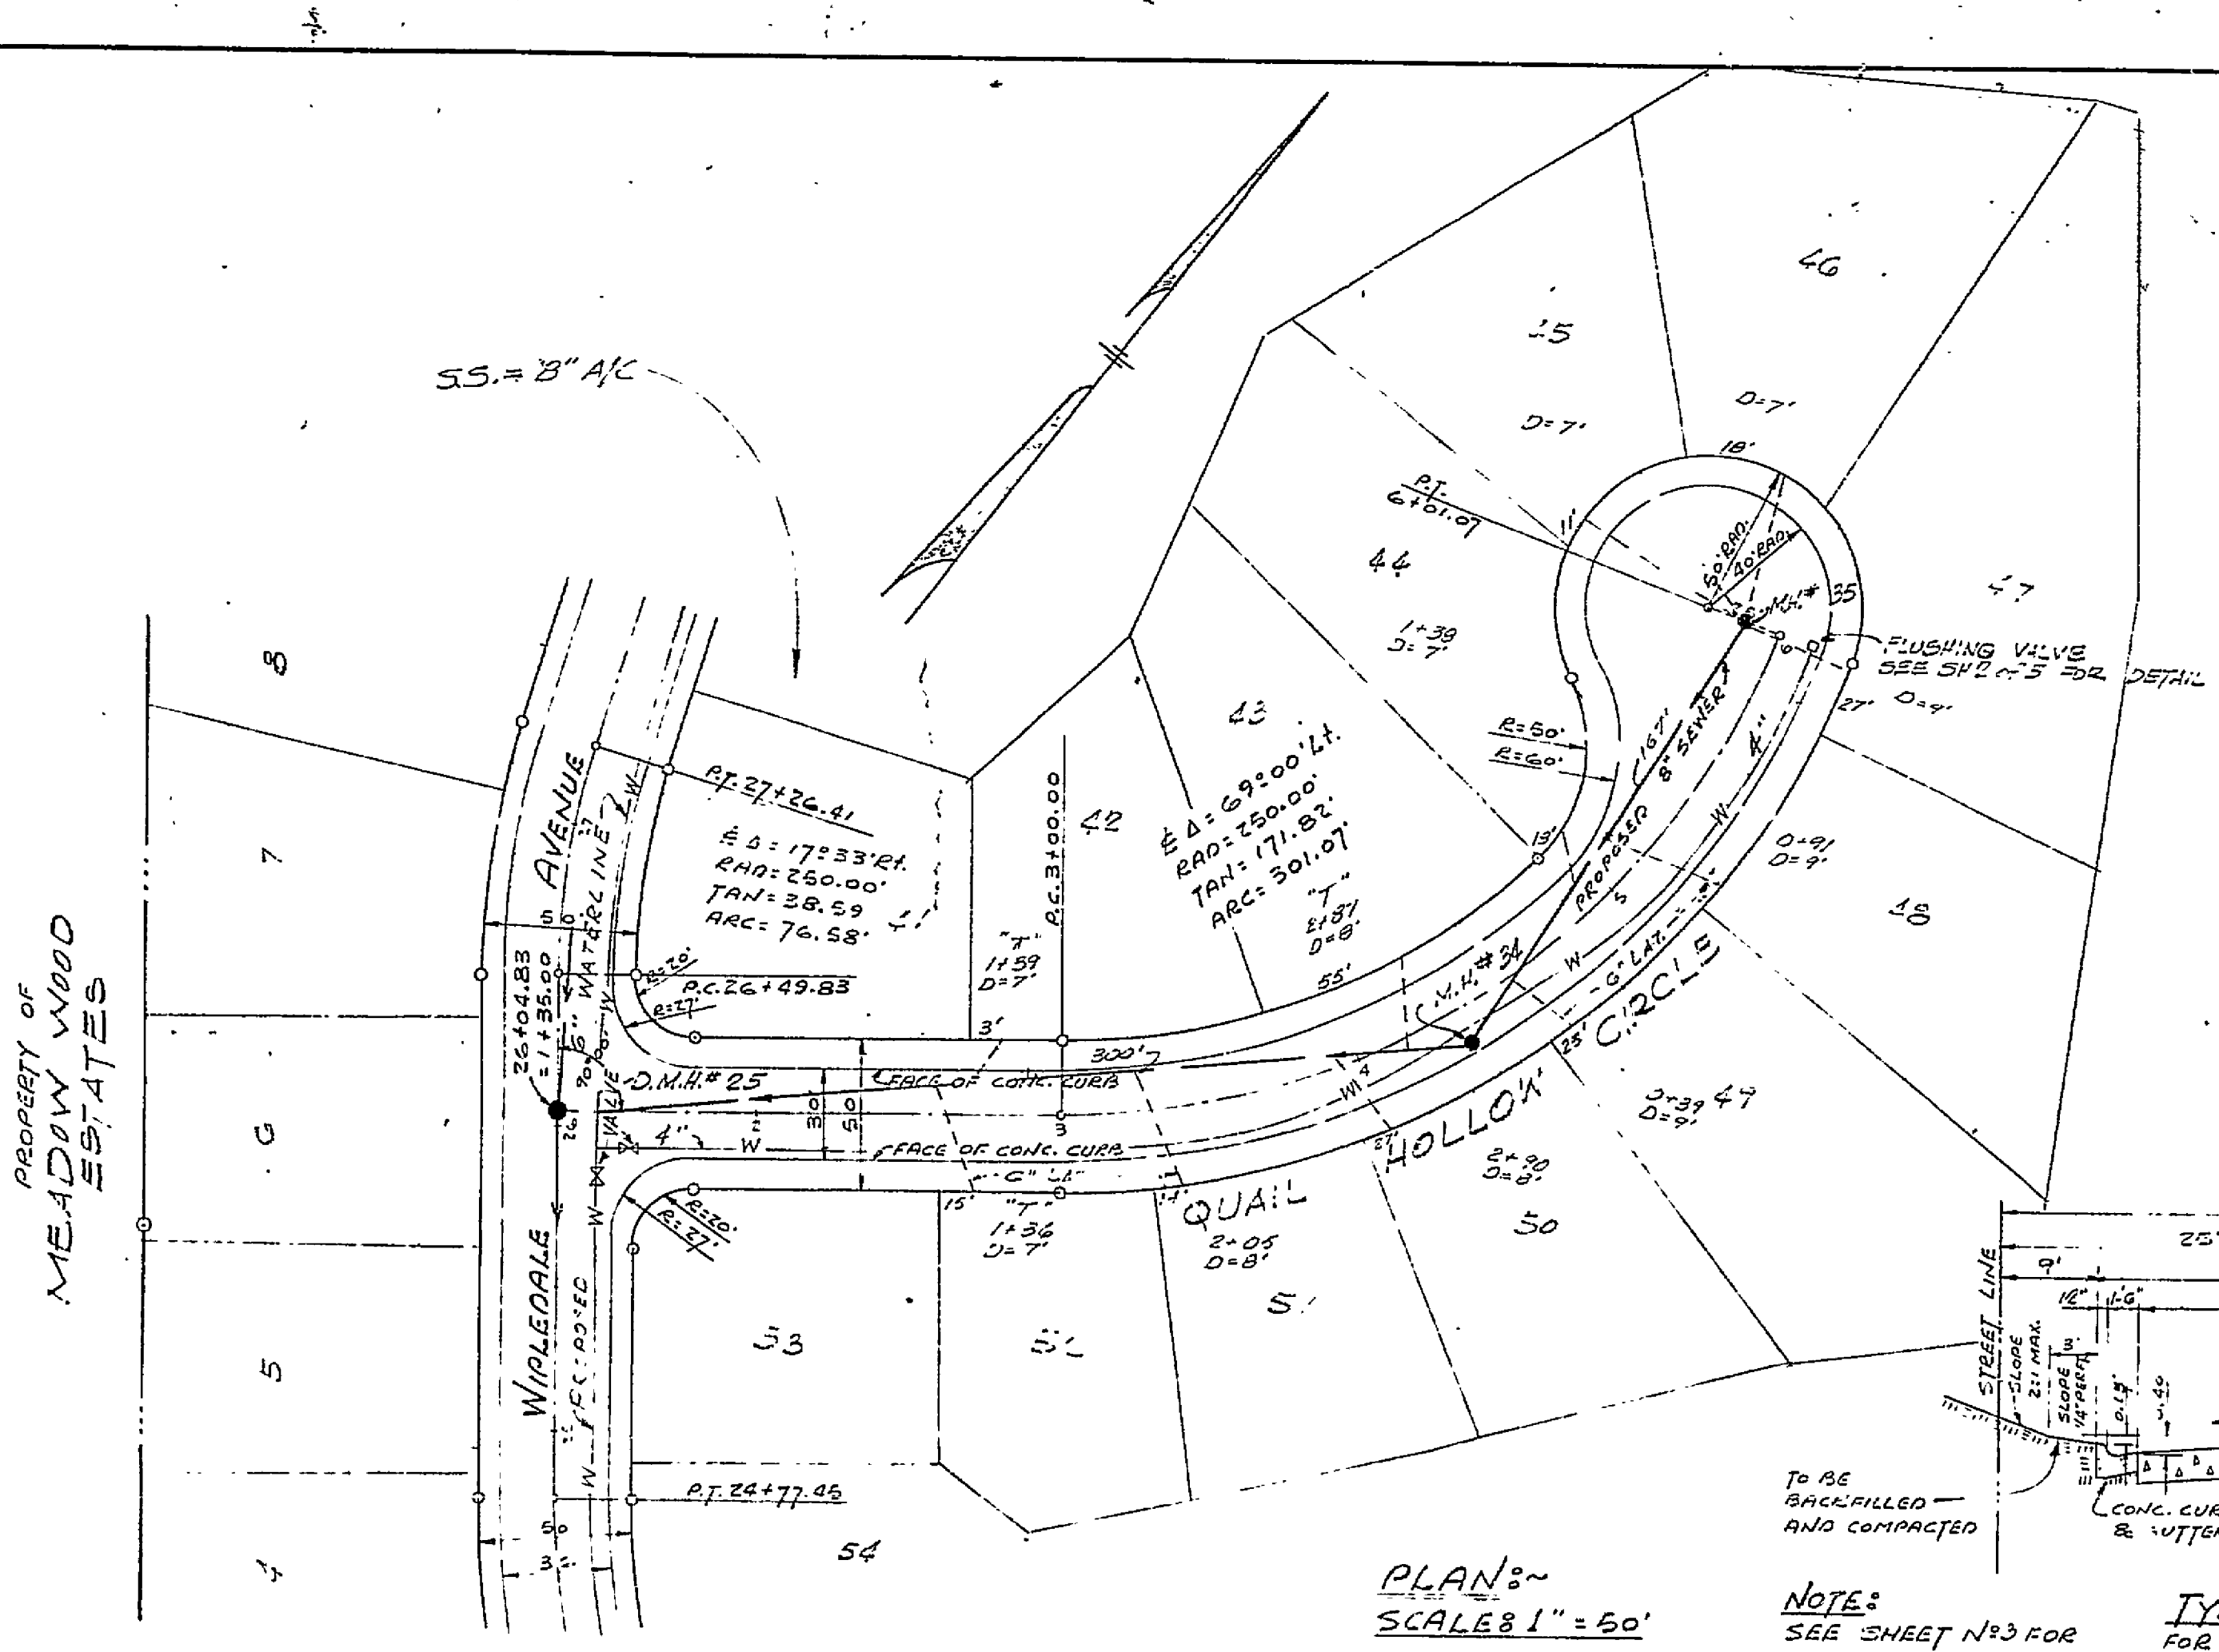
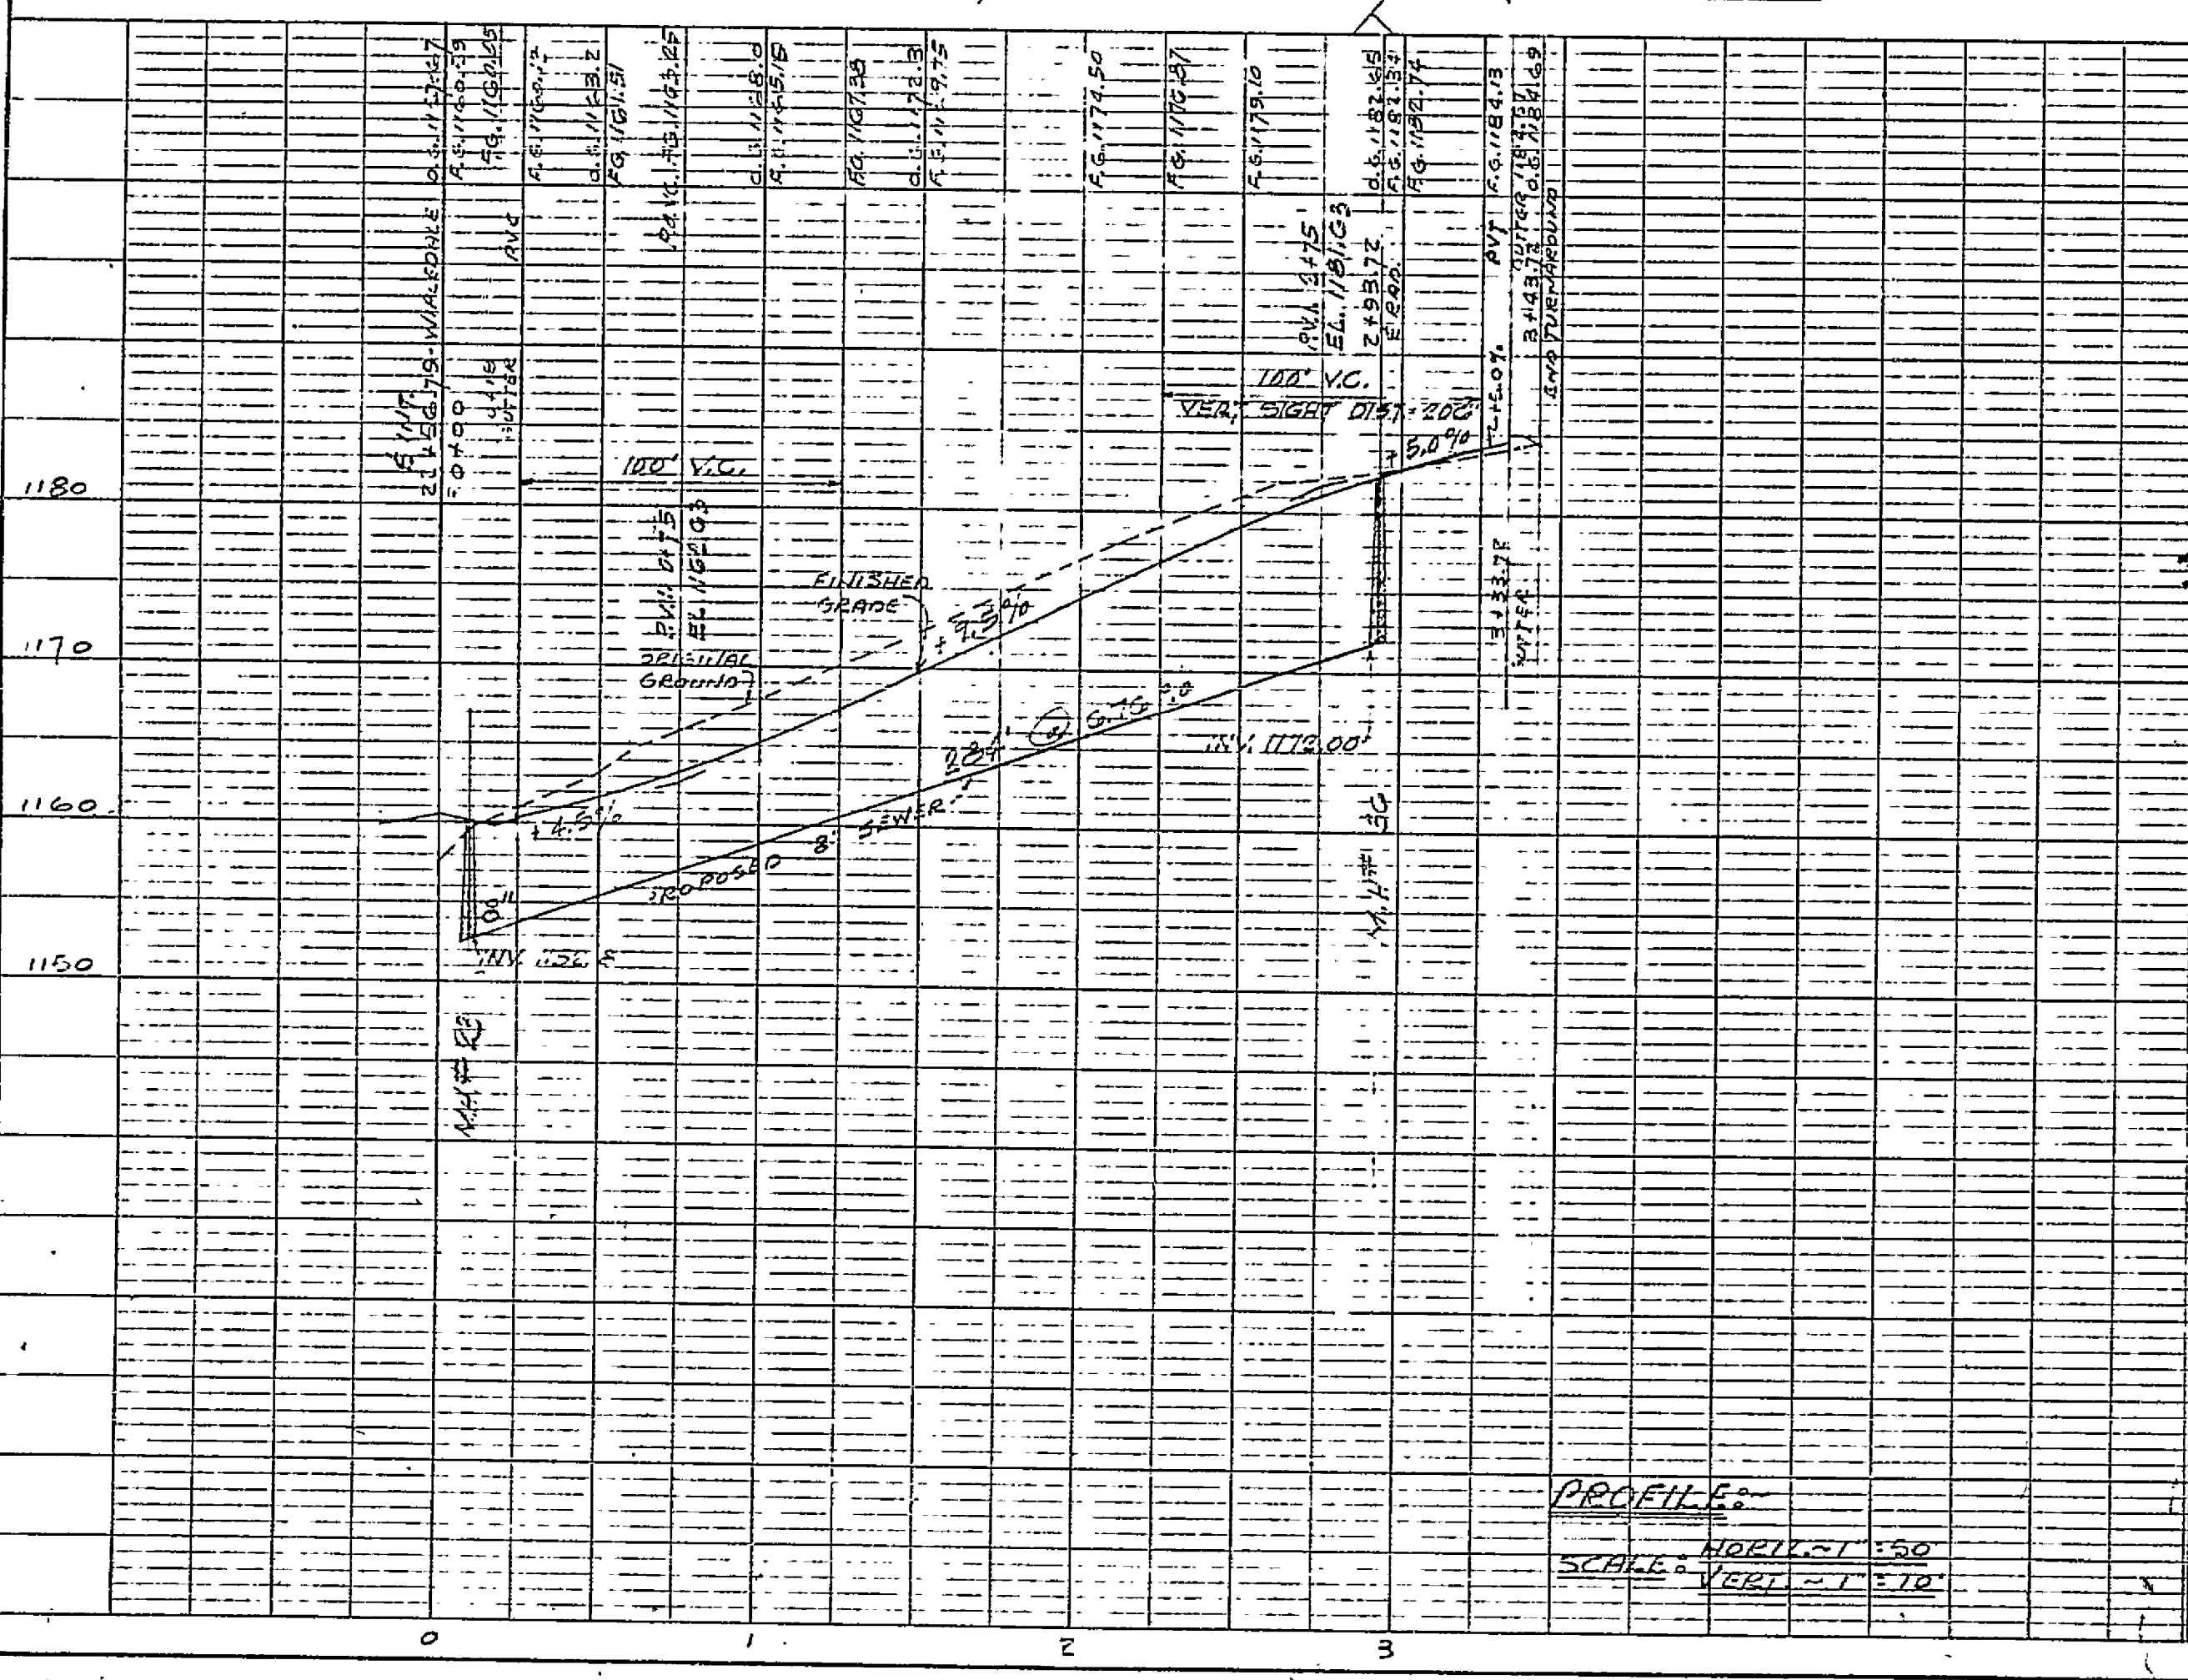


PLAN	SURVEYED	DATE
	NOTED	BY
NO.	W.T.L.	
	NOTE BOOK	RT. OF WAY CHECKED

PROFILE	GRADES	DATE
	PLOTTED	BY
NO.	GRADES CHECKED	
	STRUCTURE NOTATIONS C'D	

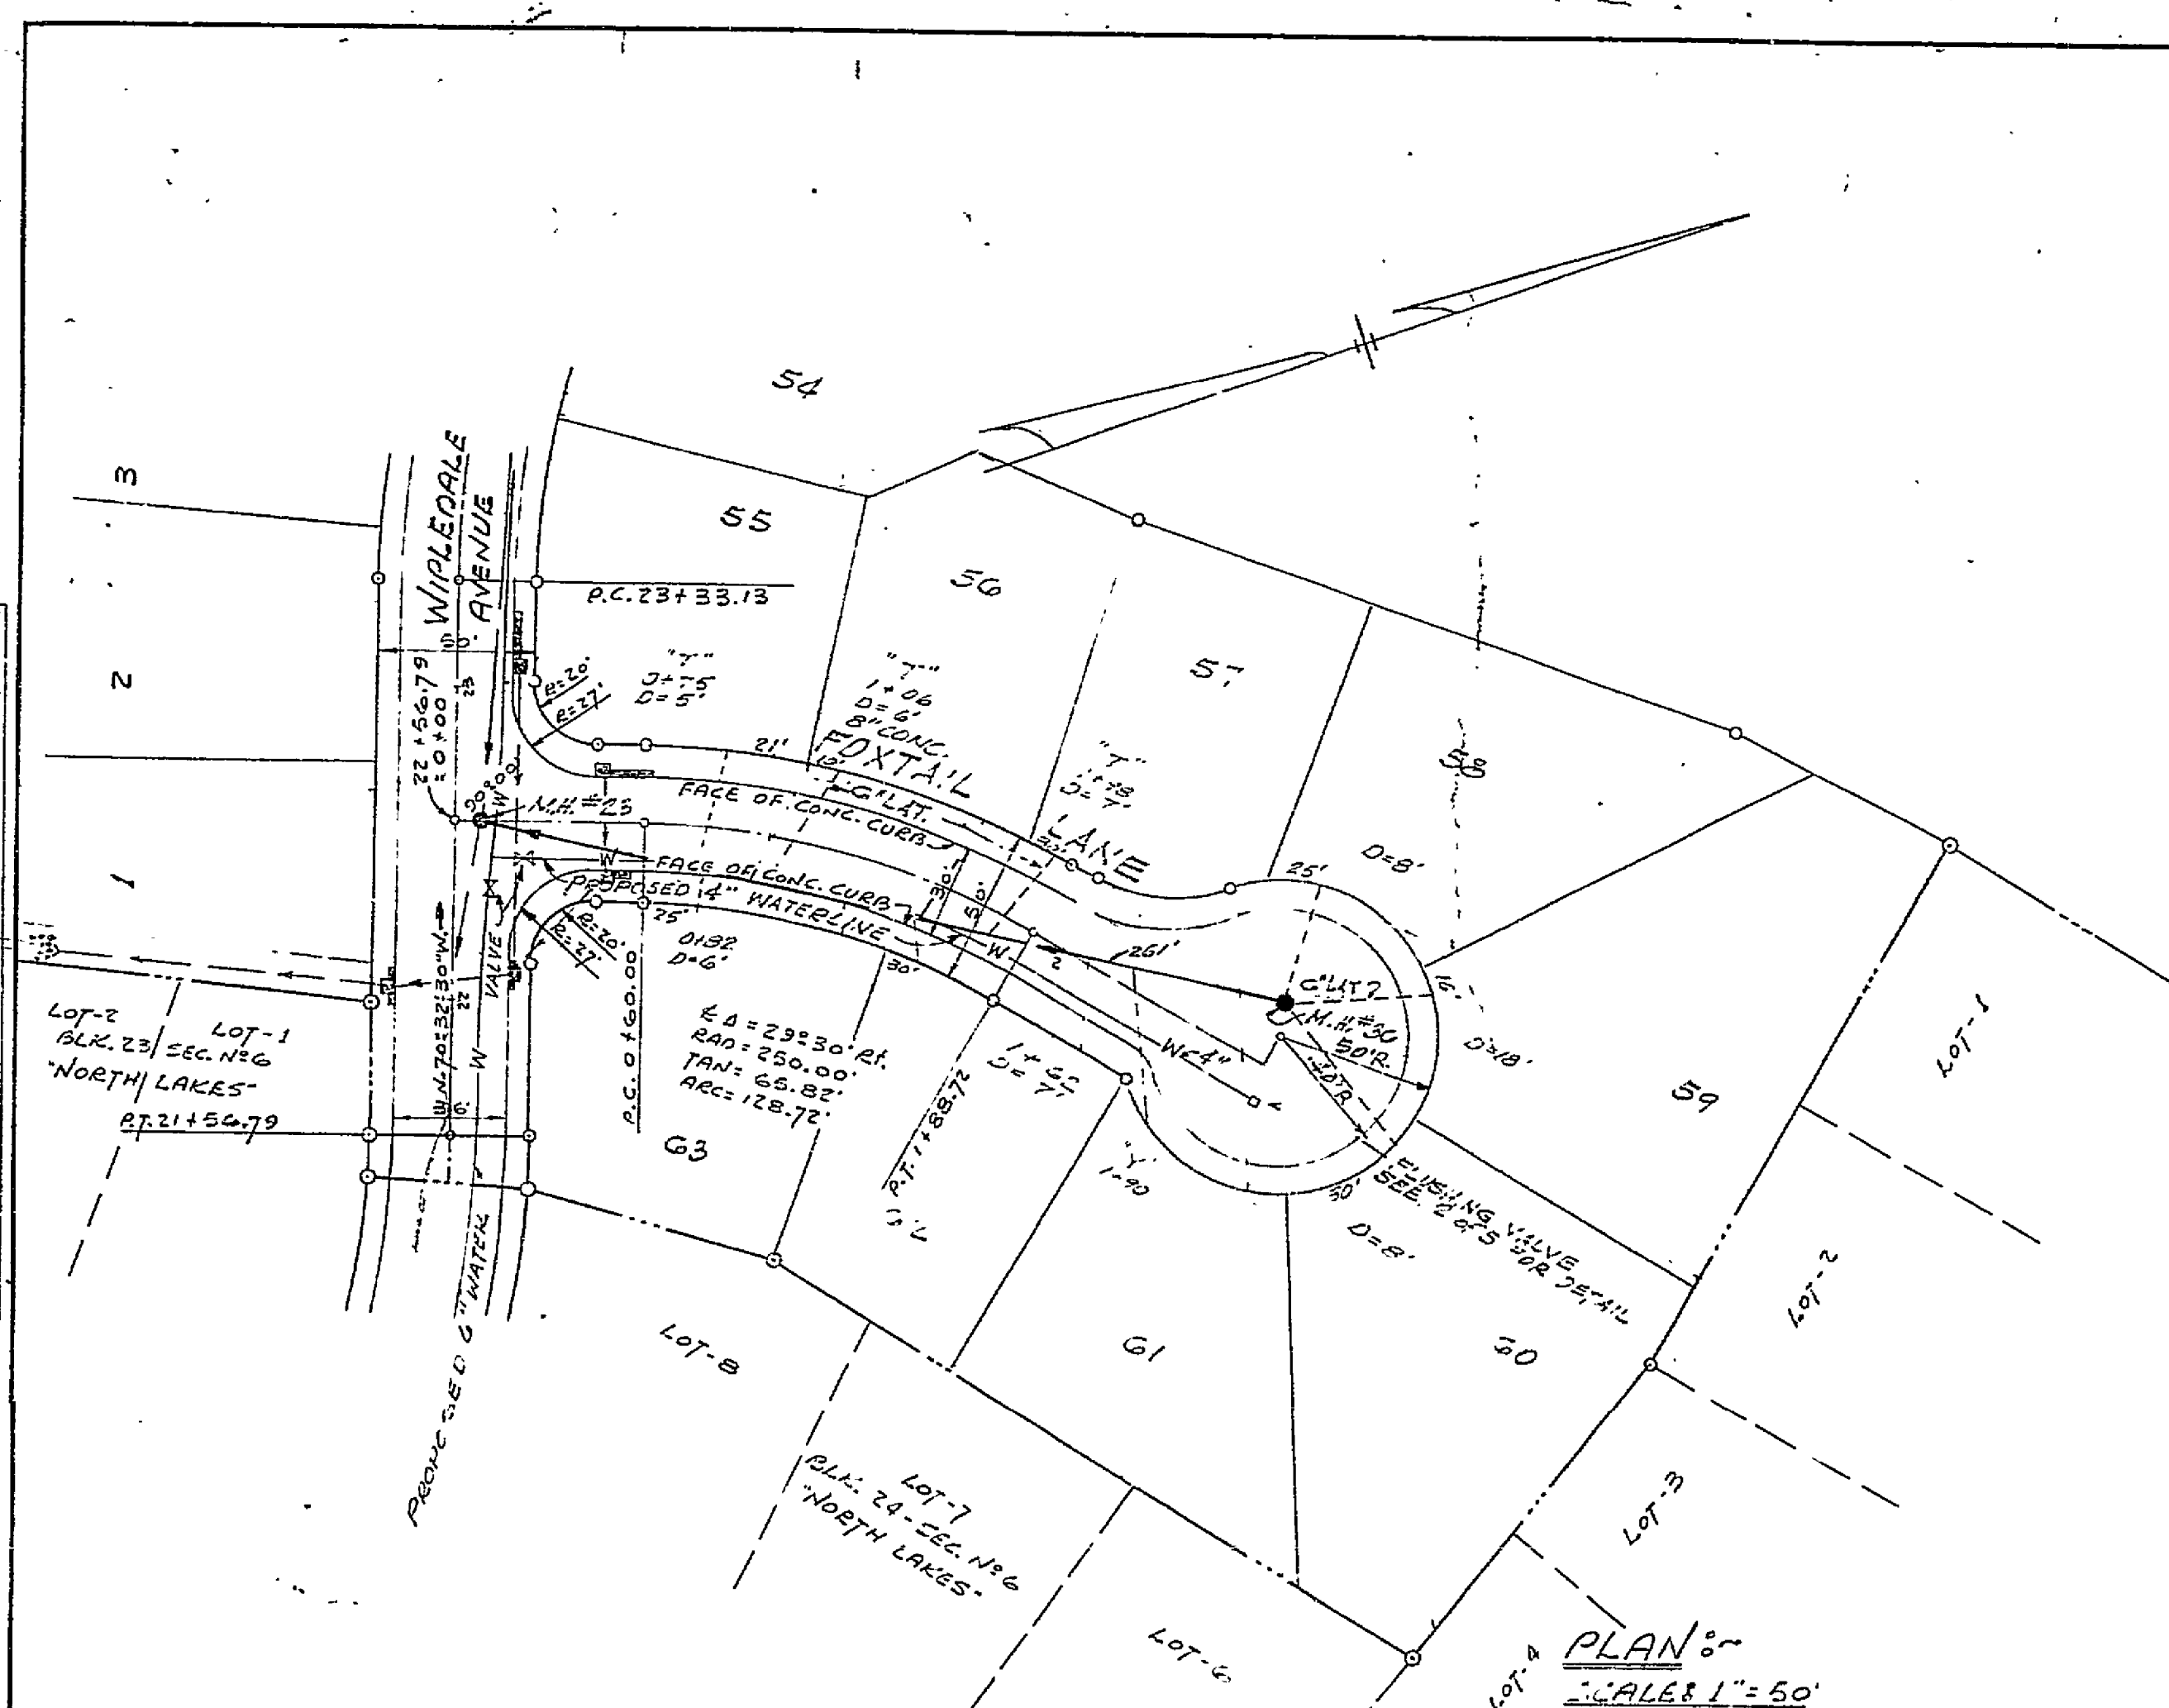

NOTE: SEE SHEET N-3 FOR DETAILS OF CONCRETE CURB AND GUTTER.

TYPICAL CROSS SECTION FOR 30 FT BETWEEN CURBS NO SCALE

AS BUILT
PLAN & PROFILE
OF
SECTION N-4
NORTH LAKES
PROPERTY OF JAMES E. LONG
ROANOKE CO., VIRGINIA
DATE 5 NOV 1971
REV 1 DEC 1971
REV 26 FEB 1972
REV 2 MAY 1976
REV 17 DEC 1973
RC-2195

PLATE 1, PLAN-PROFILE
KUTTER & ASSOCIATES
487004

