



DATE	BY
PLANNED	WILL
NOTED	WILL
NO.	NO.

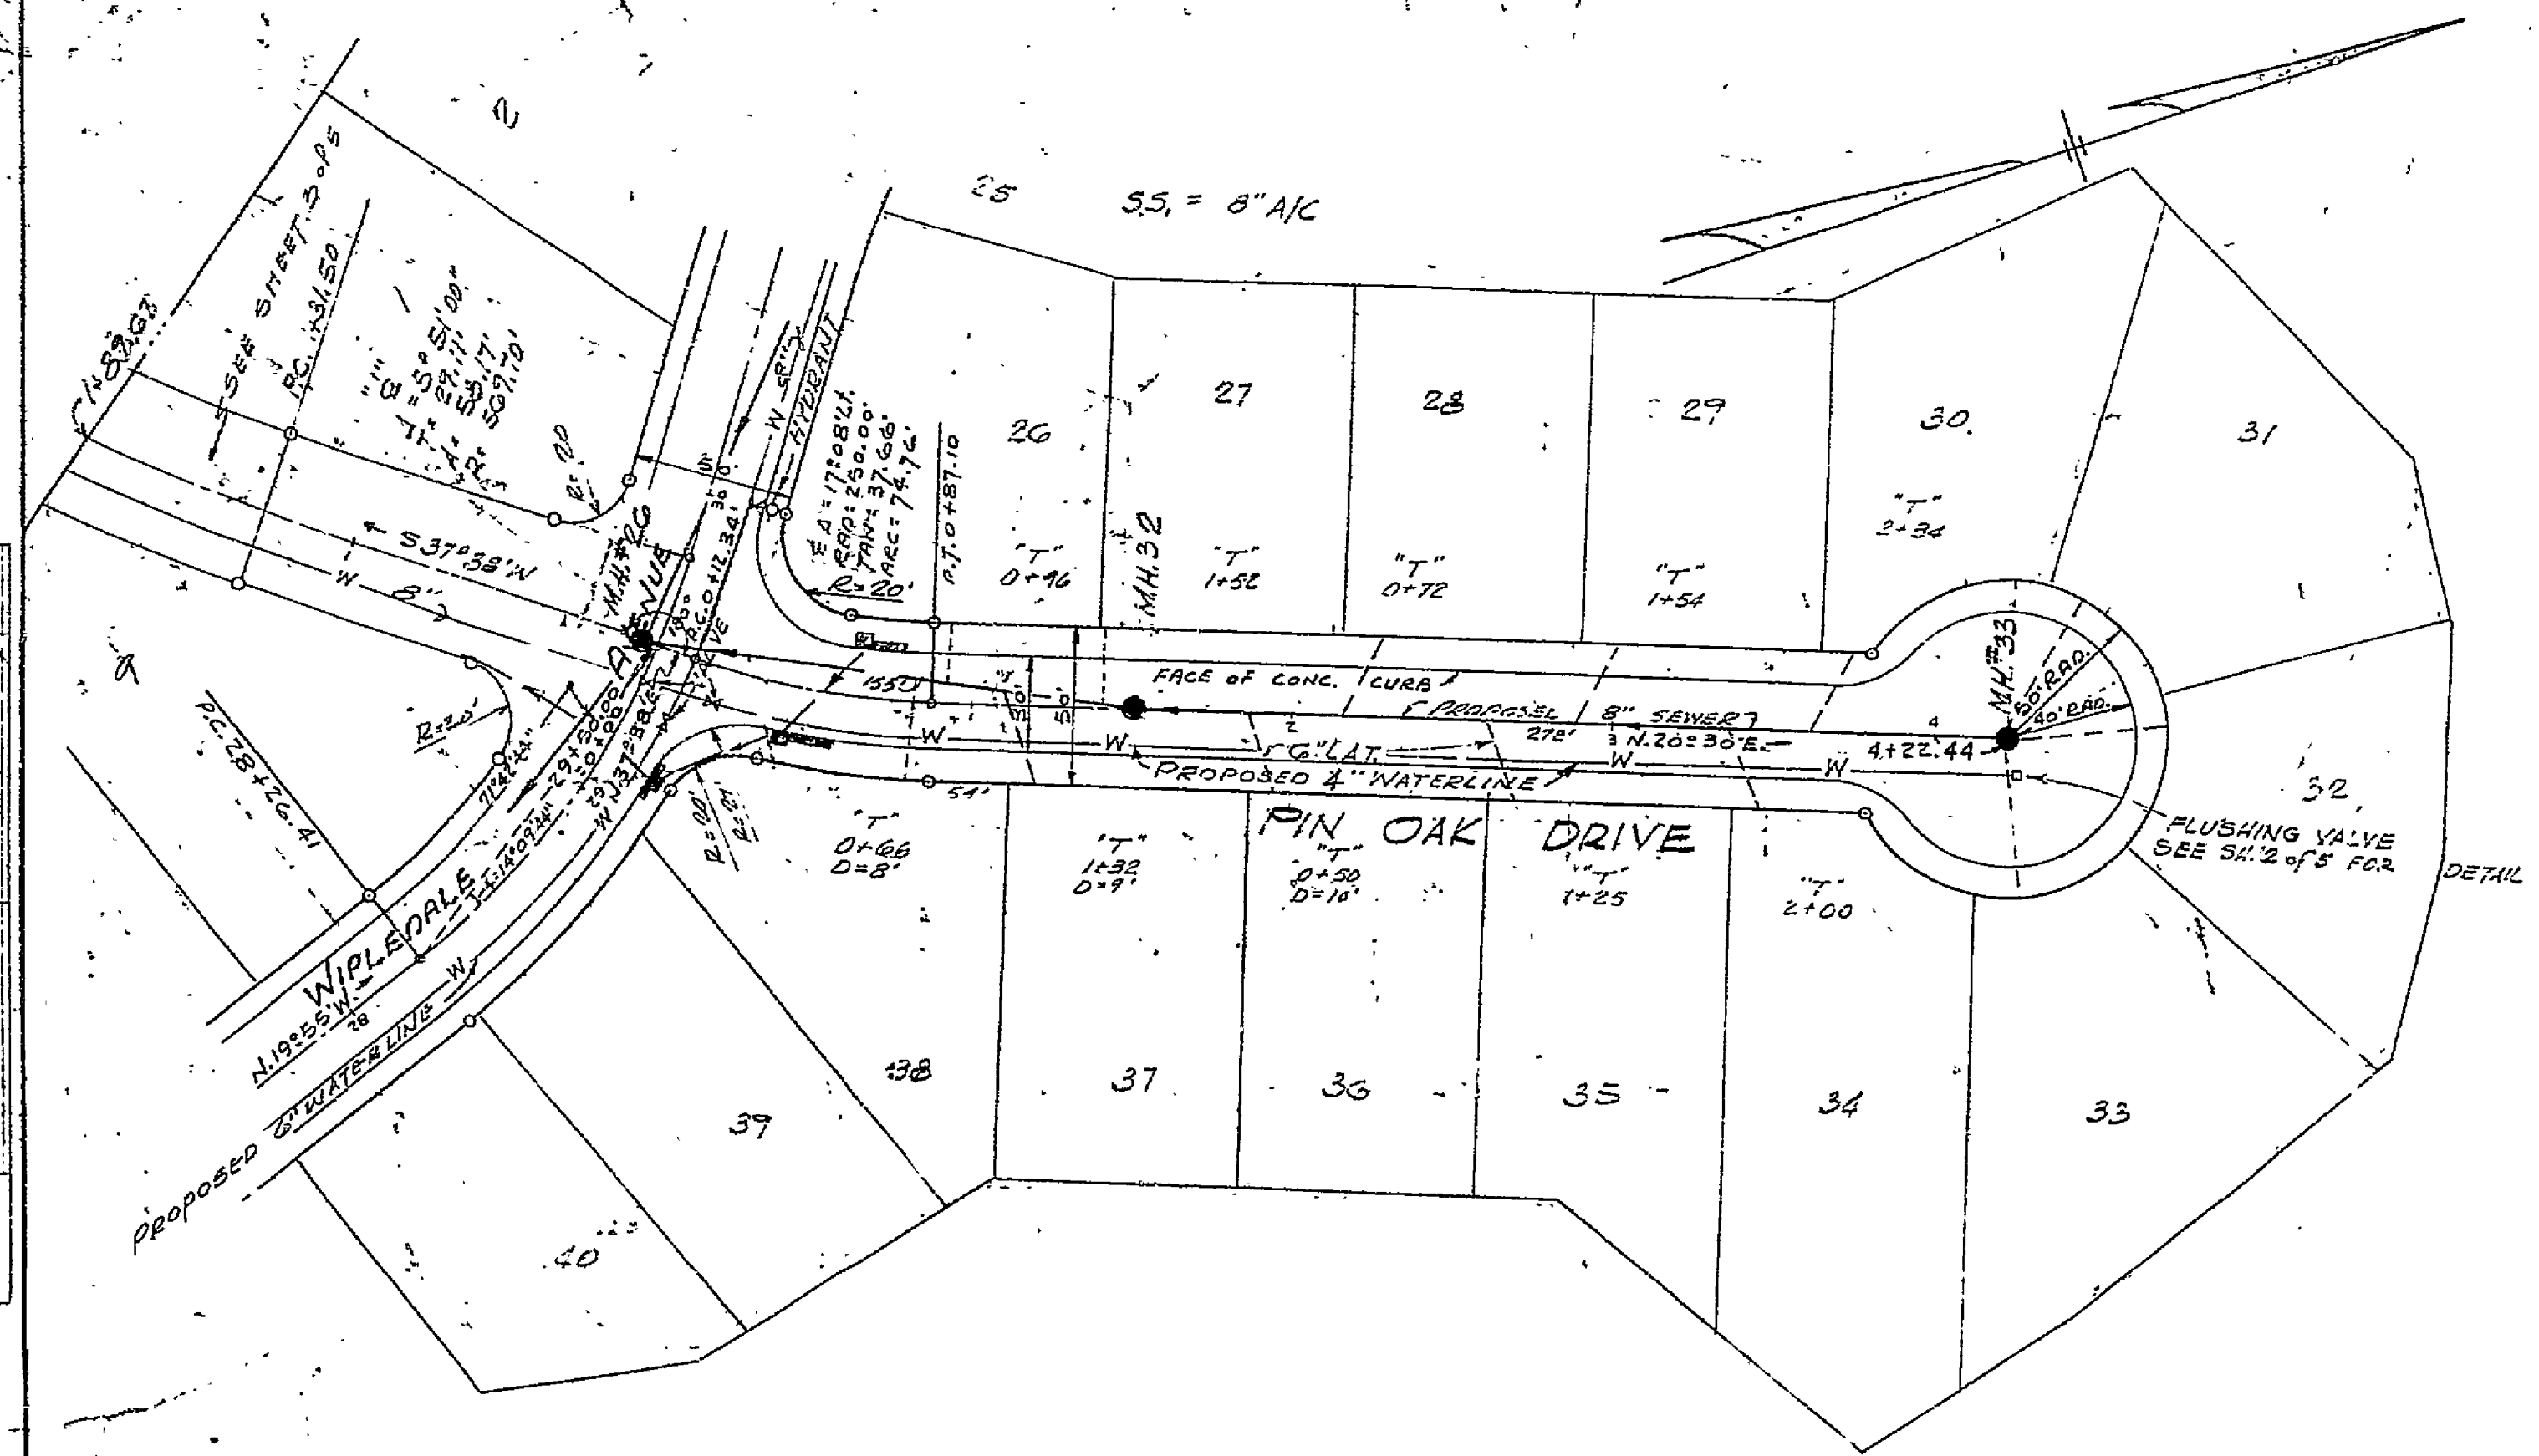


NOTE: SEE SHEET 3 FOR STORM DRAINAGE

PLAN
SCALE: 1" = 50'


DATE	BY
PLANNED	WILL
NOTED	WILL
NO.	NO.

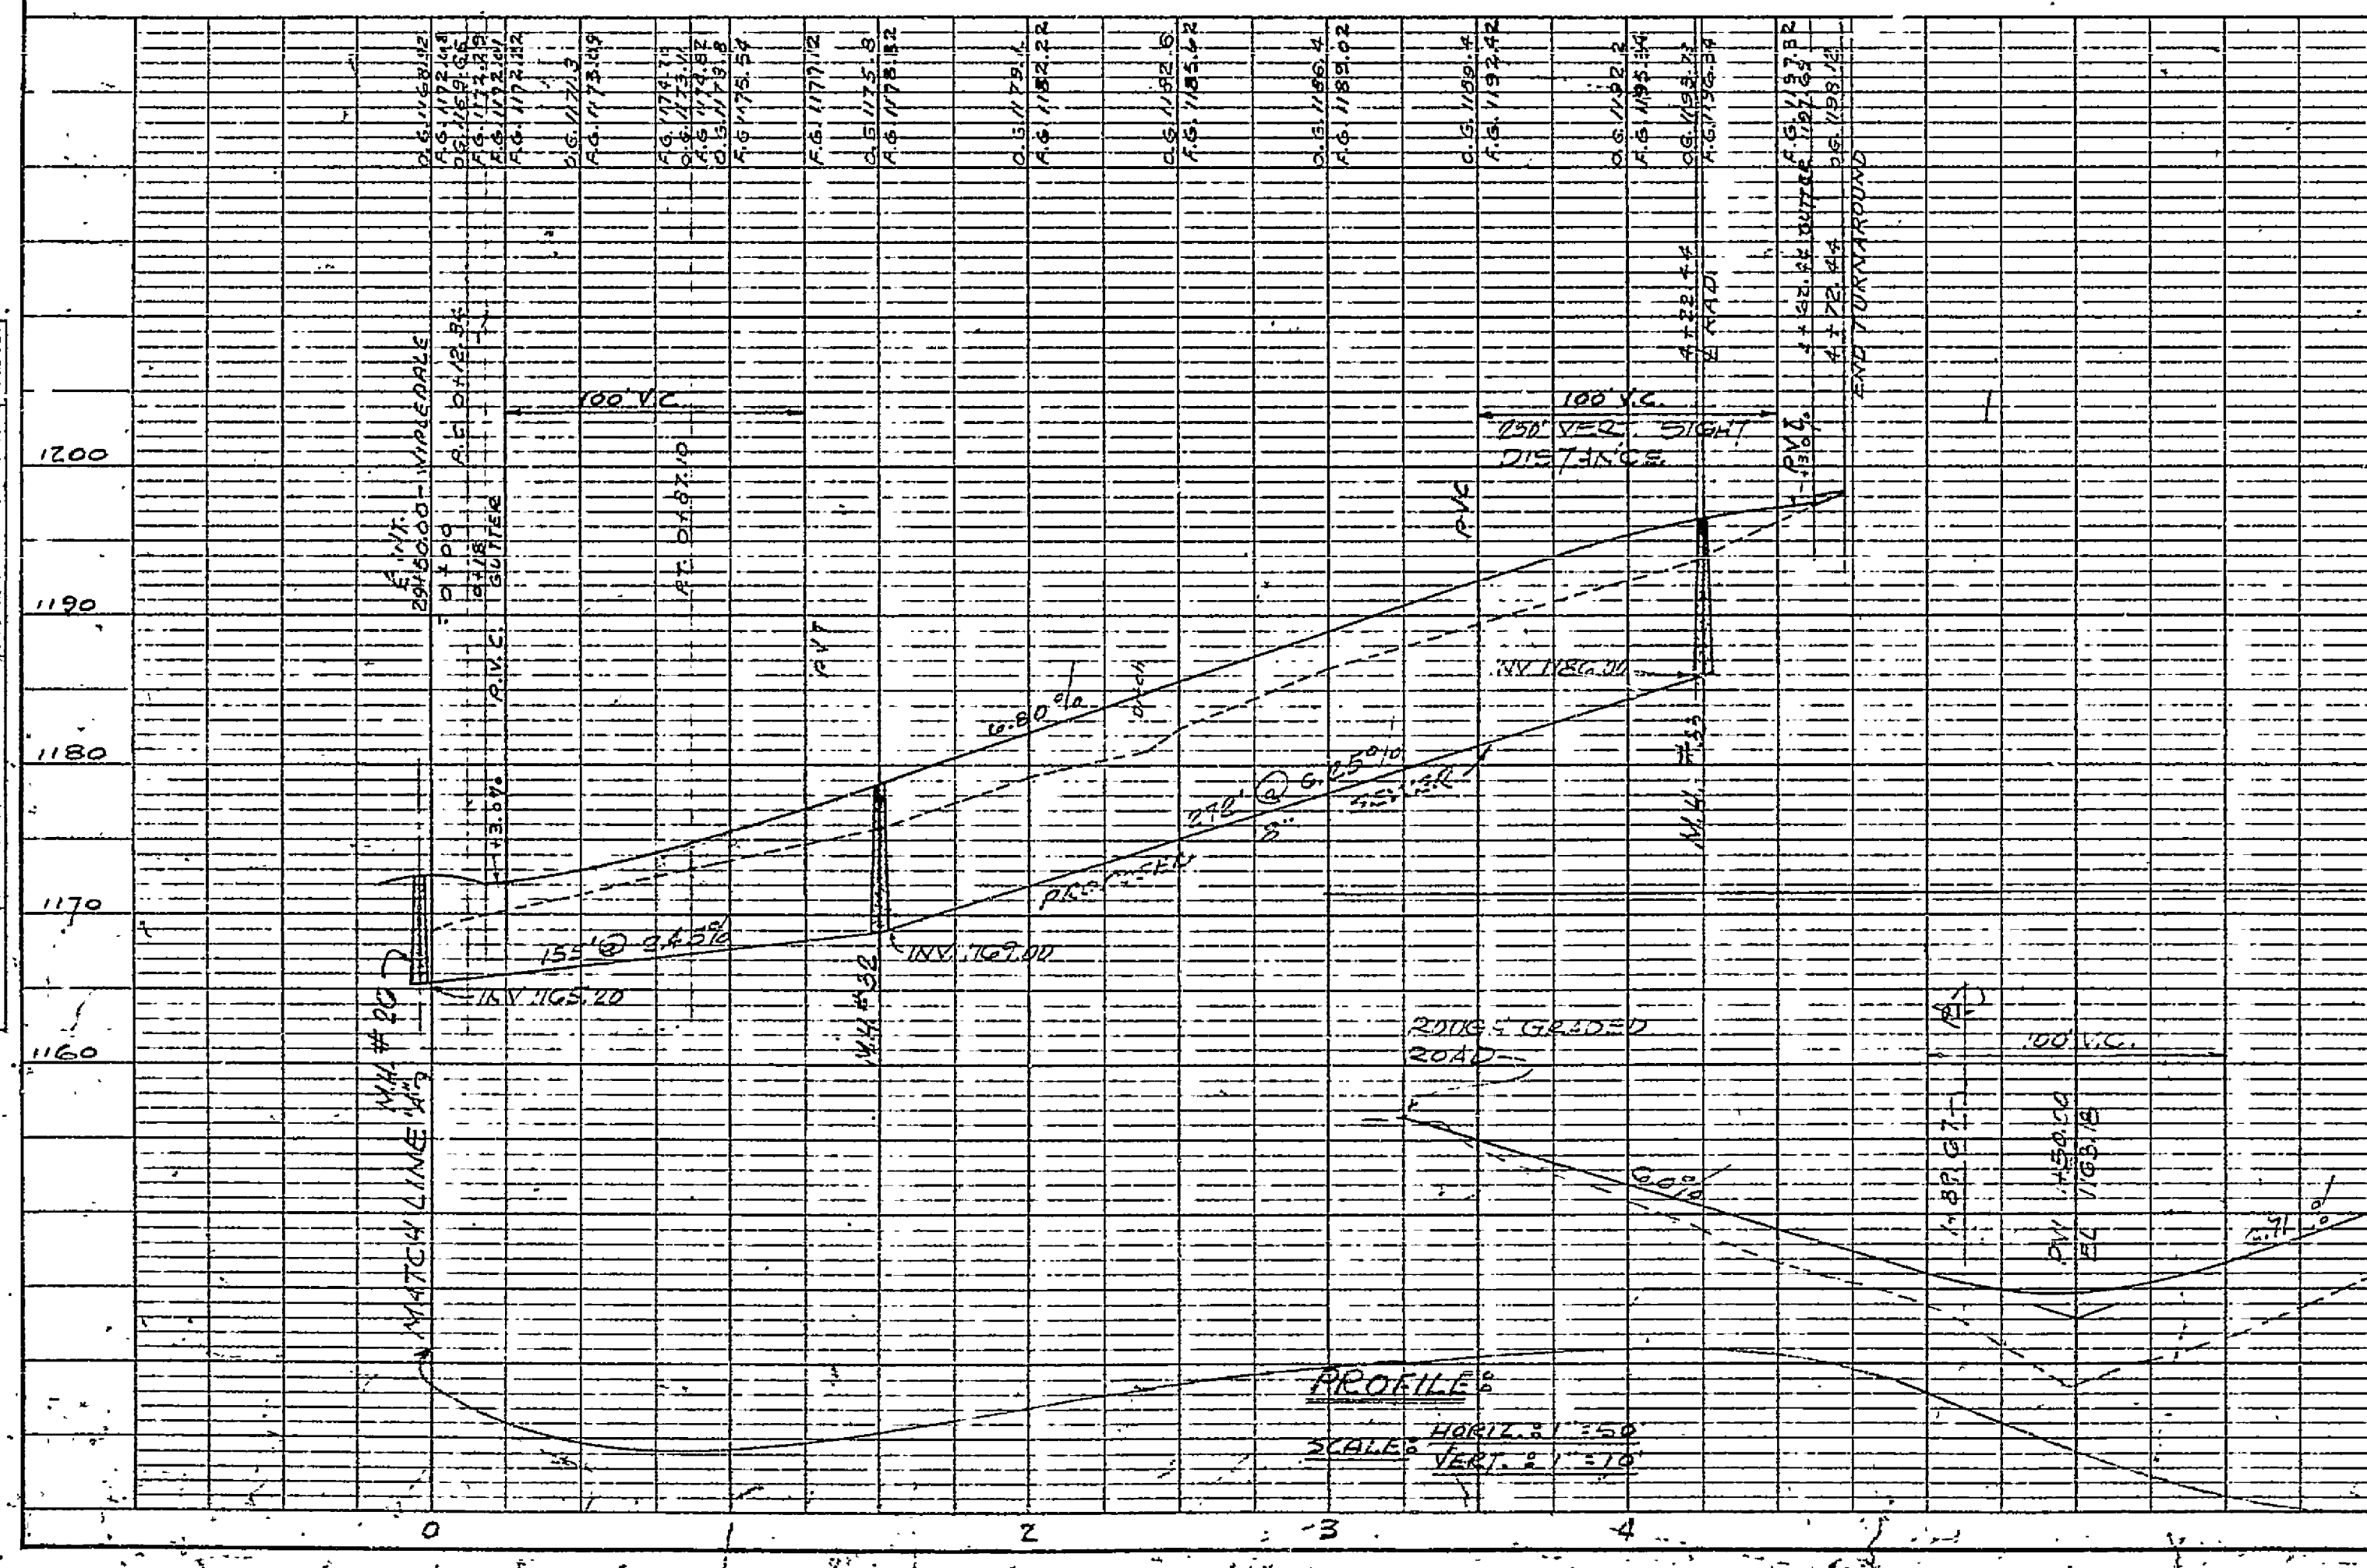

PROFILE
SCALE: 1" = 10'

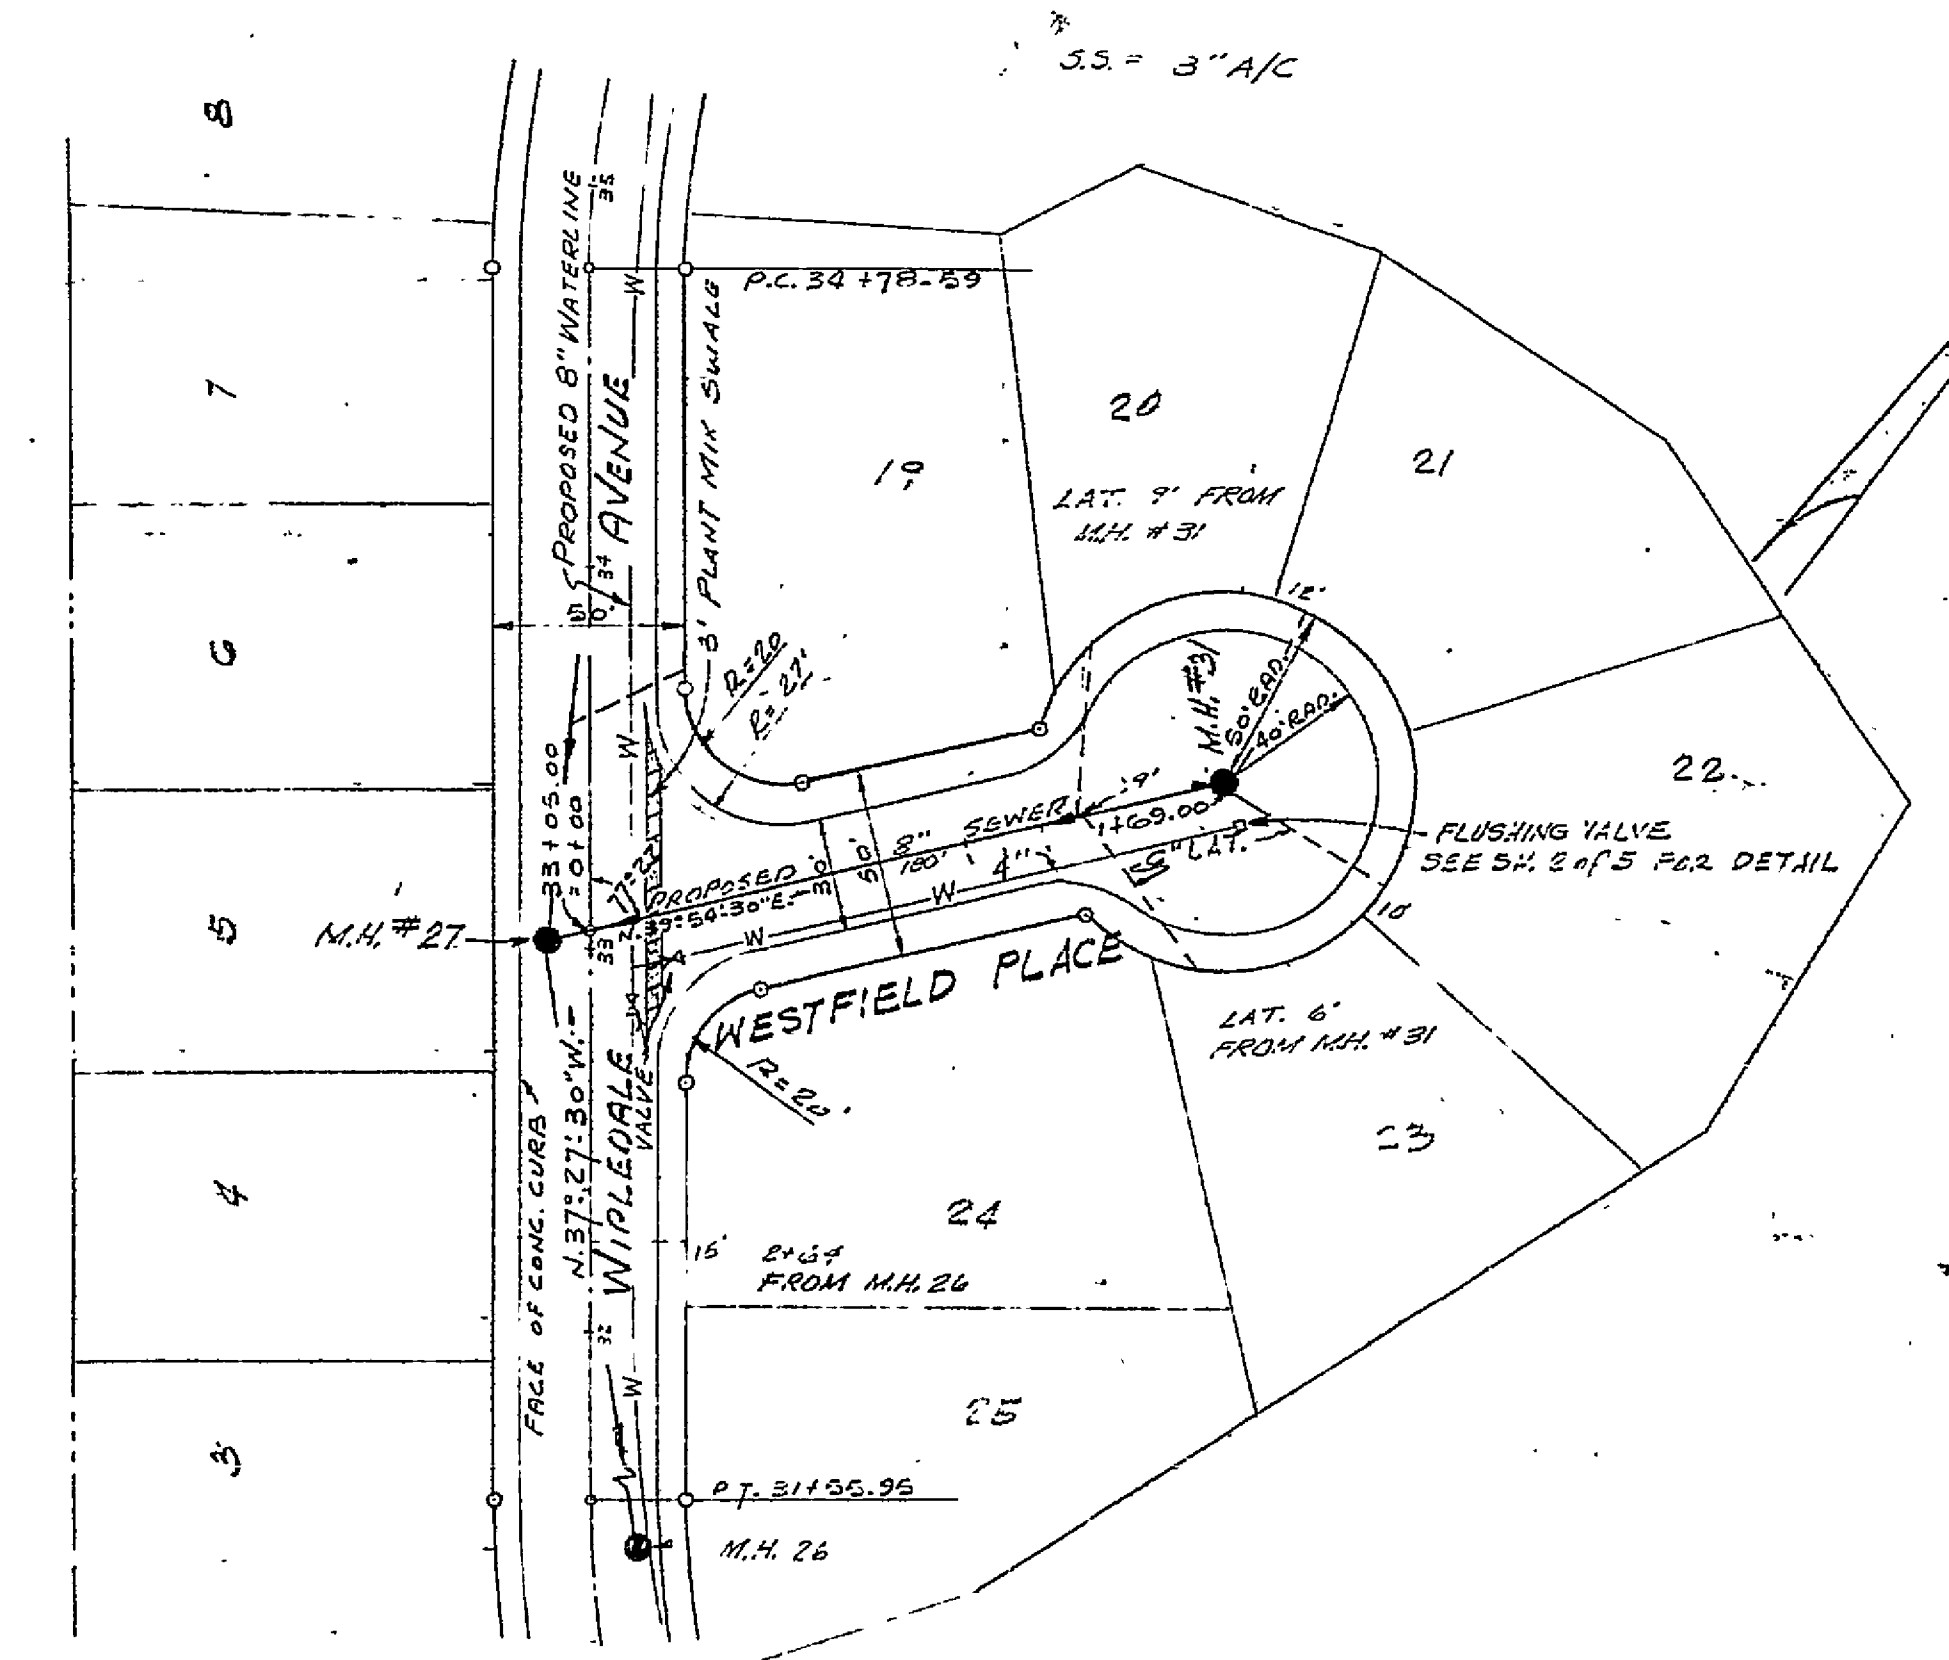

PLAN
SCALE: 1" = 50'

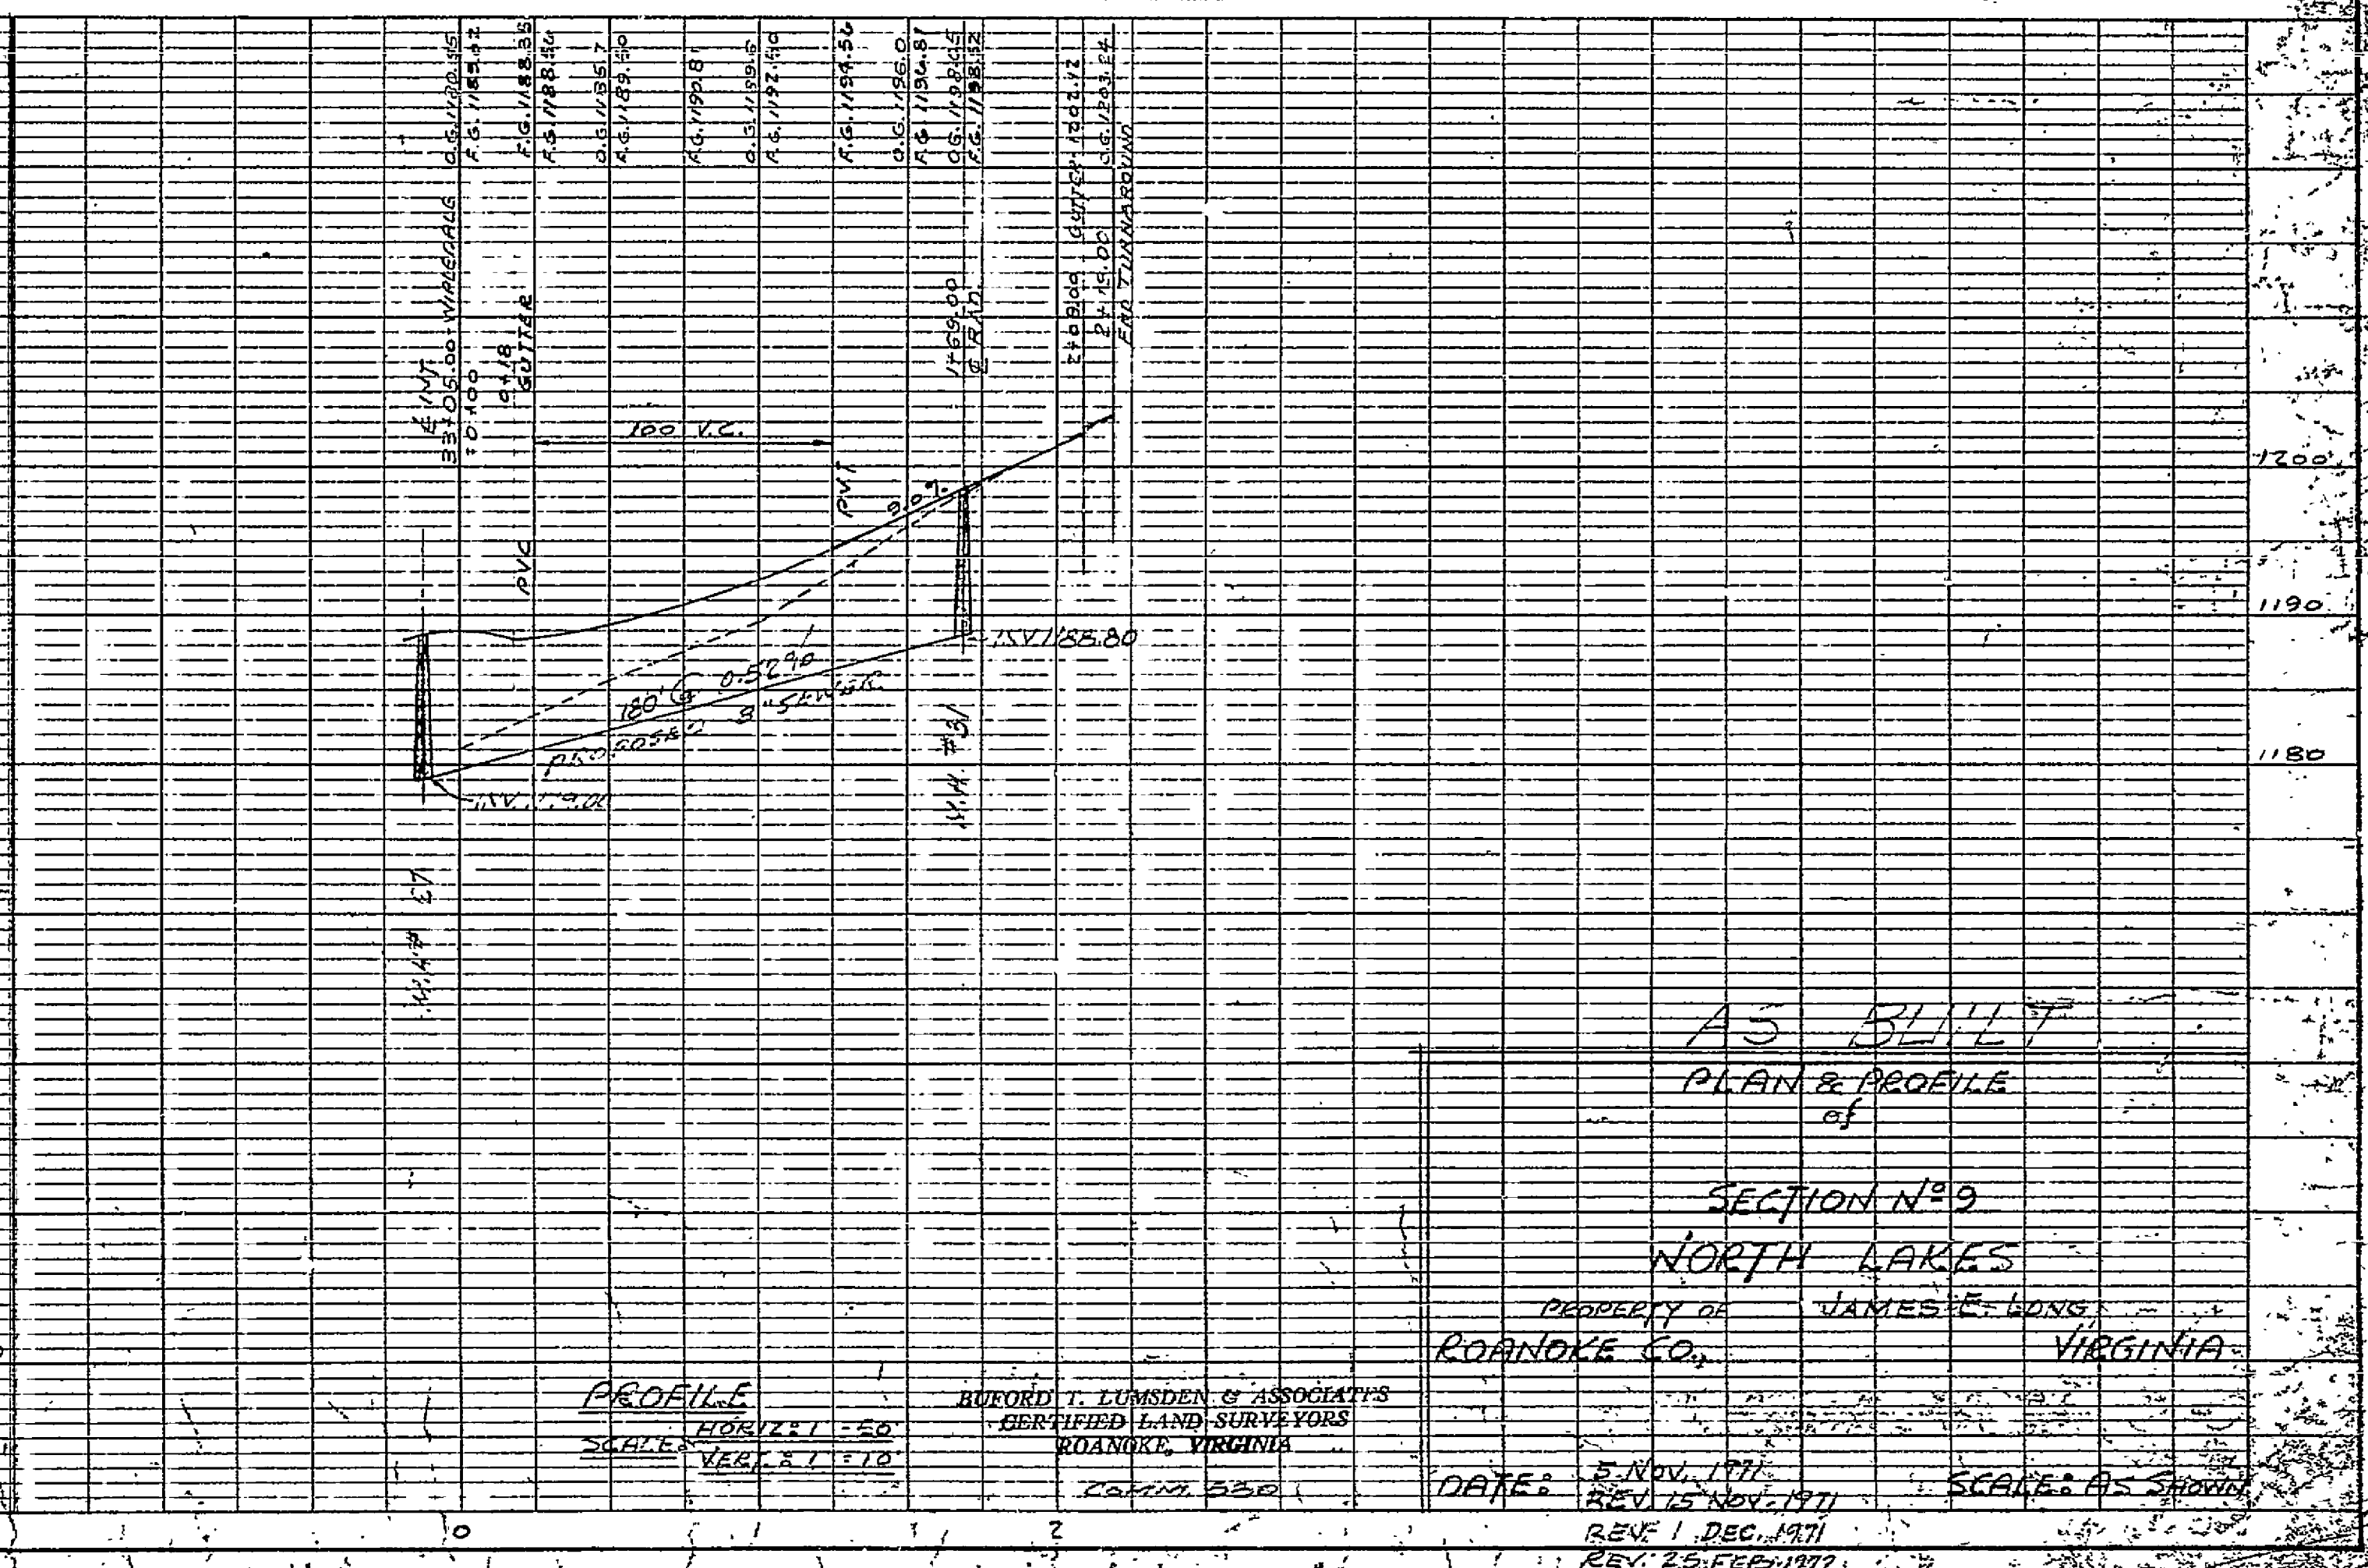

PROFILE
SCALE: 1" = 10'

AS BUILT
PLAN & PROFILE
SECTION N° 9
NORTH LAKES
PROPERTY OF JAMES E. LONG
ROANOKE CO., VIRGINIA
DATE: 5 NOV. 1971
REV. 1 DEC. 1971
REV. 26 FEB. 1972
REV. 17 DEC. 1973
SCALE: AS SHOWN
RC 2196

DATE: 11 JAN. 1972
BY: J. L. LUMSDEN & ASSOCIATES
CERTIFIED LAND SURVEYORS
ROANOKE, VIRGINIA