




VDOT STD. GR-2 GUARDRAIL

30' 0' 30' 60' 1" = 30'

GRAPHIC SCALE

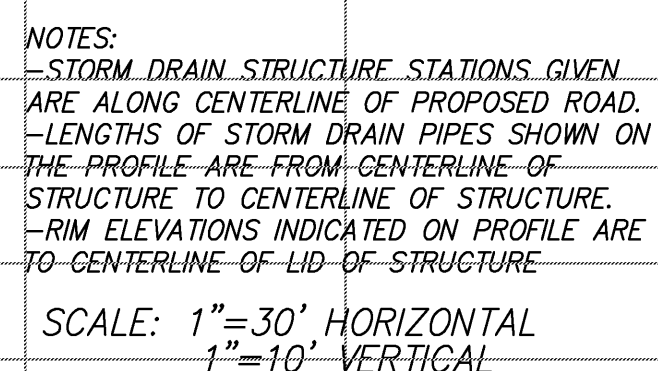

AS-BUILT UTILITY PLAN AND
ROAD PLAN & PROFILE STA. 9+63.5 TO 15+04
AND ROAD PLAN STA. 30+00 TO 33+45.5
ROANOKE COUNTY CENTER FOR RESEARCH AND
TECHNOLOGY-GLENMARY DRIVE EXTENSION

Designed: JWK
Checked: FBC
Date: March 8, 2006
Rev. Apr. 12, 2007
Scale: 1"=30'
Tax Parcel: 54.00-1
W.O. No.: 05-0012

 **CWA**

CALDWELL WHITE ASSOCIATES

ENGINEERS / SURVEYORS / PLANNERS

**4803 MELROSE AVENUE, N.W.
P.O. BOX 6260
ROANOKE, VIRGINIA 24017
(540) 368-3440
FAX: (540) 368-8702**