



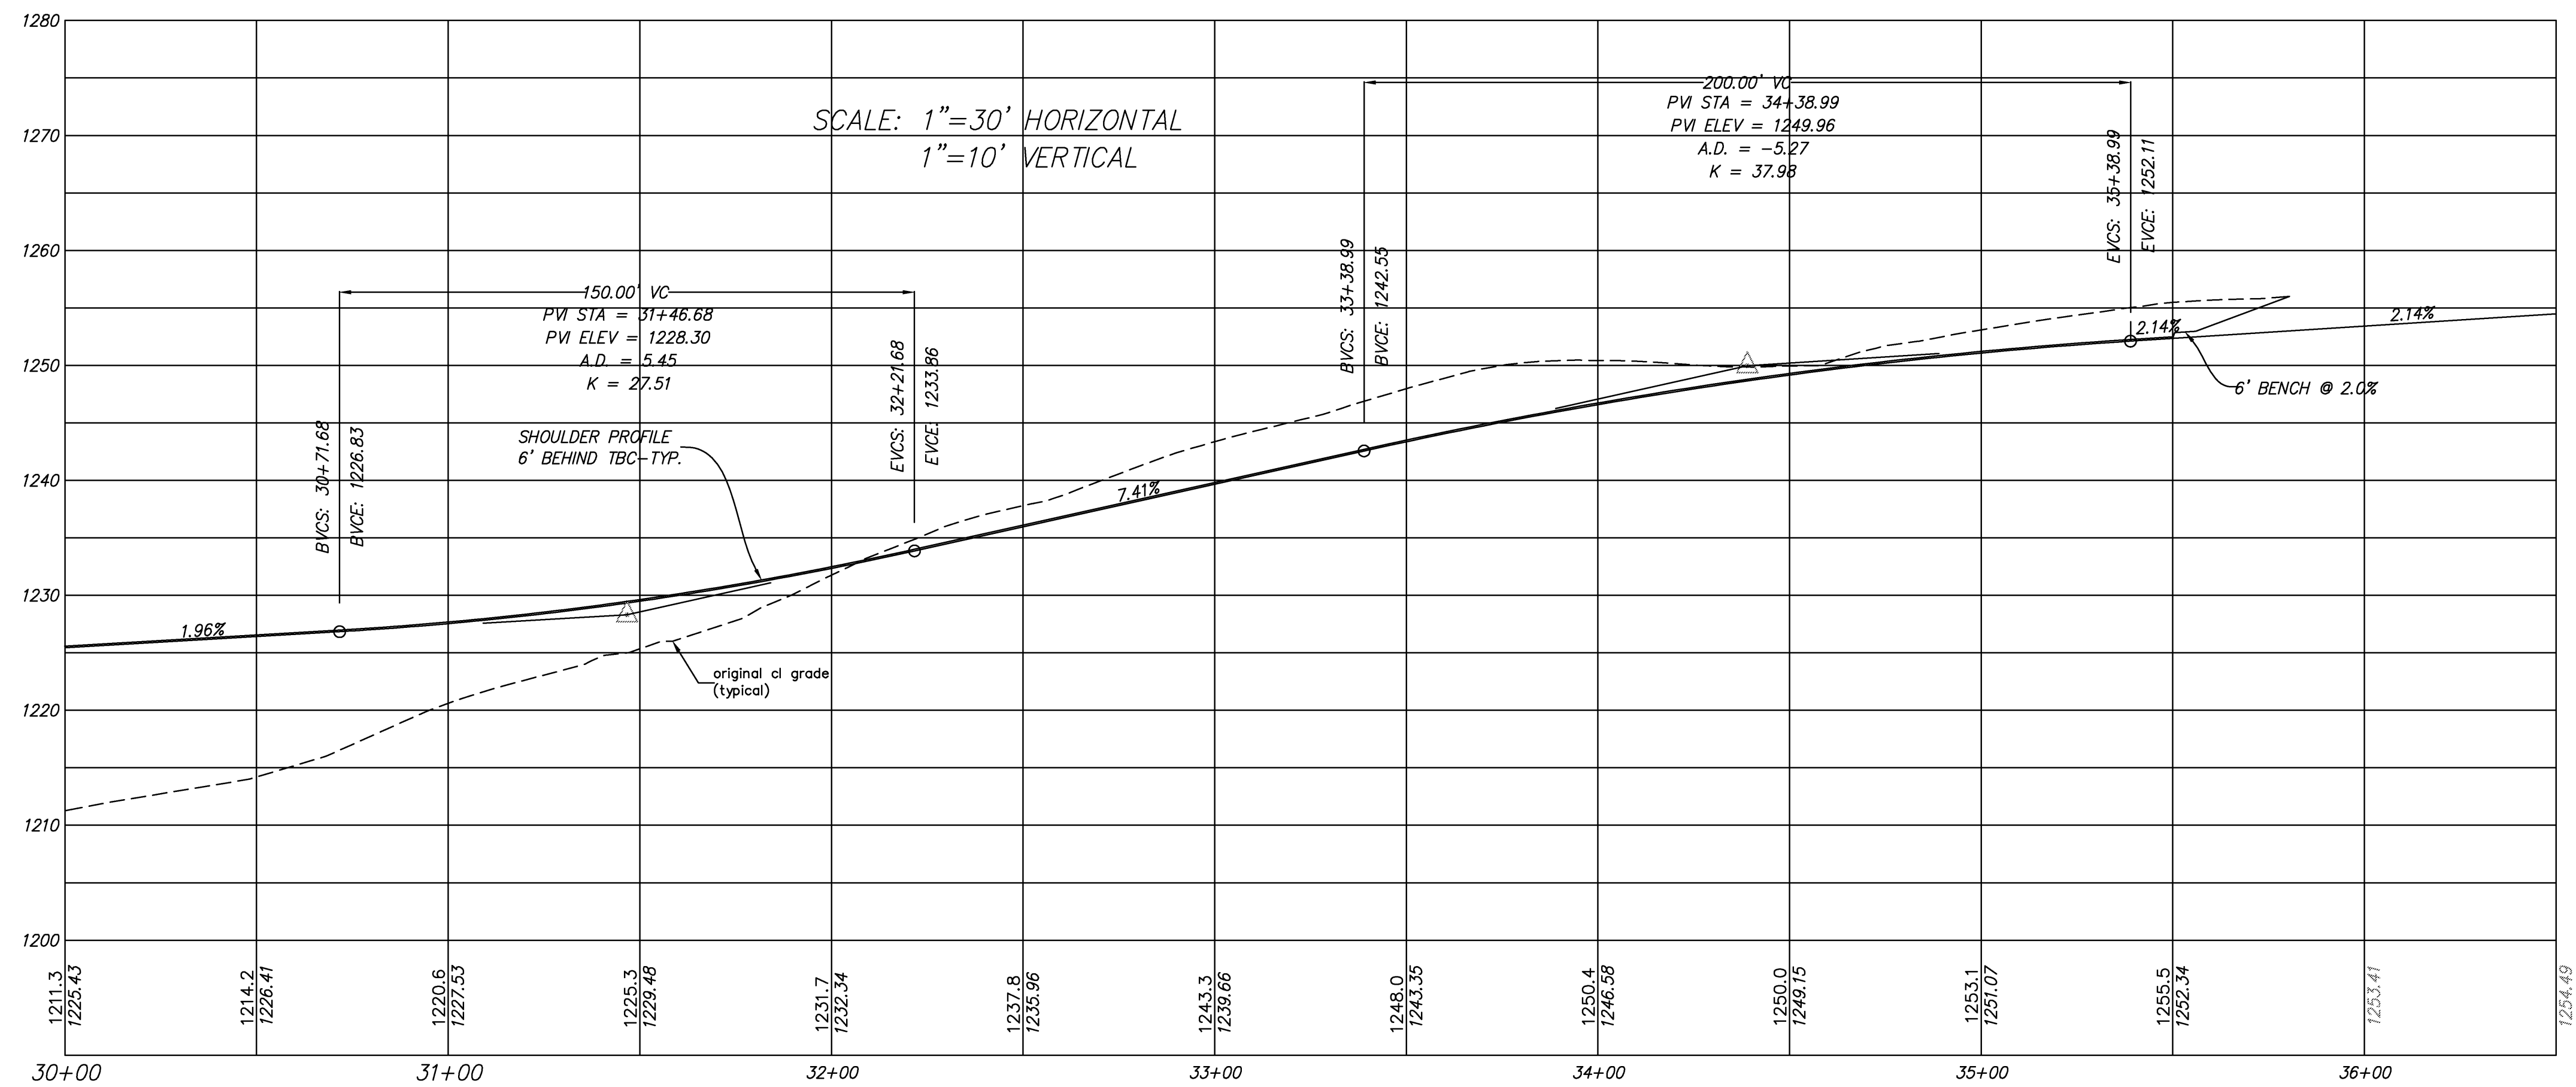


ROAD PROFILE STA. 30+00 TO 35+50

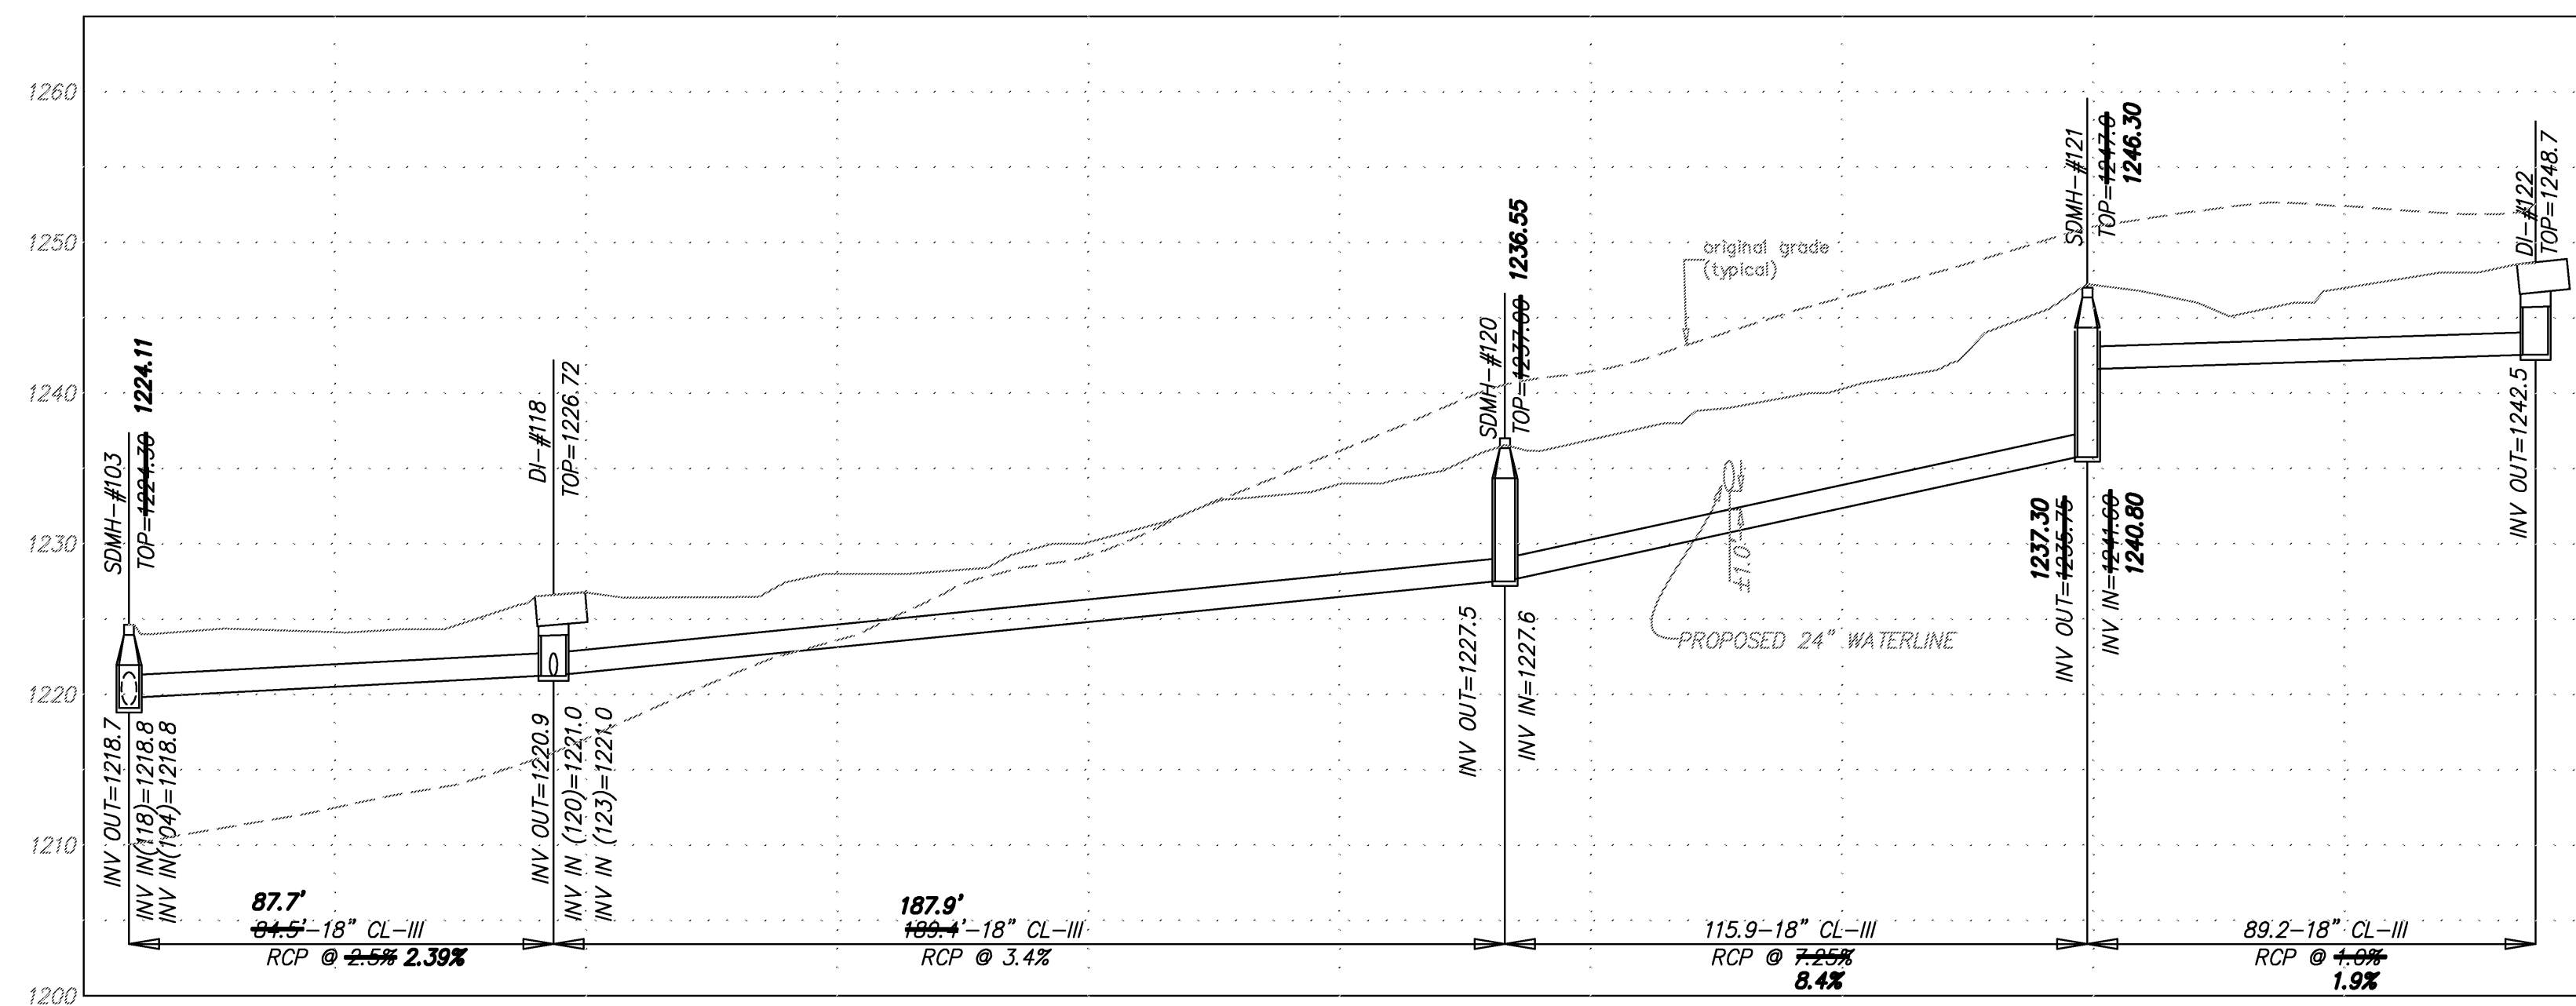

STORM DRAIN PROFILE STA. 30.00 TO 35+50

AS-BUILT PLANS BY CALDWELL WHITE
ASSOCIATES DATED JUNE 11, 2008

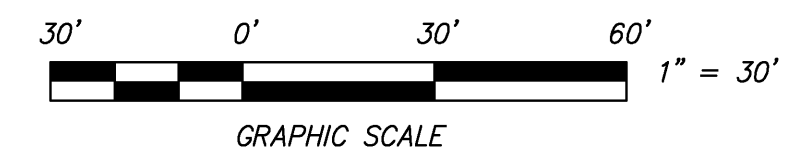

ROAD & STORM DRAIN PROFILE
STA. 30+00 TO 35+50
ROANOKE COUNTY CENTER FOR RESEARCH AND
TECHNOLOGY-GLENMARY DRIVE EXTENSION

Designed: JWK
Checked: FBC
Date: July 17, 2006
Rev: July 27, 2007
Scale: 1"=30'
Tax Parcel: 54.00-1
W.O. No.: 05-0012

CWA
CALDWELL WHITE ASSOCIATES
ENGINEERS / SURVEYORS / PLANNERS
4208 MELROSE AVENUE, N.W.
P.O. BOX 6860
ROANOKE, VIRGINIA 24017
(540) 366-3400
FAX: (540) 366-8702