
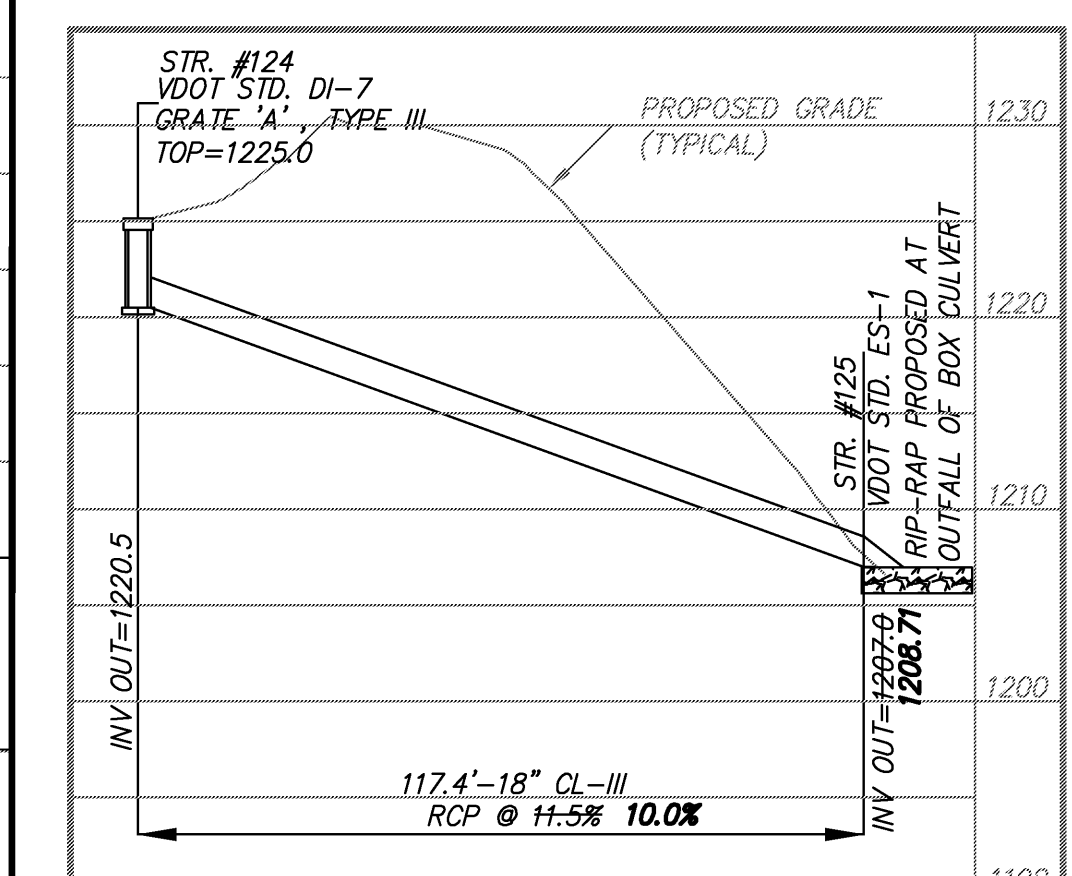
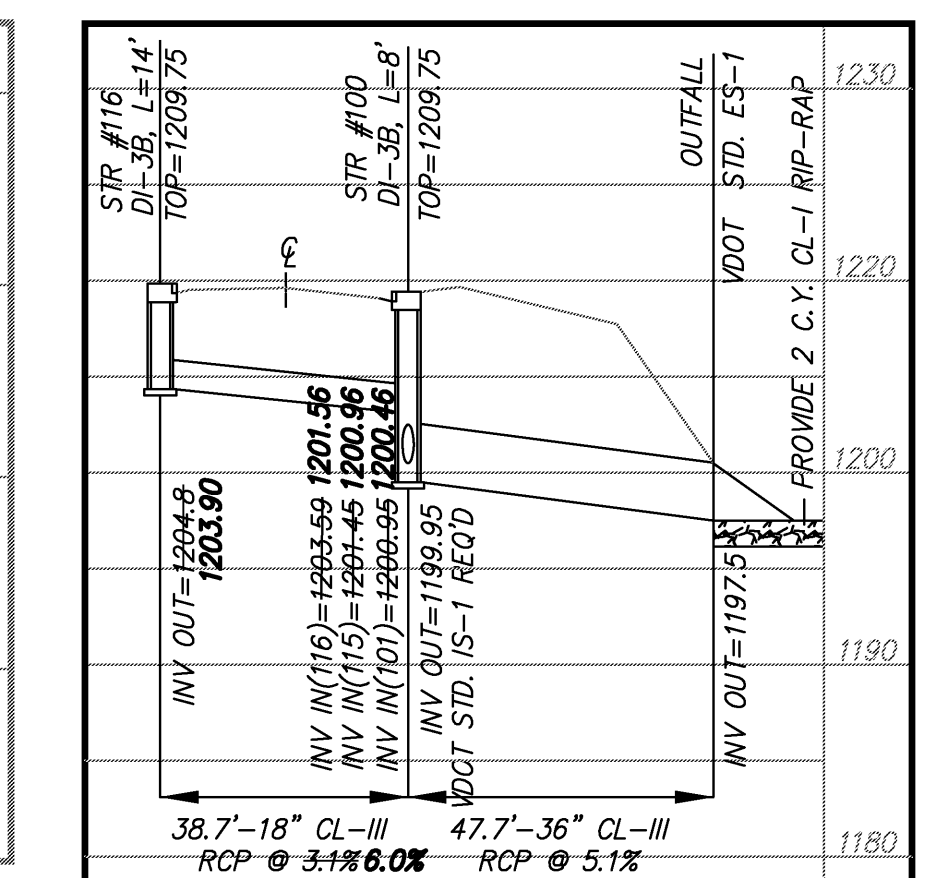
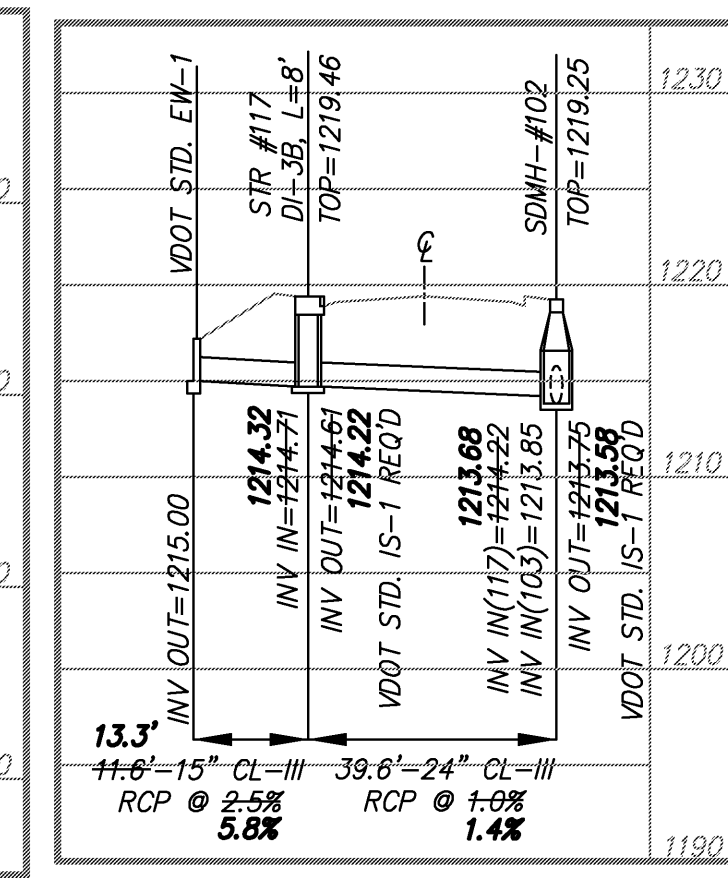
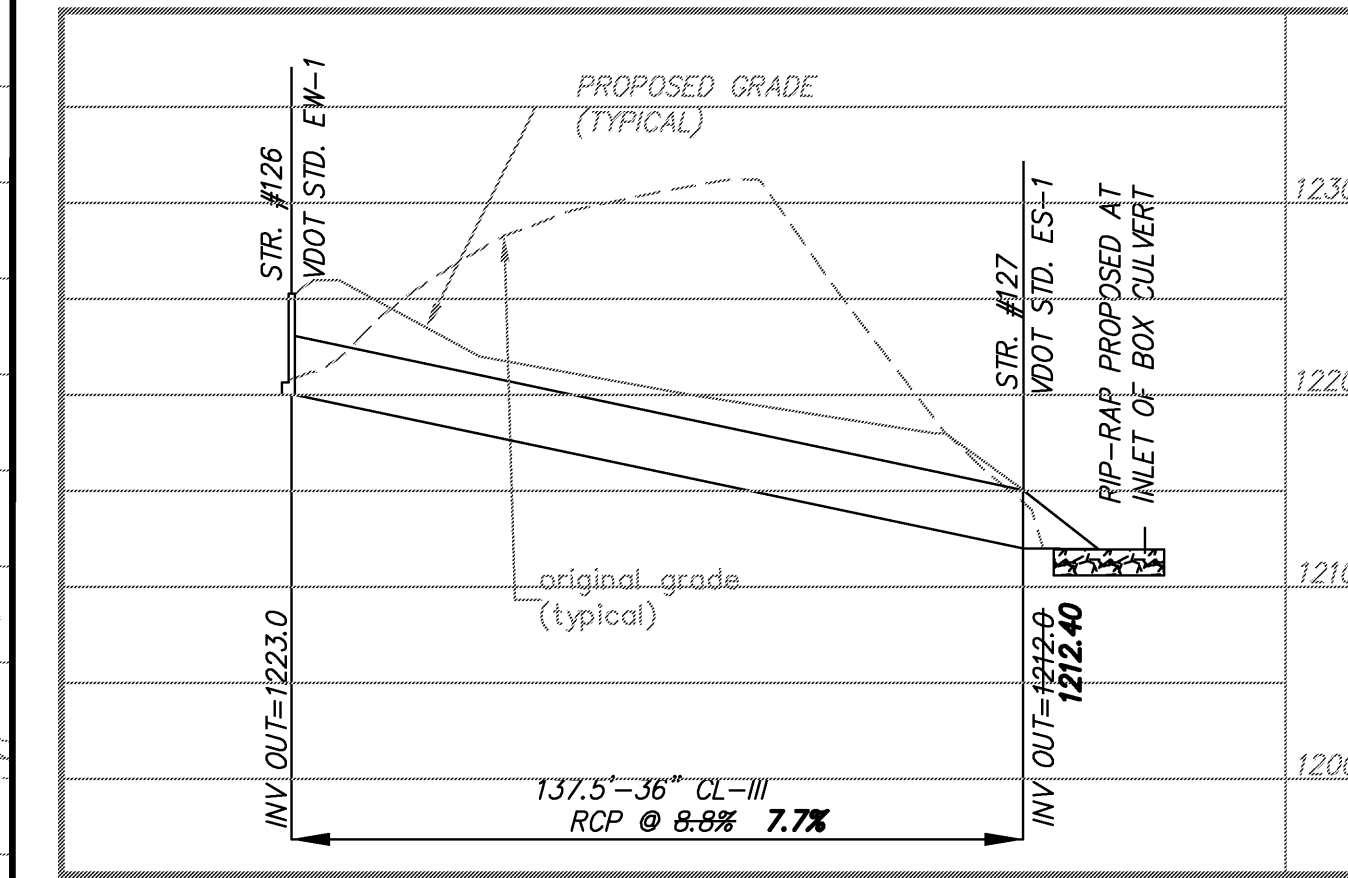
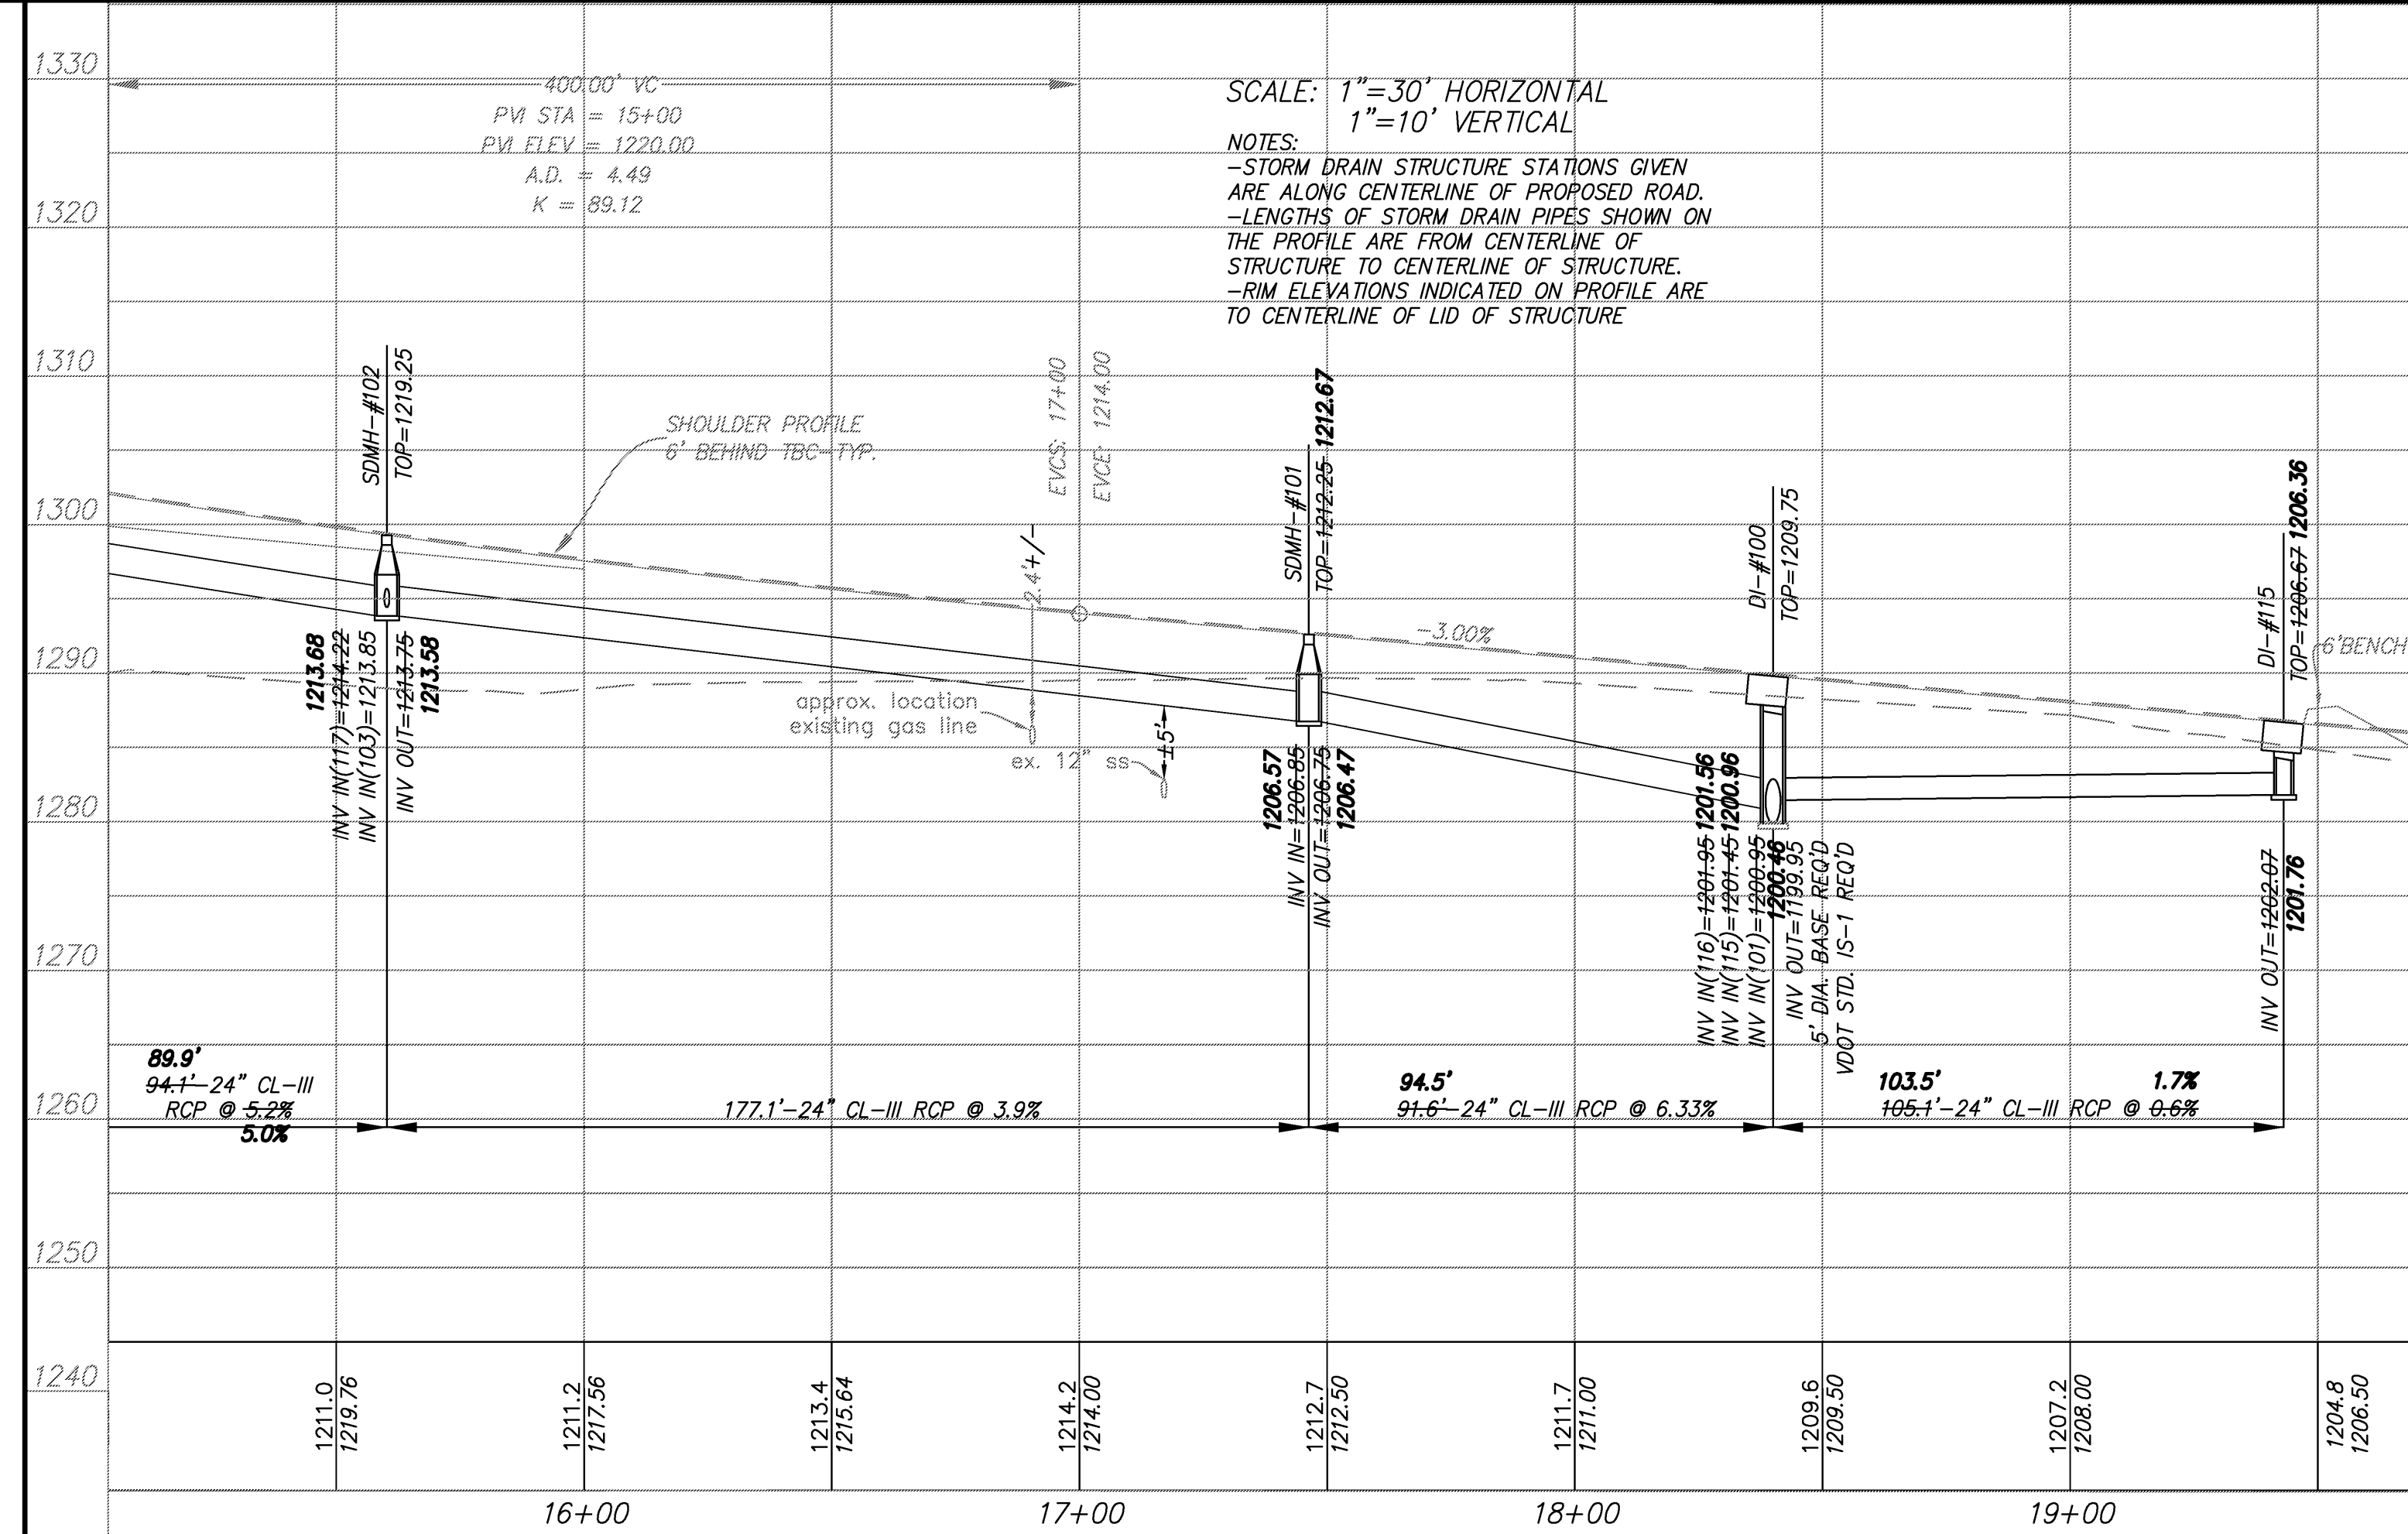
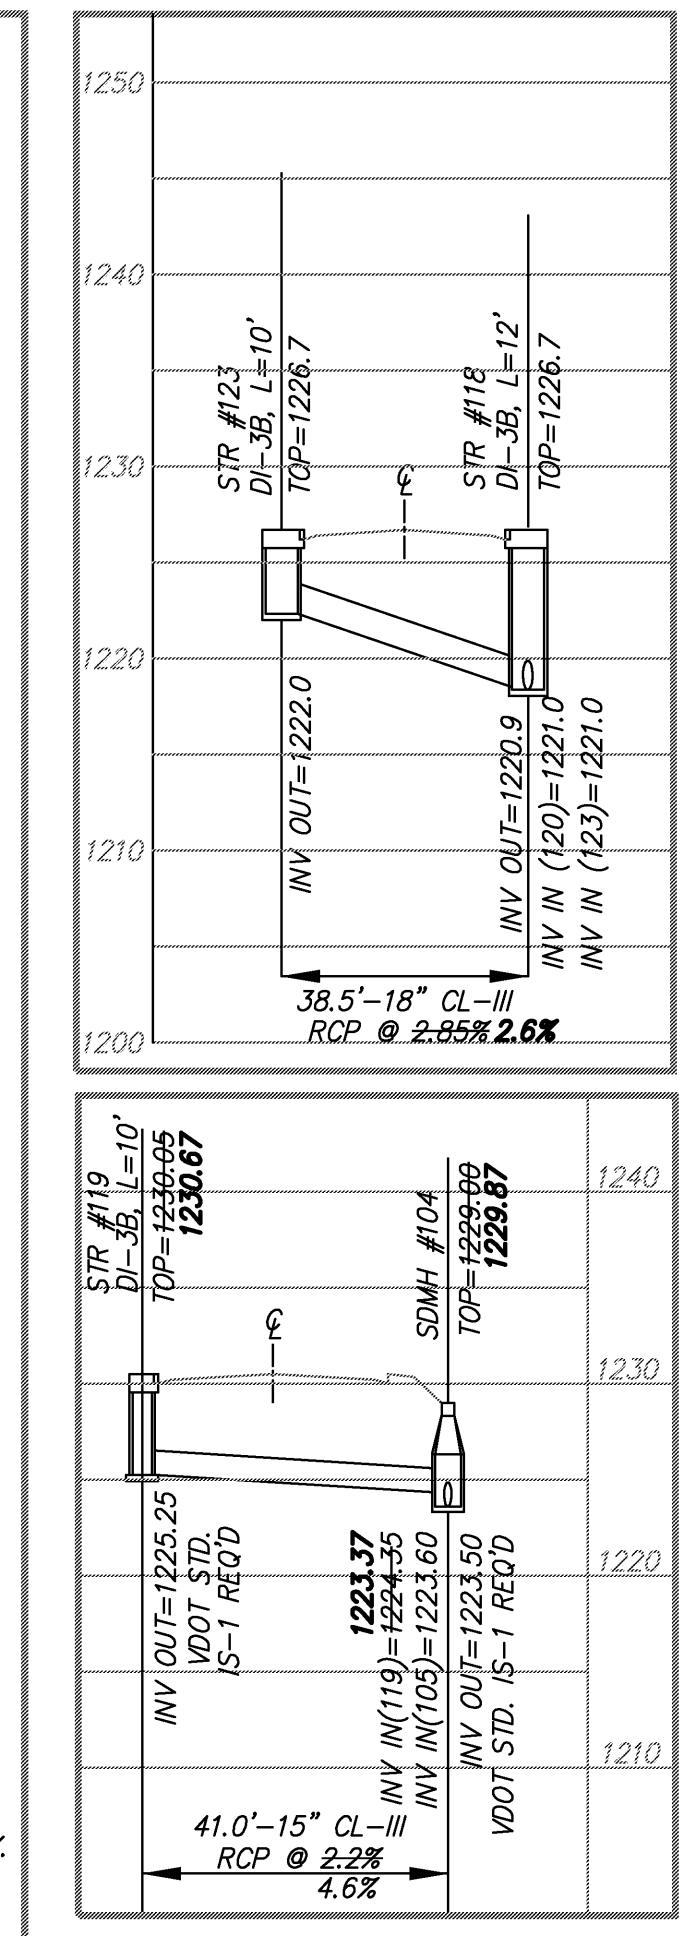
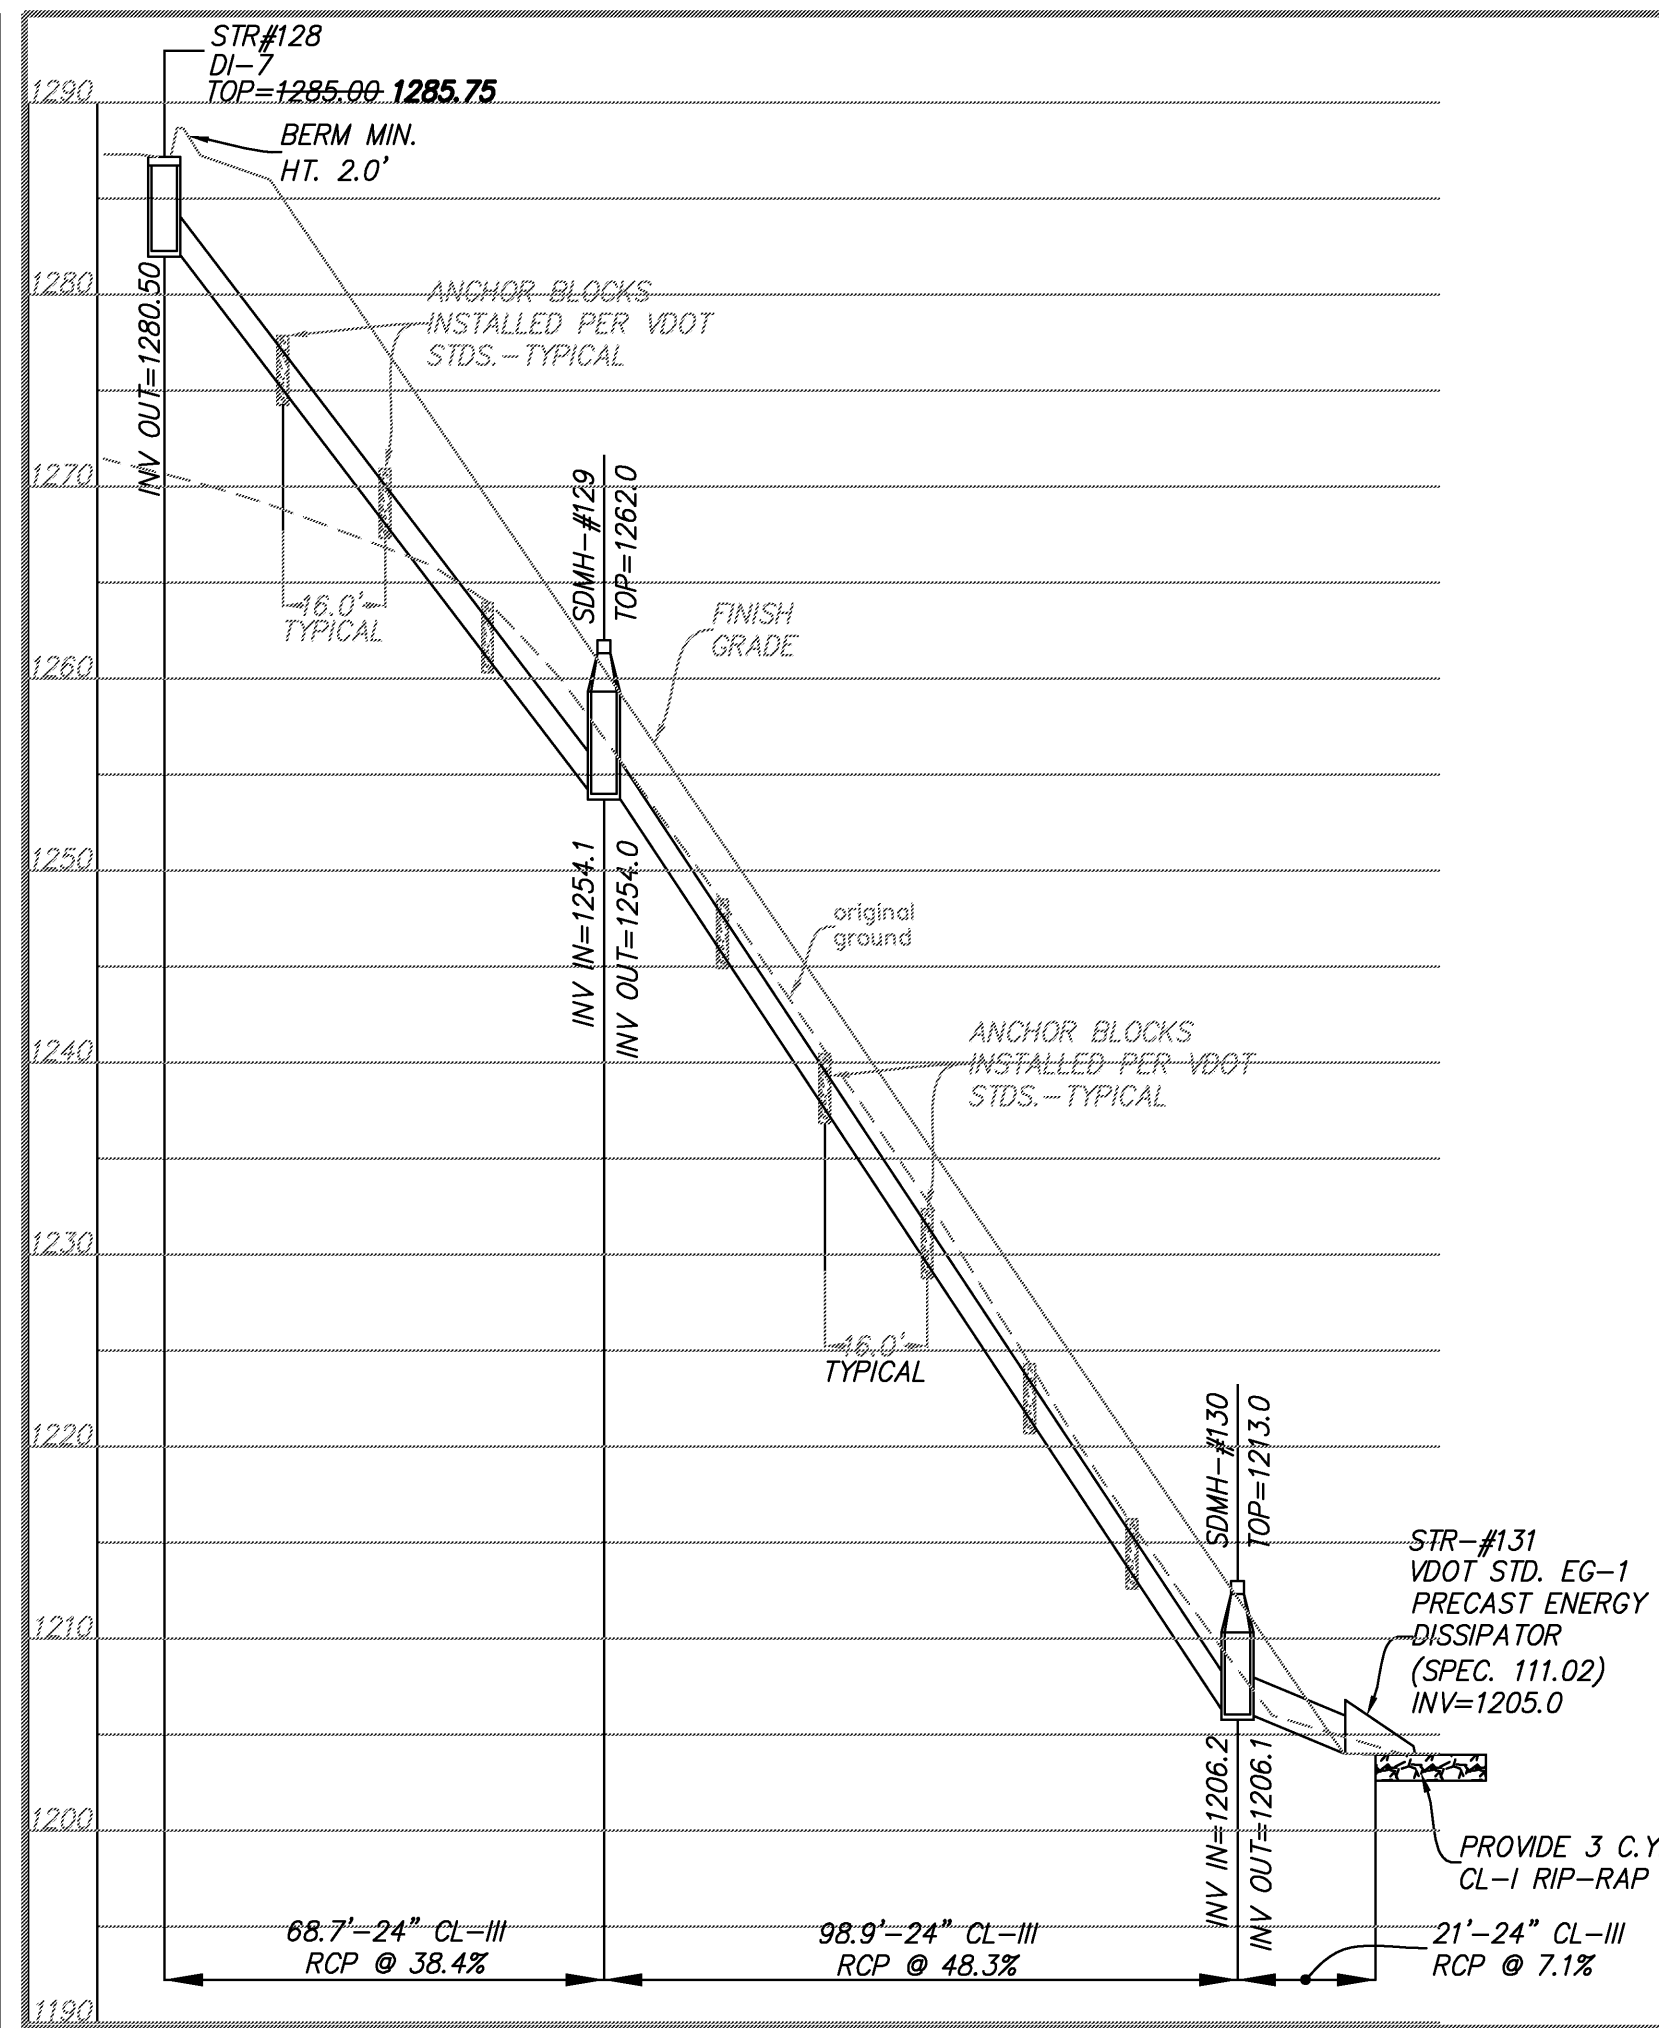


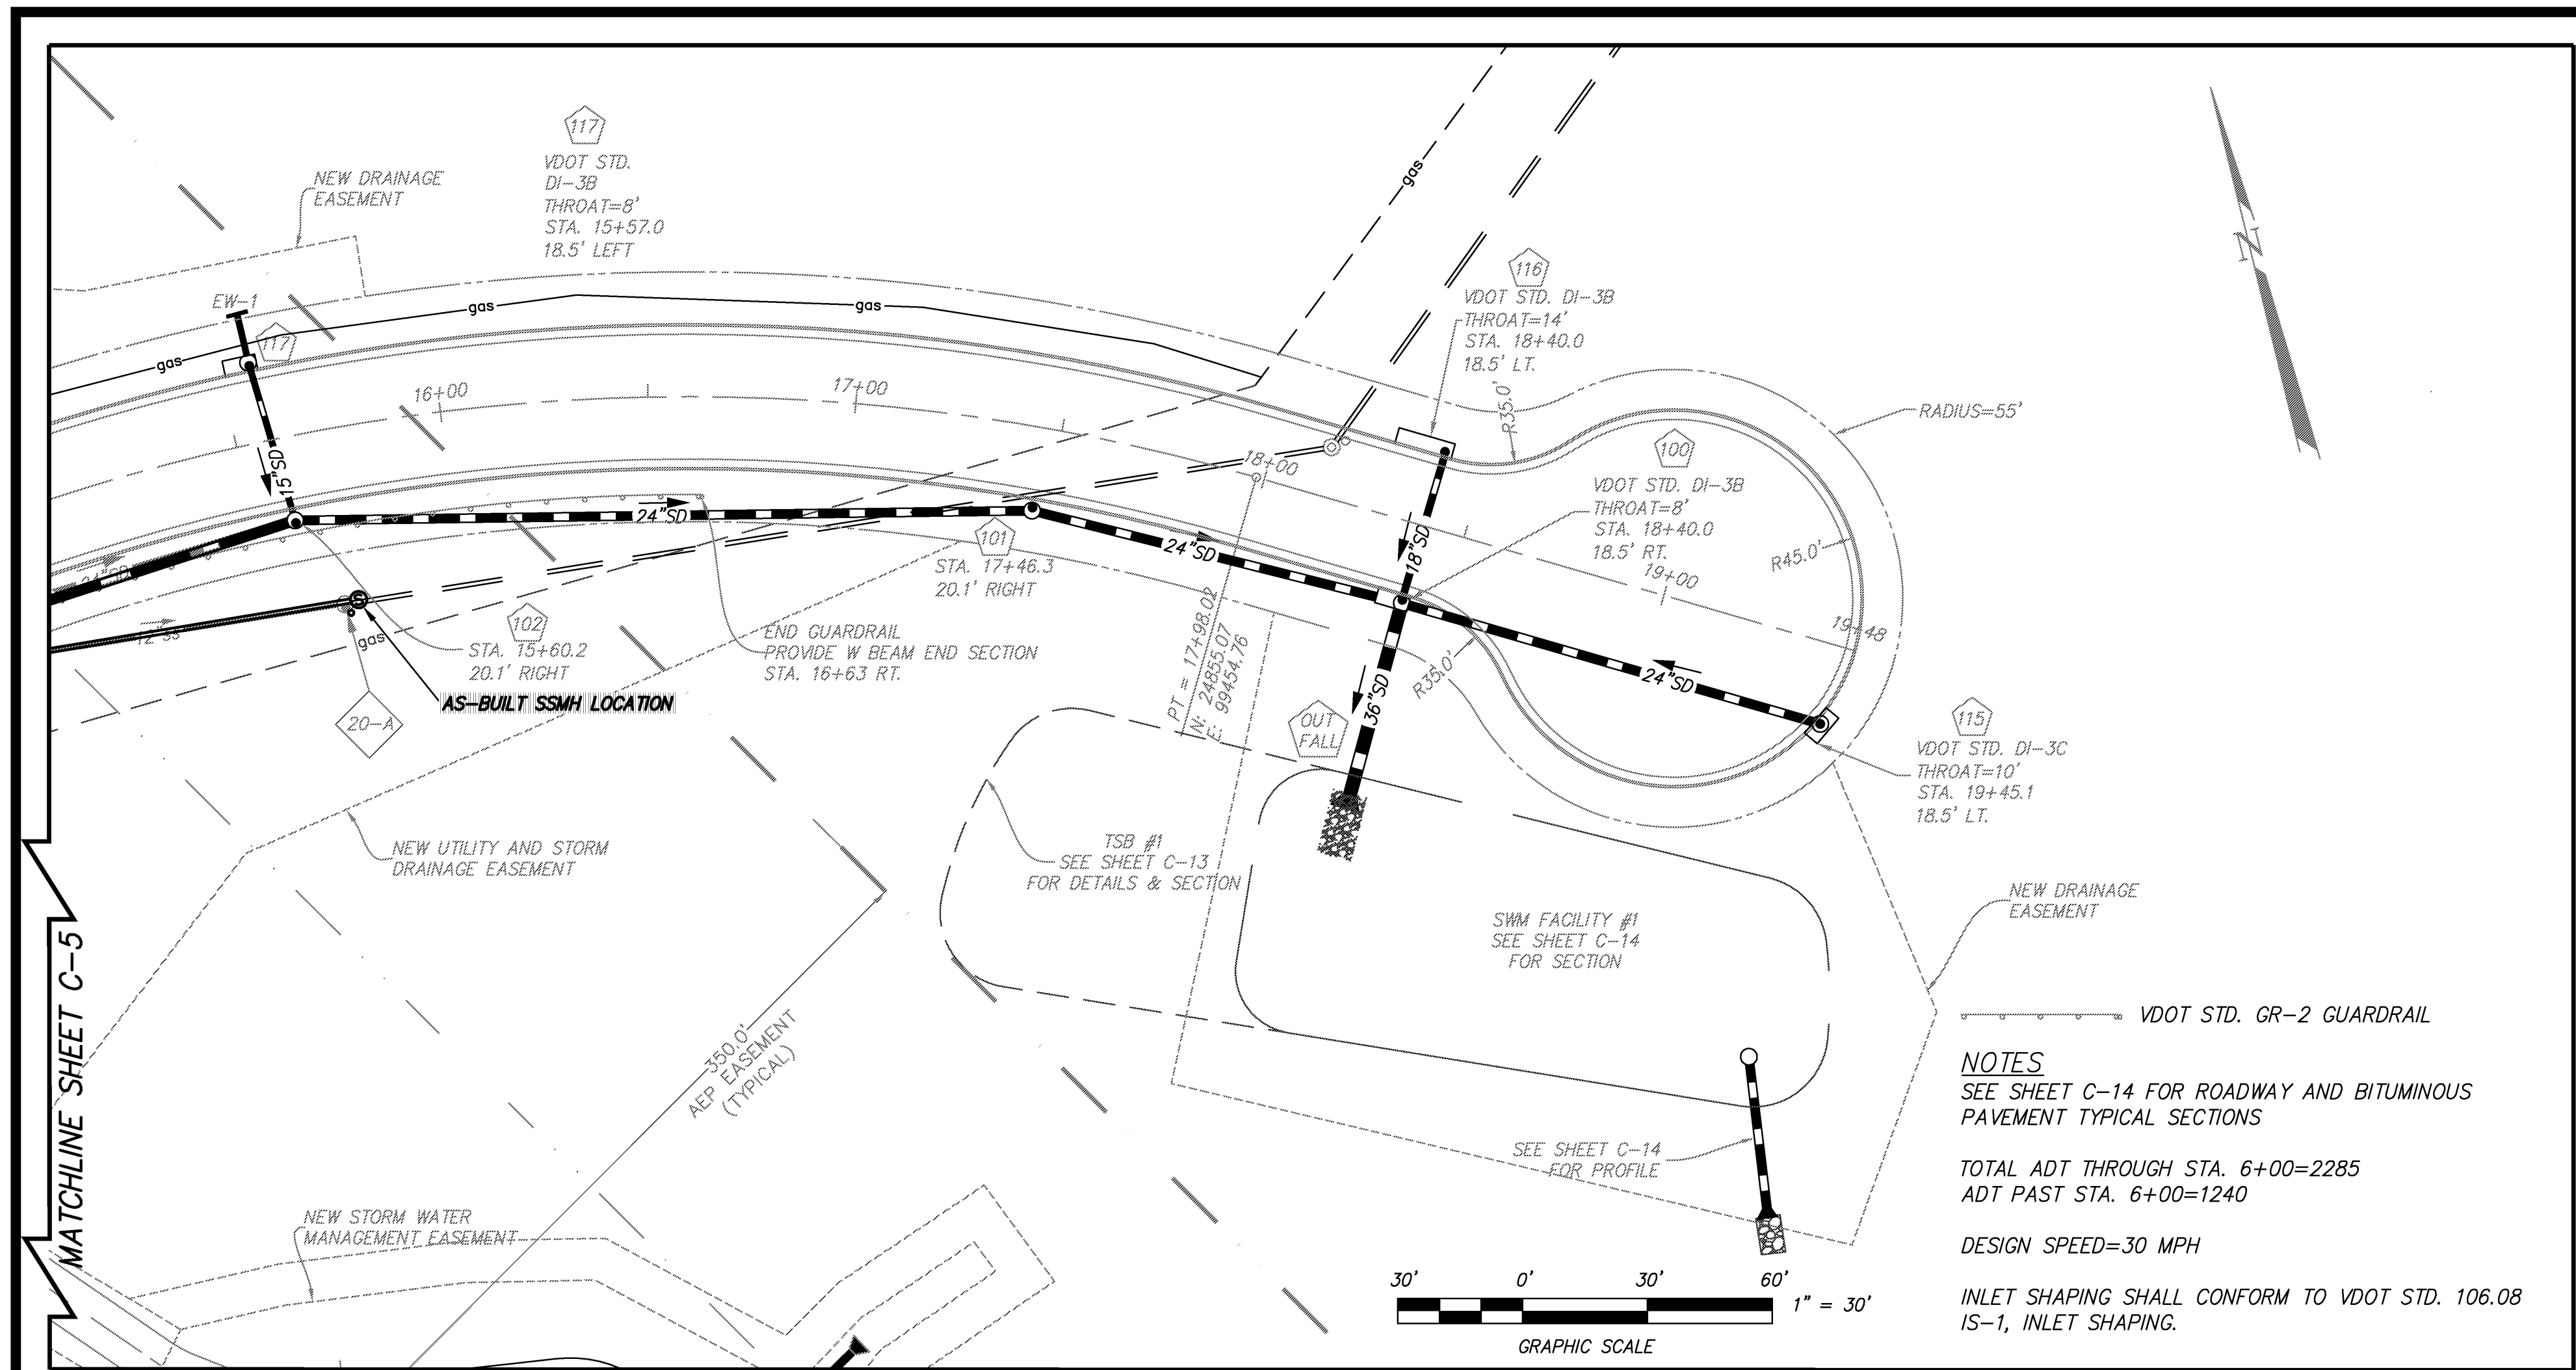

AS-BUILT PLANS BY CALDWELL WHITE ASSOCIATES DATED JUNE 11, 2008

COMMONWEALTH OF VIRGINIA
 JASON W. KNIGHT
 NO. 0402 033551
 PROFESSIONAL ENGINEER

UTILITY PLAN & ROAD PLAN AND PROFILE STA. 15+04 TO 19+48
ROANOKE COUNTY CENTER FOR RESEARCH AND TECHNOLOGY-GLENMARY DRIVE EXTENSION

Designed: JWK
 Checked: FBC
 Date: February 28, 2006
 Rev: Apr. 12, 2007
 Scale: 1"=30'
 Tax Parcel: 54.00-1
 W.O. No.: 05-0012

CWA
CALDWELL WHITE ASSOCIATES
 ENGINEERS / SURVEYORS / PLANNERS
 4203 MELROSE AVENUE, N.W.
 P.O. BOX 6860
 ROANOKE, VIRGINIA 24017
 (540) 366-3400
 FAX: (540) 366-8702