




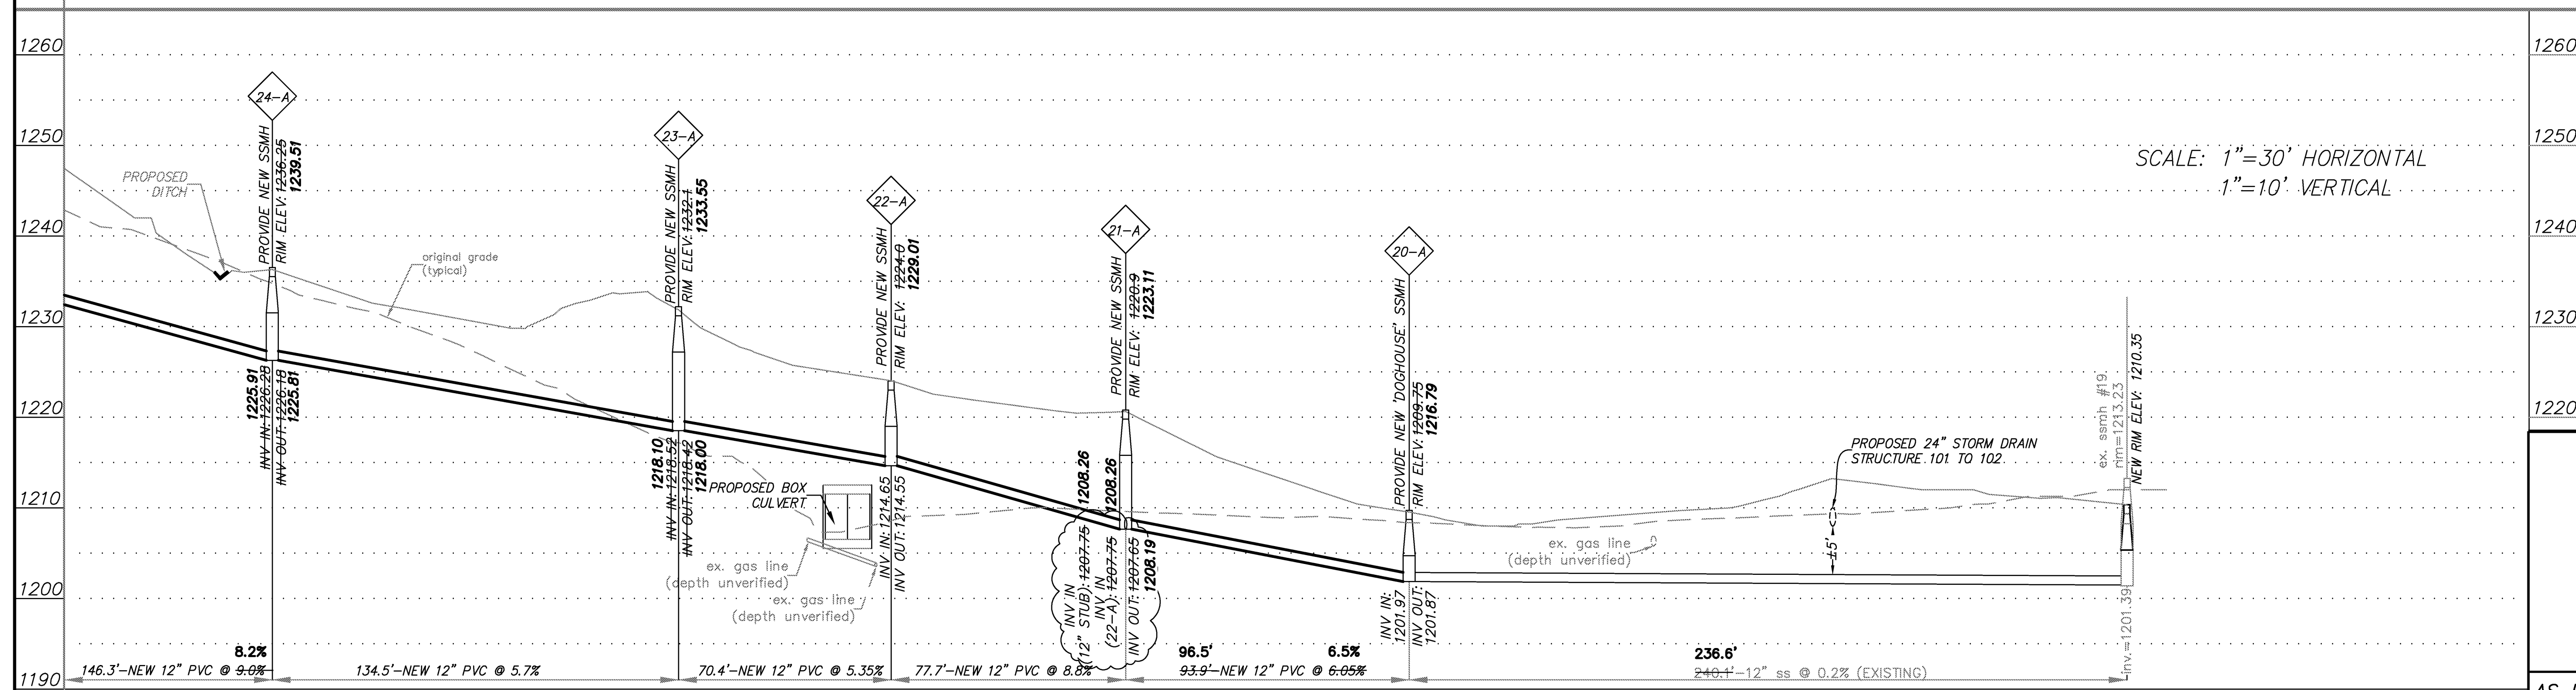

AS-BUILT PLANS BY CALDWELL WHITE ASSOCIATES DATED JUNE 11, 2008

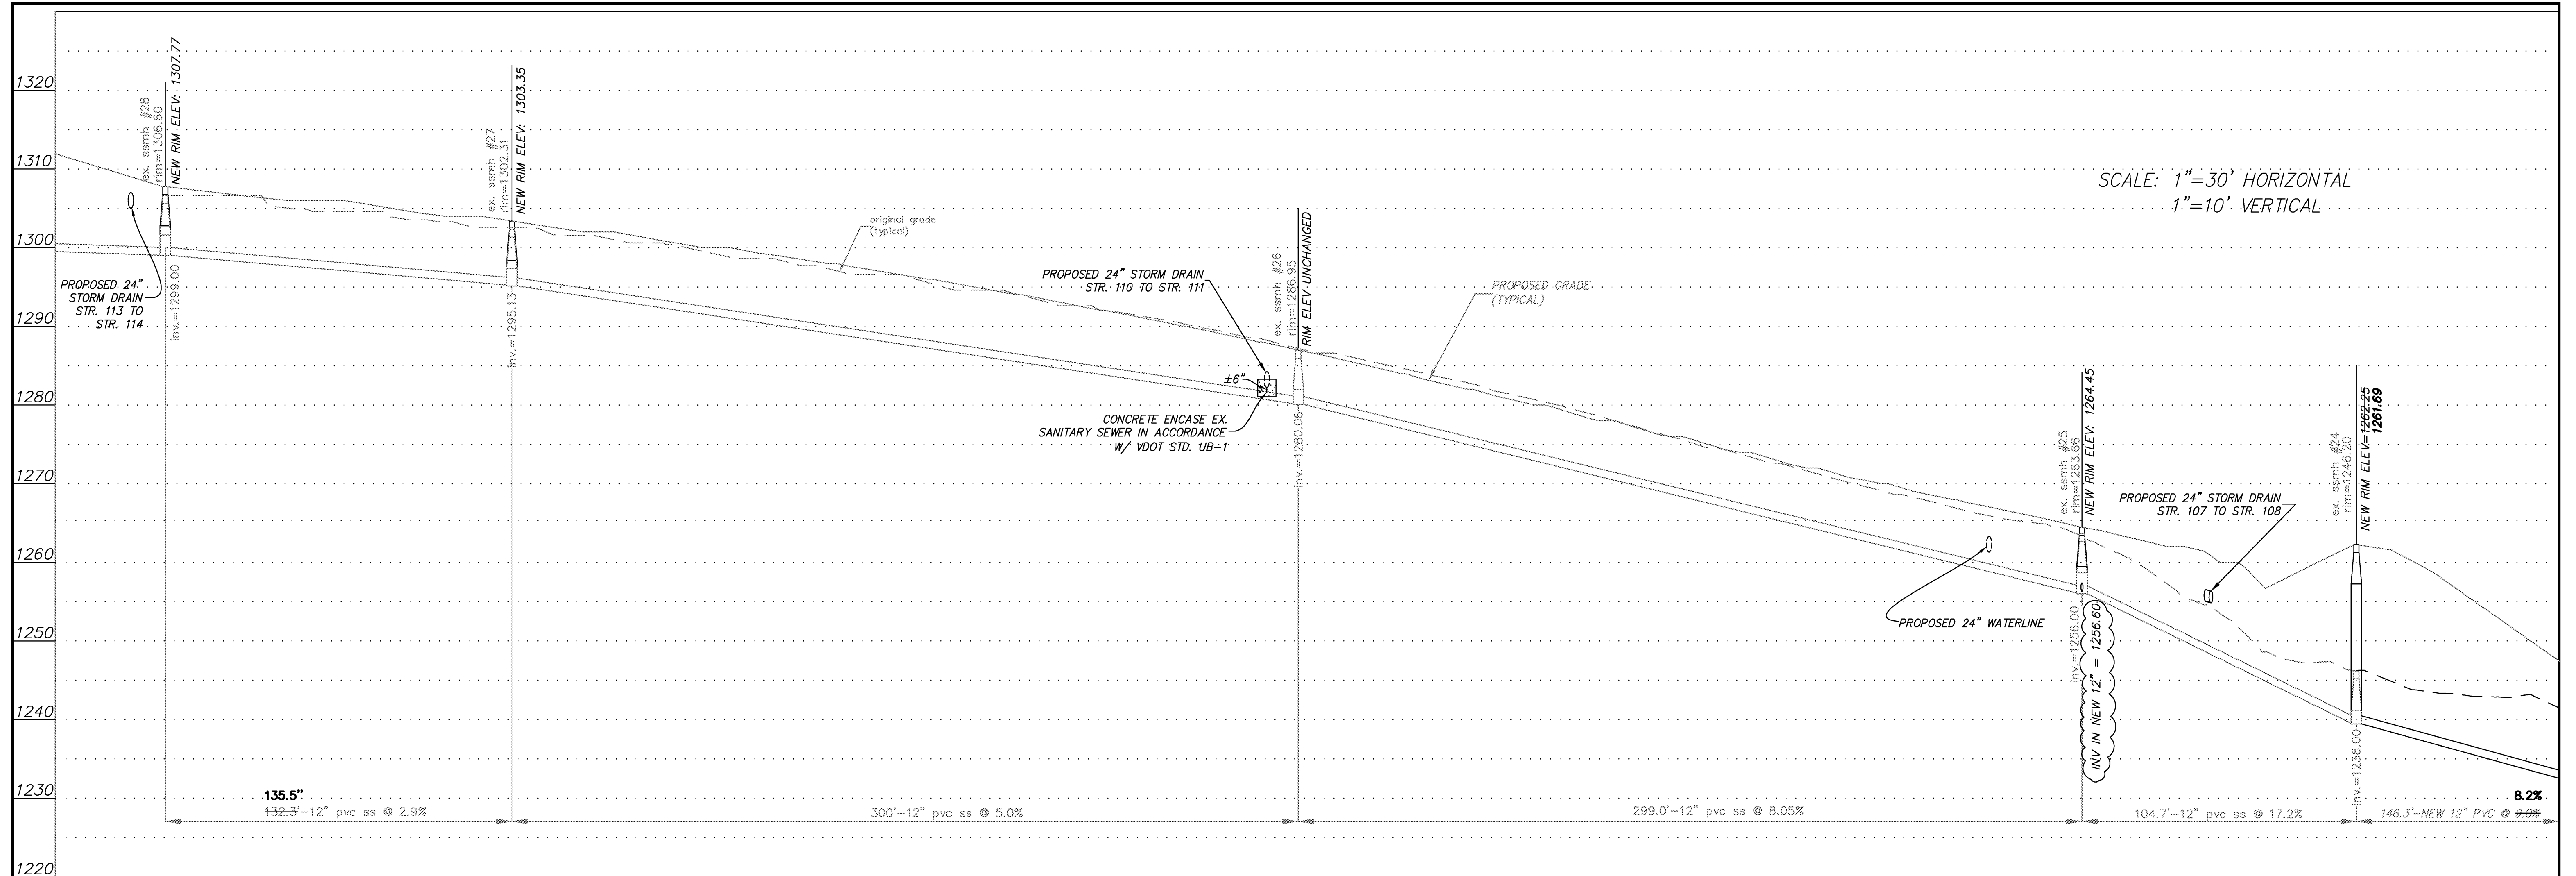

Designed: JWK
Checked: FBC
Date: March 8, 2006
Rev: Aug. 8, 2007
Scale: 1"=30'
Tax Parcel: 54.00-1
W.O. No.: 05-0012

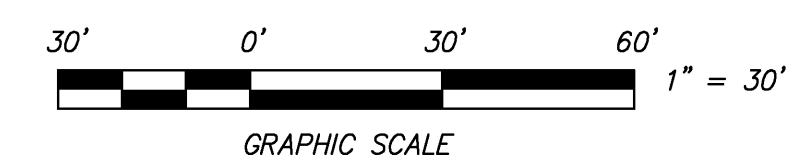

AS-BUILT SANITARY SEWER PROFILES
GLENMARY DRIVE EXTENSION
ROANOKE COUNTY CENTER FOR RESEARCH AND TECHNOLOGY
CATAWBA MAGISTERIAL DISTRICT
COUNTY OF ROANOKE, VA.

CWA
CALDWELL WHITE ASSOCIATES
ENGINEERS / SURVEYORS / PLANNERS
4203 MELROSE AVENUE, N.W.
P.O. BOX 6260
ROANOKE, VIRGINIA 24017
(540) 568-3400
FAX: (540) 568-8702