

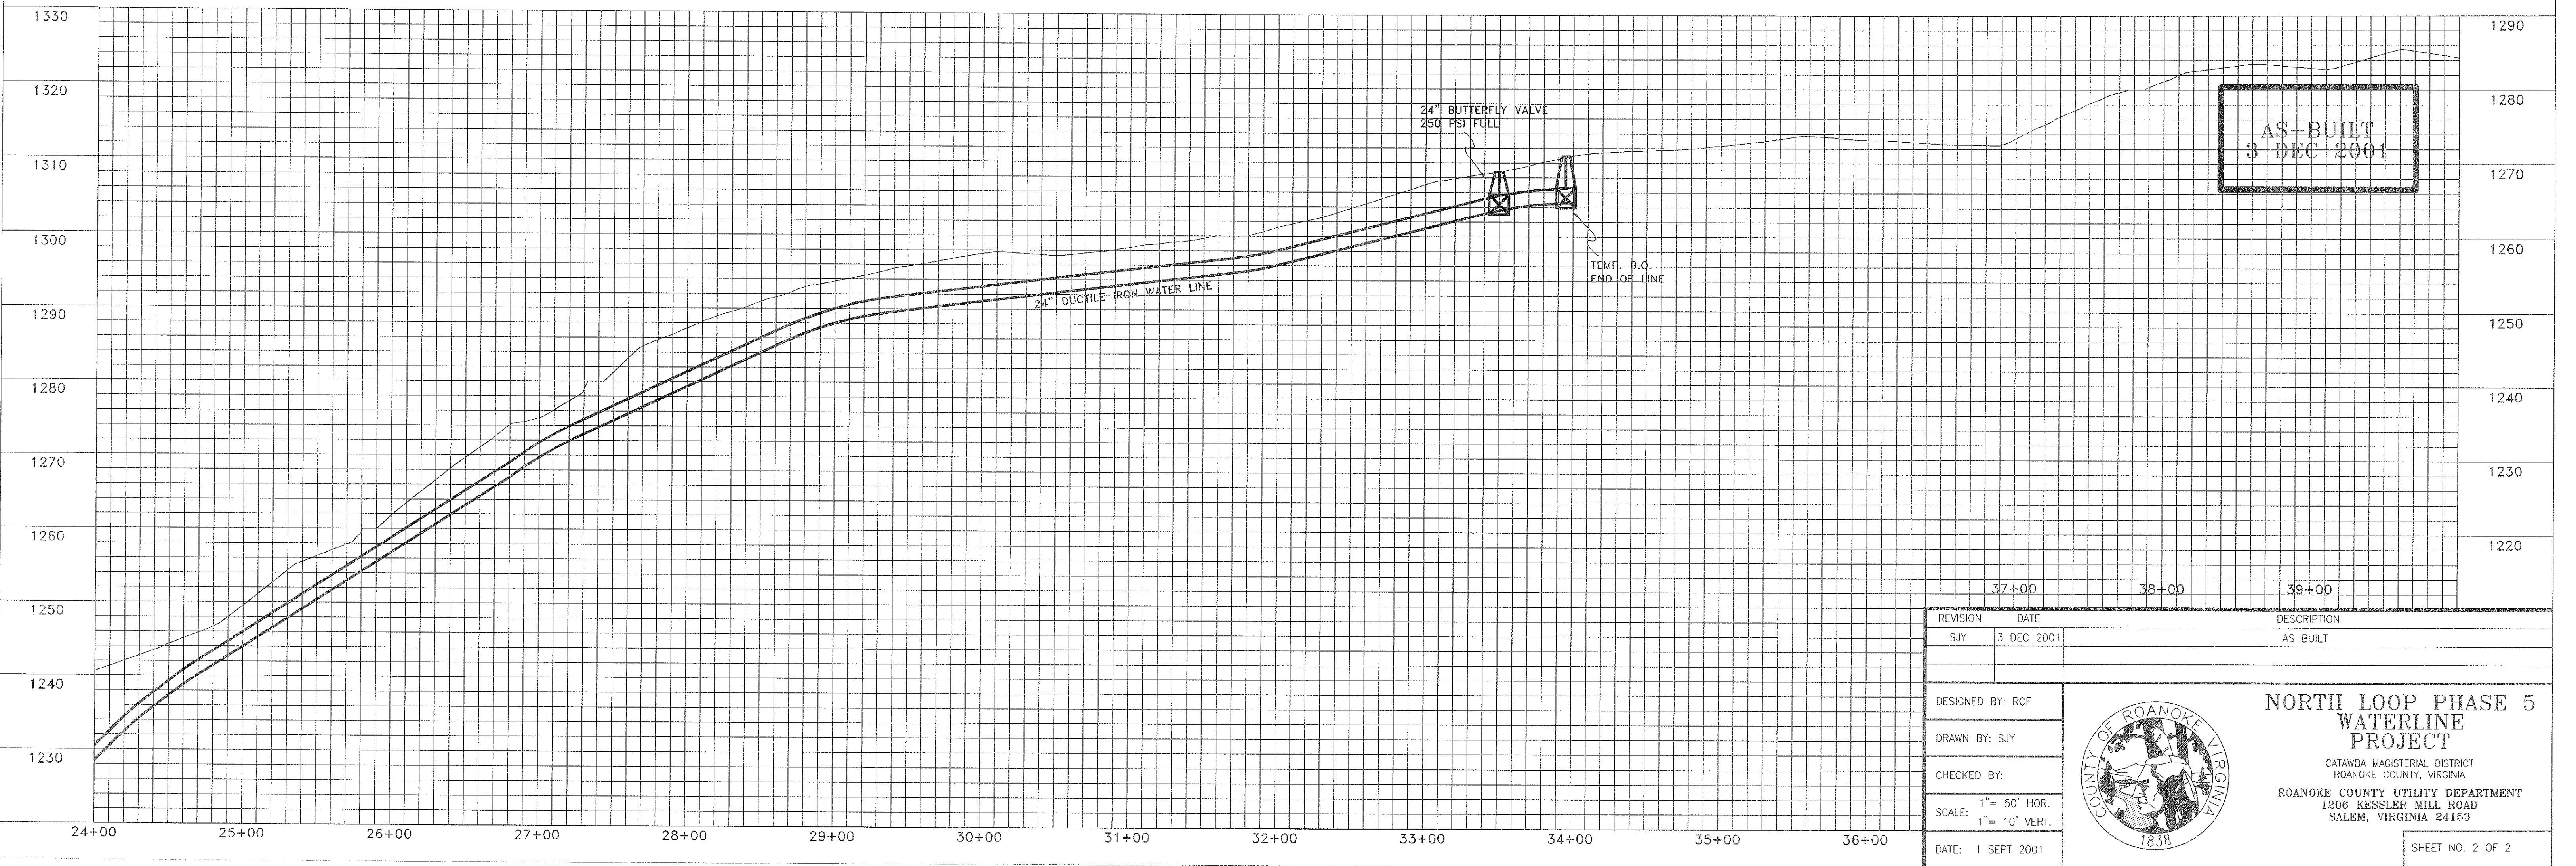


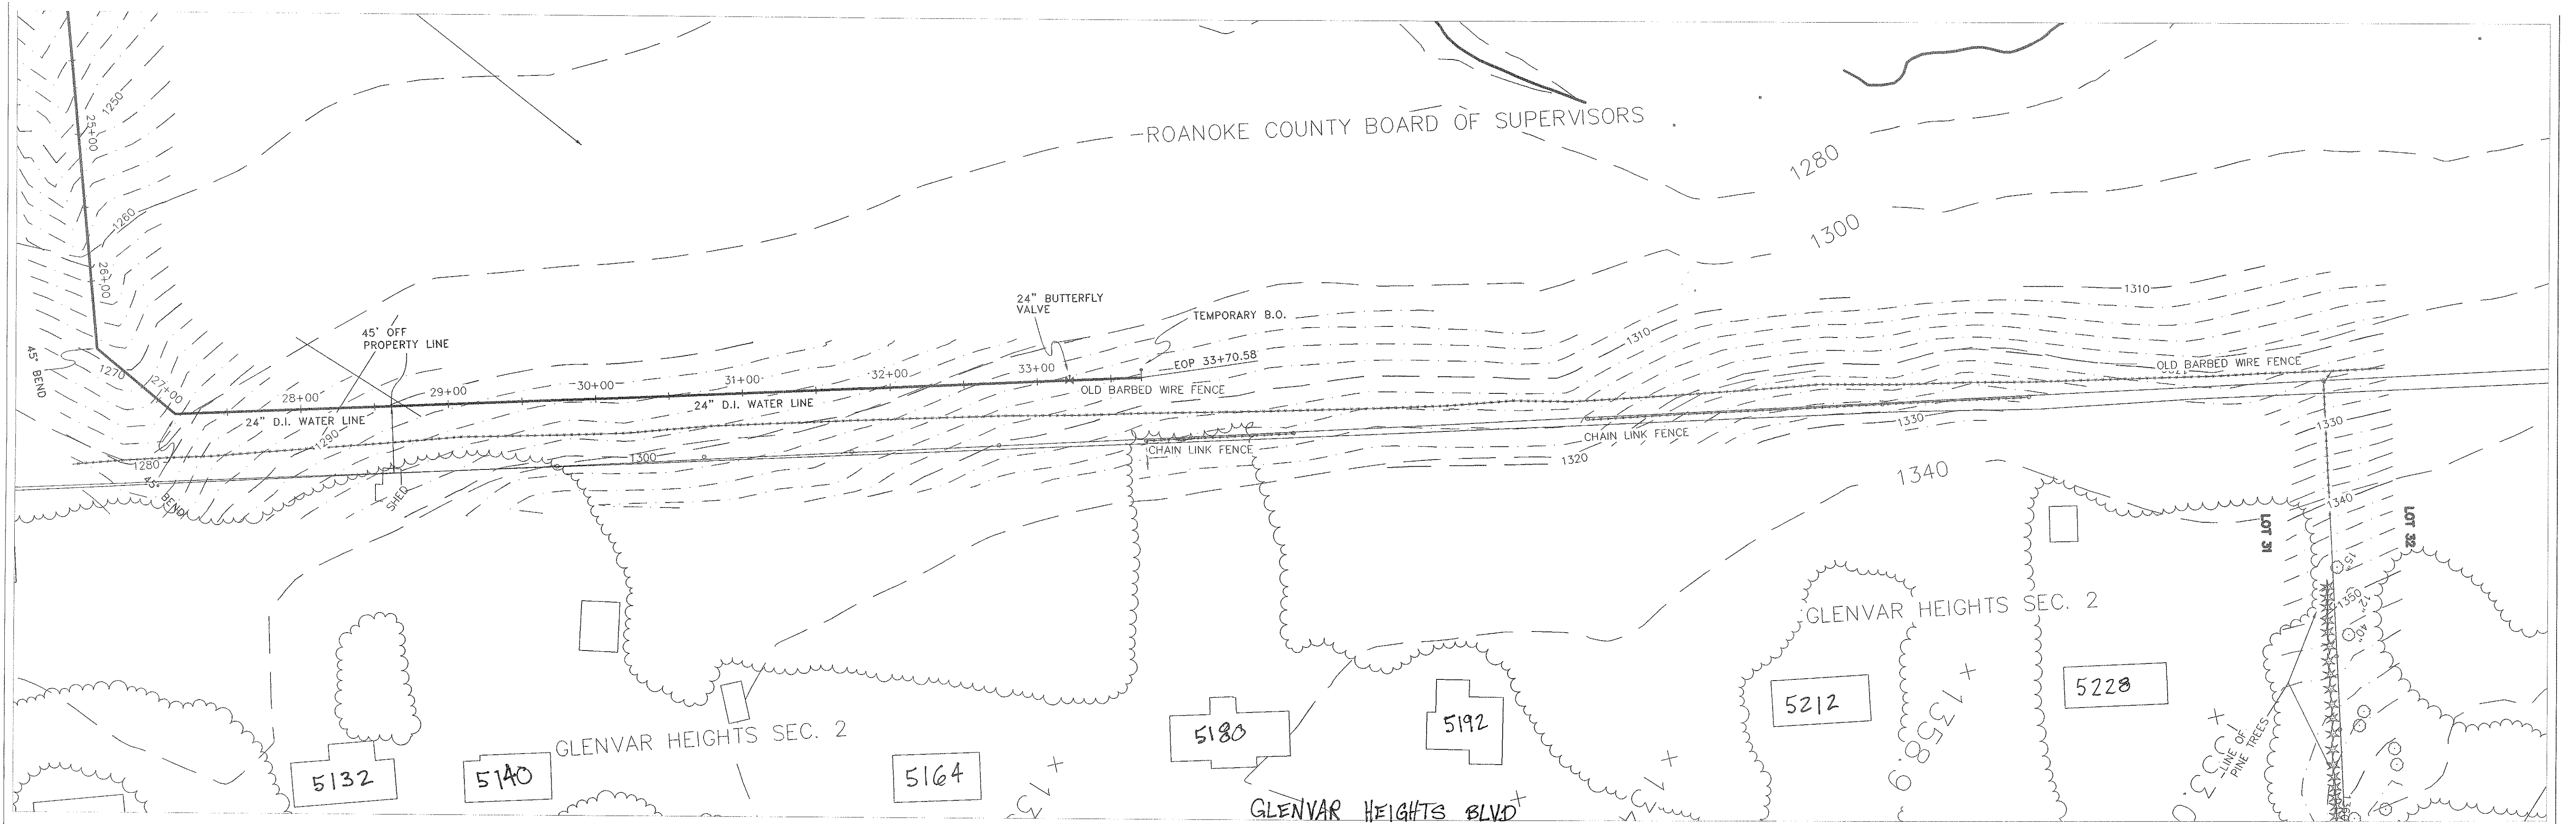

REVISION	DATE	DESCRIPTION
SJY	3 DEC 2001	AS BUILT
DESIGNED BY: RCF		
DRAWN BY: SJY		
CHECKED BY:		
SCALE: 1"= 50' HOR. 1"= 10' VERT.		
DATE: 1 SEPT 2001		

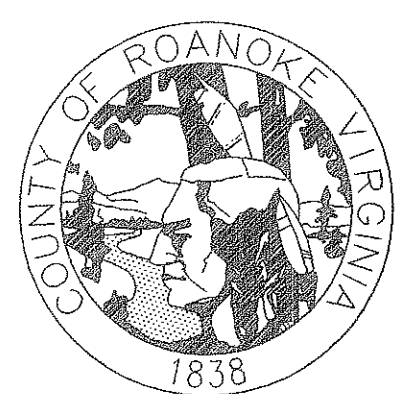

**NORTH LOOP PHASE 5
WATERLINE
PROJECT**
 CATANBA MACISTERIAL DISTRICT
 ROANOKE COUNTY, VIRGINIA
 ROANOKE COUNTY UTILITY DEPARTMENT
 1200 KESSLER MILL ROAD
 SALEM, VIRGINIA 24153