



WATERLINE & FORCE MAIN EXTENSION
AS-BUILT
FOR
ROANOKE COUNTY UTILITY DEPARTMENT

*SITUATE FROM NEW COUNTY OF ROANOKE WATER TREATMENT PLANT NORTHEASTERLY
TO THE INTERSECTION OF U.S. ROUTE 460 AND DOW HOLLOW ROAD (RTE. 647)*

*CATAWBA MAGISTERIAL DISTRICT
COUNTY OF ROANOKE, VIRGINIA*

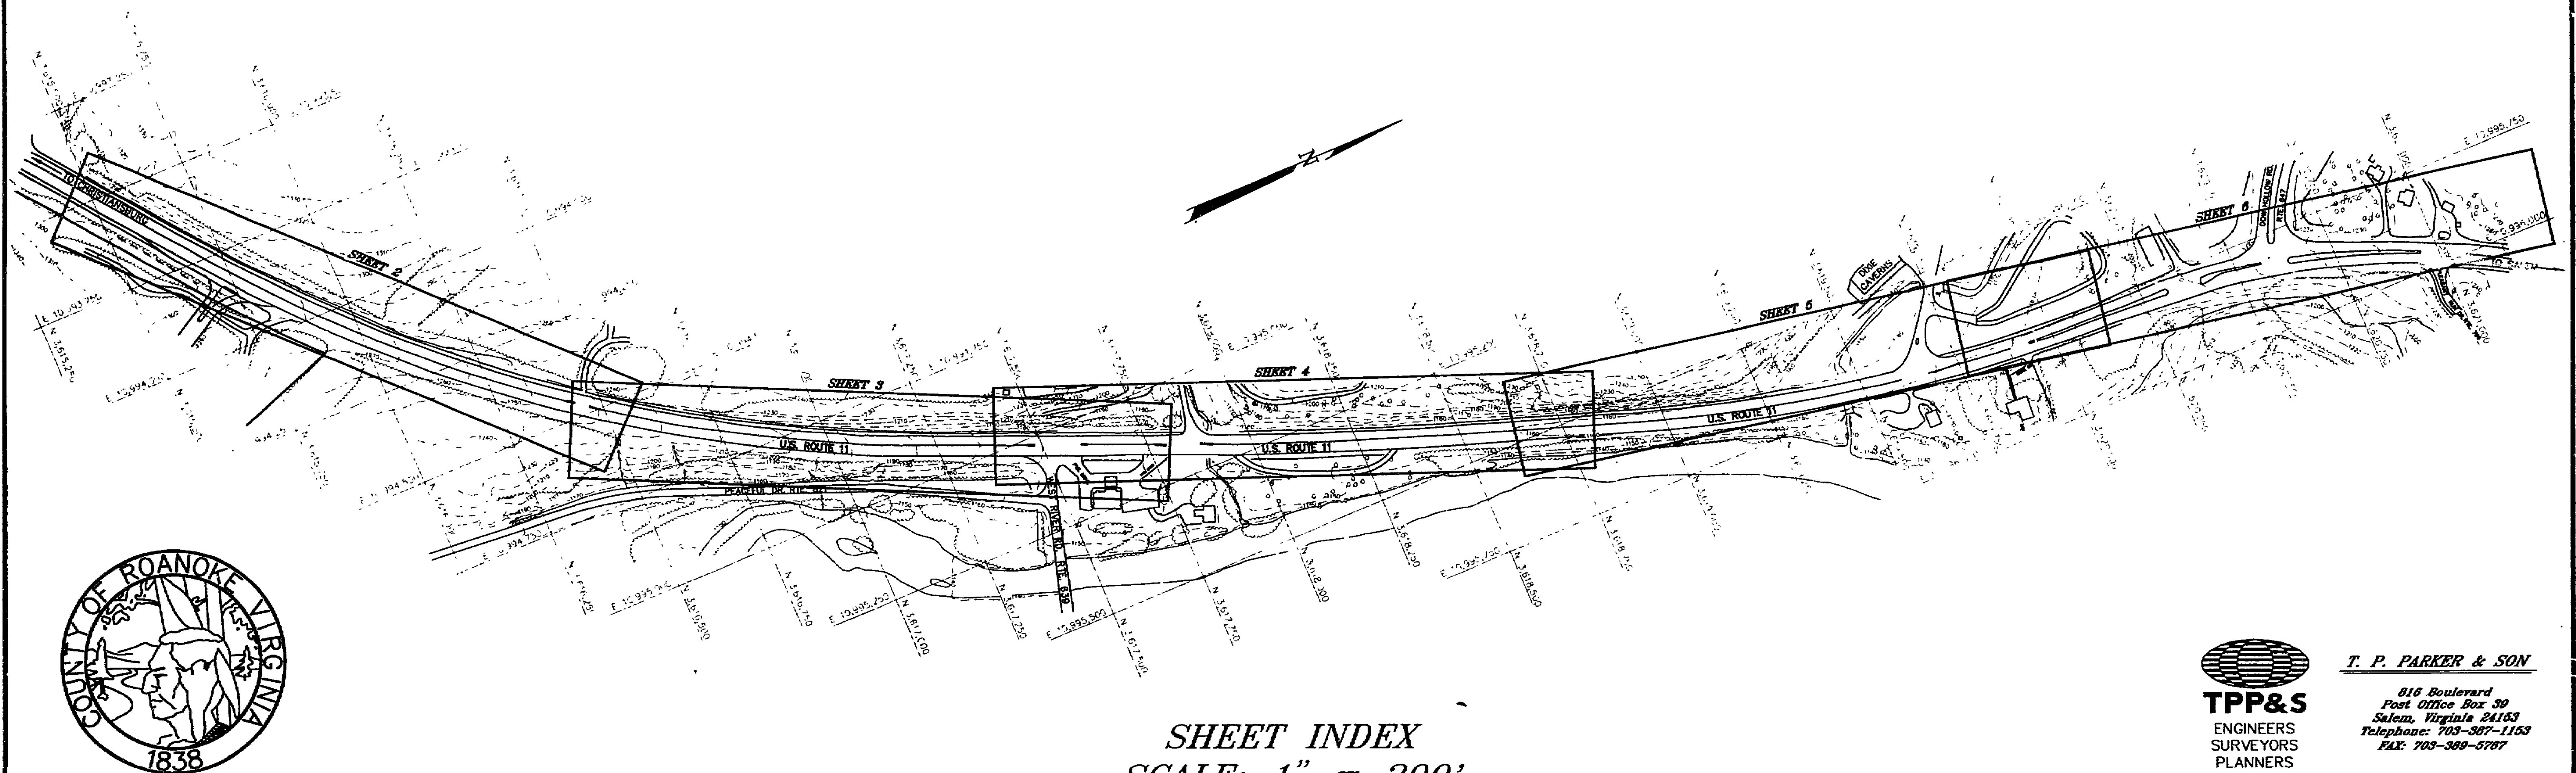

SHEET INDEX
SCALE: 1" = 200'

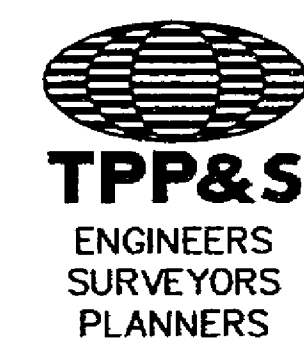

T. P. PARKER & SON
816 Boulevard
Post Office Box 39
Salem, Virginia 24153
Telephone: 703-387-1153
FAX: 703-389-5787

SHEET 1 OF 6

WT- 0424