



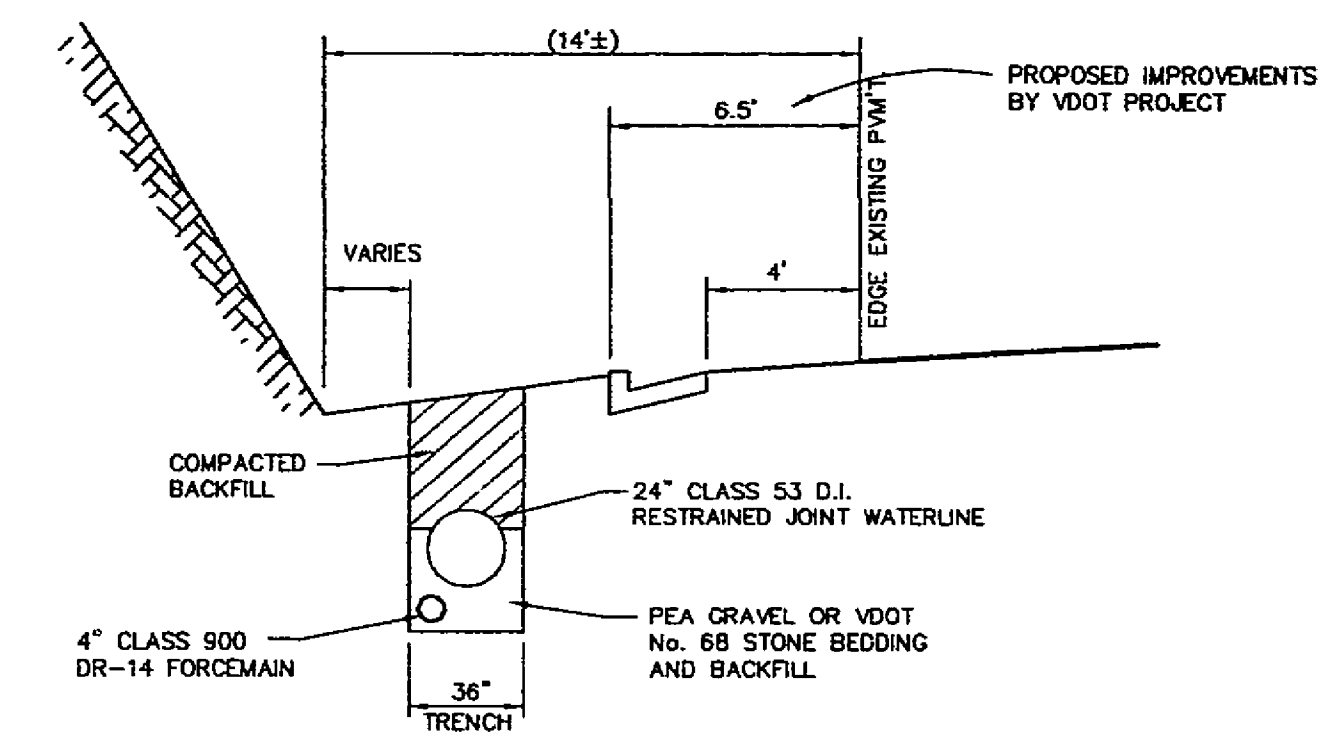

TYPICAL SECTION
(SEE DETAIL THIS SHEET)

TYPICAL SECTION
NO SCALE

SEE SHEET 3

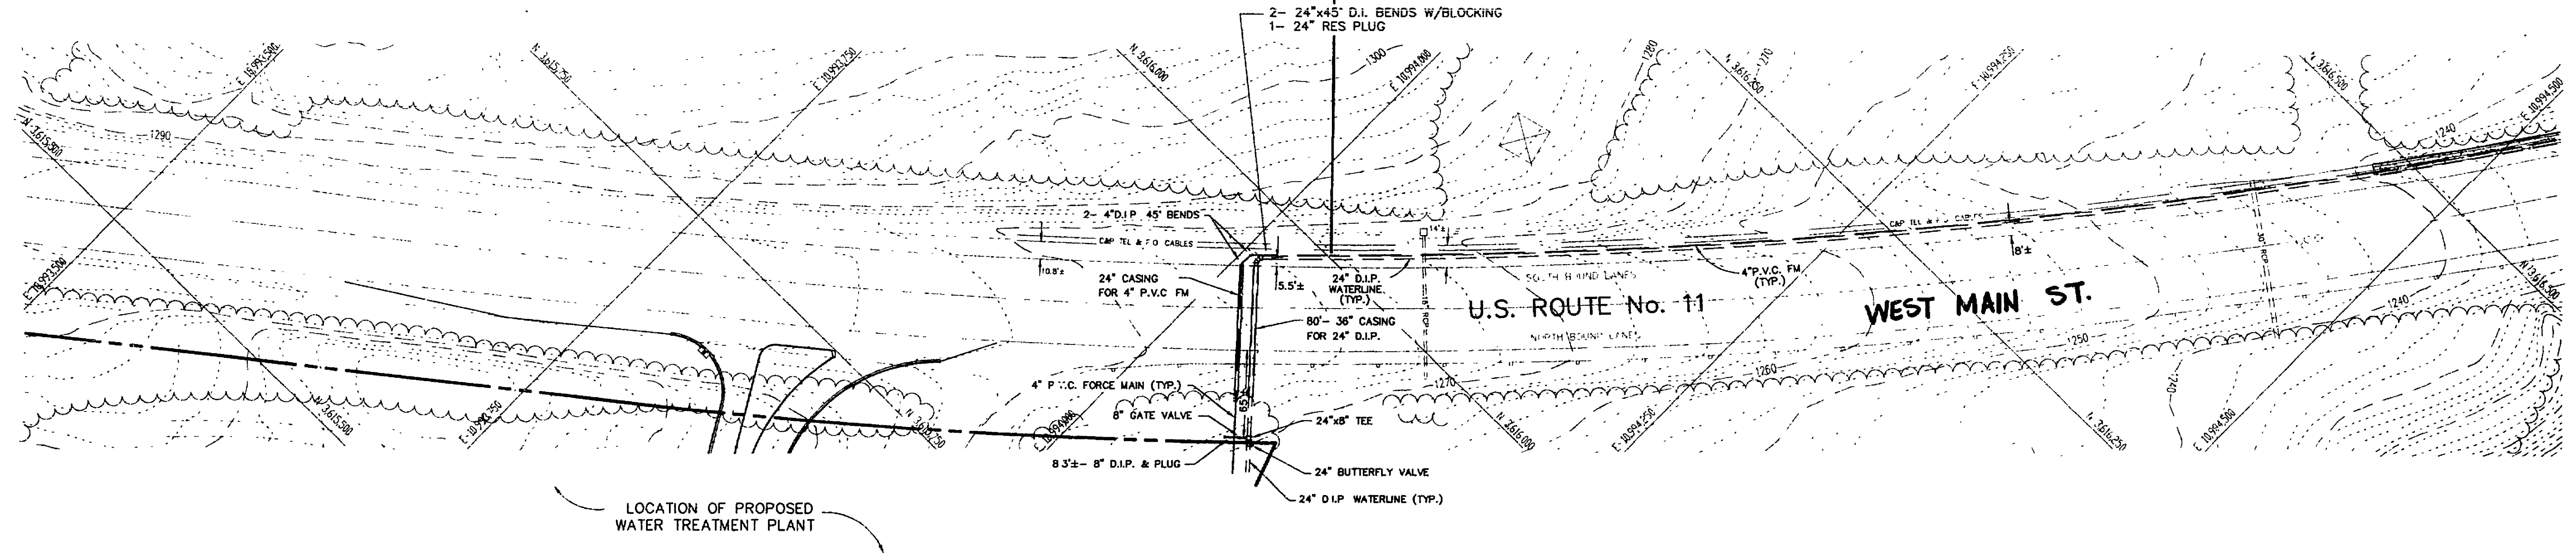

AS-BUILT
FEB. 3, 1995
WATERLINE & FORCE MAIN

PLAN FOR
COUNTY OF ROANOKE
WATERLINE AND
FORCE MAIN EXTENSION
CATAWBA MAGISTERIAL DISTRICT
ROANOKE COUNTY, VIRGINIA
SCALE: AS SHOWN

DESIGNED BY CLW
DRAWN BY JJB
CHECKED BY FBC
W.O. # 92-1077
N.B. ---
TAX NO. ---

TPP&S
ENGINEERS
SURVEYORS
PLANNERS

T. P. PARKER & SON
816 Boulevard
Post Office Box 39
Salem, Virginia 24163
Telephone: 703-387-1153
FAX: 703-389-8787

