


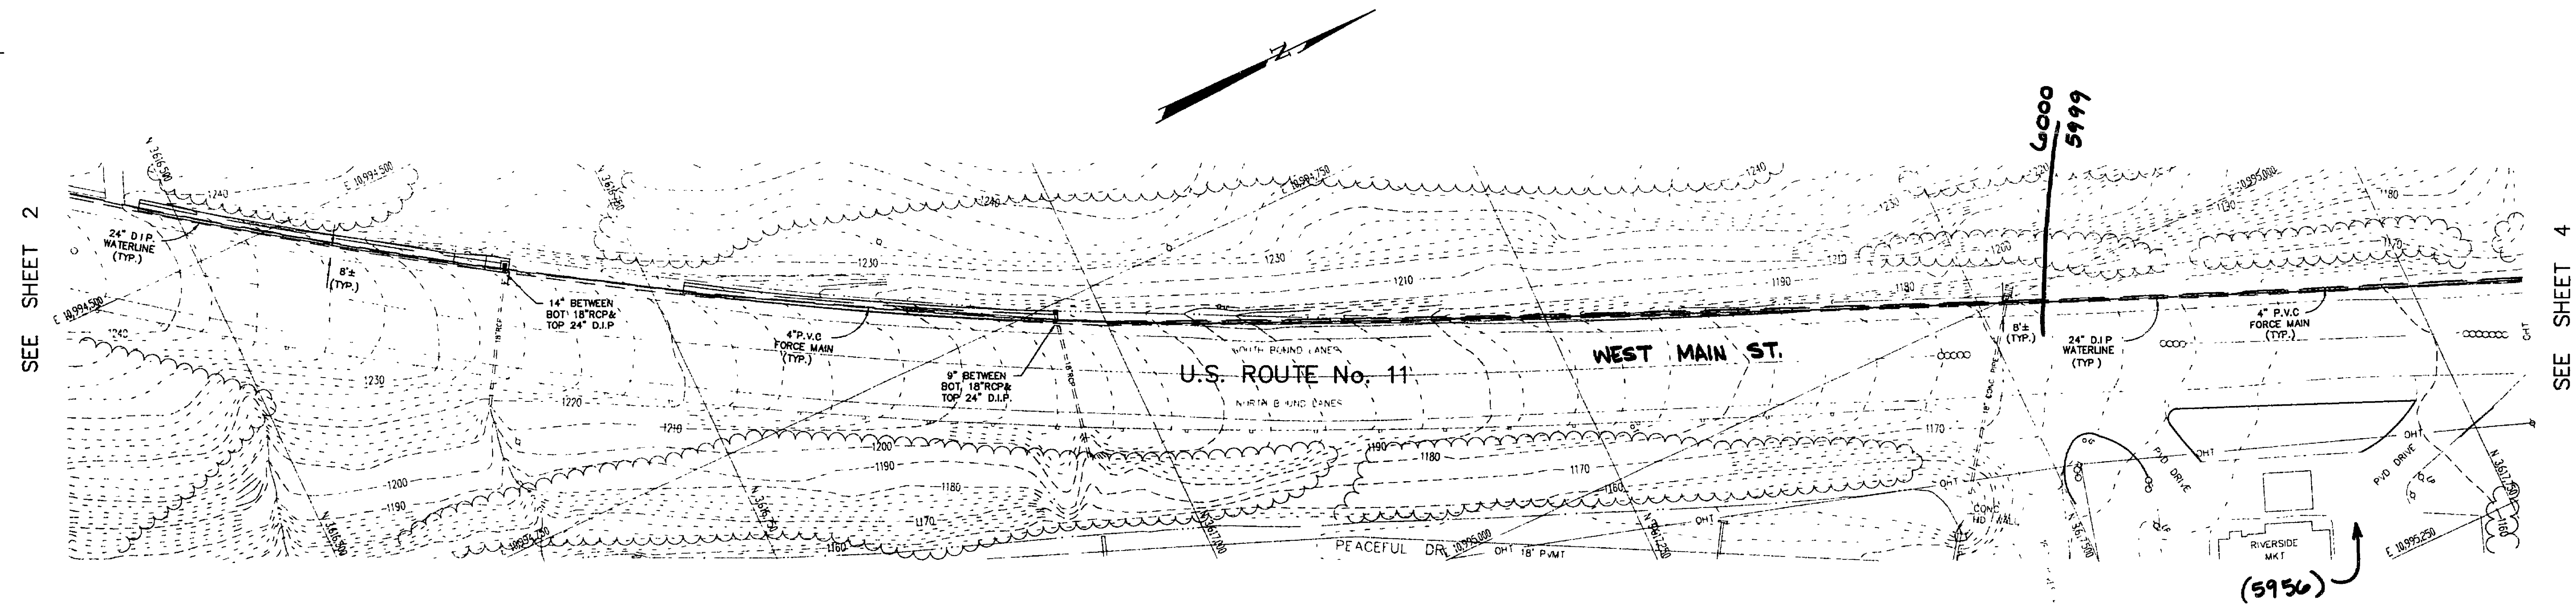

AS-BUILT
FEB. 3, 1995

WATERLINE & FORCEMAIN

PLAN FOR
COUNTY OF ROANOKE
WATERLINE AND
FORCE MAIN EXTENSION
CATAWBA MAGISTERIAL DISTRICT
ROANOKE COUNTY, VIRGINIA

SCALE: AS SHOWN

DESIGNED BY CLW
DRAWN BY JJB
CHECKED BY FBC
W.O. # 92-1077
N.B. — — —
TAX NO.

T. P. PARKER & SON
816 Boulevard
Post Office Box 39
Salem, Virginia 24153
Telephone: 703-367-1153
FAX: 703-369-5767

SHEET 3 OF 6
WT-0426

