

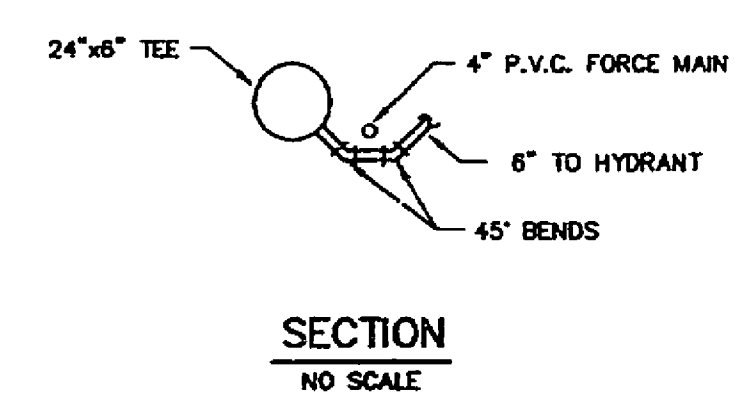
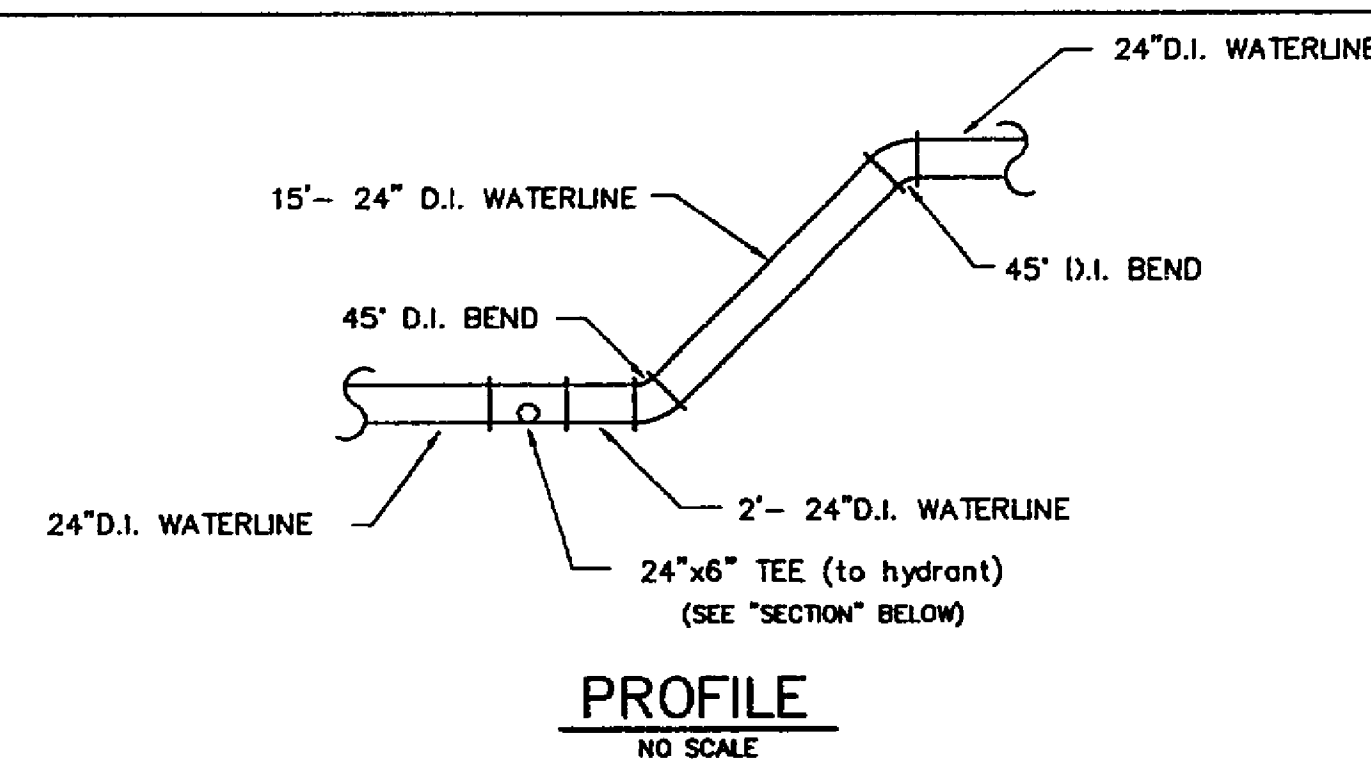


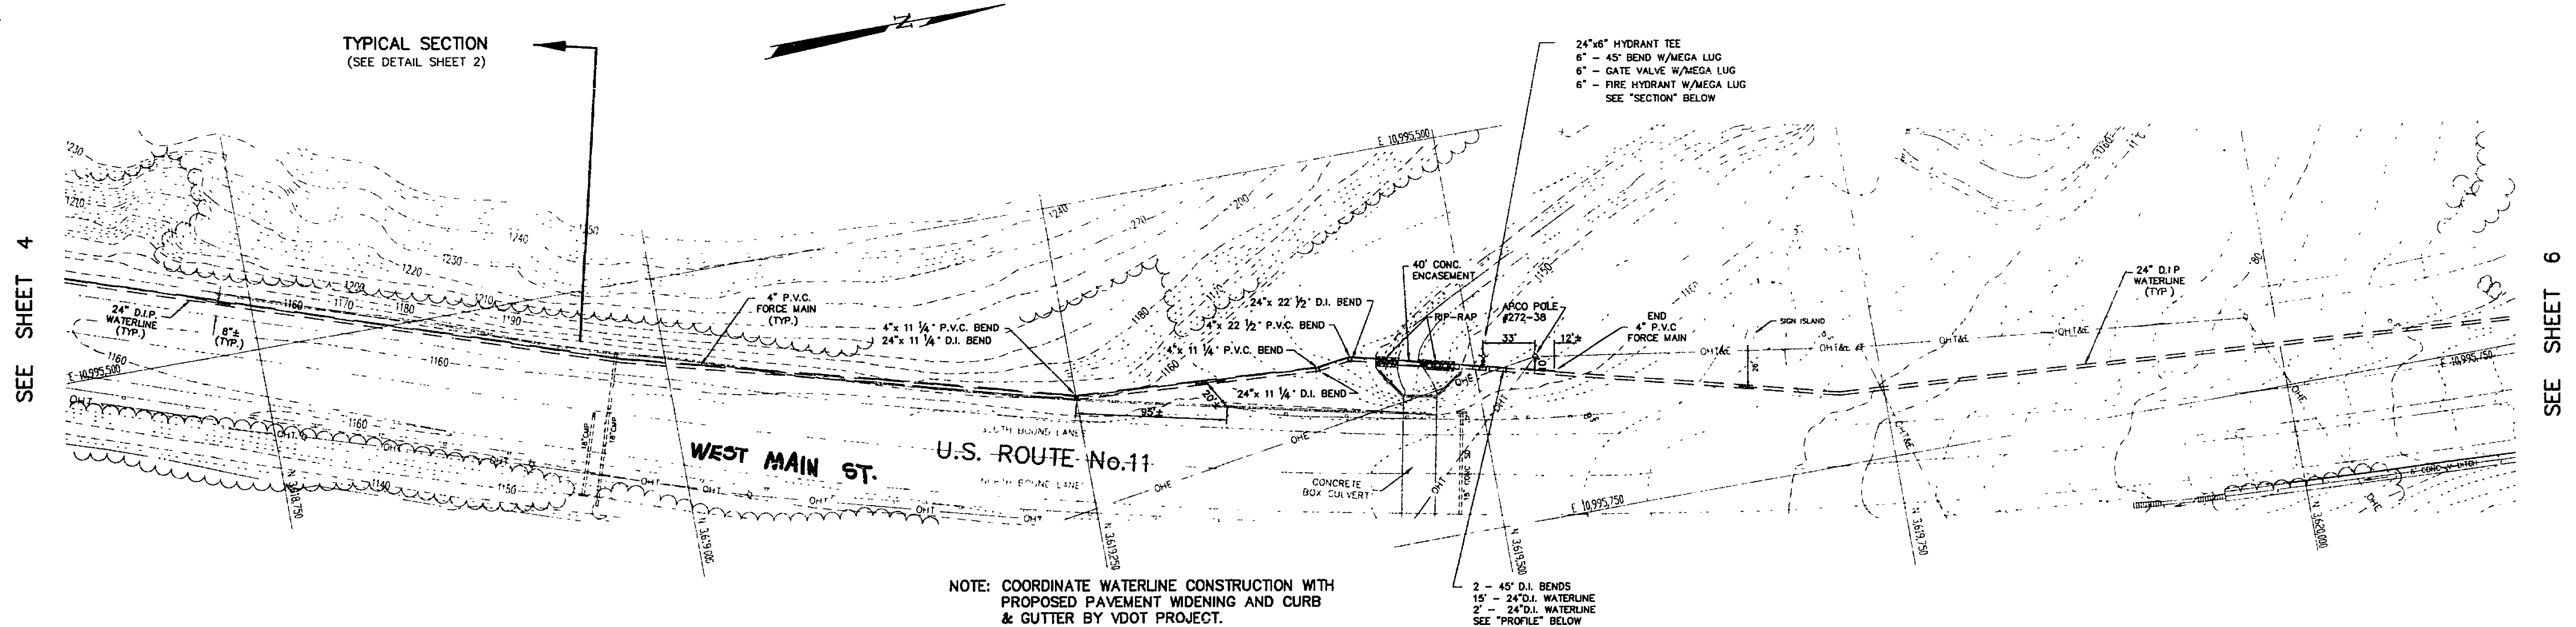

AS-BUILT
FEB. 3, 1995

WATERLINE & FORCEMAIN

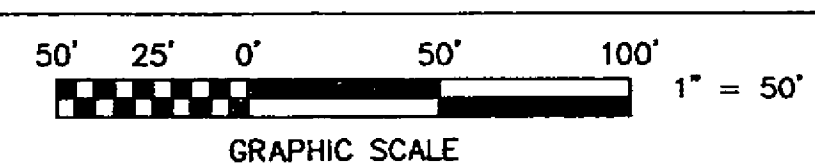

DESIGNED BY CLW DRAWN BY JUB CHECKED BY FBC W.O. # 92-1077 N.B. --- TAX NO. ---		PLAN FOR COUNTY OF ROANOKE WATERLINE AND FORCE MAIN EXTENSION CATAMBA MAGISTERIAL DISTRICT ROANOKE COUNTY, VIRGINIA SCALE: AS SHOWN
TPP&S ENGINEERS SURVEYORS PLANNERS		T. P. PARKER & SON 816 Boulevard Post Office Box 39 Salem, Virginia 24153 Telephone: 703-387-1153 FAX: 703-389-5767