


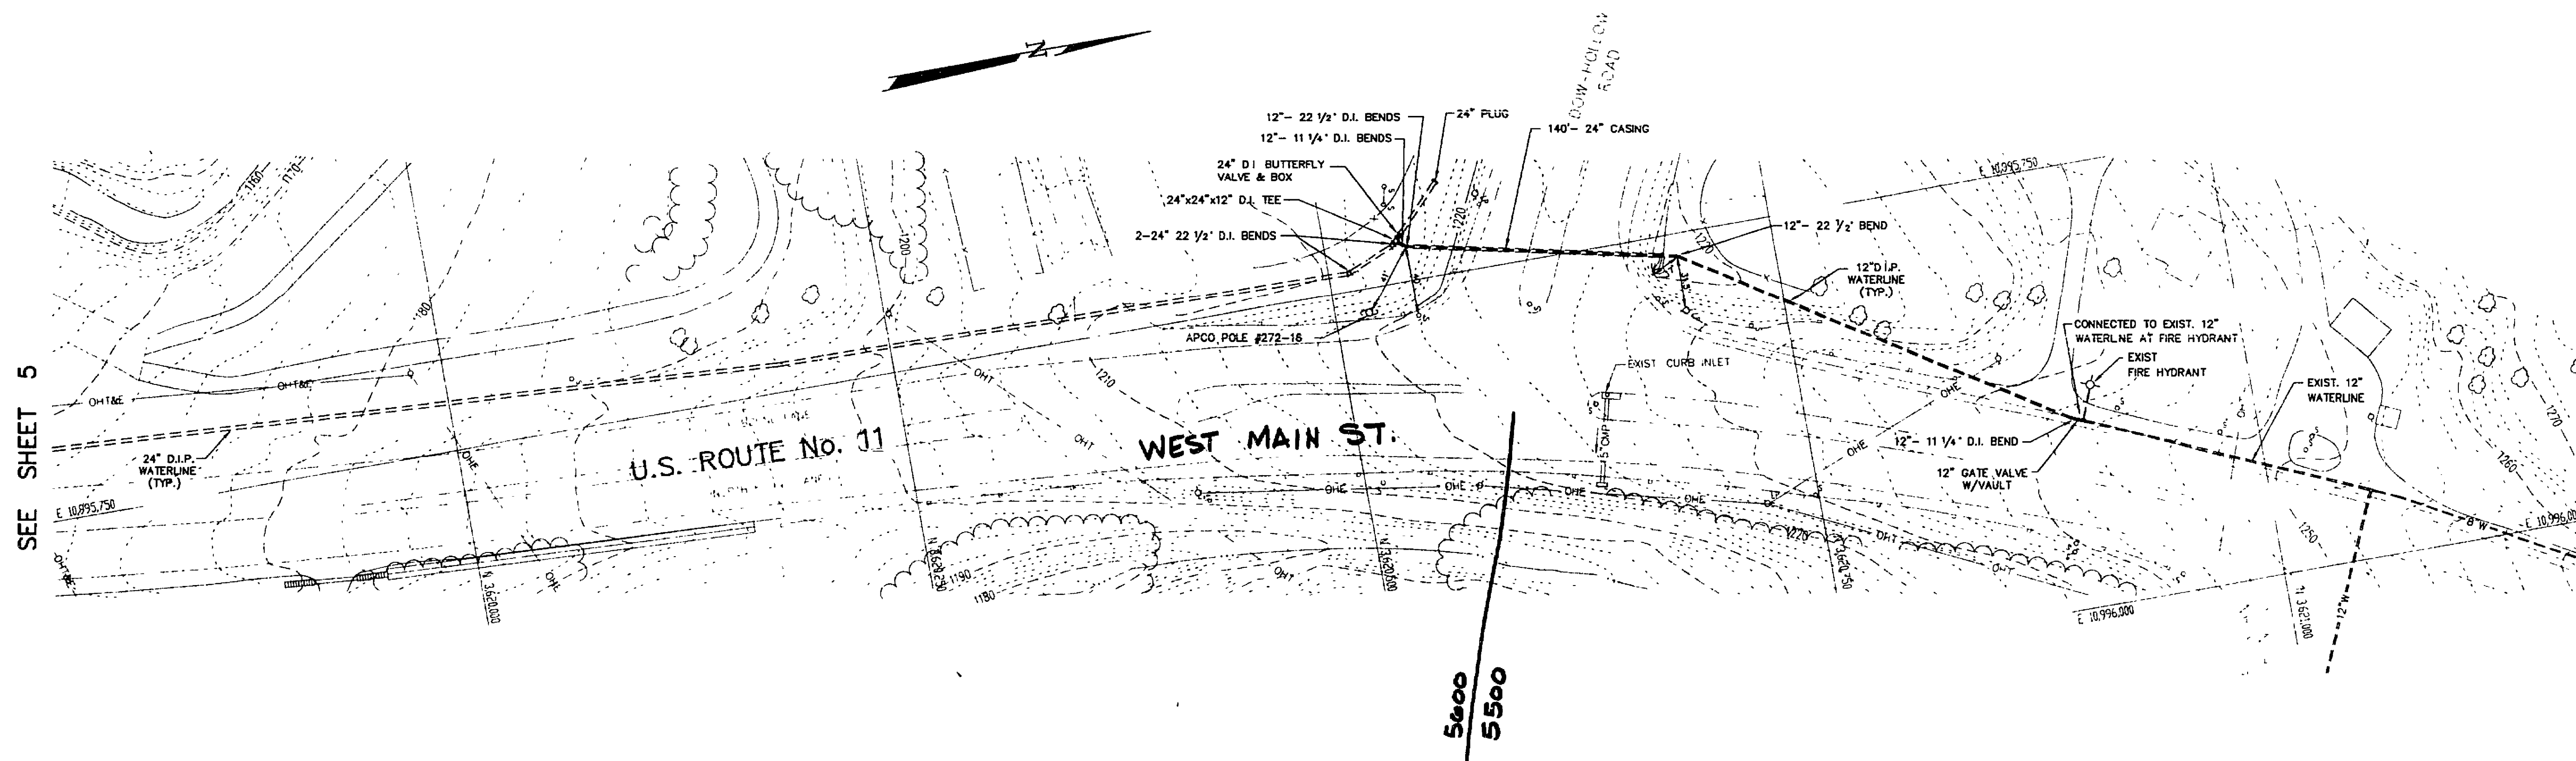


AS-BUILT  
FEB. 3, 1995  
WATERLINE & FORCEMAIN

PLAN FOR  
**COUNTY OF ROANOKE**  
WATERLINE AND  
FORCEMAIN EXTENSION  
CATAWBA MAGISTERIAL DISTRICT  
ROANOKE COUNTY, VIRGINIA  
SCALE: AS SHOWN

DESIGNED BY CLW  
DRAWN BY JJB  
CHECKED BY FBC  
W.O. # 92-1077  
N.B. ---  
TAX NO. ---

**TPP&S**  
ENGINEERS  
SURVEYORS  
PLANNERS

**T. P. PARKER & SON**  
816 Boulevard  
Post Office Box 39  
Salem, Virginia 24153  
Telephone: 703-507-1153  
FAX: 703-509-5767

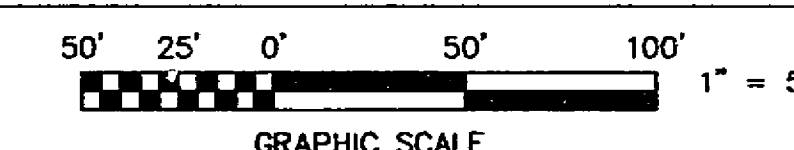

SHEET 6 OF 6  
WT-0429