


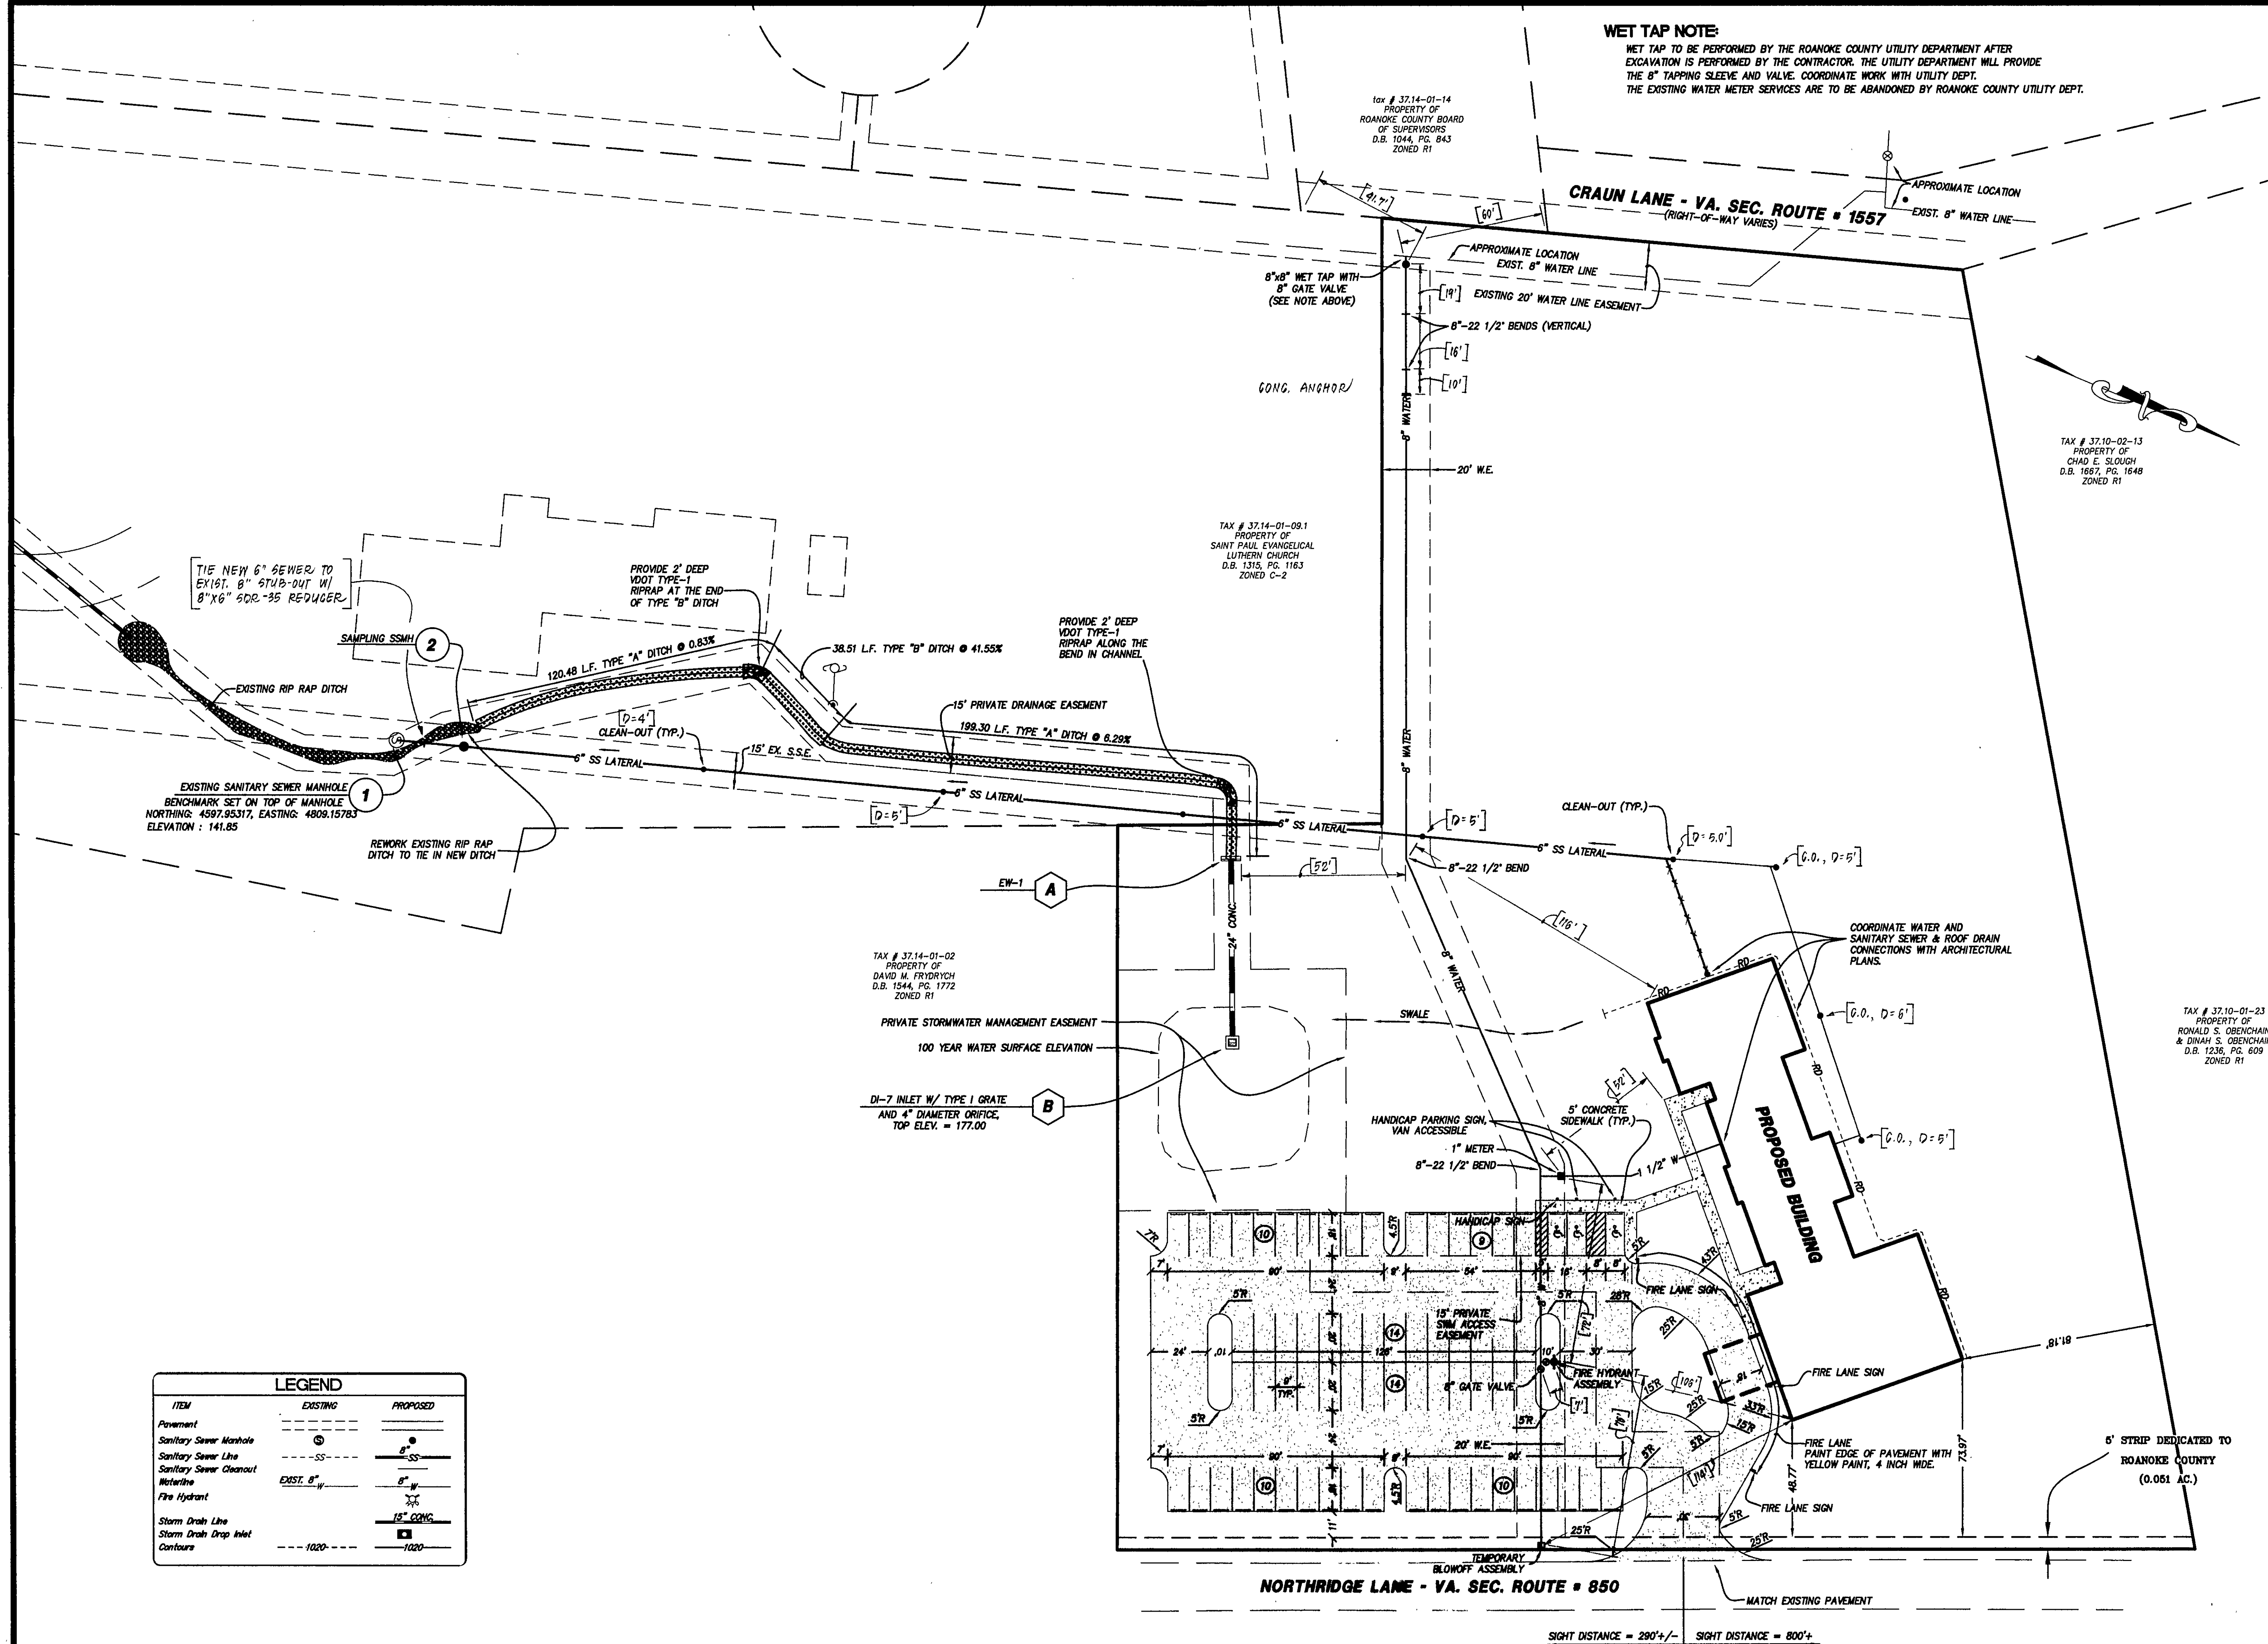

WET TAP NOTE:
WET TAP TO BE PERFORMED BY THE ROANOKE COUNTY UTILITY DEPARTMENT AFTER EXCAVATION IS PERFORMED BY THE CONTRACTOR. THE UTILITY DEPARTMENT WILL PROVIDE THE 8" TAPPING SLEEVE AND VALVE. COORDINATE WORK WITH UTILITY DEPT. THE EXISTING WATER METER SERVICES ARE TO BE ABANDONED BY ROANOKE COUNTY UTILITY DEPT.

LUMSDEN ASSOCIATES, P.C.
ENGINEERS-SURVEYORS-PLANNERS
ROANOKE, VIRGINIA

PHONE: (540) 774-4411
FAX: (540) 772-9445
E-MAIL: MAIL@LUMSDENPC.COM

4664 BRAMBLETON AVENUE
P.O. BOX 20669
ROANOKE, VIRGINIA 24018

COMMONWEALTH OF VIRGINIA
THOMAS C. DALE
No. 033002
4/1/09
PROFESSIONAL ENGINEER

**DIMENSIONAL LAYOUT
& UTILITIES**

**NORTH VALLEY
SEVENTH DAY ADVENTIST
PREPARED FOR
STRUCTURES DESIGN/BUILD
CATAWBA MAGISTERIAL DISTRICT
ROANOKE COUNTY, VIRGINIA**

REVISIONS		DESCRIPTION
NO.	DATE	DESCRIPTION
1	8/30/04	"AS-BUILT" SANITARY SEWER & WATER
2		
3		
4		
5		

DATE: JUNE 1, 2004
SCALE: 1" = 30'
COMMISSION NO.: 03-360
CADD FILE: P:\2003\03360\END\380COMP
SHEET 5 OF 10

LEGEND		
ITEM	EXISTING	PROPOSED
Pavement	---	---
Sanitary Sewer Manhole	⊙	⊙
Sanitary Sewer Line	---	---
Sanitary Sewer Cleanout	---	---
Waterline	---	---
Fire Hydrant	⊙	⊙
Storm Drain Line	---	---
Storm Drain Drop Inlet	---	---
Contours	---	---

"AS-BUILT"