
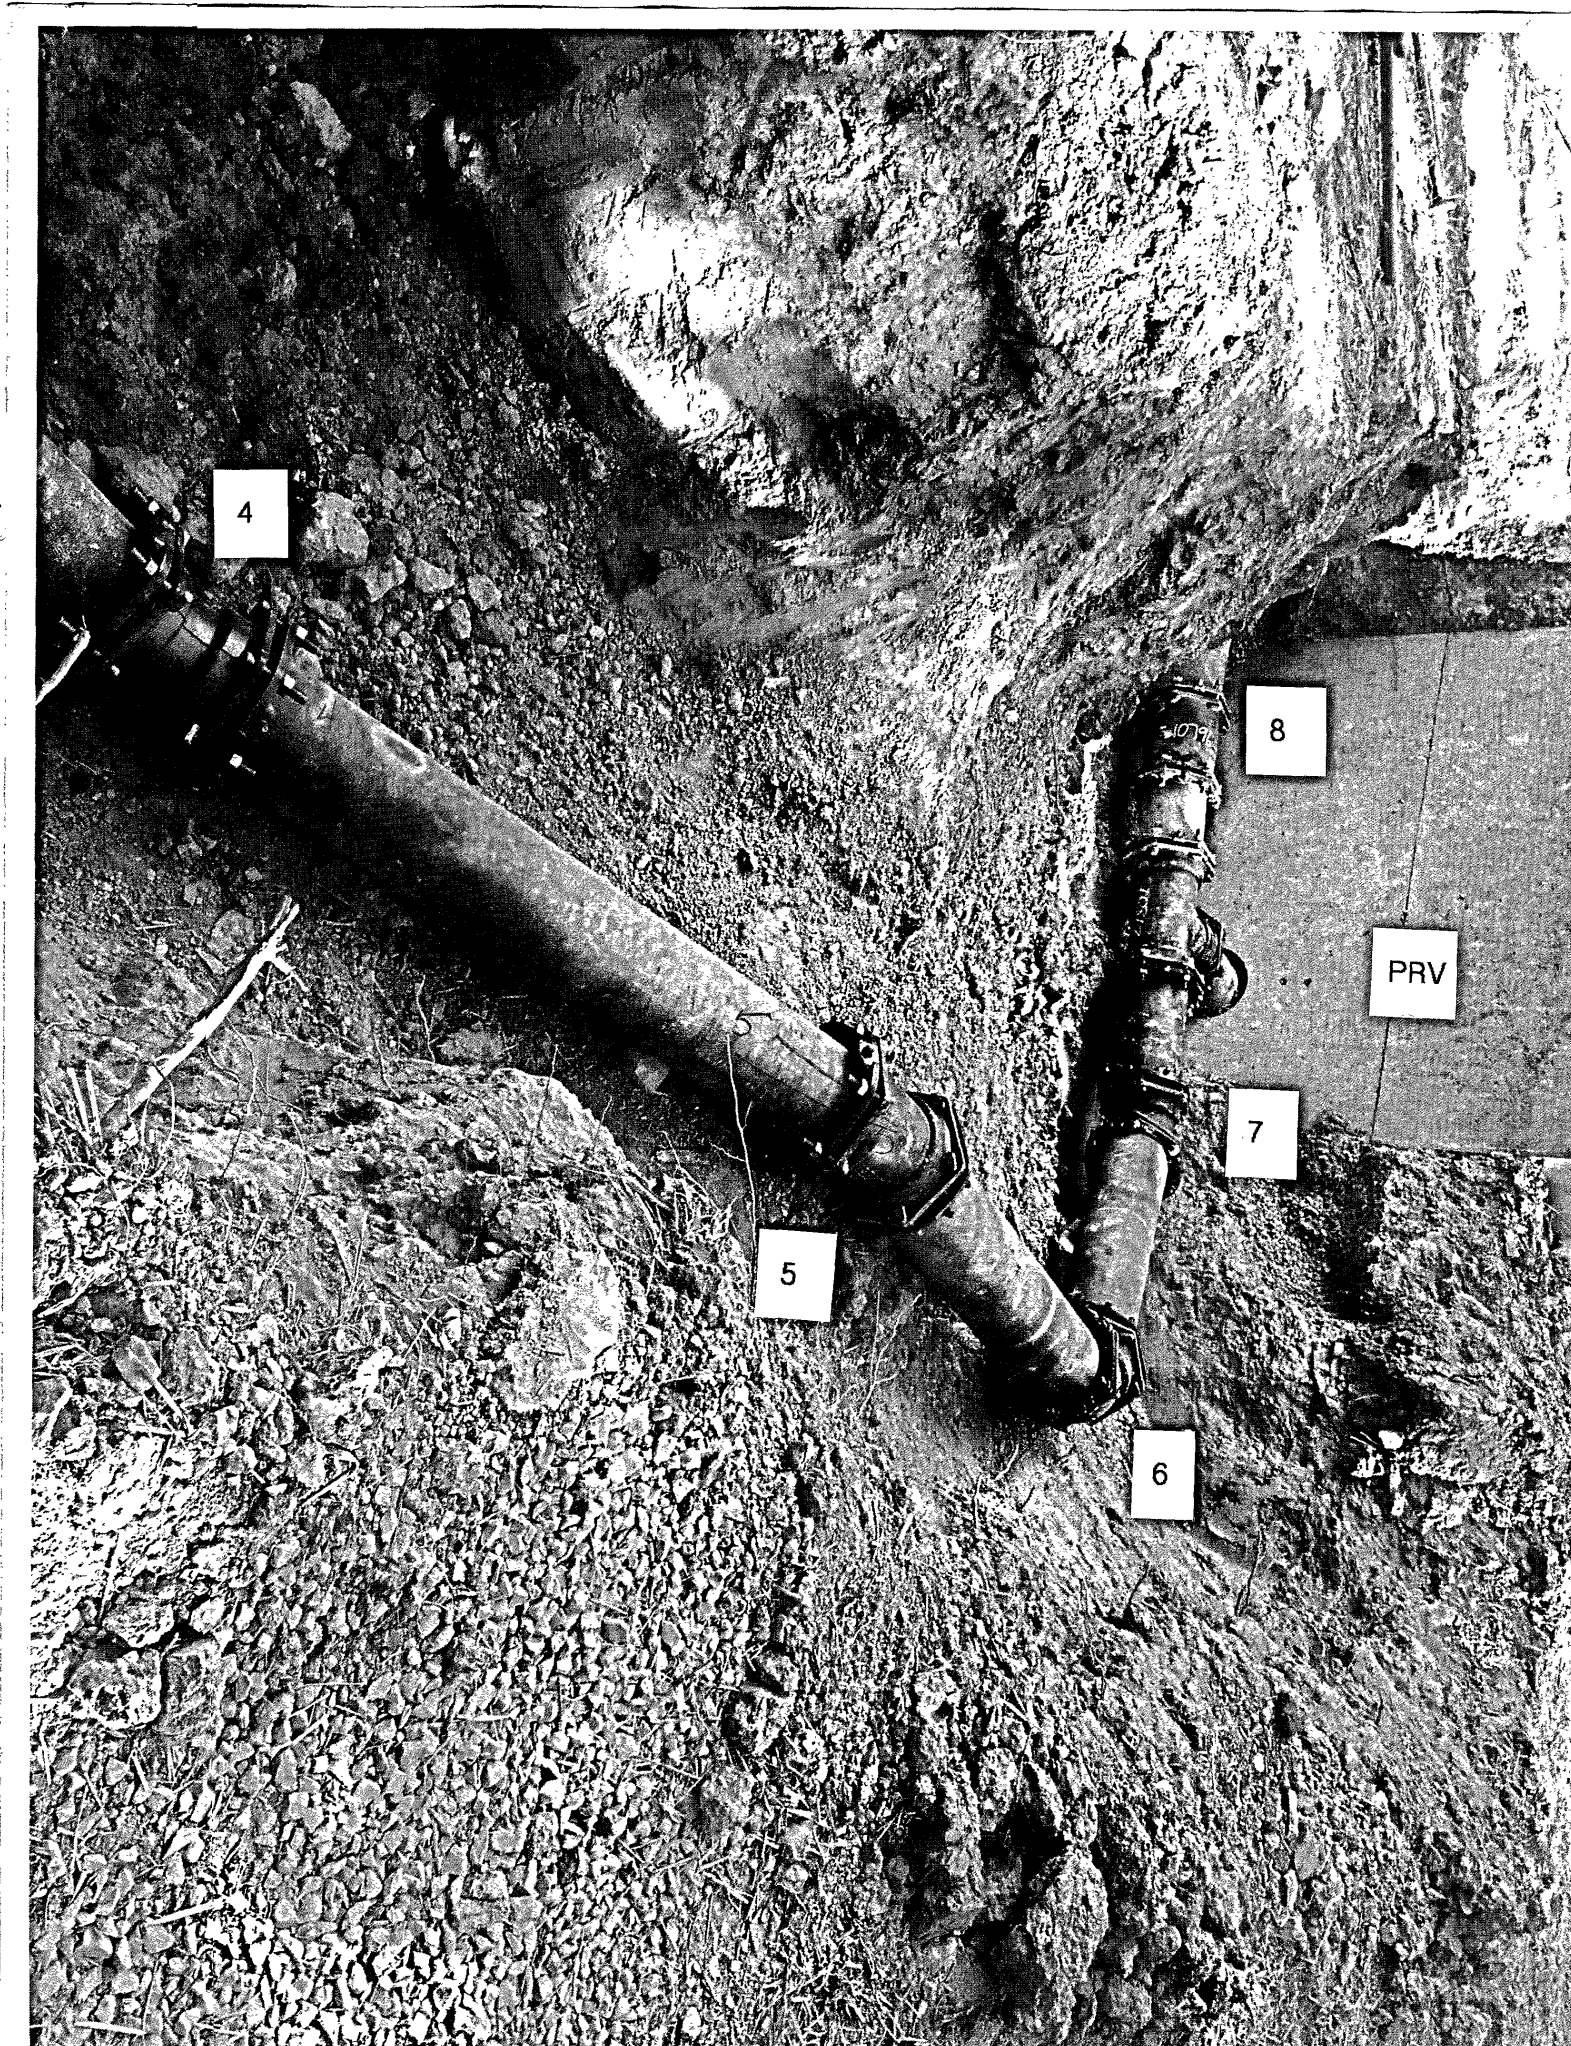
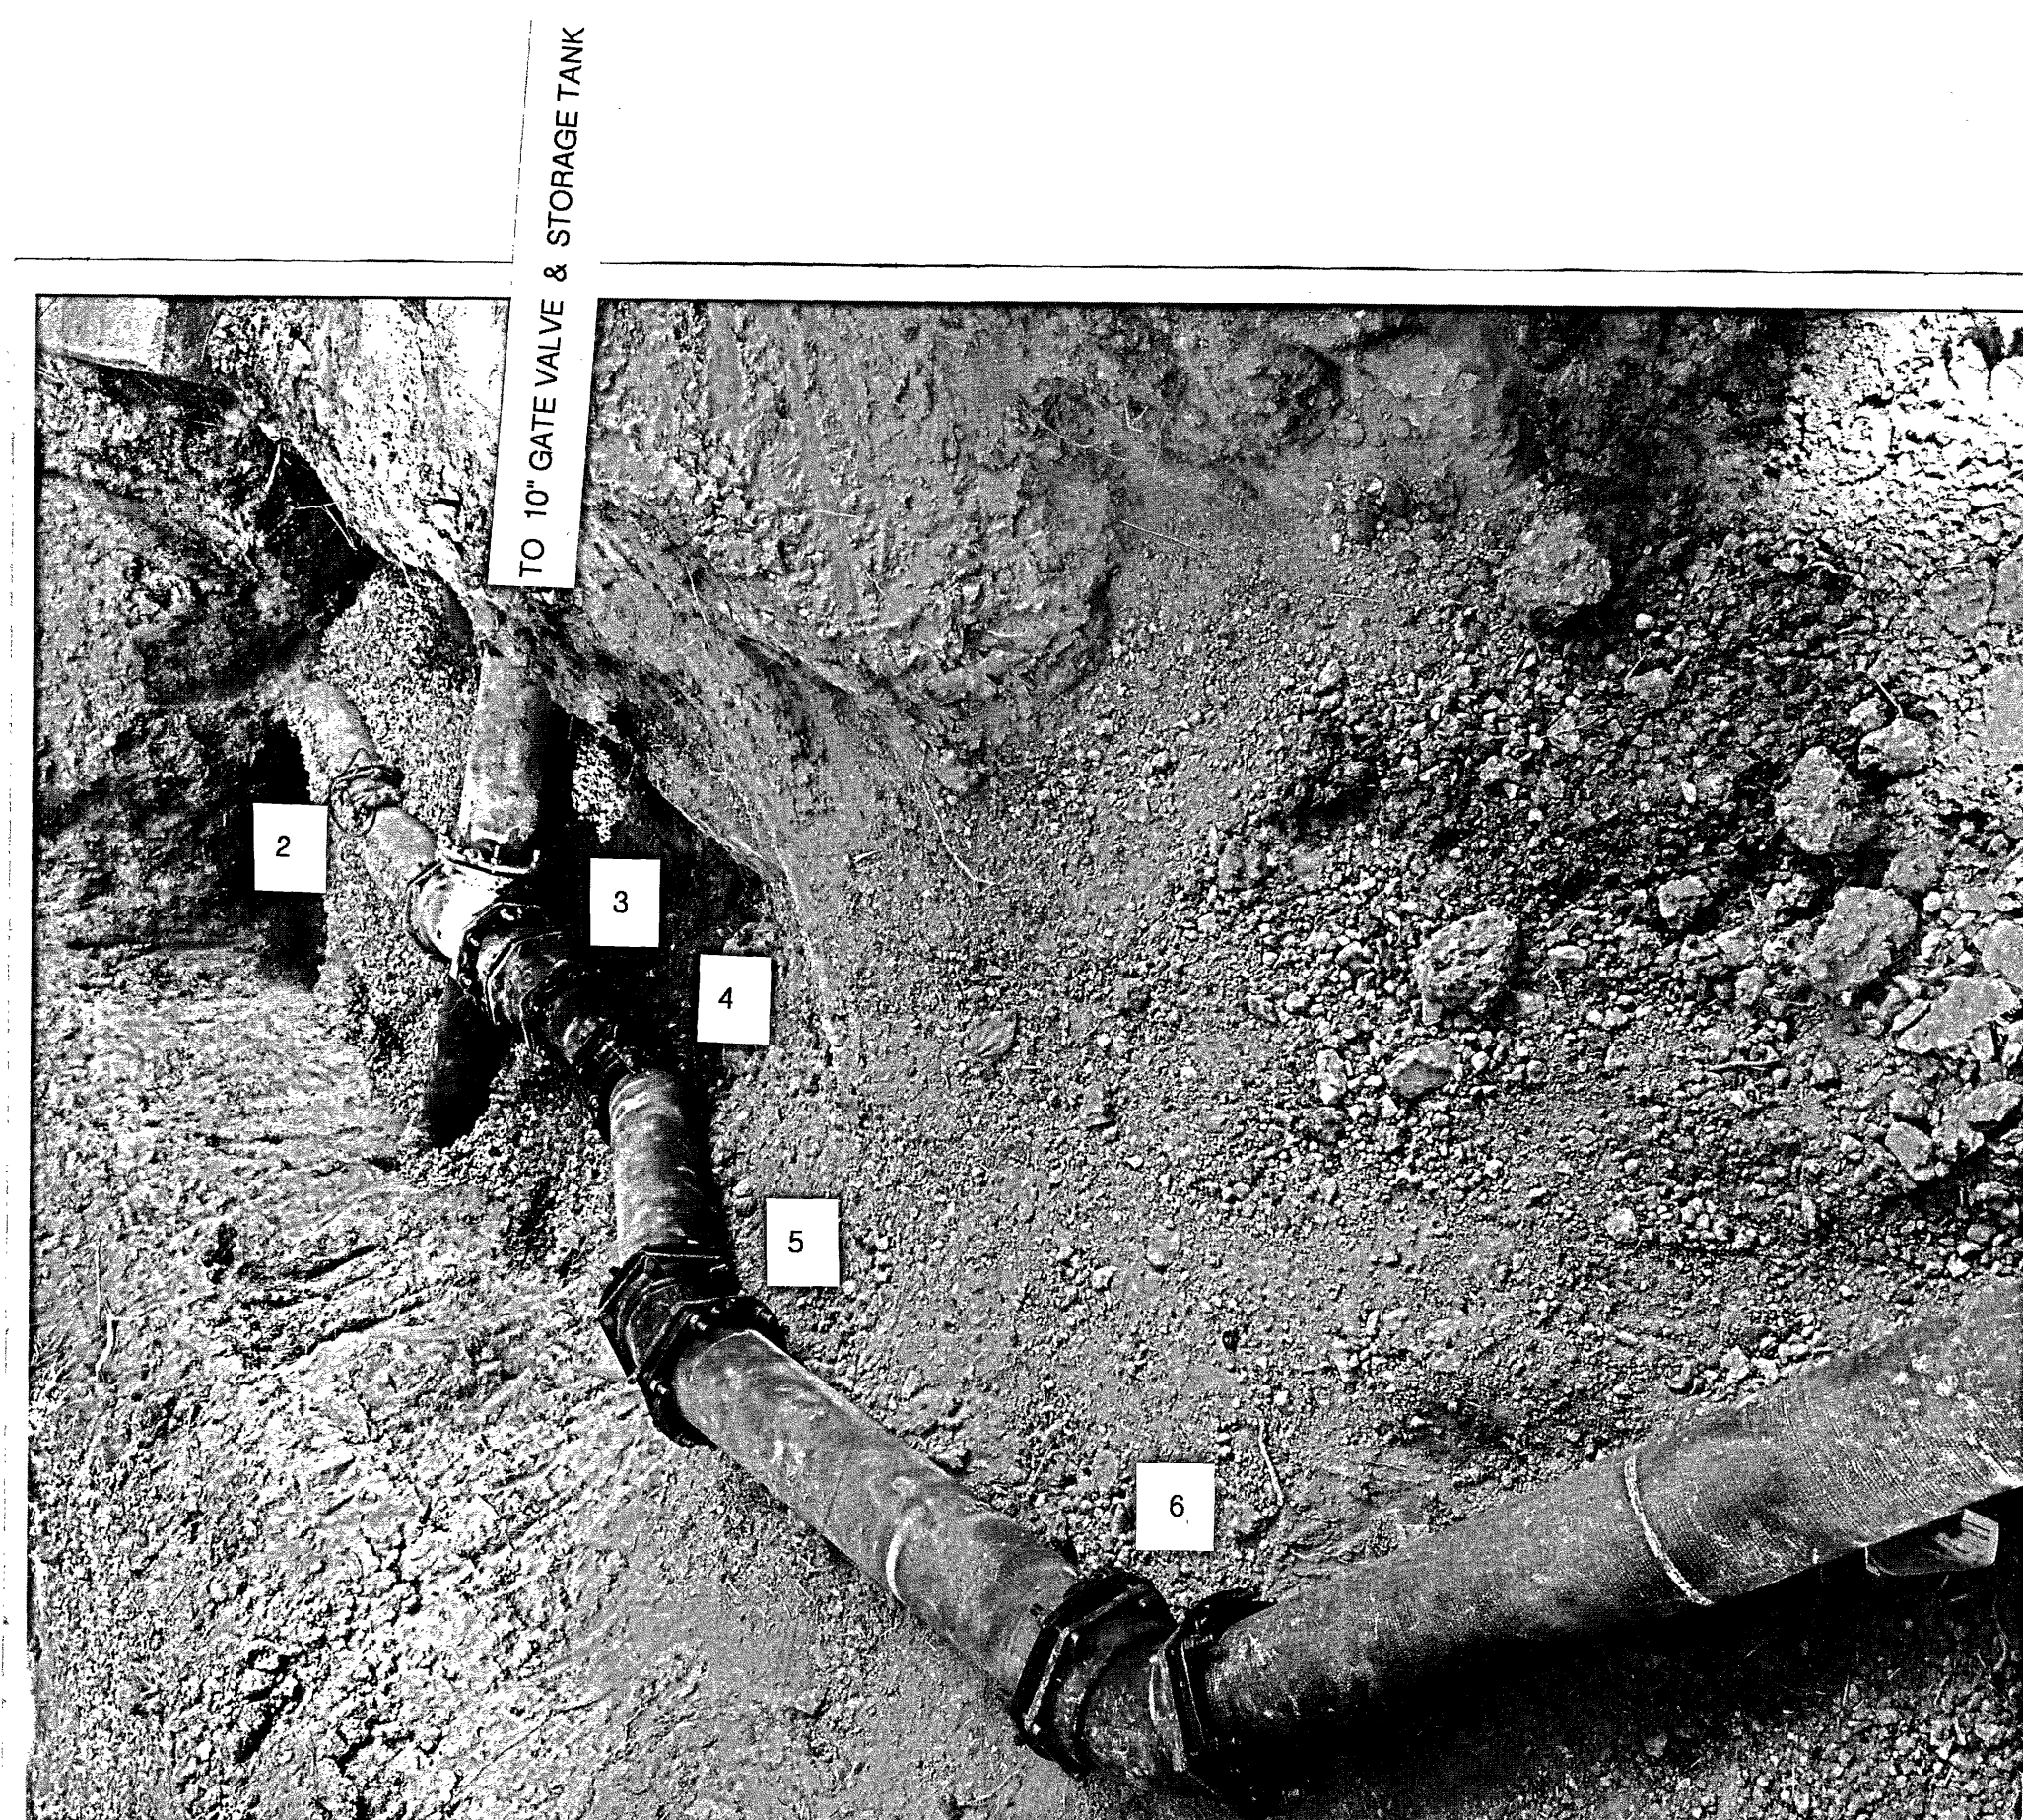
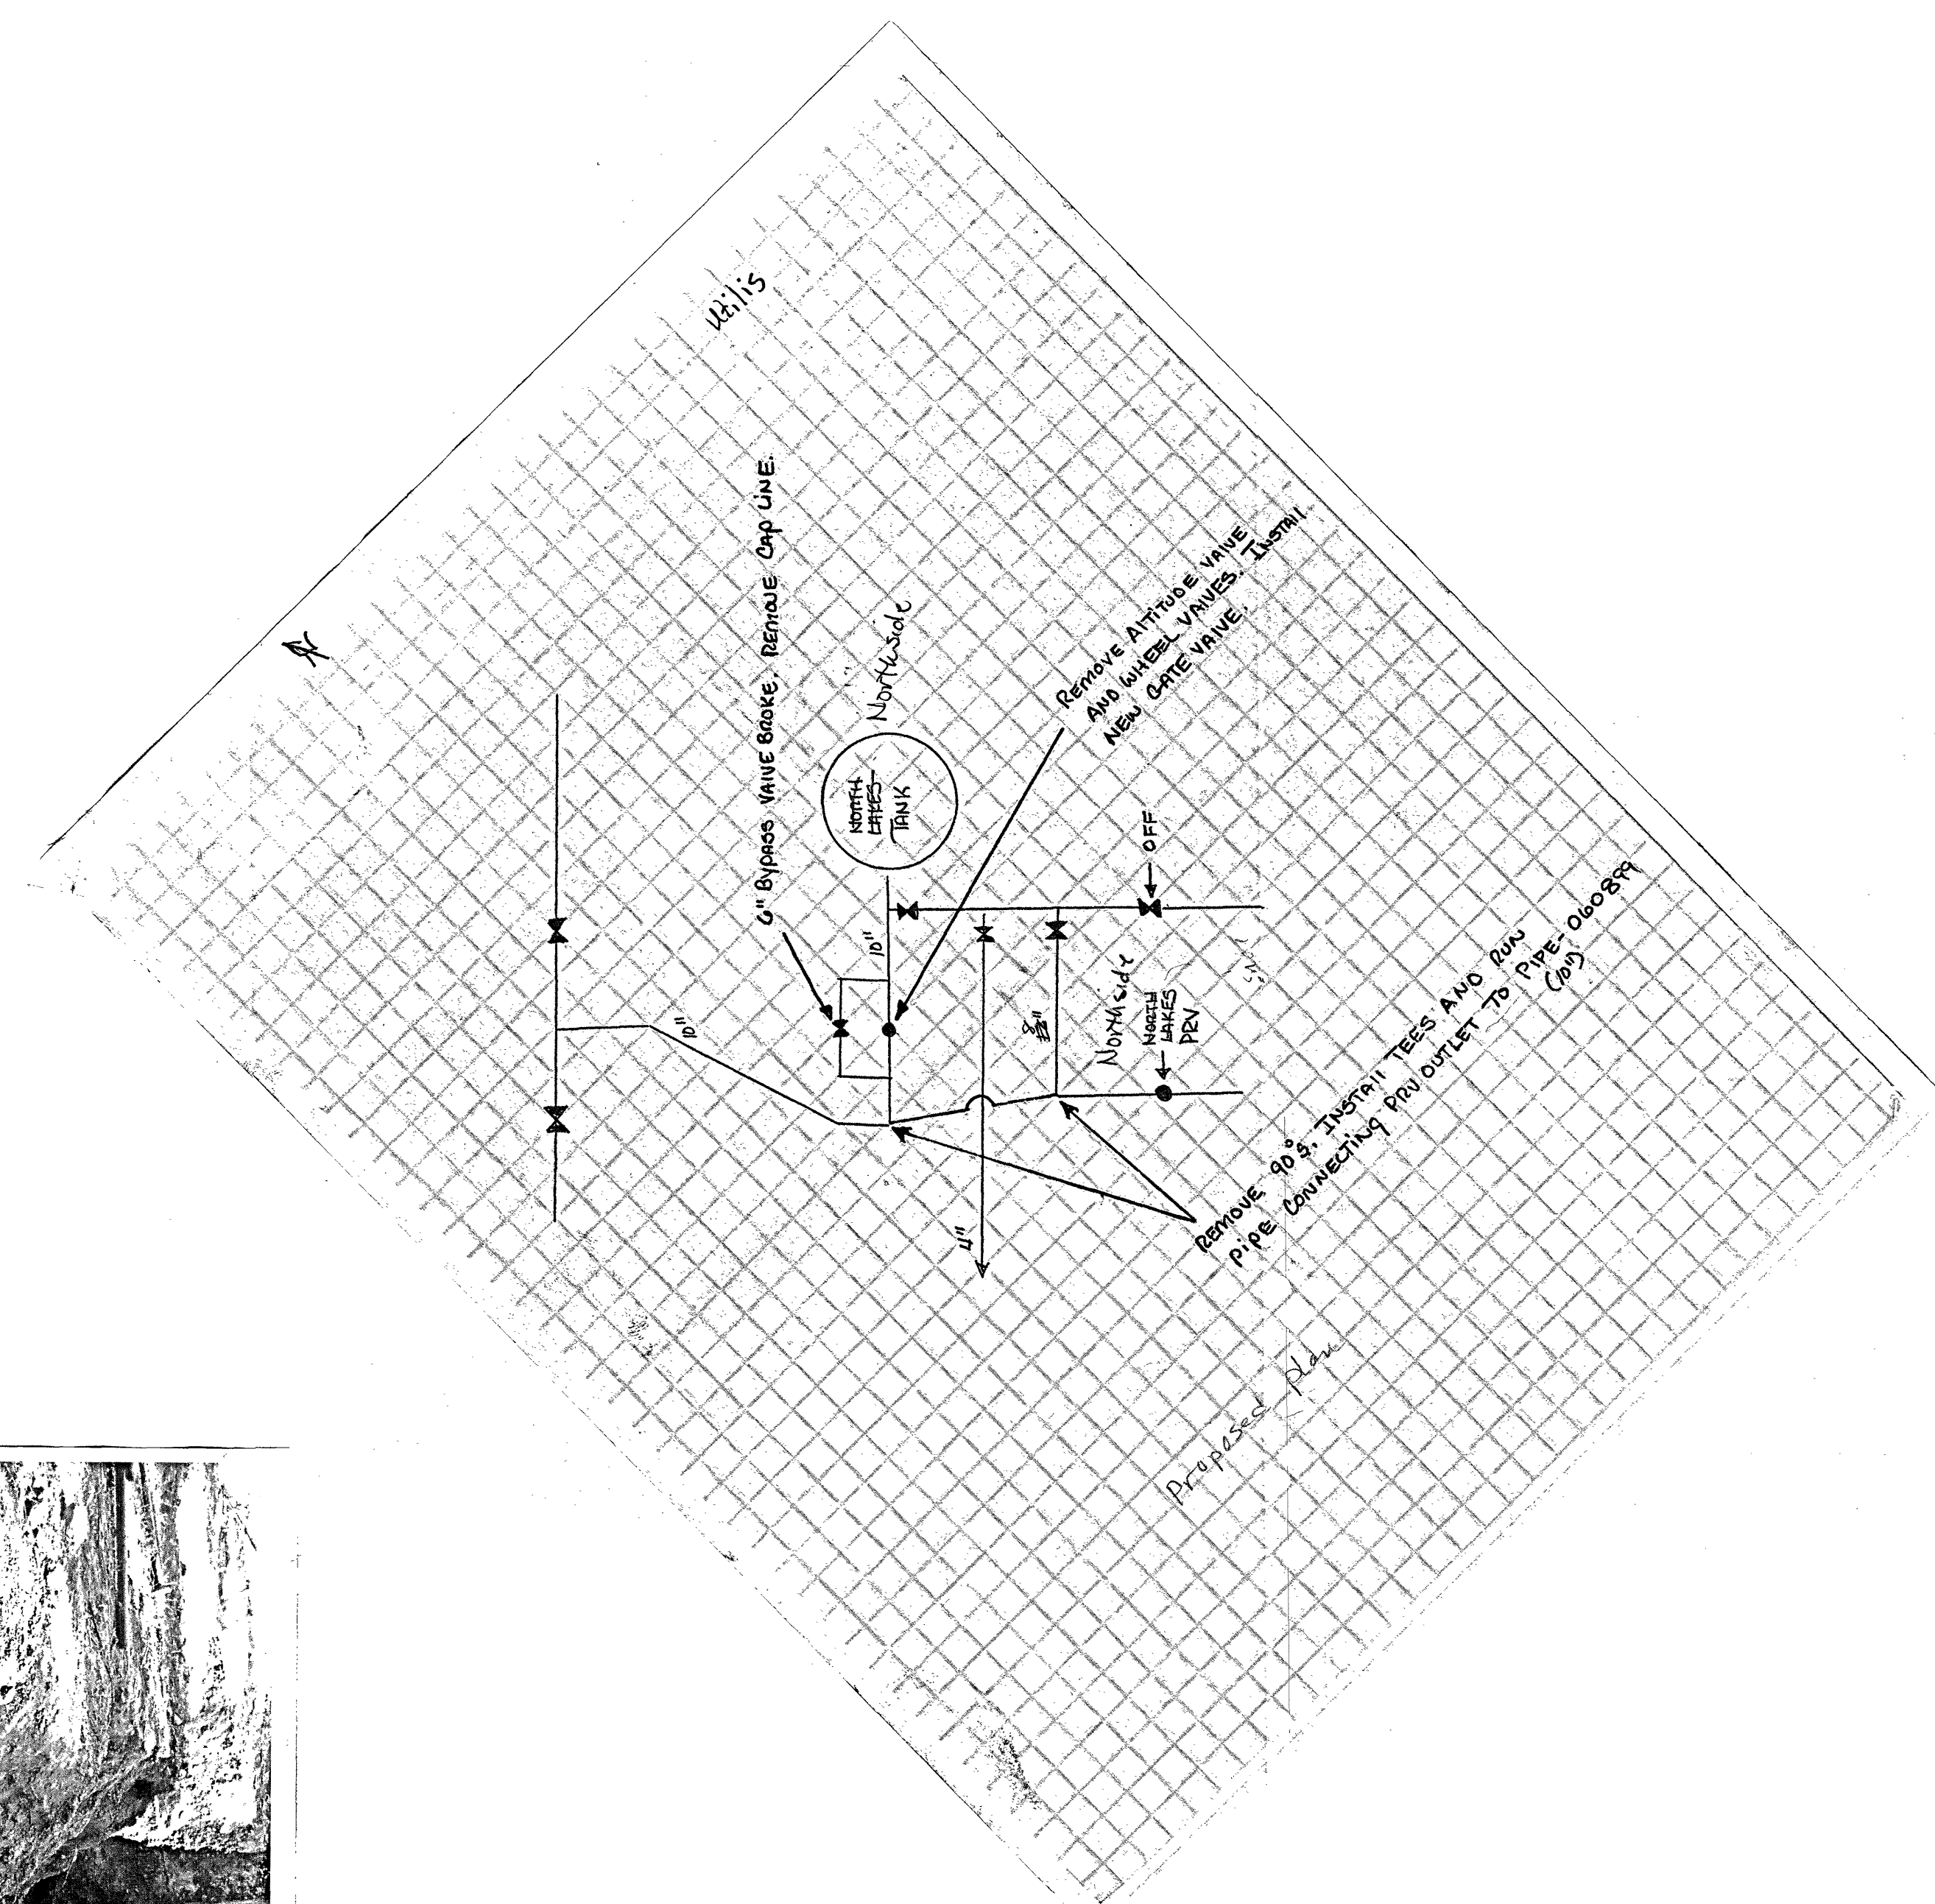
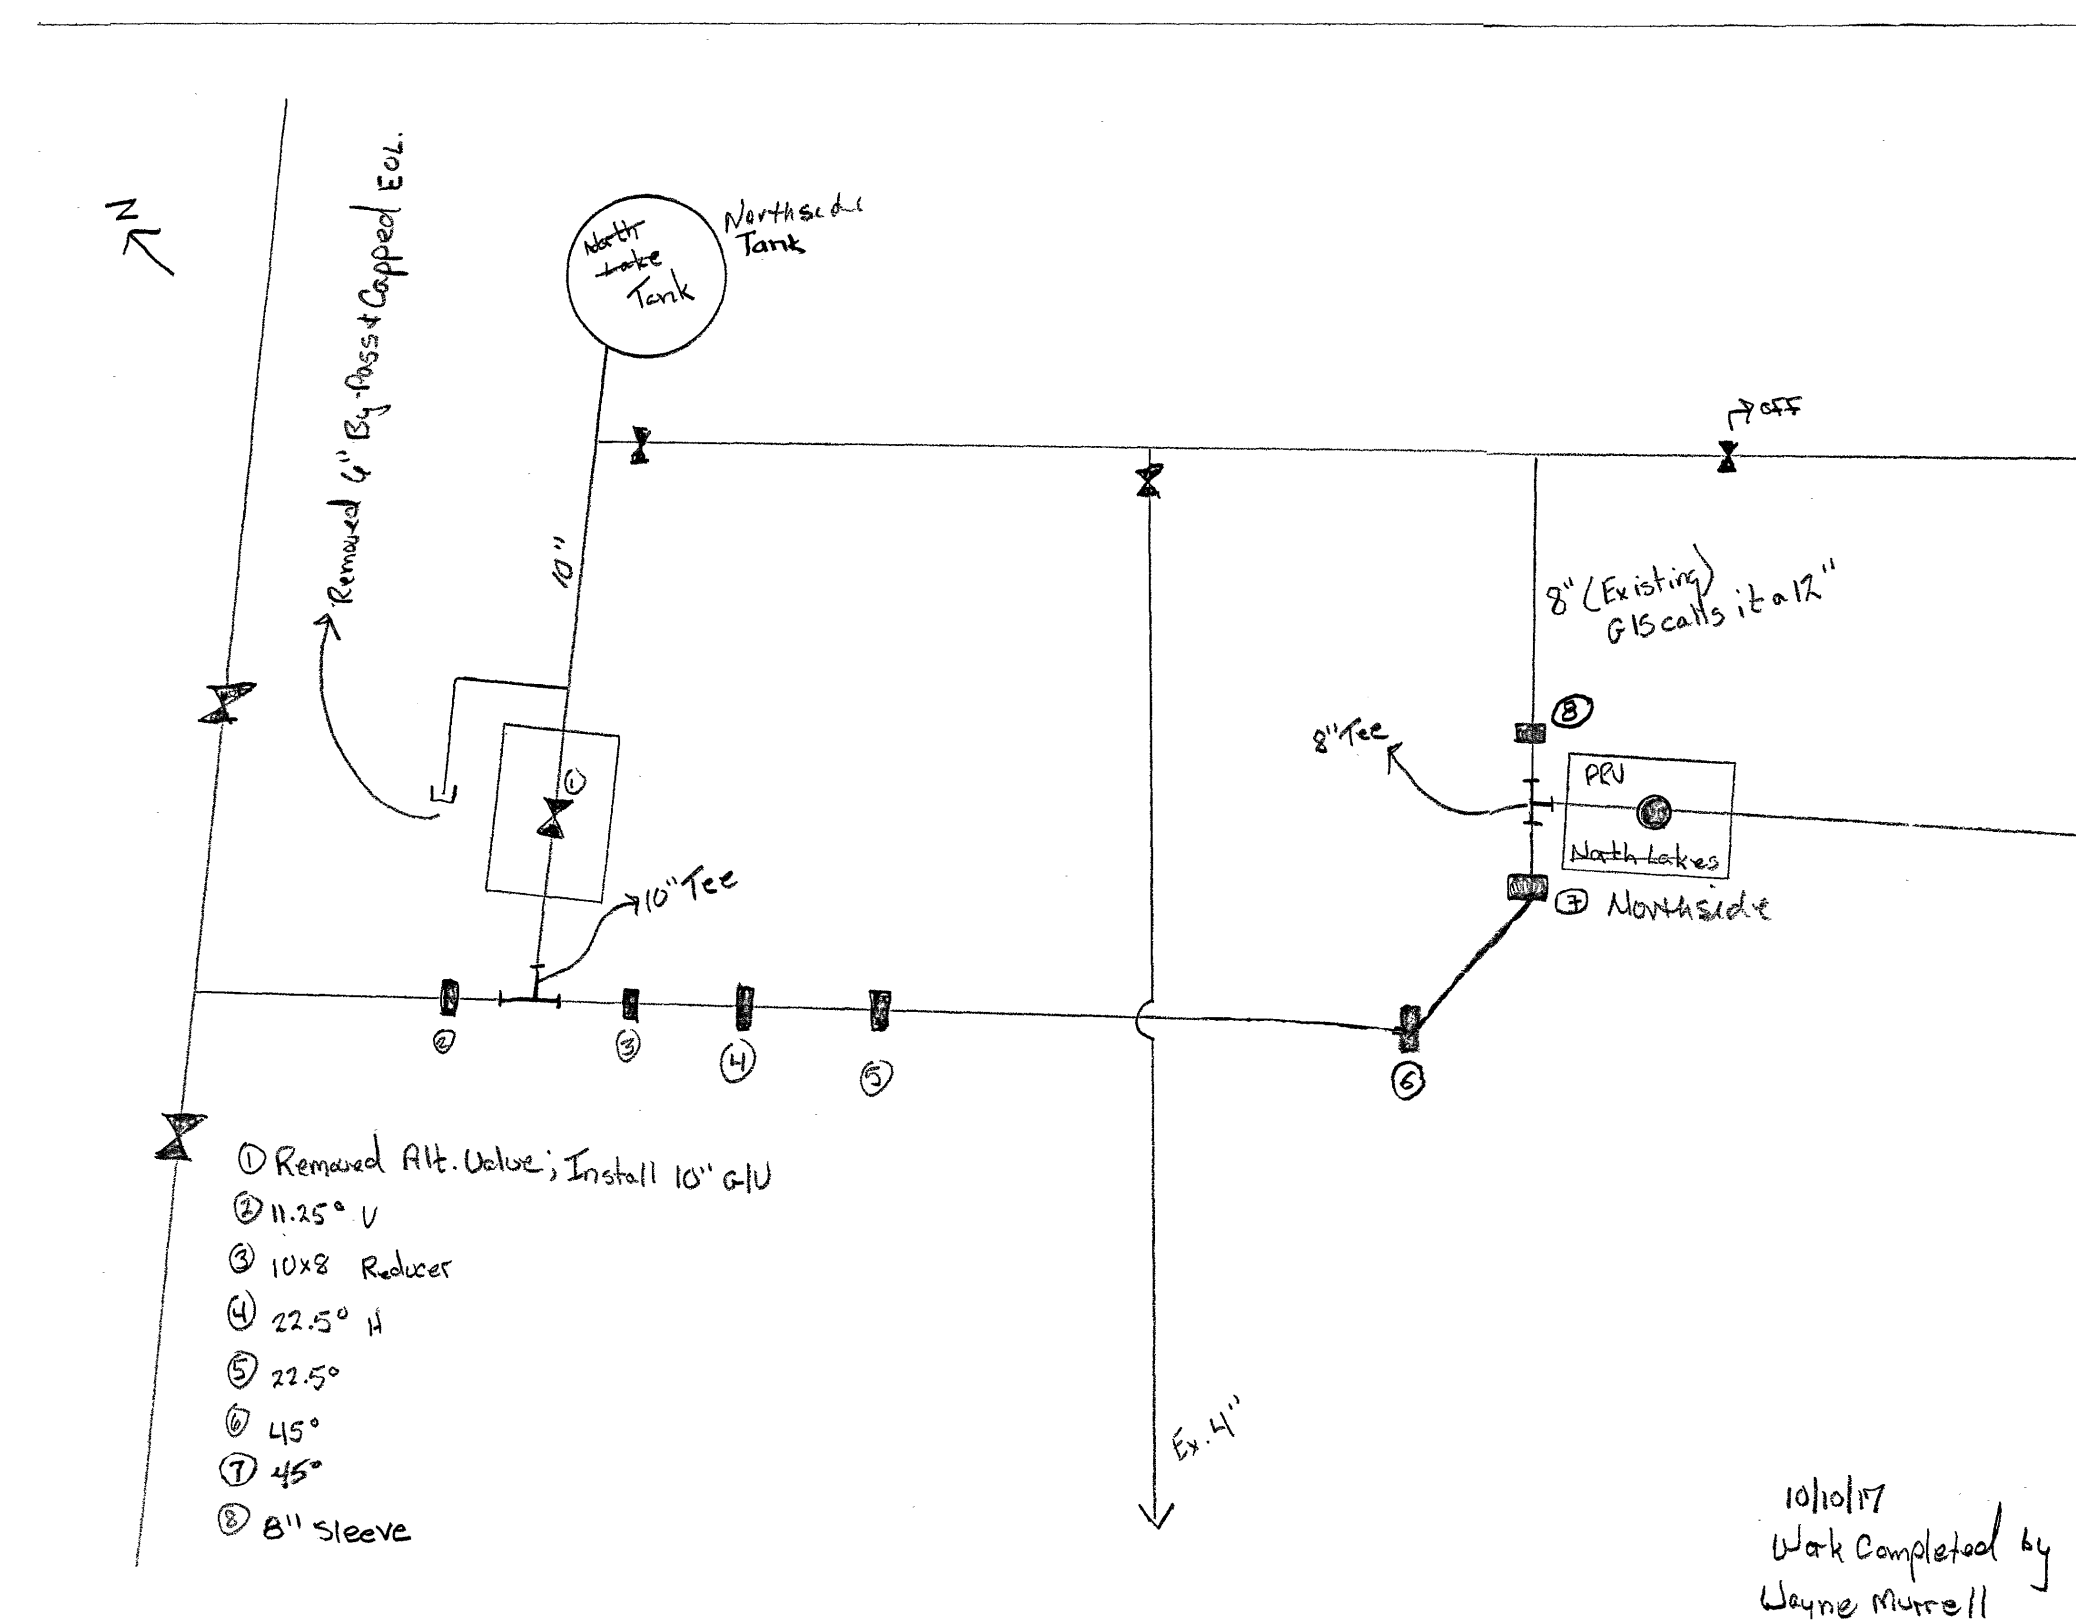


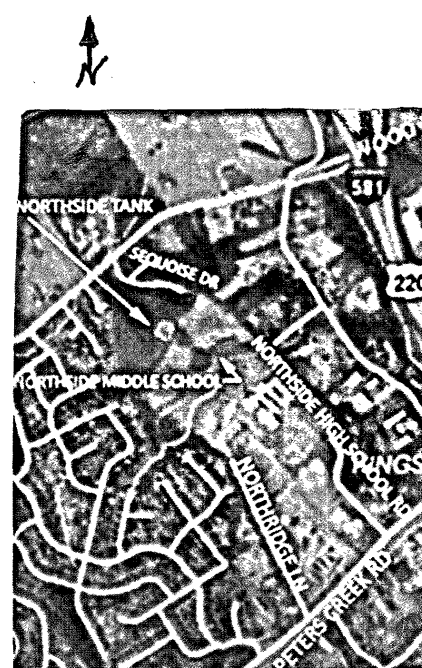

Installed by:
Western Virginia Water Authority
Field Operations

	WATERLINE	RELOCATION
	NORTHSIDE	WATER TANK
4968 NORTH RIDGE LANE, ROANOKE COUNTY		
SCALE: NTS		
AS-BUILT DATE: 10/10/2017		