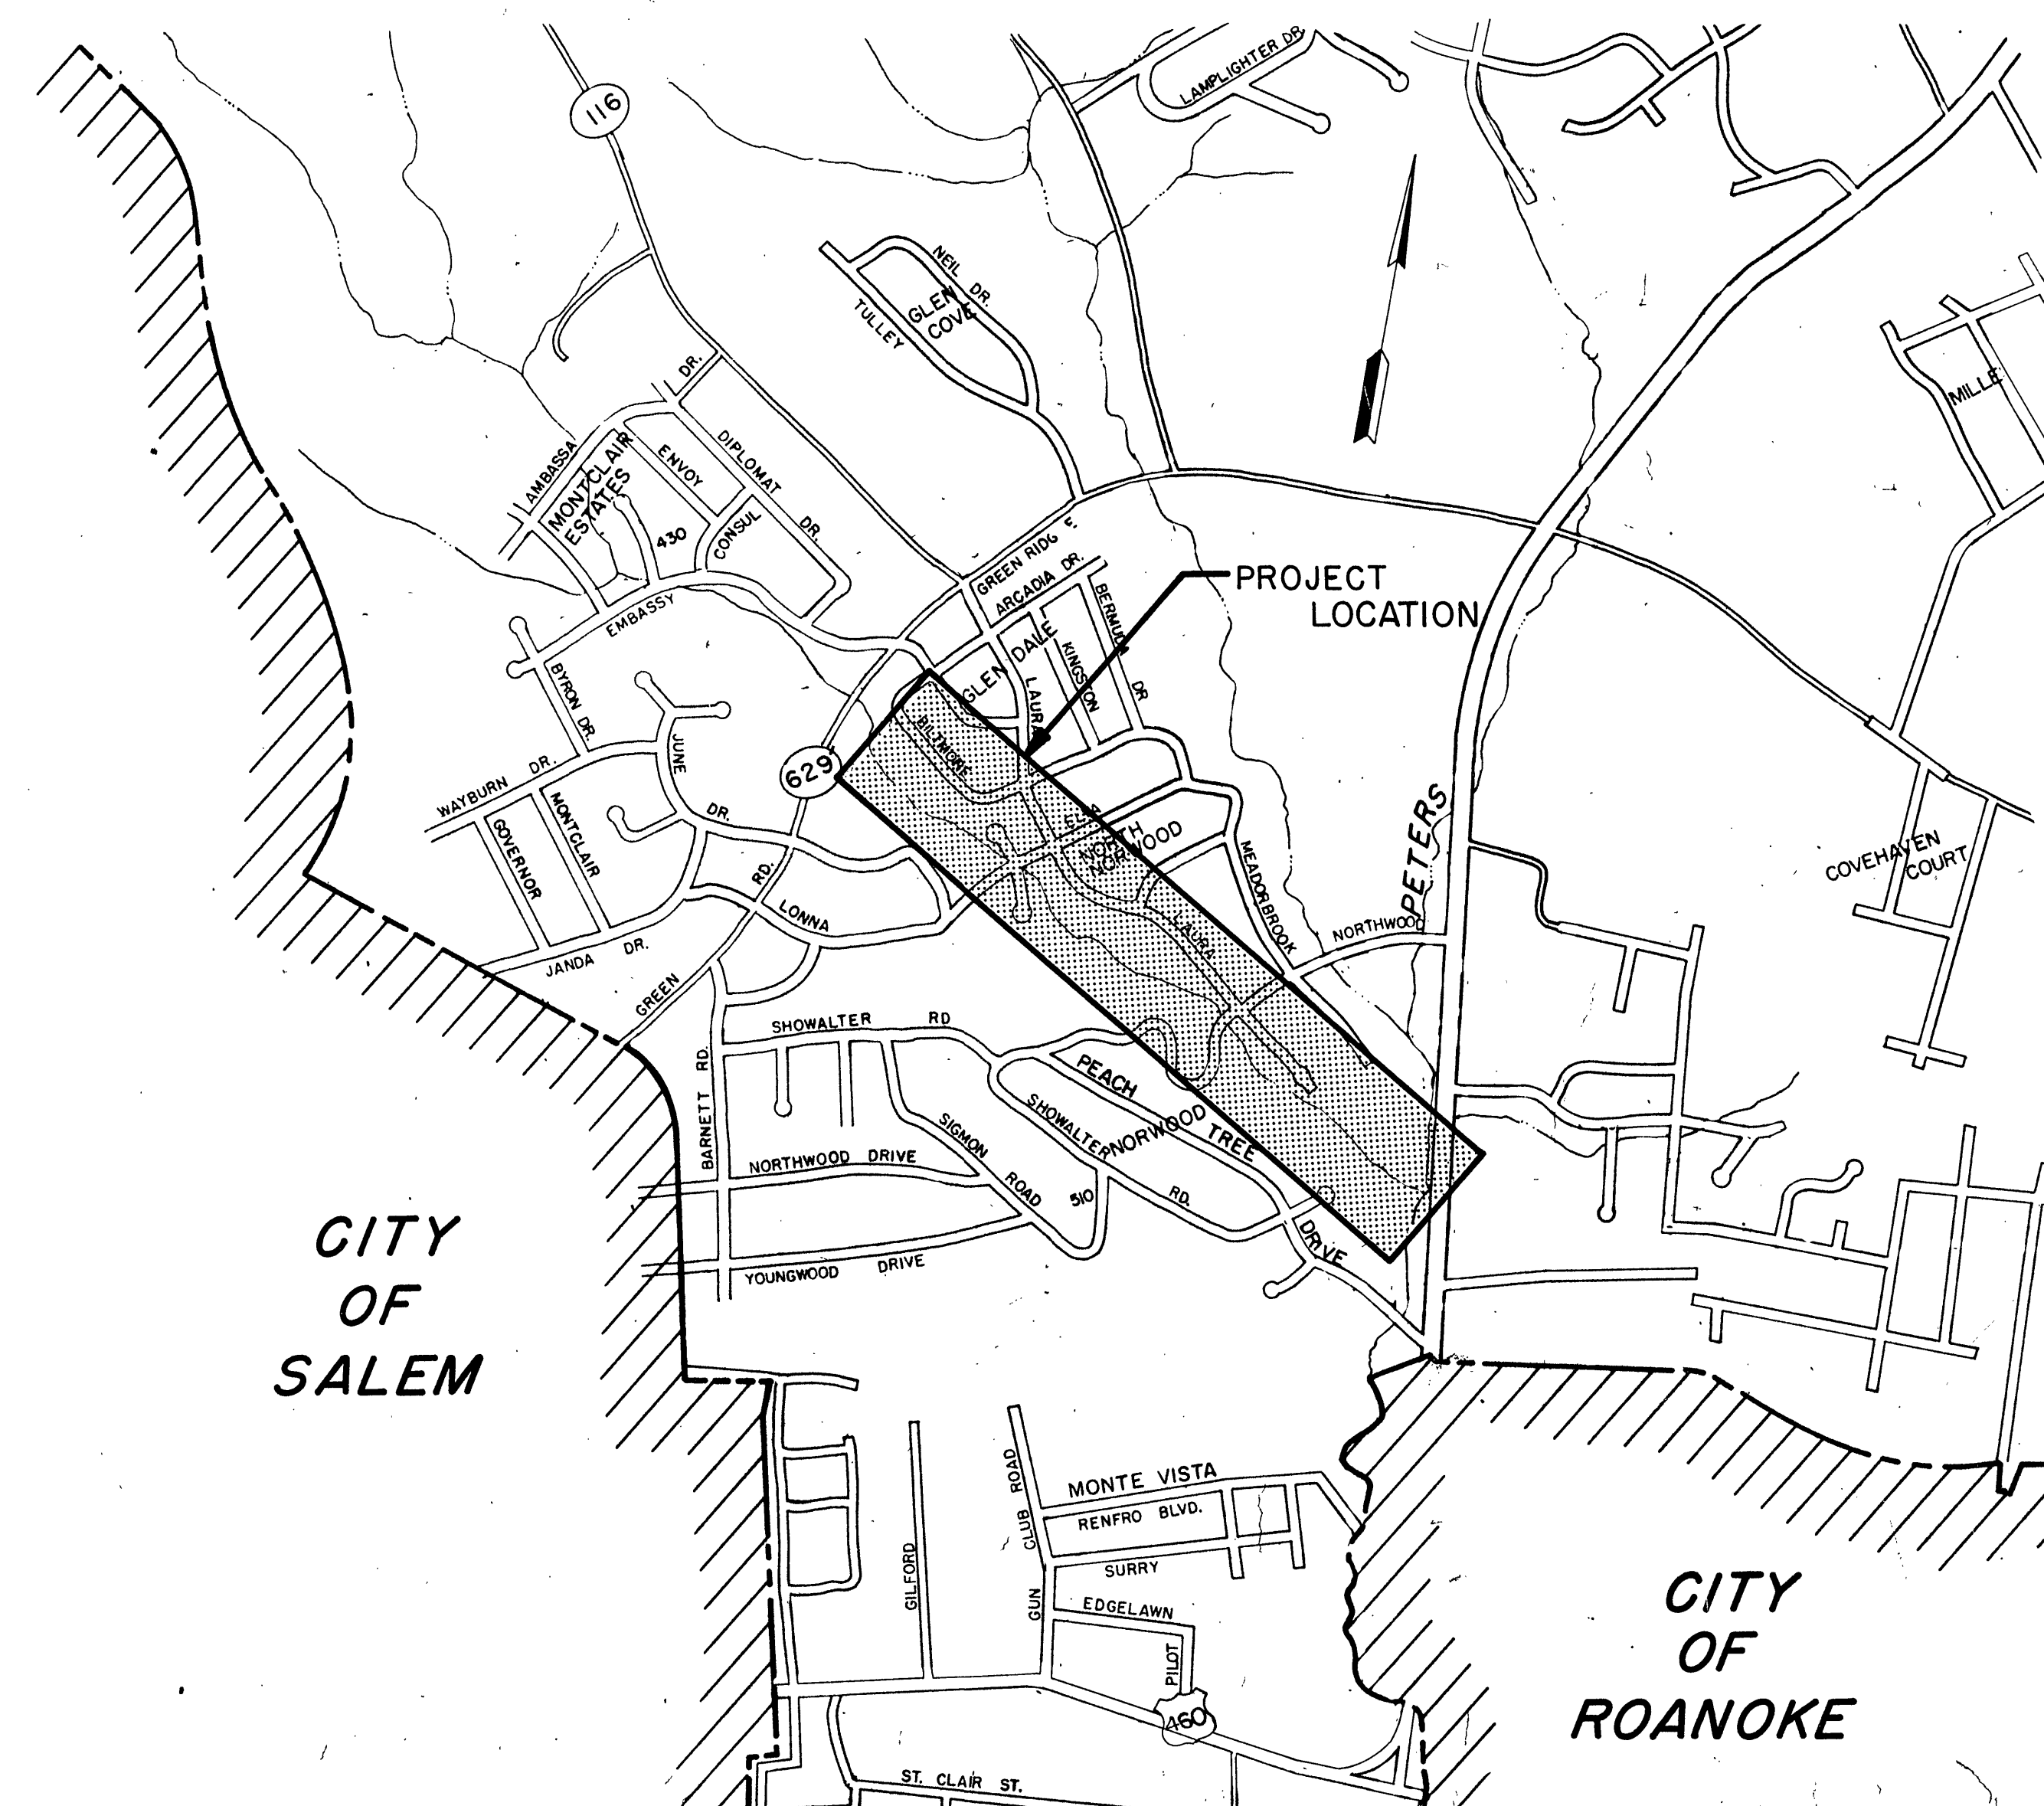


**PROJECT NO. 72-3-S**


J.A. BEAVERS                      EXECUTIVE DIRECTOR

[illegible]

-  SURVEY BASE LINE
-  PROPERTY LINE
-  RIGHT OF WAY LINE
-  EDGE OF PAVEMENT
-  EXISTING SANITARY SEWER
-  PROPOSED SANITARY SEWER
-  EXISTING MANHOLE
-  PROPOSED MANHOLE
-  PROPOSED CLEANOUT
-  PROPOSED METERING STATION
-  WATER MAIN
-  GAS LINE
-  ELECTRIC CABLE OR CONDUIT
-  TELEPHONE CABLE OR CONDUIT
-  RAILROAD TRACKS
-  DITCH
-  STREAM
-  FENCE
-  FIRE HYDRANT
-  POWER POLE
-  TELEPHONE POLE AND GUY WIRE
-  VALVE VAULT
-  WATER METER
-  TREE
-  SHRUB
-  HEDGE
-  ROCK OR STONE WALL
-  EXISTING GROUND

| SCHEDULE OF DRAWINGS |                     |               |
|----------------------|---------------------|---------------|
| SHEET                | TITLE               | STATION       |
| 1.                   | NORWOOD INTERCEPTOR | 0+47 - 13+00  |
| 2.                   | NORWOOD INTERCEPTOR | 13+00 - 28+00 |
| 3.                   | NORWOOD INTERCEPTOR | 28+00 - 39+87 |
| 4.                   | DETAILS             |               |

LANGLEY, McDONALD AND OVERMAN  
CONSULTING ENGINEERS  
NORFOLK, VIRGINIA

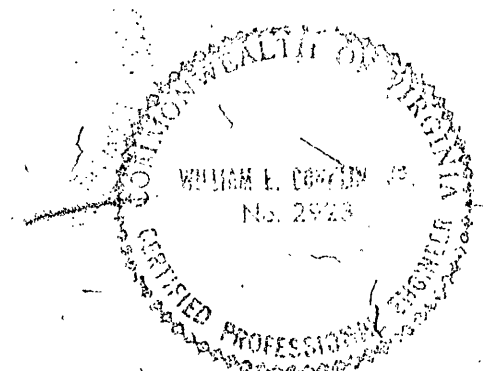

# AS BUILT