



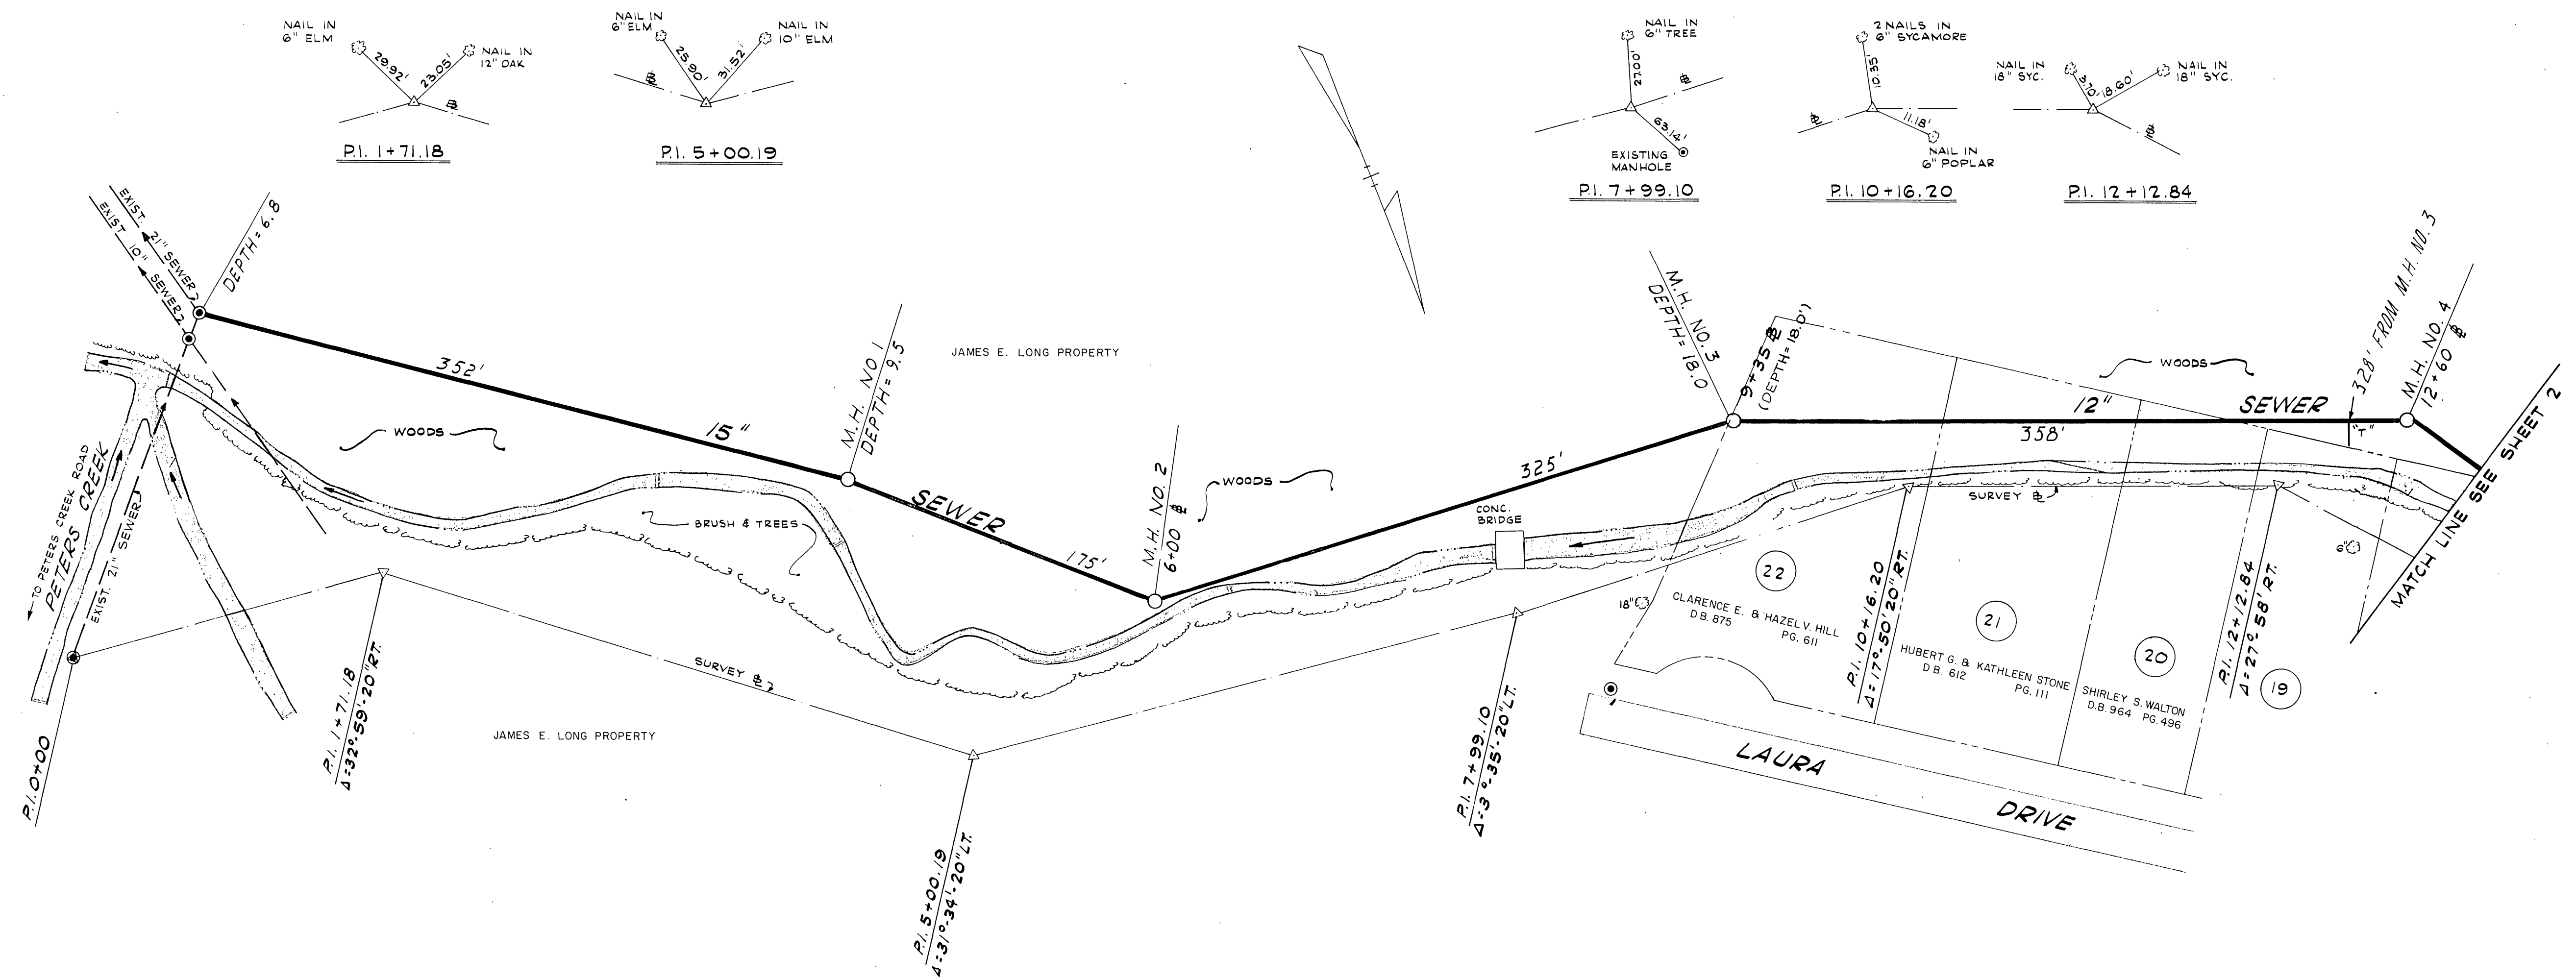

SCALE: 1 IN. = 50 FT.

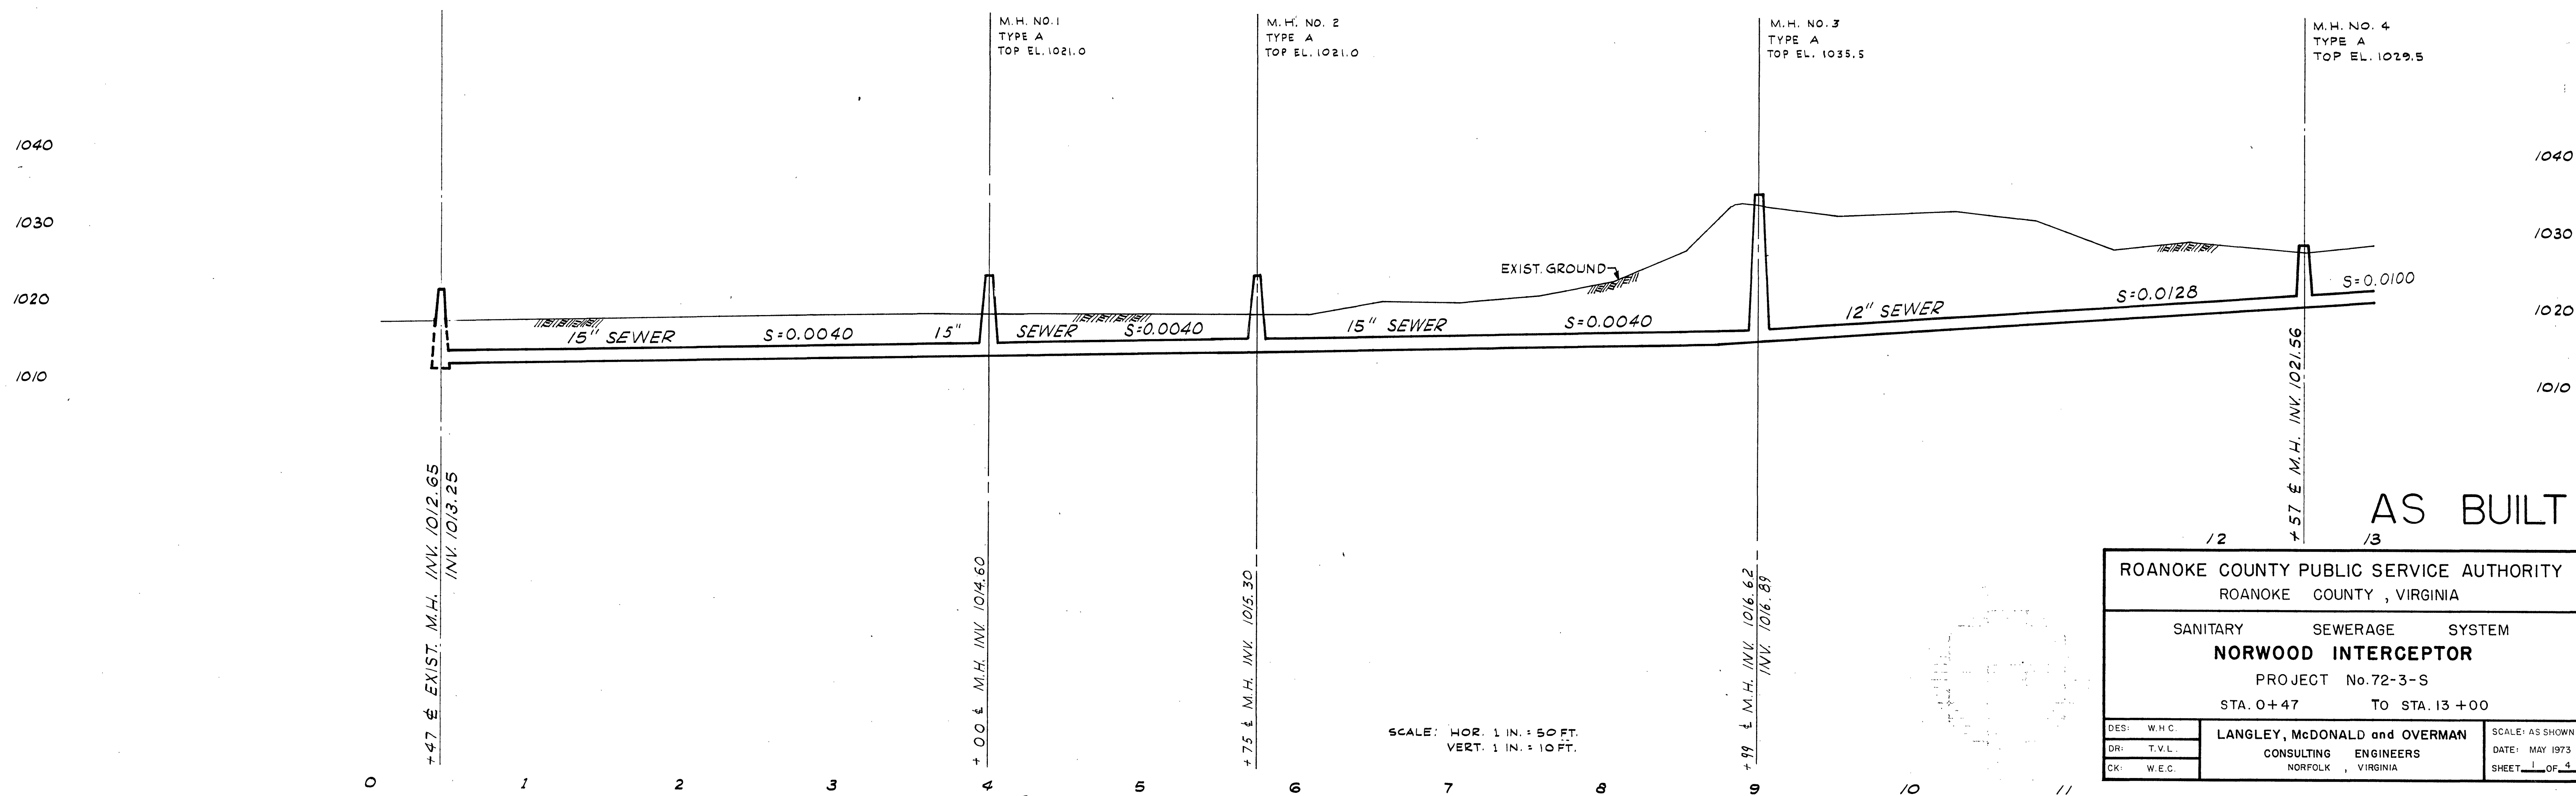

SCALE: HOR. 1 IN. = 50 FT.
VERT. 1 IN. = 10 FT.

AS BUILT

ROANOKE COUNTY PUBLIC SERVICE AUTHORITY ROANOKE COUNTY, VIRGINIA			
SANITARY SEWERAGE SYSTEM NORWOOD INTERCEPTOR			
PROJECT No. 72-3-S			
STA. 0+47 TO STA. 13+00			
DES: W.H.C.	LANGLEY, McDONALD and OVERMAN		SCALE: AS SHOWN
DR: T.V.L.	CONSULTING ENGINEERS		DATE: MAY 1973
CK: W.E.C.	NORFOLK, VIRGINIA		SHEET 1 OF 4