



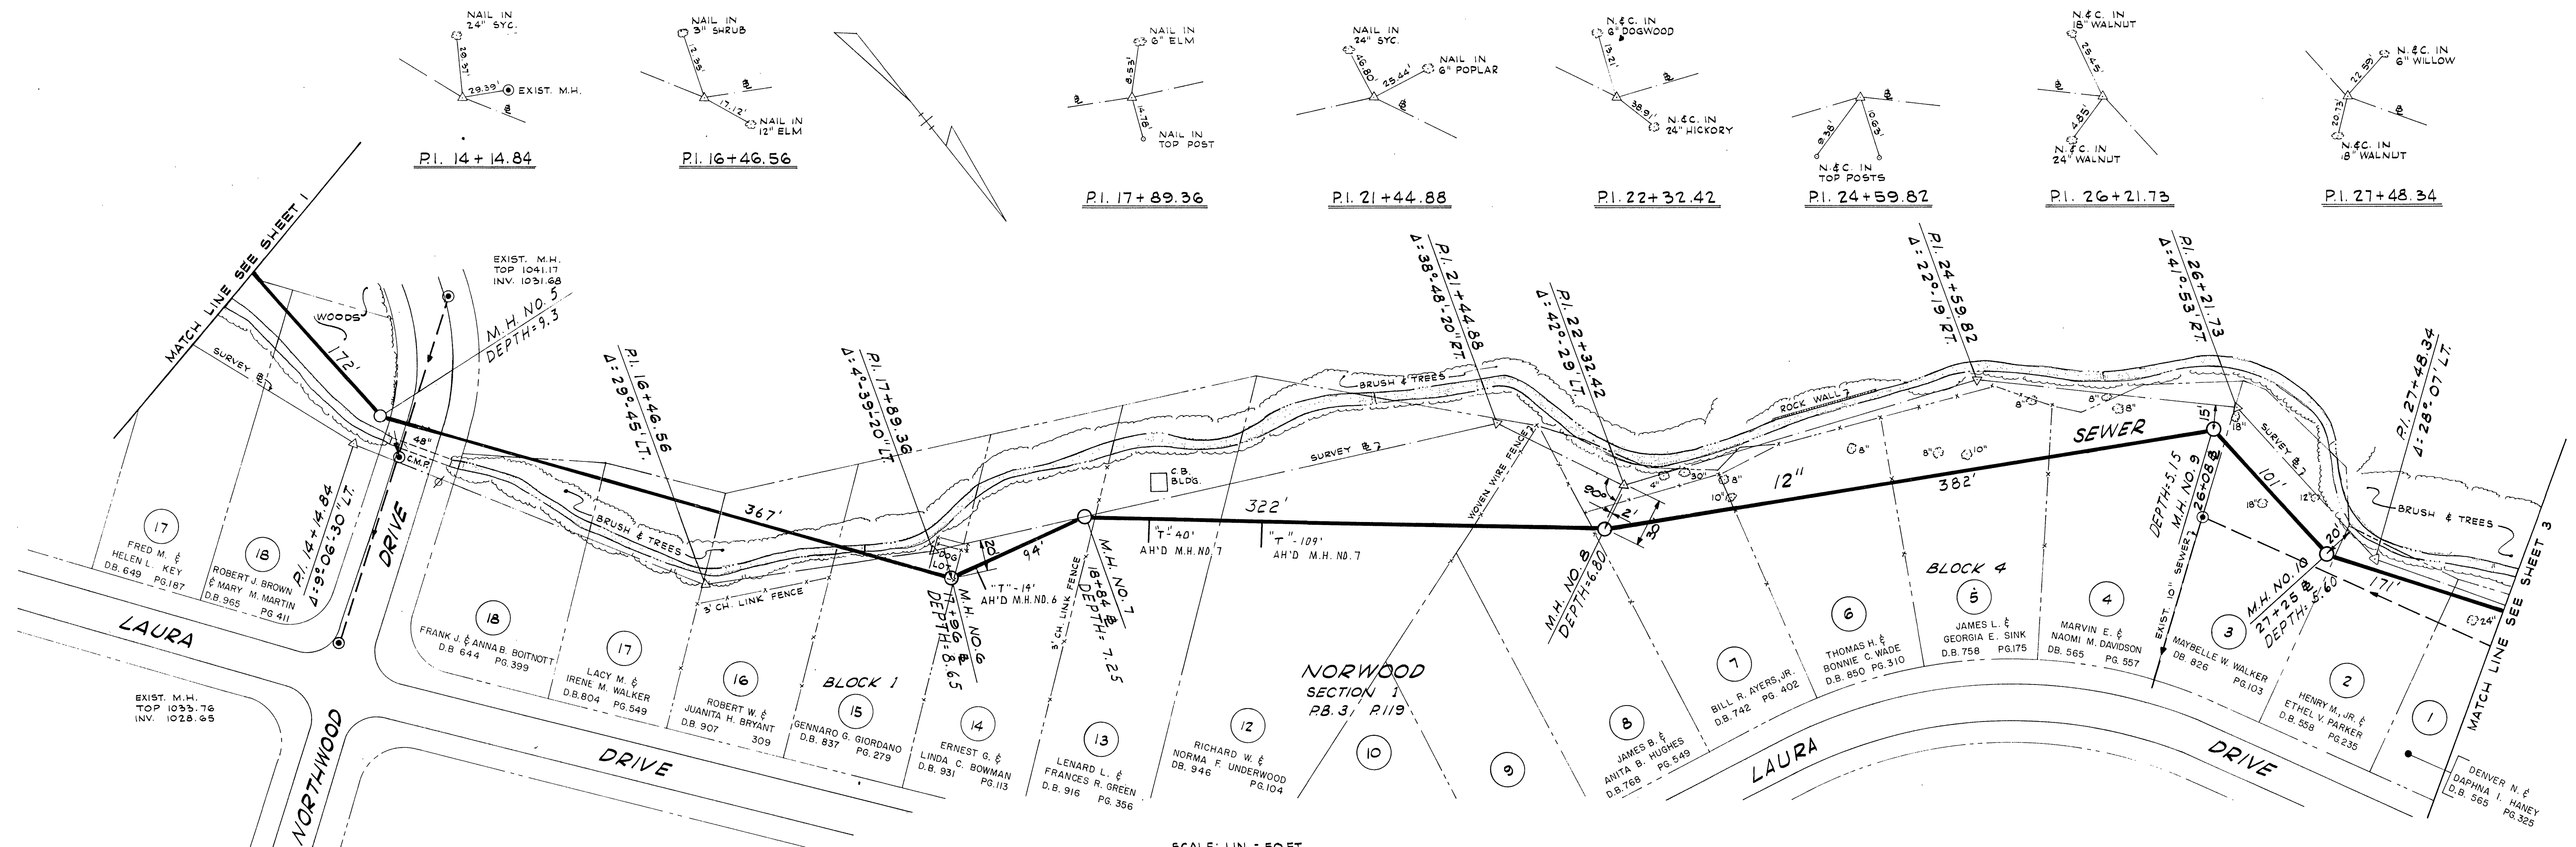

SCALE: 1 IN. = 50 FT.

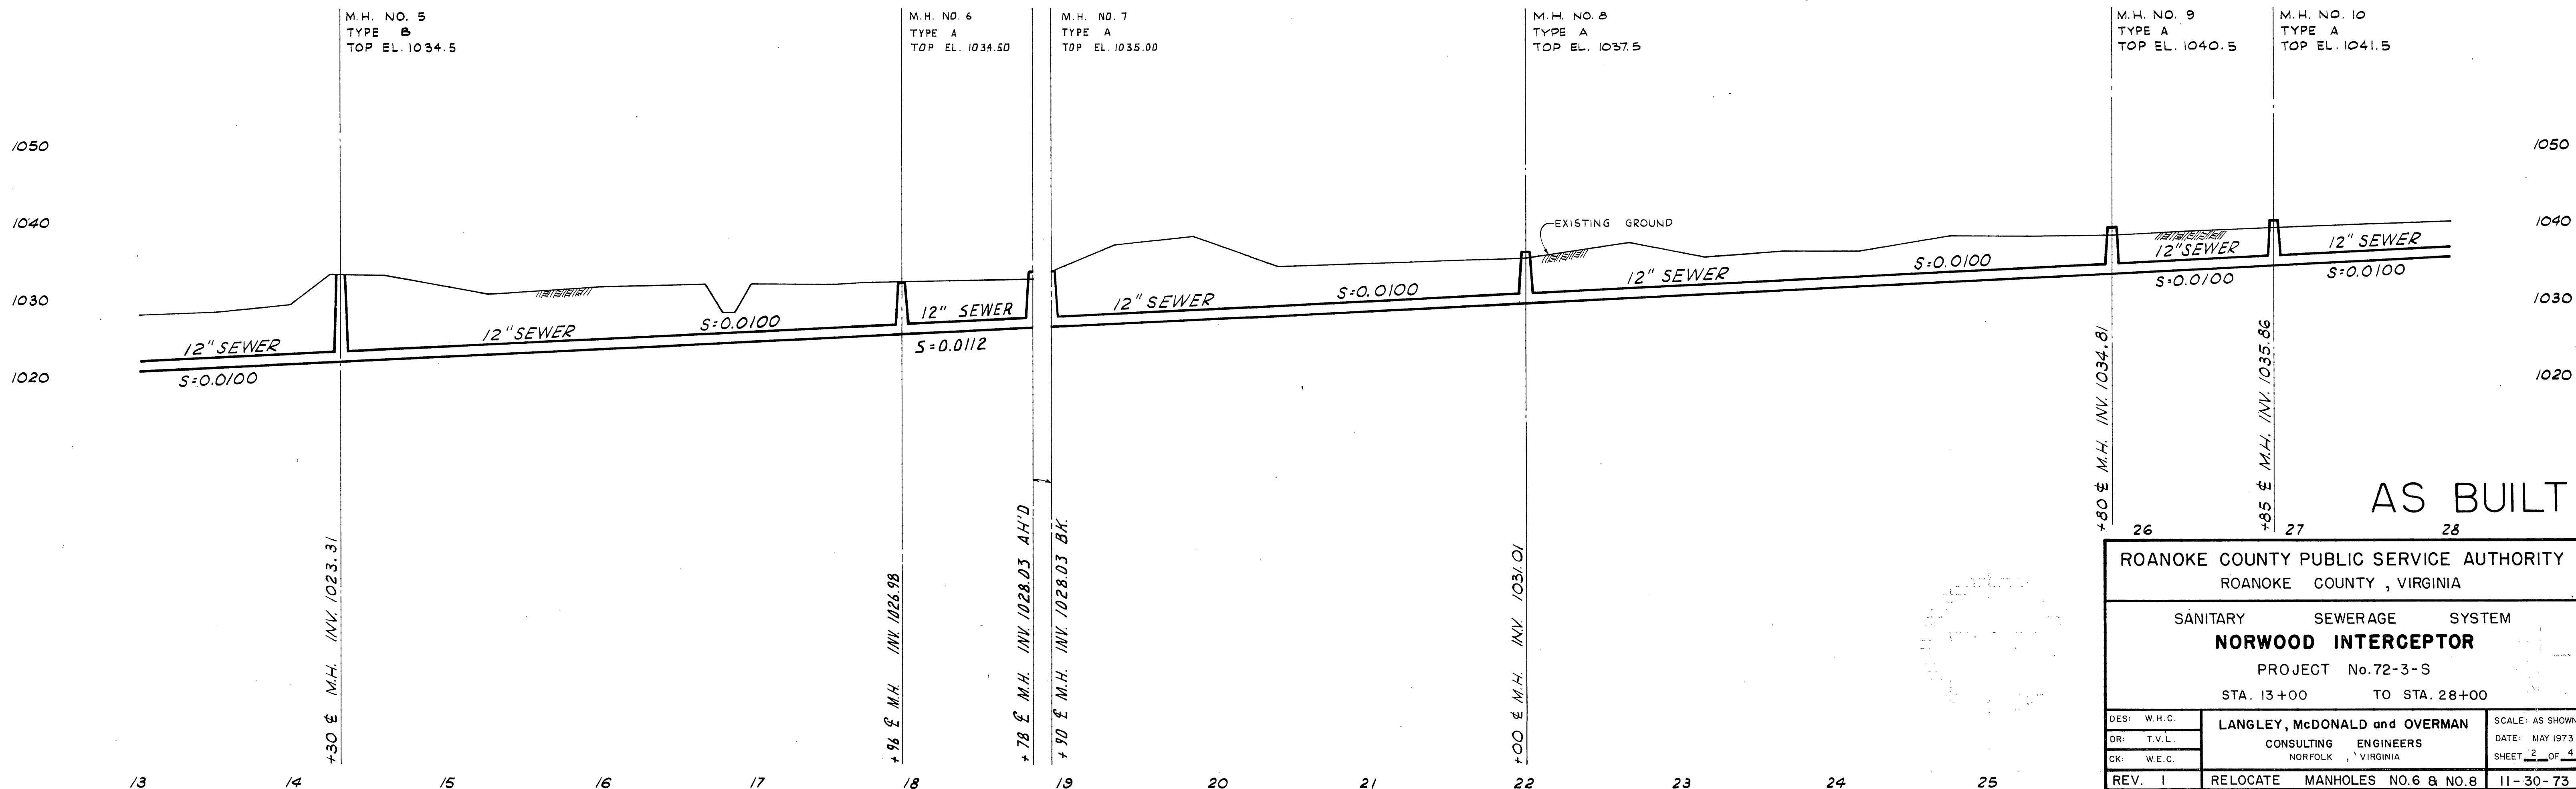

AS BUILT

| ROANOKE COUNTY PUBLIC SERVICE AUTHORITY |                                 |          |                 |
|-----------------------------------------|---------------------------------|----------|-----------------|
| ROANOKE COUNTY, VIRGINIA                |                                 |          |                 |
| SANITARY SEWERAGE SYSTEM                |                                 |          |                 |
| NORWOOD INTERCEPTOR                     |                                 |          |                 |
| PROJECT No. 72-3-S                      |                                 |          |                 |
| STA. 13+00 TO STA. 28+00                |                                 |          |                 |
| DES: W.H.C.                             | LANGLEY, McDONALD and OVERMAN   |          | SCALE: AS SHOWN |
| DR: T.V.L.                              | CONSULTING ENGINEERS            |          | DATE: MAY 1973  |
| CK: W.E.C.                              | NORFOLK, VIRGINIA               |          | SHEET 2 OF 4    |
| REV. 1                                  | RELOCATE MANHOLES NO. 6 & NO. 8 | 11-30-73 |                 |