


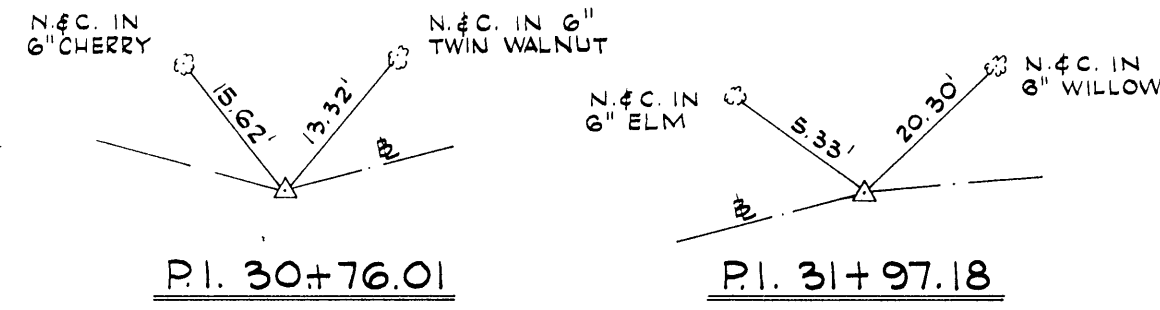


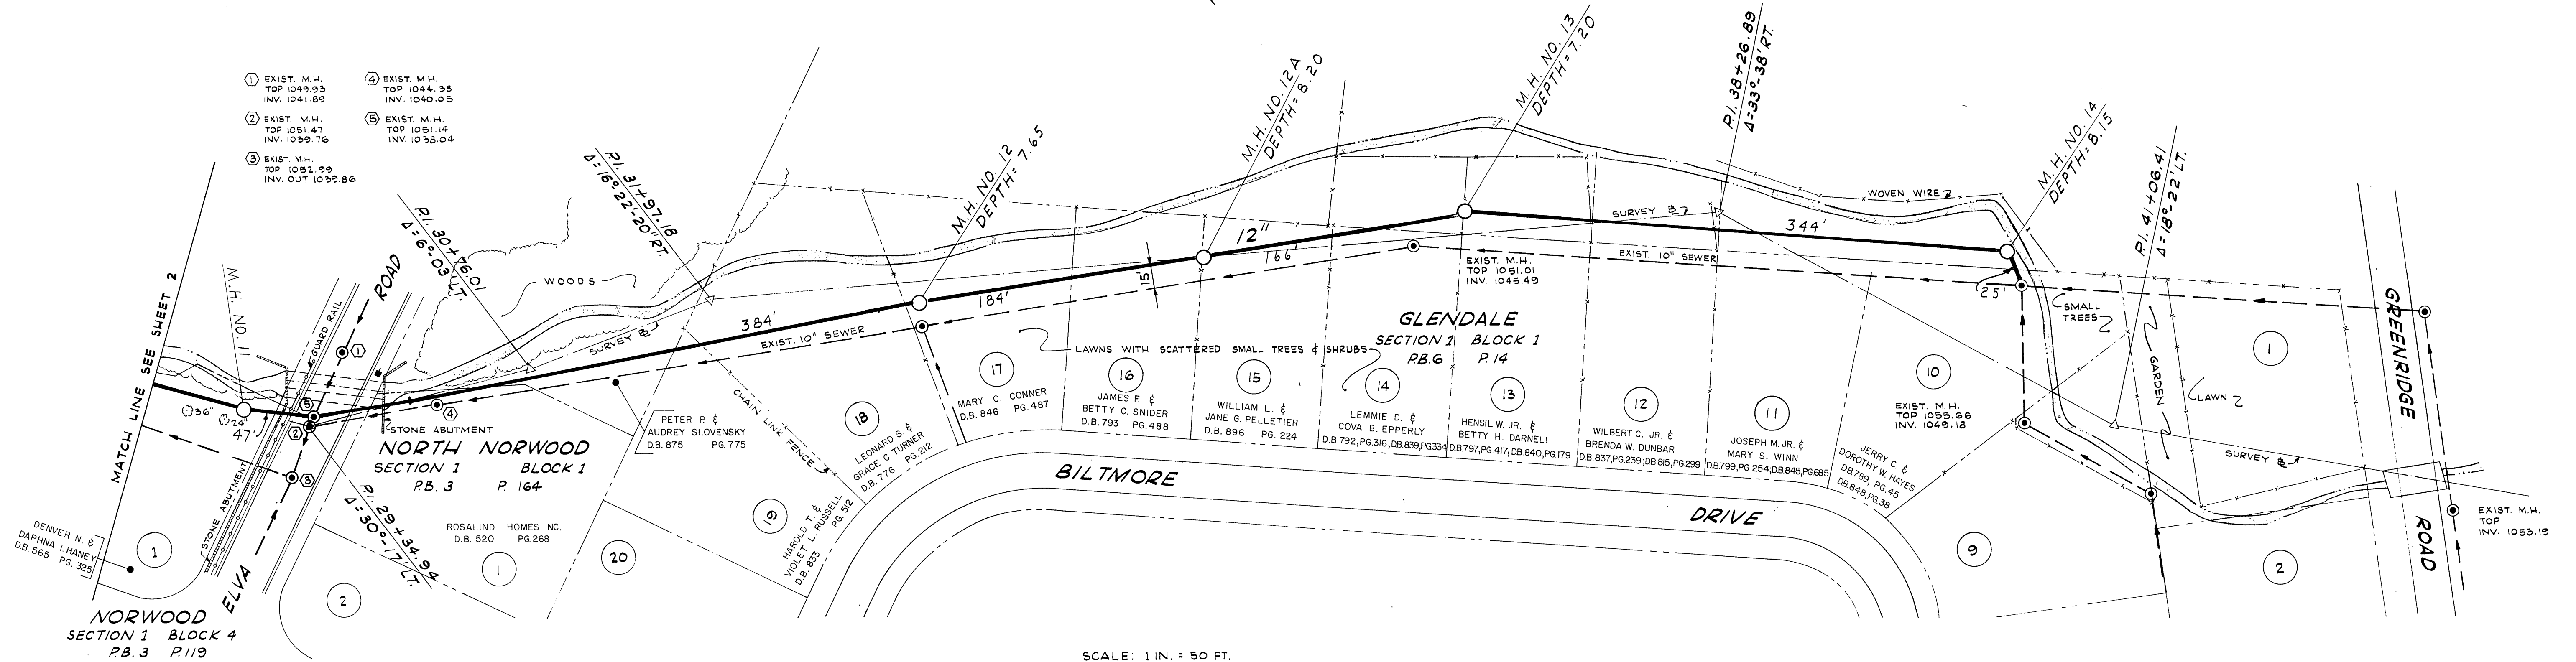

NOTE:
CONTRACTOR SHALL CONFIRM
INVERT ELEVATION OF EXIST.
12\"/>

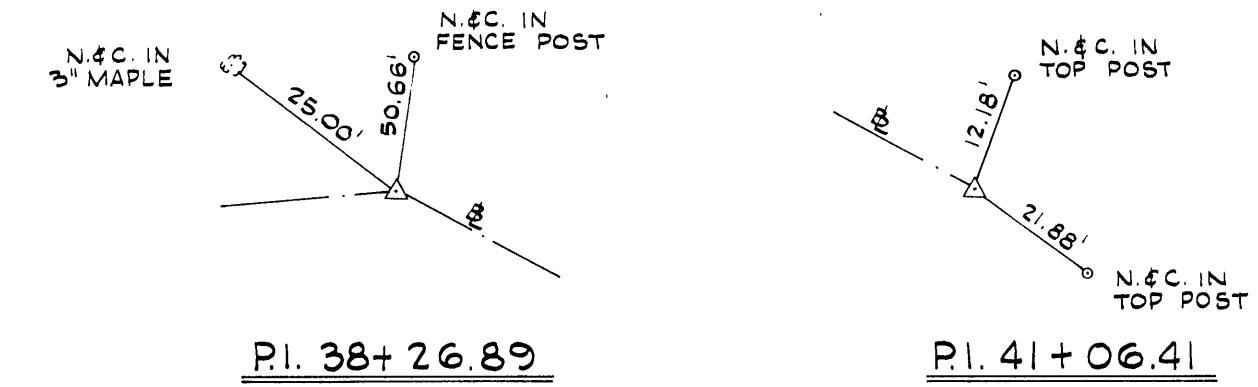

SCALE: 1 IN. = 50 FT.

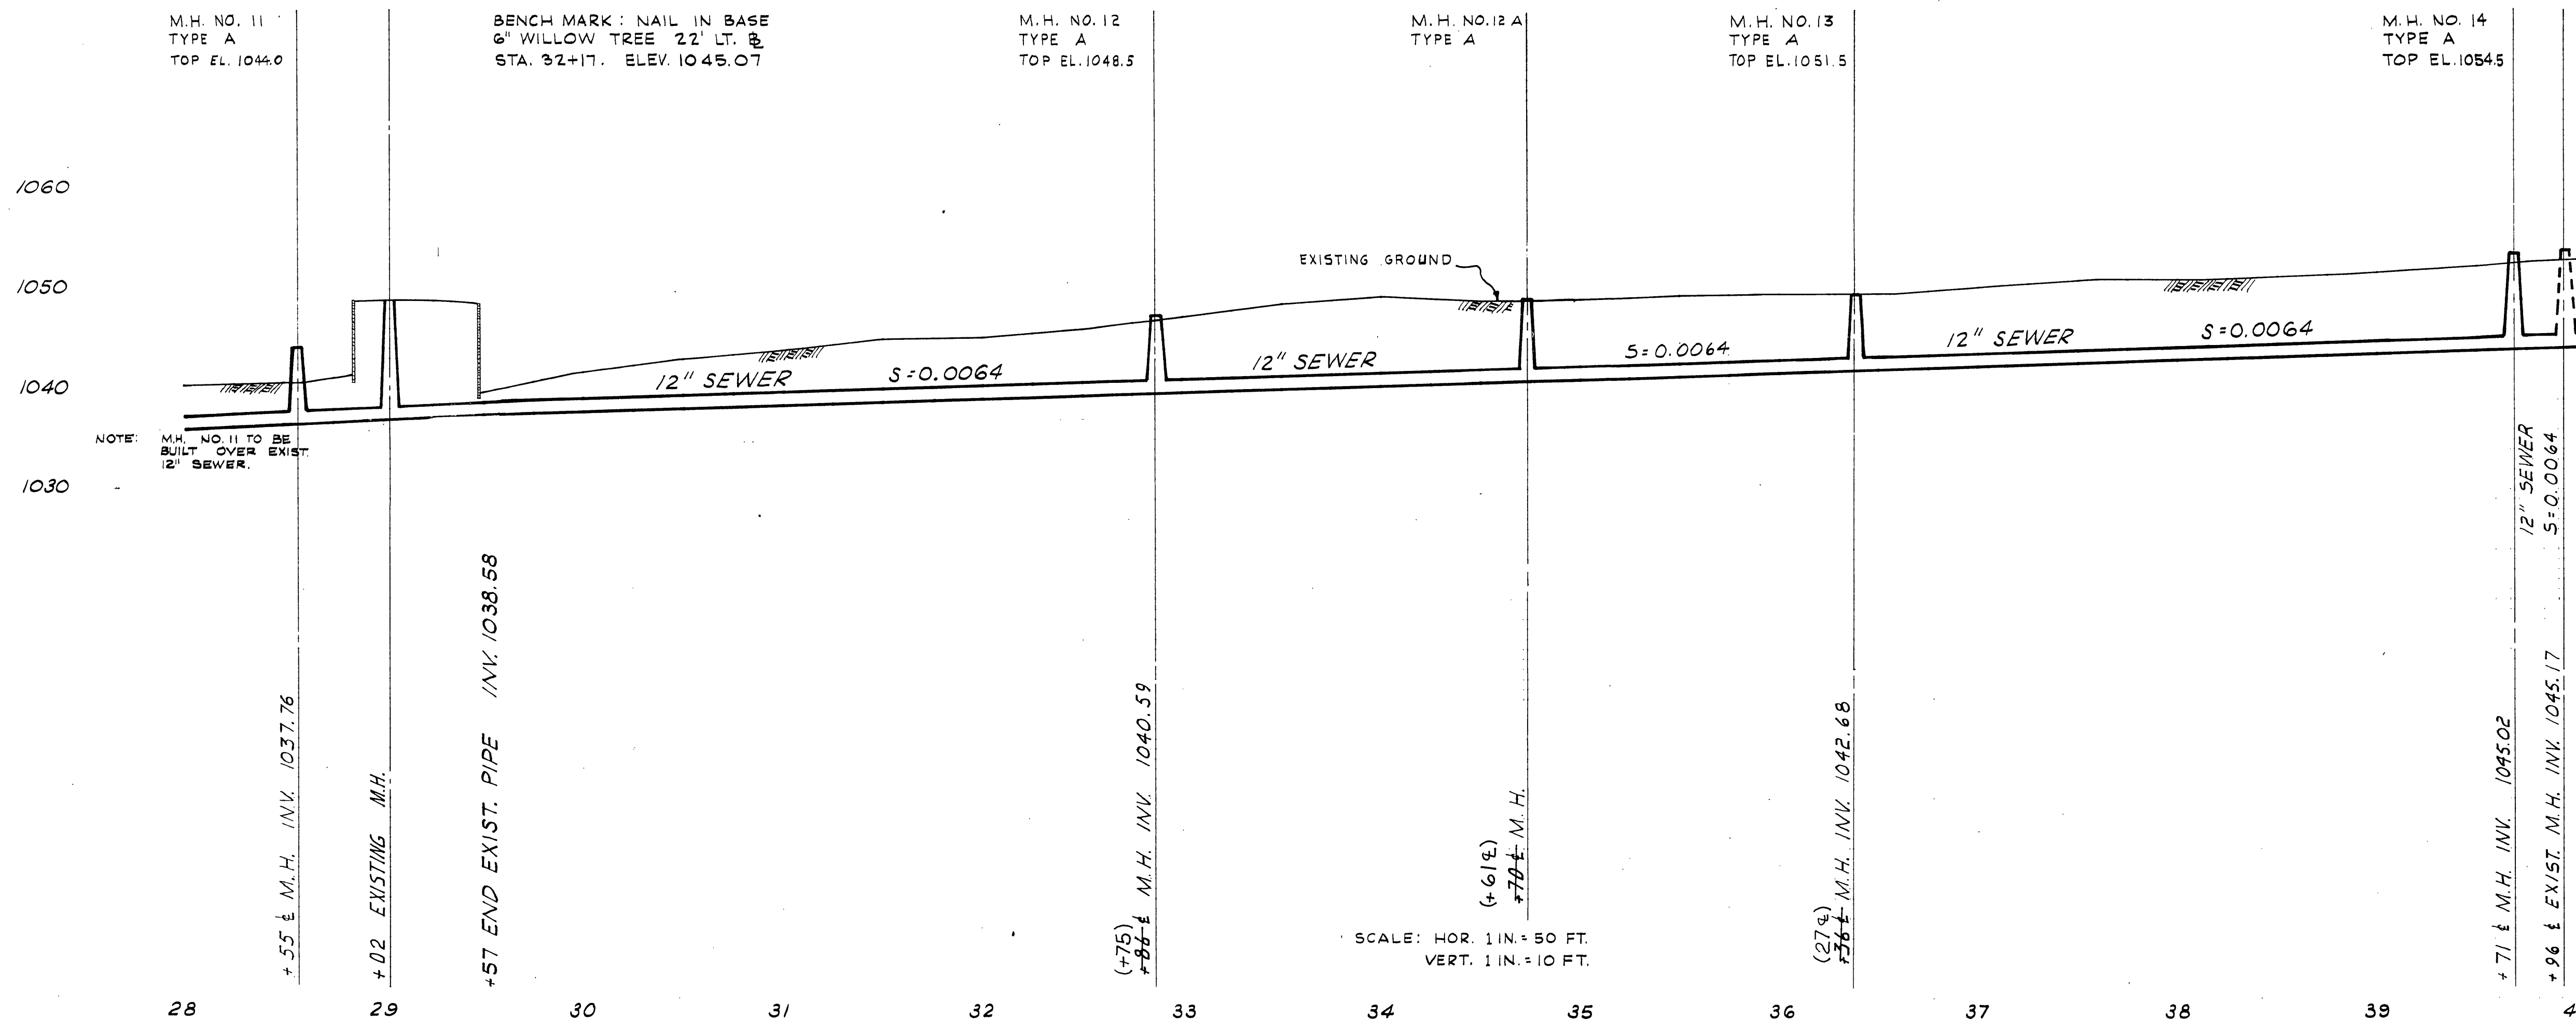

AS BUILT

ROANOKE COUNTY PUBLIC SERVICE AUTHORITY ROANOKE COUNTY , VIRGINIA			
SANITARY		SEWERAGE SYSTEM	
NORWOOD INTERCEPTOR			
PROJECT No. 72-3-S			
STA. 28+00		TO STA. 39+87	
DES: W.H.C.	LANGLEY, McDONALD and OVERMAN		SCALE: AS SHOWN
DR: T.V.L.	CONSULTING ENGINEERS		DATE: MAY 1973
CK: W.E.C.	NORFOLK , VIRGINIA		SHEET 3 OF 4