


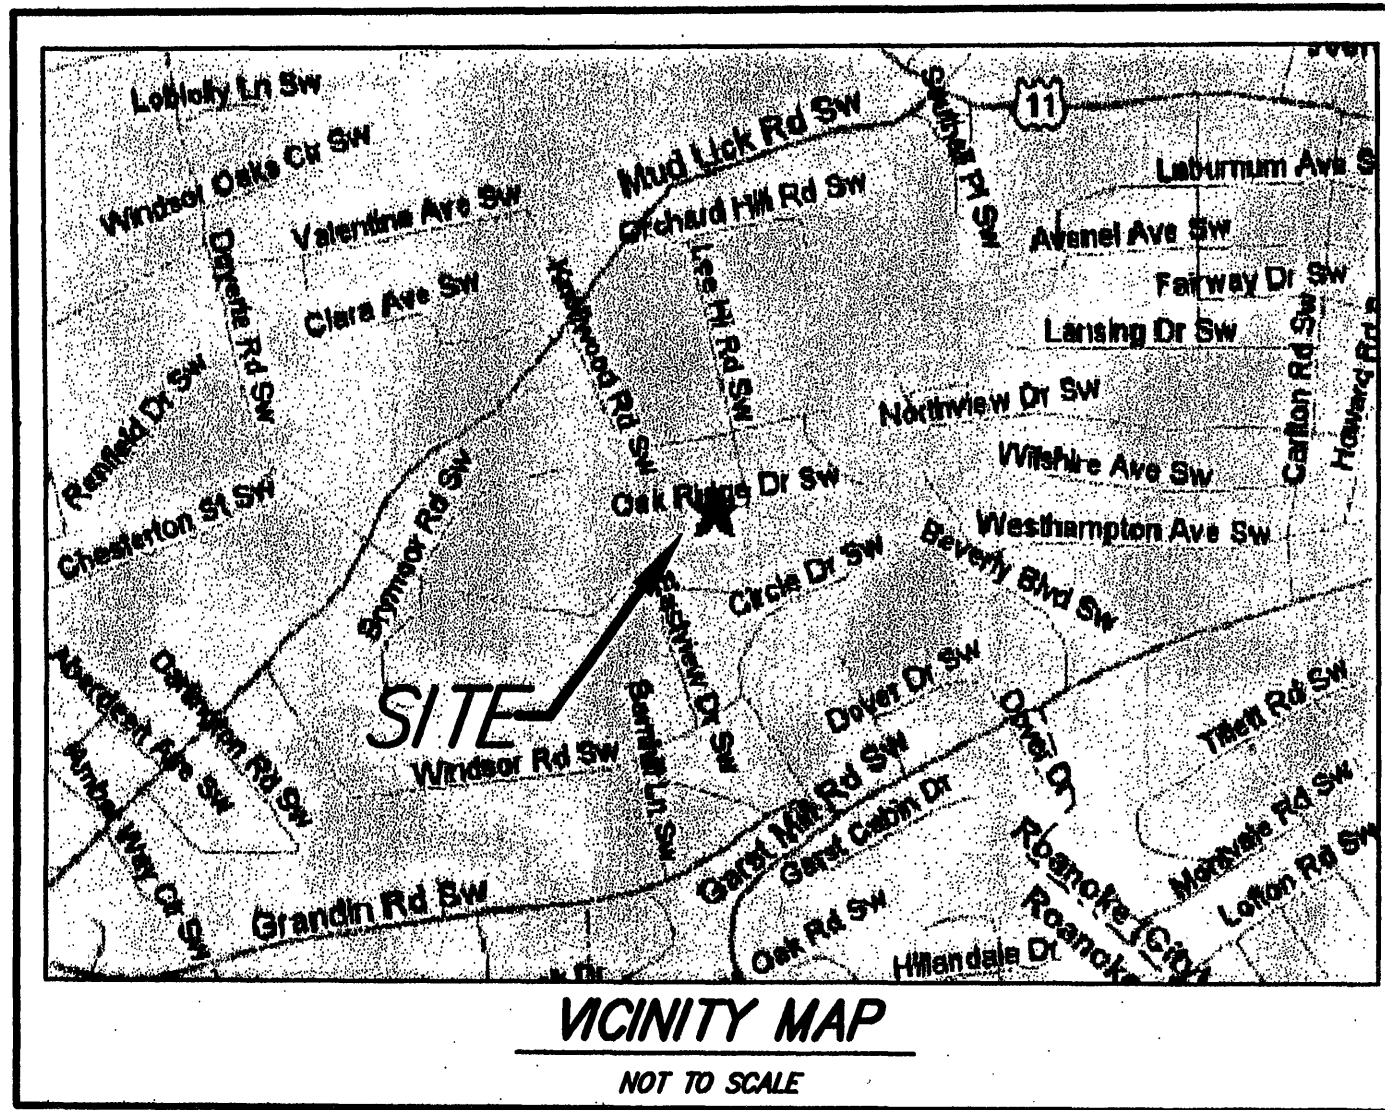

DATE: 12/21/05

REVISIONS
 △
 △
 △

**PIERSON
 ENGINEERING
 &
 SURVEYING**


P.O. BOX 311
 1324 ROANOKE ROAD
 DALEVILLE, VA 24083

(540) 966-3027 TEL
 (540) 966-5906 FAX
 e-mail: rpierson@earthlink.net

**NEW SANITARY SEWER EXTENSION
 FOR
 3231 OAK RIDGE ROAD, SW
 ROANOKE CITY, VIRGINIA**


**SANITARY
 SEWER PLAN &
 PROFILE**

AS BUILT
 03/02/2007

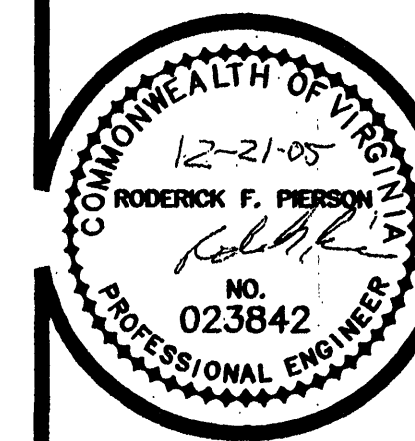

COMMISSION
 R200548
 SHEET
 1


WWW.ID#6VJNH

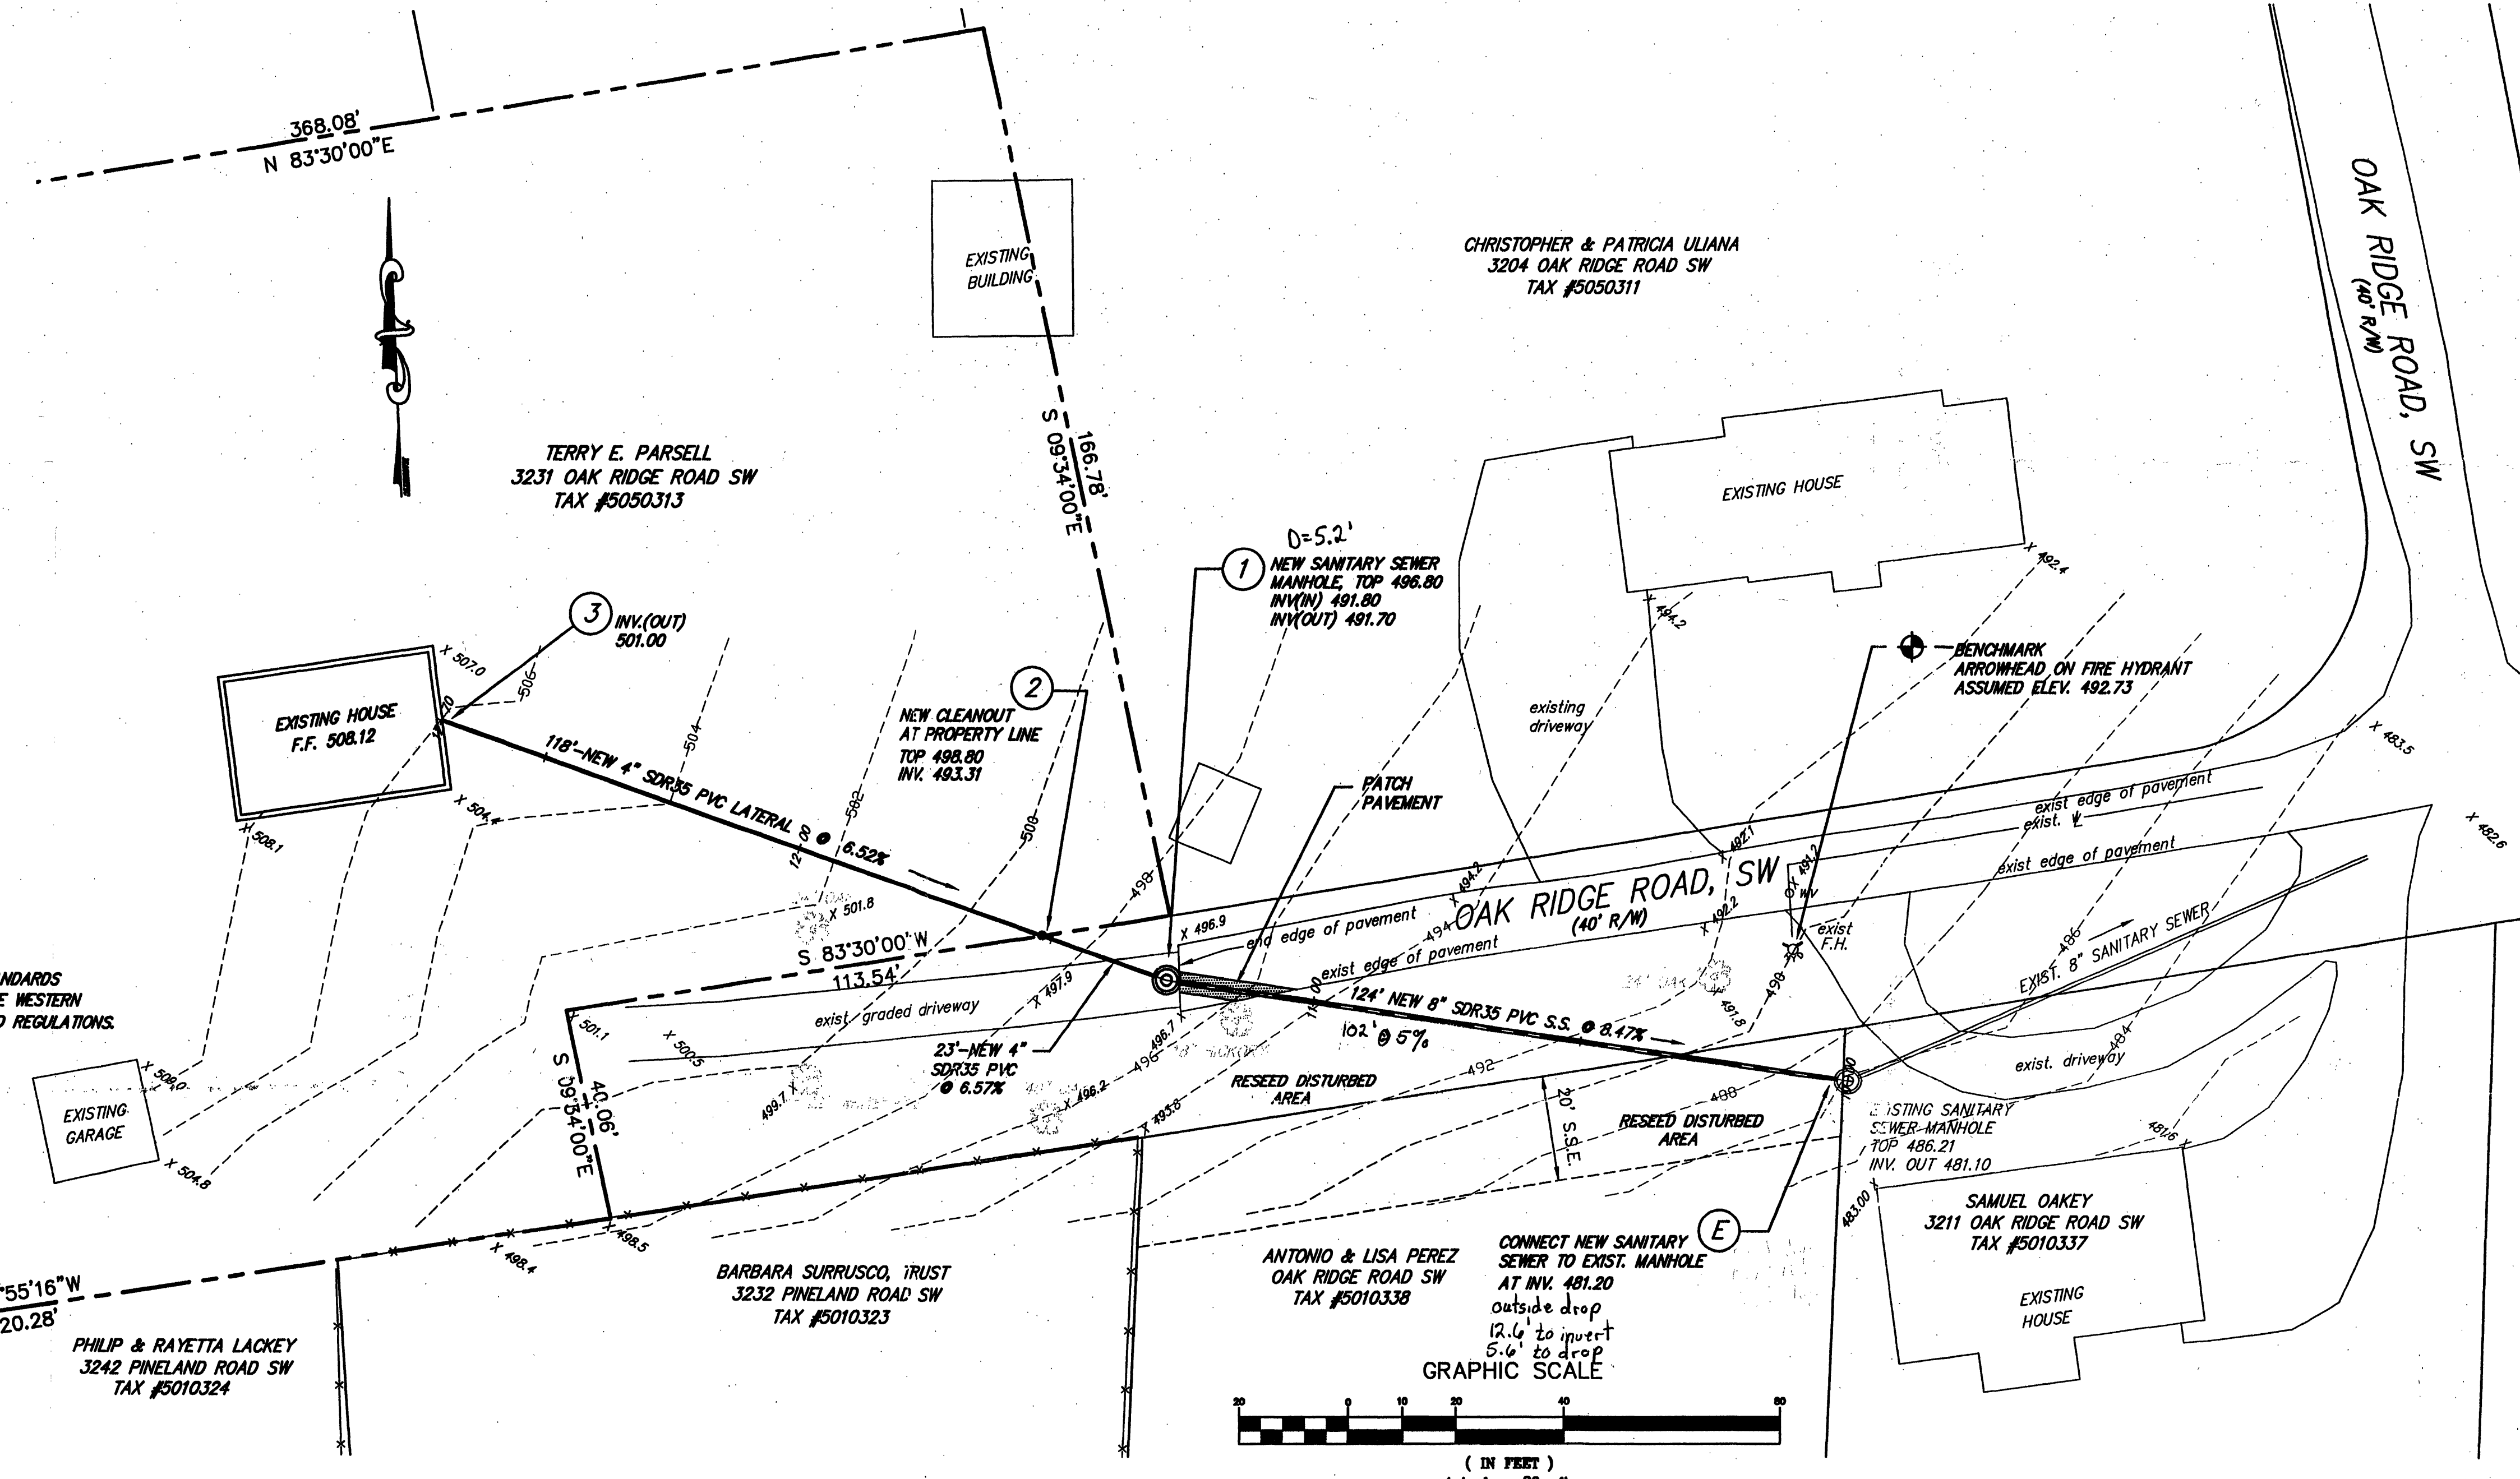

ALL UNDERGROUND UTILITIES ARE TO BE CLEARLY
 MARKED BY MISS UTILITY PRIOR TO BEGINNING CONST.
 ANY POTENTIAL CONFLICTS AS A RESULT OF THE
 MARKINGS SHALL BE MADE KNOWN TO THE ARCHITECT.

SEWER LINES SHALL BE CONSTRUCTED IN ACCORDANCE WITH STANDARDS
 AND REGULATIONS AS SET FORTH IN THE LATEST EDITION OF THE WESTERN
 VIRGINIA WATER AUTHORITY, WATER AND WASTEWATER RULES AND REGULATIONS.

INSTALLATION OF THE 4" LATERAL FROM THE NEW CLEANOUT
 TO THE HOUSE WILL BE THE RESPONSIBILITY OF THE OWNER.

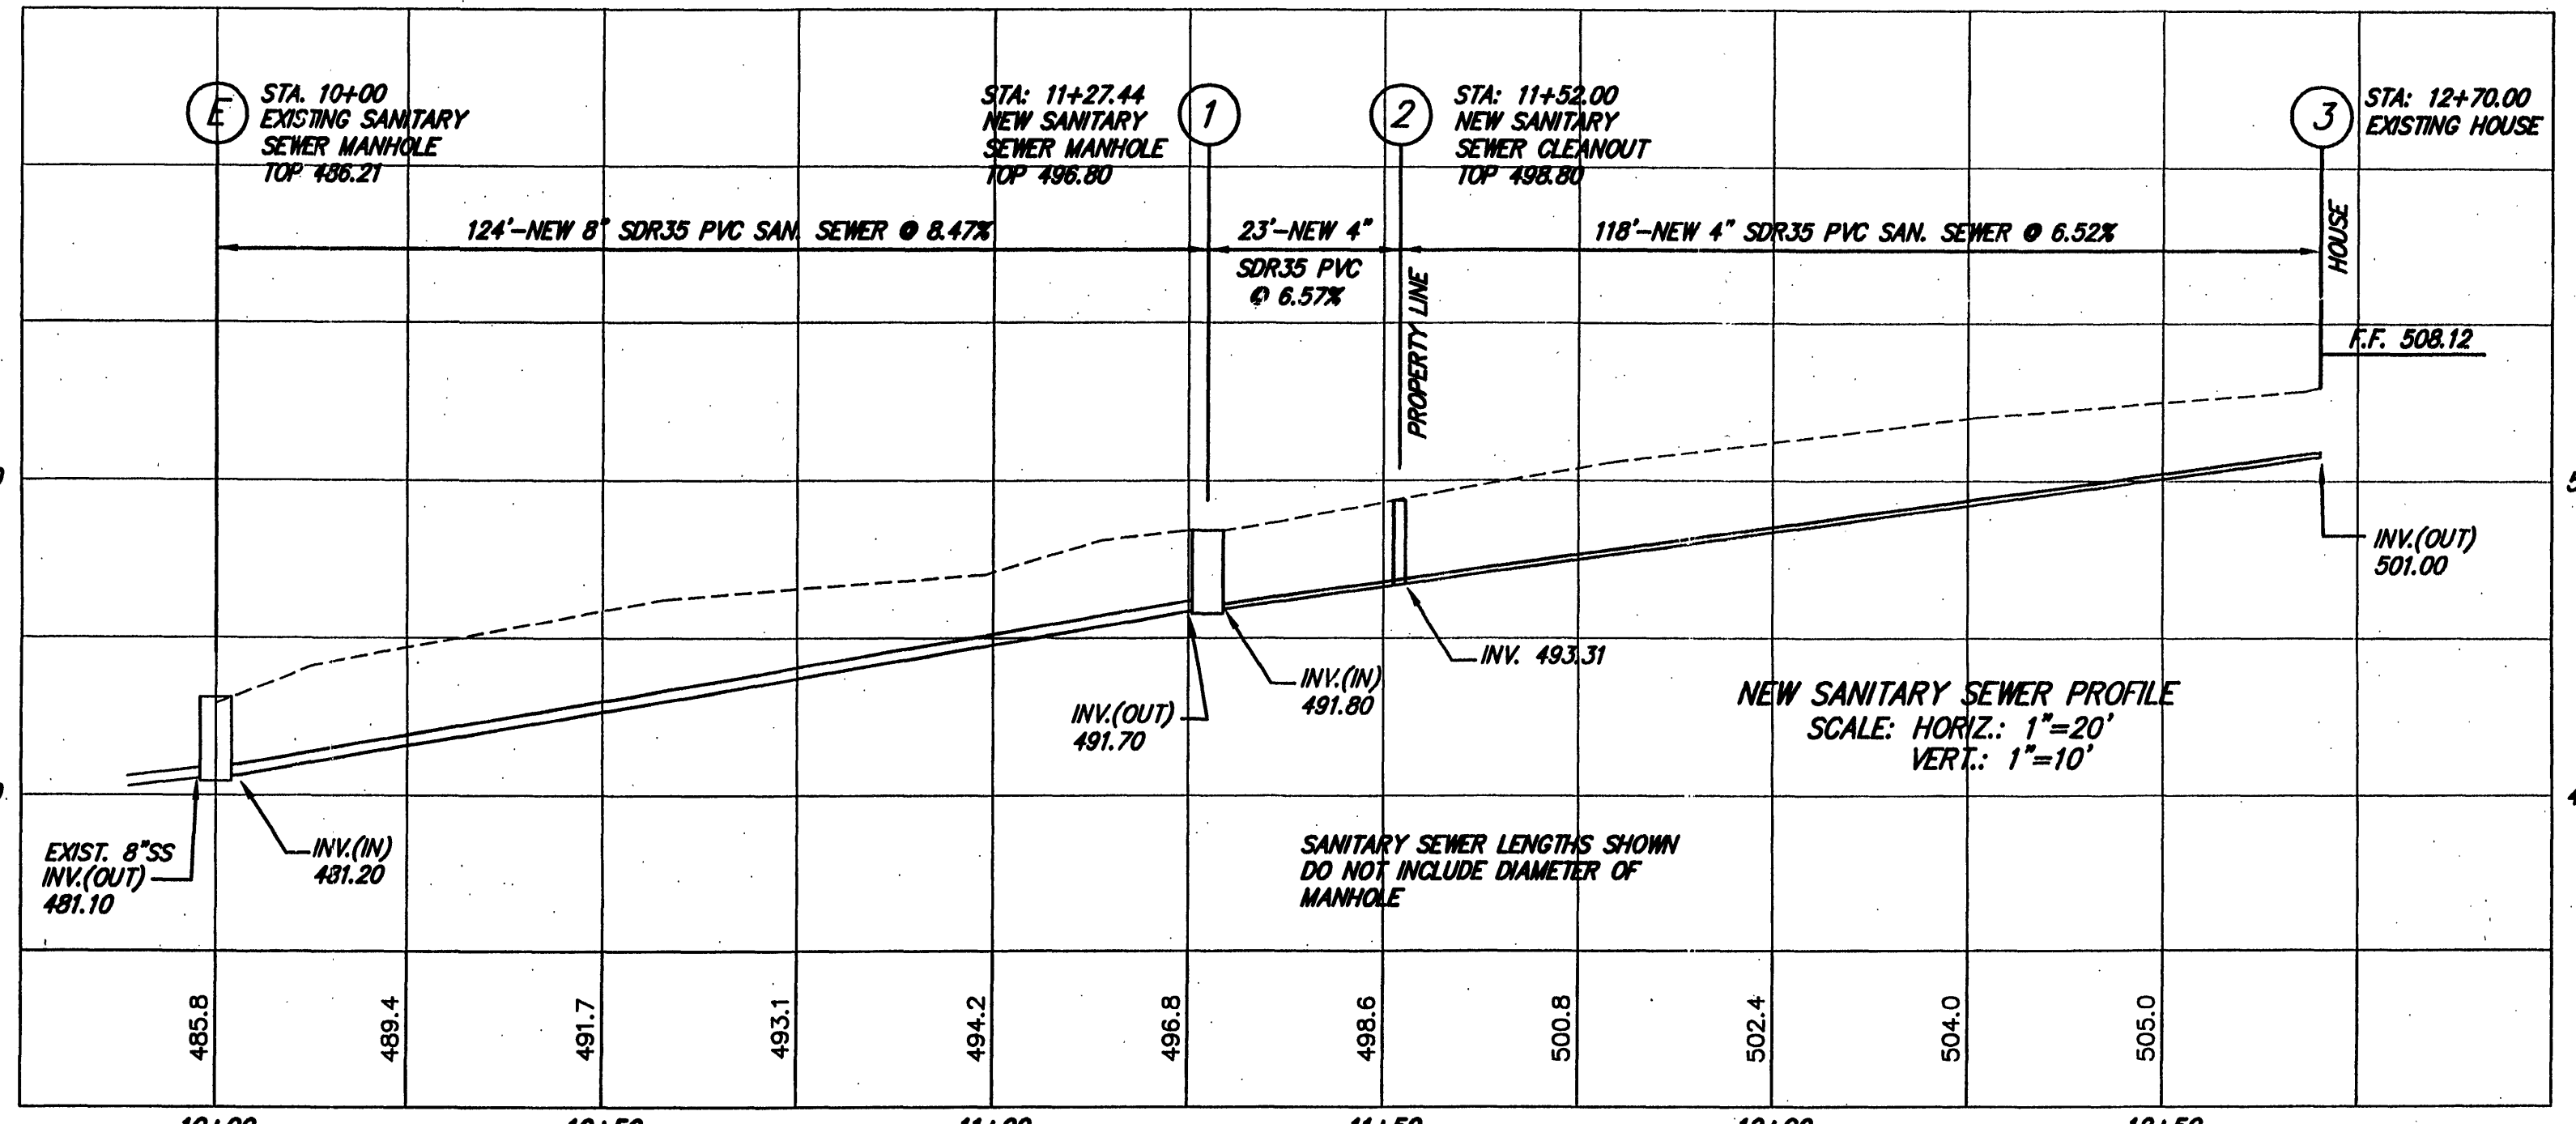

RECEIVED

JAN 23 2006

CITY OF ROANOKE
 PLANNING BUILDING AND DEVELOPMENT