



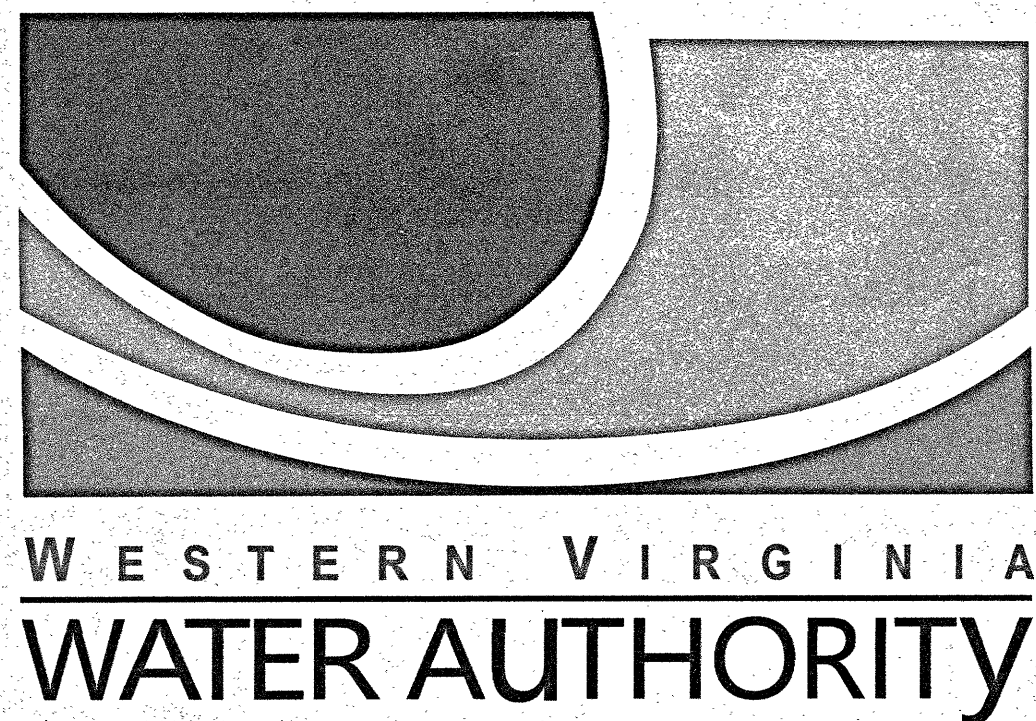

LOCATION MAP
NO SCALE

WESTERN VIRGINIA WATER AUTHORITY OAKLAND III WATER MAIN REPLACEMENT


DRAWING TITLE	SHEET NUMBER
COVER	1
NOTES & PROPOSED LEGEND	2
SURVEY SCHEDULES, NOTES, & EXISTING LEGEND	3
SHEET LAYOUT & FIRE HYDRANT COVERAGE MAP	4
12" D.I. WATER MAIN PLAN - PROFILE, STA. 10+00 TO STA. 14+75	5
12" D.I. WATER MAIN PLAN - PROFILE, STA. 14+75 TO STA. 19+25	6
12" D.I. WATER MAIN PLAN - PROFILE, STA. 19+25 TO STA. 24+25	7
12" D.I. WATER MAIN PLAN - PROFILE, STA. 24+25 TO STA. 29+32	8
8" D.I. WATER MAIN PLAN - PROFILE, STA. 30+00 TO STA. 33+32	9
8" D.I. WATER MAIN PLAN - PROFILE, STA. 40+00 TO STA. 43+75	10
8" D.I. WATER MAIN PLAN - PROFILE, STA. 43+75 TO STA. 47+50	11
8" D.I. WATER MAIN PLAN - PROFILE, STA. 47+50 TO STA. 53+00	12
8" D.I. WATER MAIN PLAN - PROFILE, STA. 53+00 TO STA. 57+75	13
8" D.I. WATER MAIN PLAN - PROFILE, STA. 57+75 TO STA. 61+08	14
8" D.I. WATER MAIN PLAN - PROFILE, STA. 70+00 TO STA. 73+19	15
8" D.I. WATER MAIN PLAN - PROFILE, STA. 73+19 TO STA. 75+75	16
8" D.I. WATER MAIN PLAN - PROFILE, STA. 80+00 TO STA. 84+75	17
8" D.I. WATER MAIN PLAN - PROFILE, STA. 84+75 TO STA. 89+25	18
8" D.I. WATER MAIN PLAN - PROFILE, STA. 89+25 TO STA. 91+38	19
8" D.I. WATER MAIN PLAN - PROFILE, STA. 100+00 TO STA. 104+50	20
8" D.I. WATER MAIN PLAN - PROFILE, STA. 104+50 TO STA. 108+28	21
8" D.I. WATER MAIN PLAN - PROFILE, STA. 110+00 TO STA. 113+00	22
8" D.I. WATER MAIN PLAN - PROFILE, STA. 113+00 TO STA. 116+26	23
TEMPORARY TRAFFIC CONTROL PLAN NOTES	24
TEMPORARY TRAFFIC CONTROL PLAN FIGURE 1	25
TEMPORARY TRAFFIC CONTROL PLAN FIGURE 2	26
TEMPORARY TRAFFIC CONTROL PLAN FIGURE 3	27

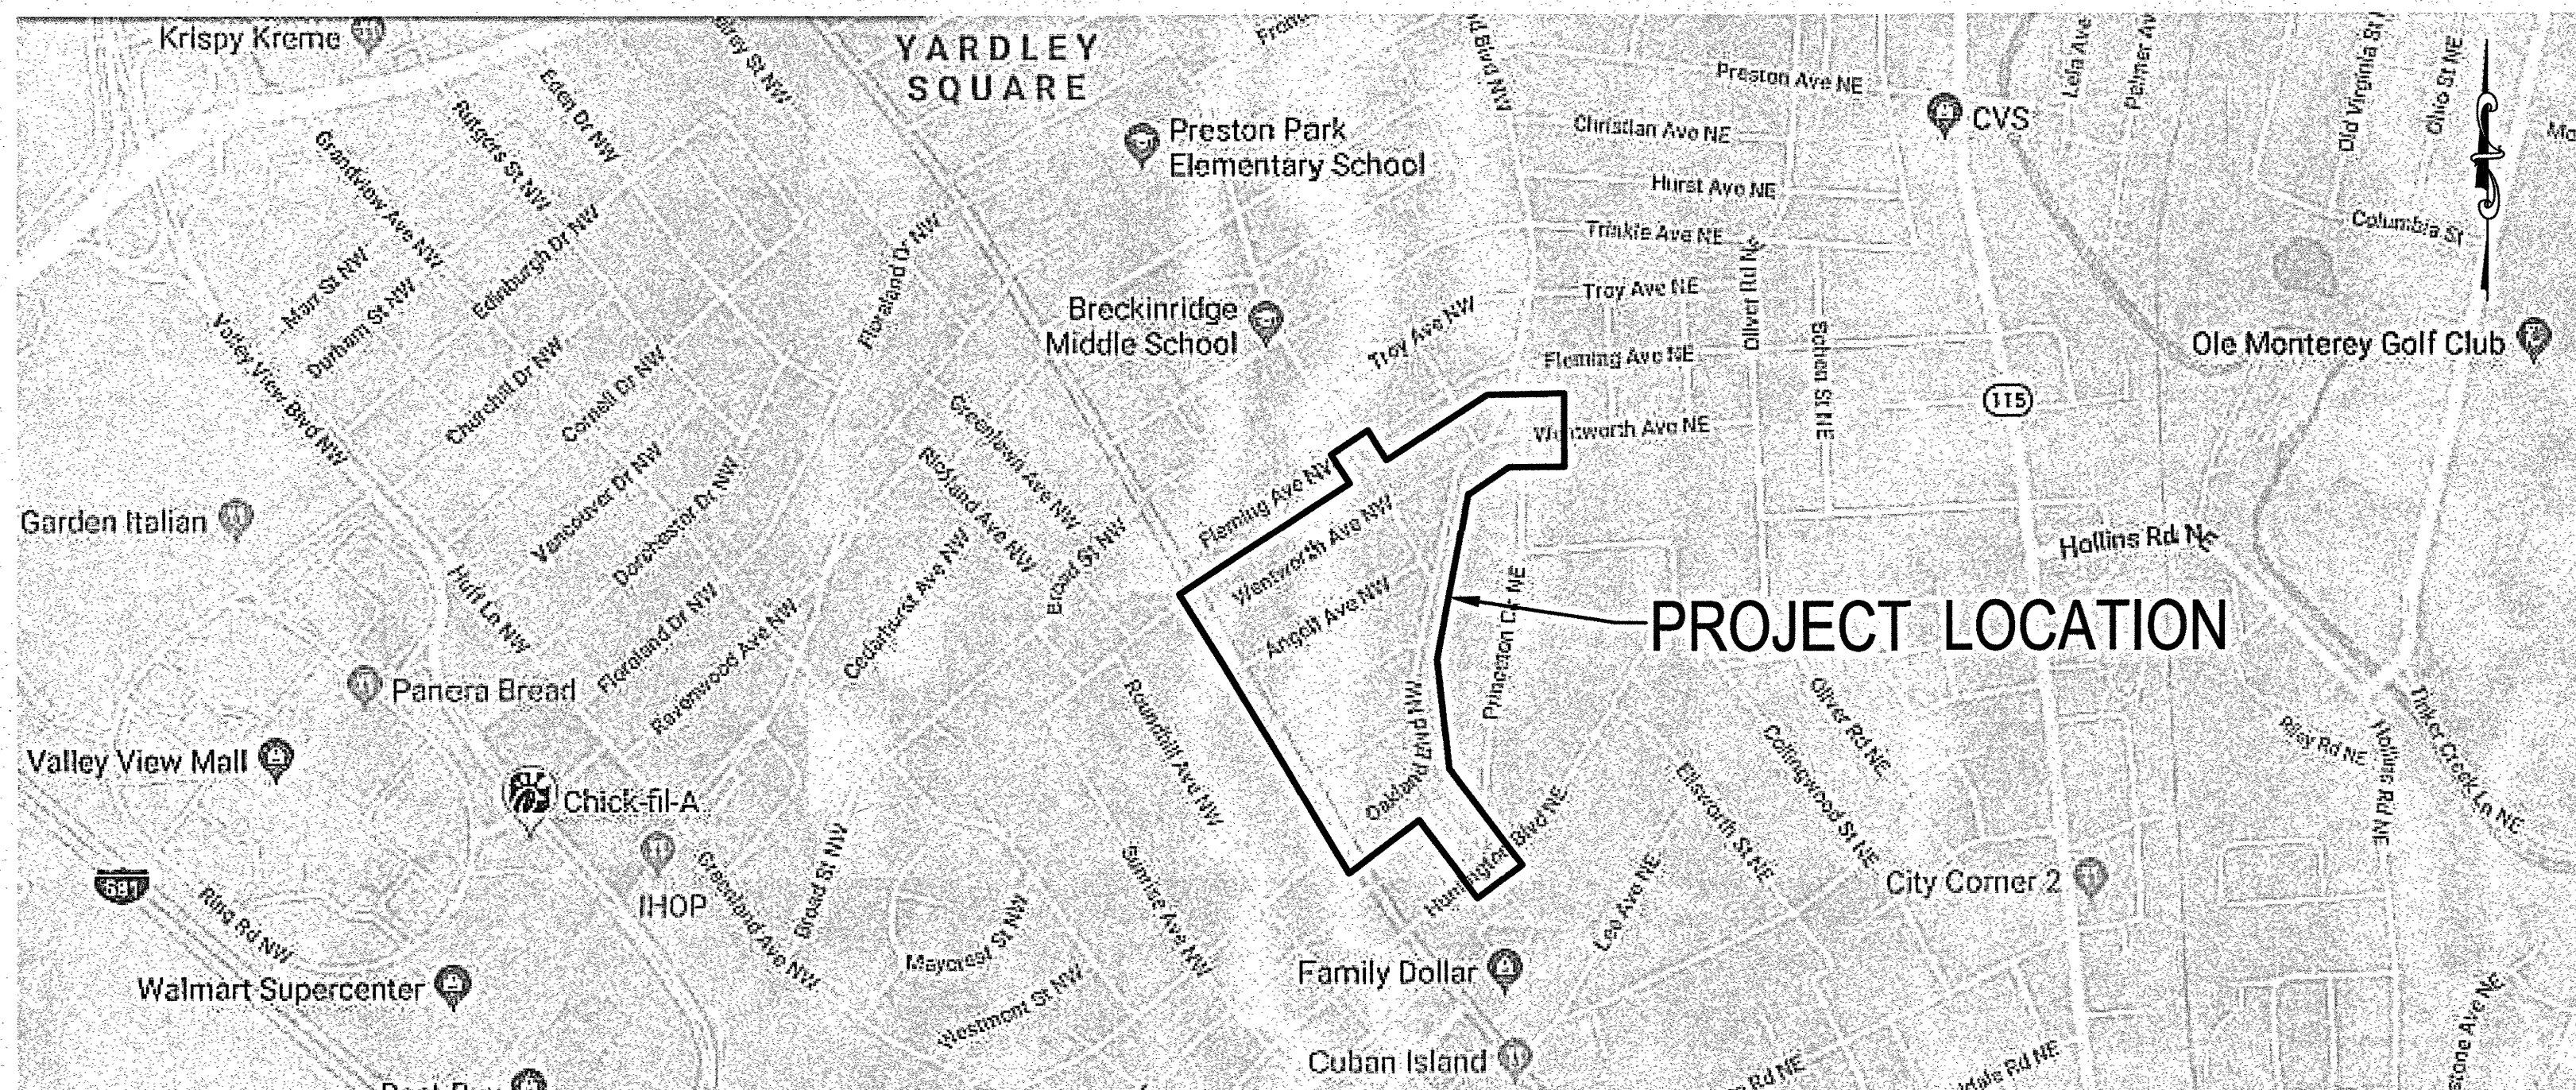

VICINITY MAP
NO SCALE

JULY 2019

CHARLES CRUSH
AS-BUILTS
02-07-2020

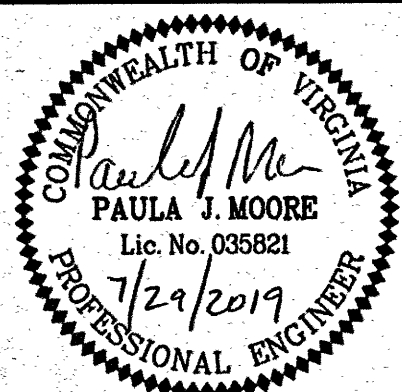

WESTERN VIRGINIA WATER AUTHORITY
601 South Jefferson Street, Suite 300
Roanoke, Virginia 24011

DES: PJM
DRAWN: DCA
CHECK: GWP
DATE: 7/29/19

SCALE: N/A
HORIZ: N/A
VERT: N/A

OAKLAND III
WATER MAIN REPLACEMENT

APPROVED FOR CONSTRUCTION

COVER

DRAWING

SHEET

1