

# ORNS OF COLONIAL - SEWER AS BUILTS

426-2003

LOTS

45' From MH

LENGTH - 13' with

LOT 4

2+33 TO TEE

LOT - 13'

LOT 3

97' TO TEE

LOT - 37'

LOT 2

66' TO TEE

LOT - 15'

LOT 1


From MH. 10'

LOT - 7'

T#157

easement

LOT 5

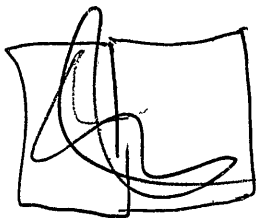

#3209  
T# 1570222

LOT 4

T# 1570221  
# 3207

2+33  
13'  
Not met

LOT 3

# 3205  
T# 1570220  
Not met

LOT 2

# 3203  
T# 1570219

66'  
15'  
Not met

LOT 1

# 3201  
T# 1570217

10'  
7'

COLONIAL AVE

just lateral connection.  
3/29/2001 from W. in the corner  
at Harland + Colonial  
still need water as built  
scanned linked