


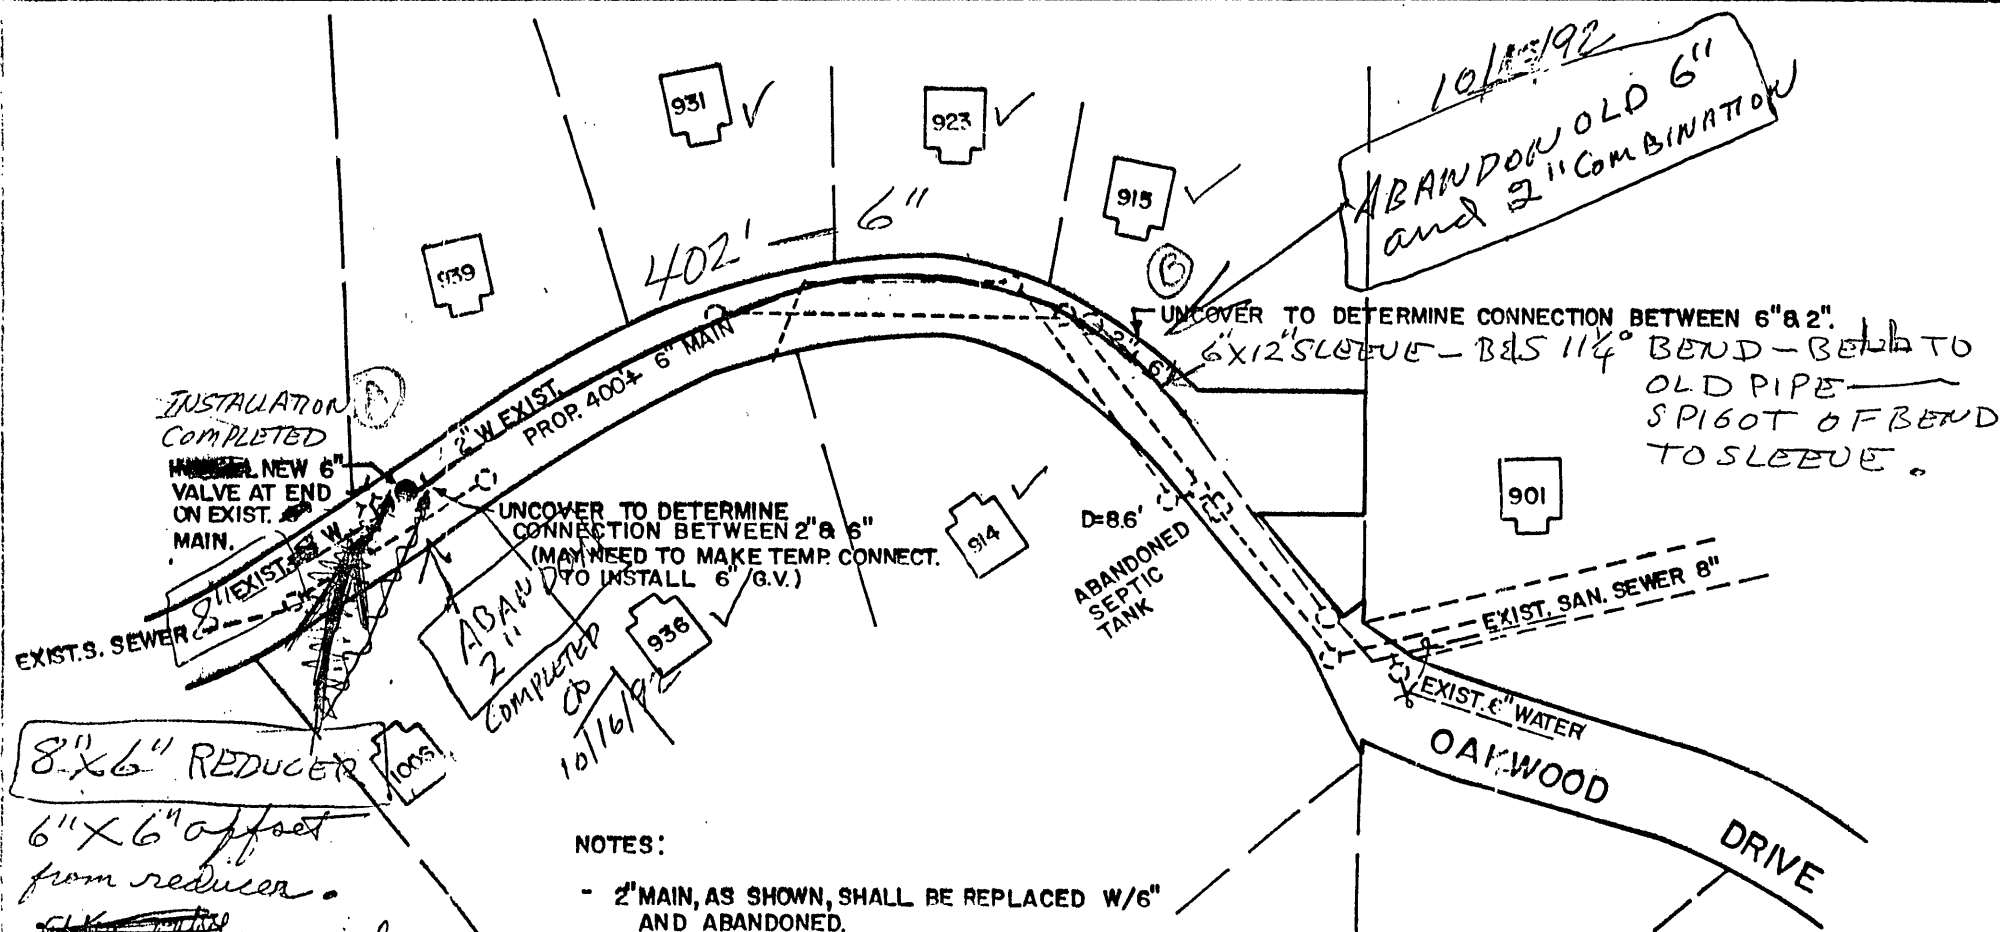

NOTES:

- 2" MAIN, AS SHOWN, SHALL BE REPLACED W/6" AND ABANDONED.
- ALL EXIST. UTILITIES SHALL BE ASCERTAINED IN THE FIELD PRIOR TO CONSTRUCTION.

*Job Completed
AS BUILT 10-15-92
C.O. Name*

[Signature]
MANAGER UTILITY LINE SERVICES

WATER DEPARTMENT
ROANOKE VIRGINIA

900 BLOCK OAKWOOD DRIVE, S.W.

SCALE 1" = 100'
DATE 9/25/92
PAGE 126
JOB NO 92-11

DATE STARTED 9/29/92			
DATE COMP. 10/15/92			
FEET MAIN	SIZE	VALVE	VAULT
402	6"	6"	X
CH. STUB ONLY			
SERV. INS. BY:			
MAIN INS. BY: C.O. Name			
NO. 1/4" SERV. INS. C.O. Name			
CITY OF ROANOKE			
DEPT. INSP.			

8" X 6" REDUCER

6" X 6" offset from reducer.

Check meter between H + valve