

| REVISIONS |      | DESCRIPTION |
|-----------|------|-------------|
| NO        | DATE |             |
| 1         |      |             |
| 2         |      |             |
| 3         |      |             |
| 4         |      |             |
| 5         |      |             |


DATE: July 16, 2022

SCALE: 1" = 30'

COMMISSION NO: 2018-262

SHEET 2 OF 2

**AS-BUILT  
SANITARY SEWER &  
WATER LINE PROFILES**

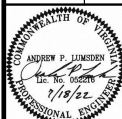

**Lumsden Associates, P.C.**  
ENGINEERS | SURVEYORS | PLANNERS

6884 BRAMBLETON AVENUE  
P.O. BOX 20669  
DANOKO, VIRGINIA 24018

PHONE: (540) 774-4411  
FAX: (540) 772-9445  
WWW.LUMSDENPC.COM