


HOLLINS ROAD
BAPTIST CHURCH

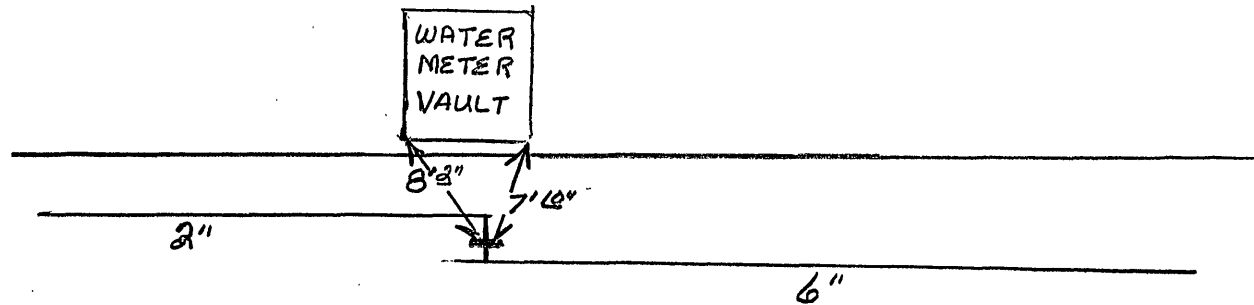

OLD MOUNTAIN RD.

#733 watermap