
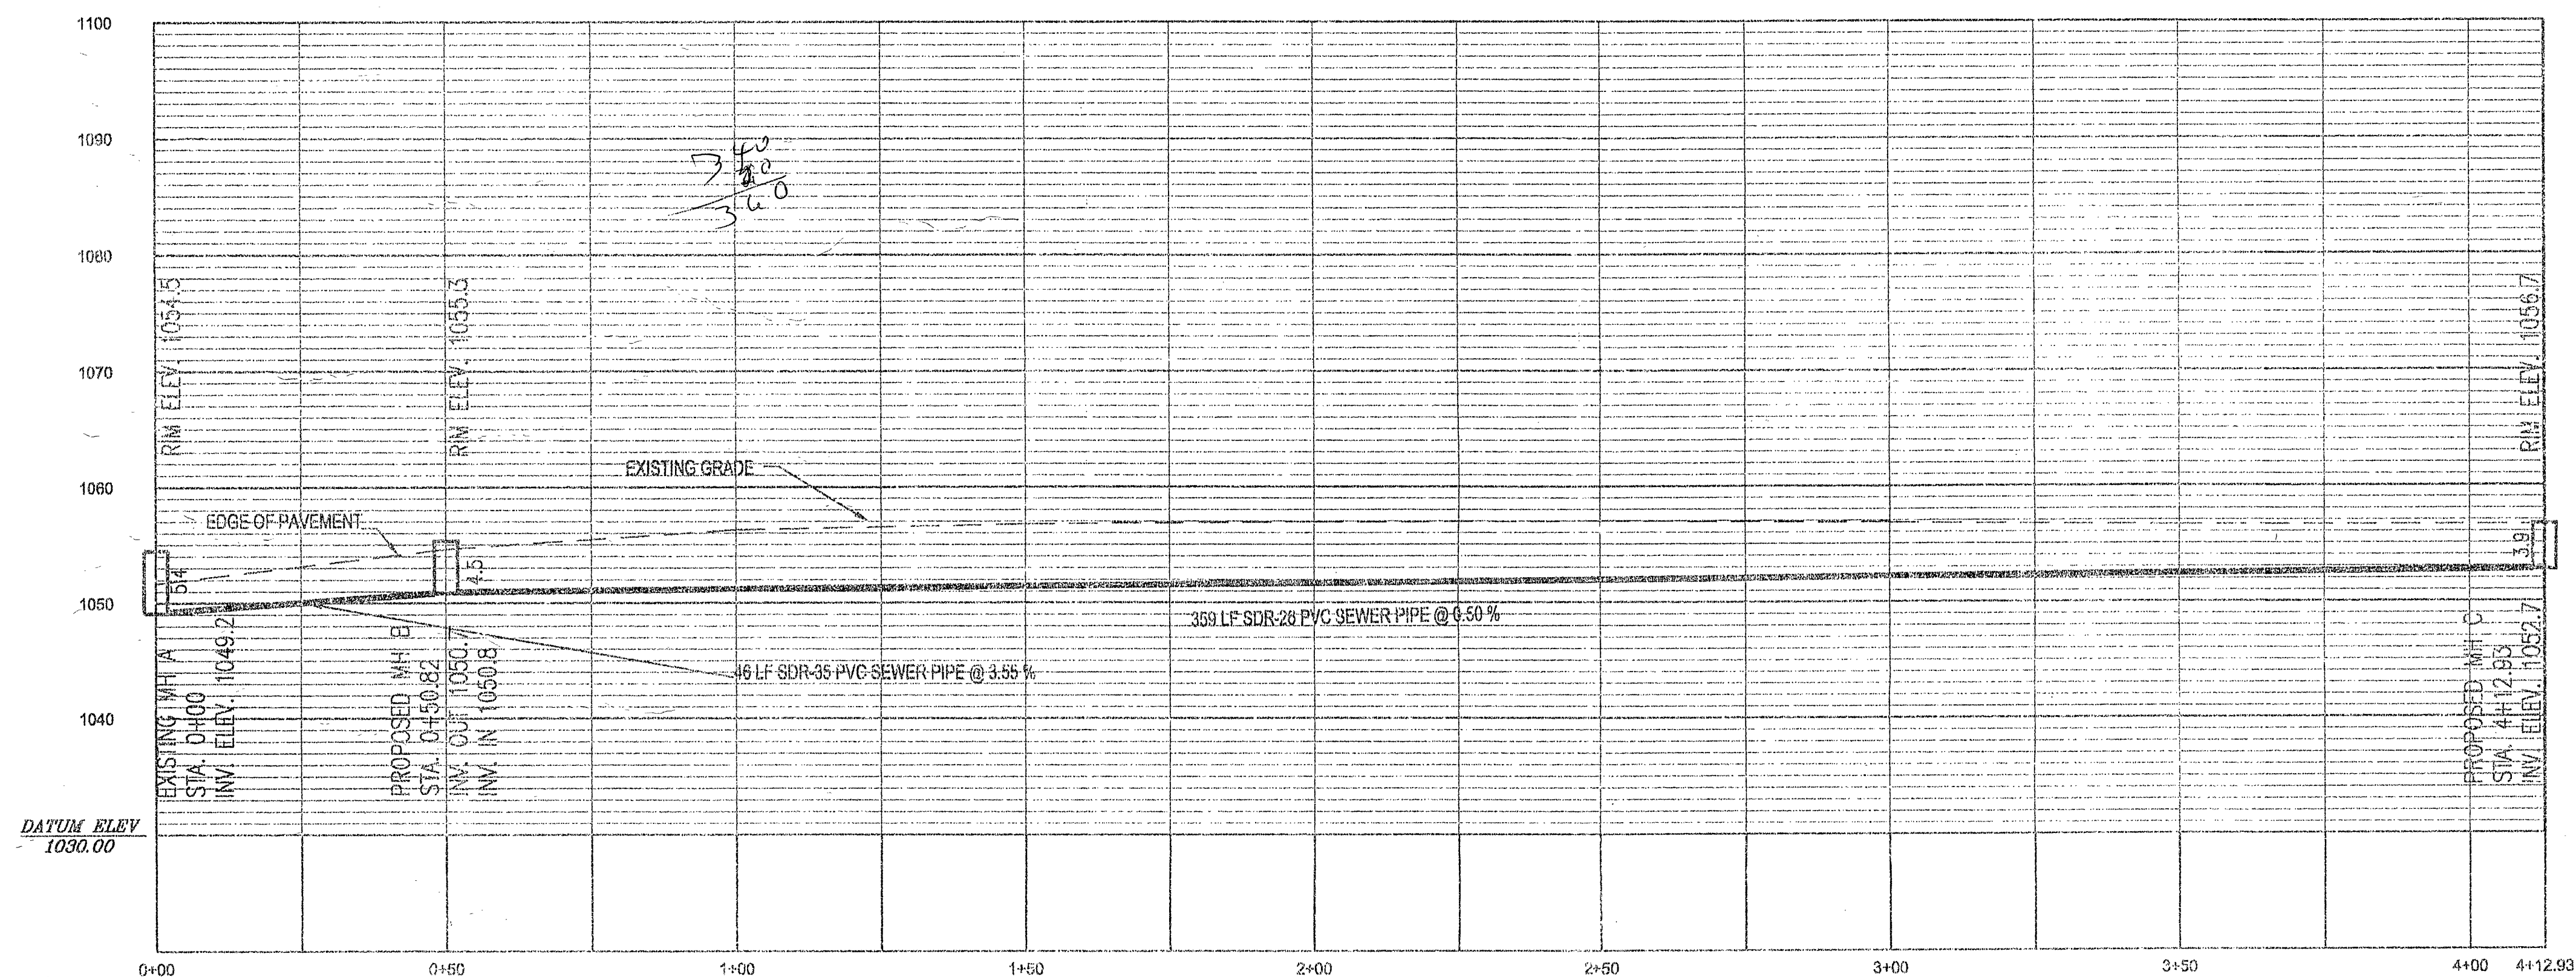


L. HUNTER
AS-BUILT

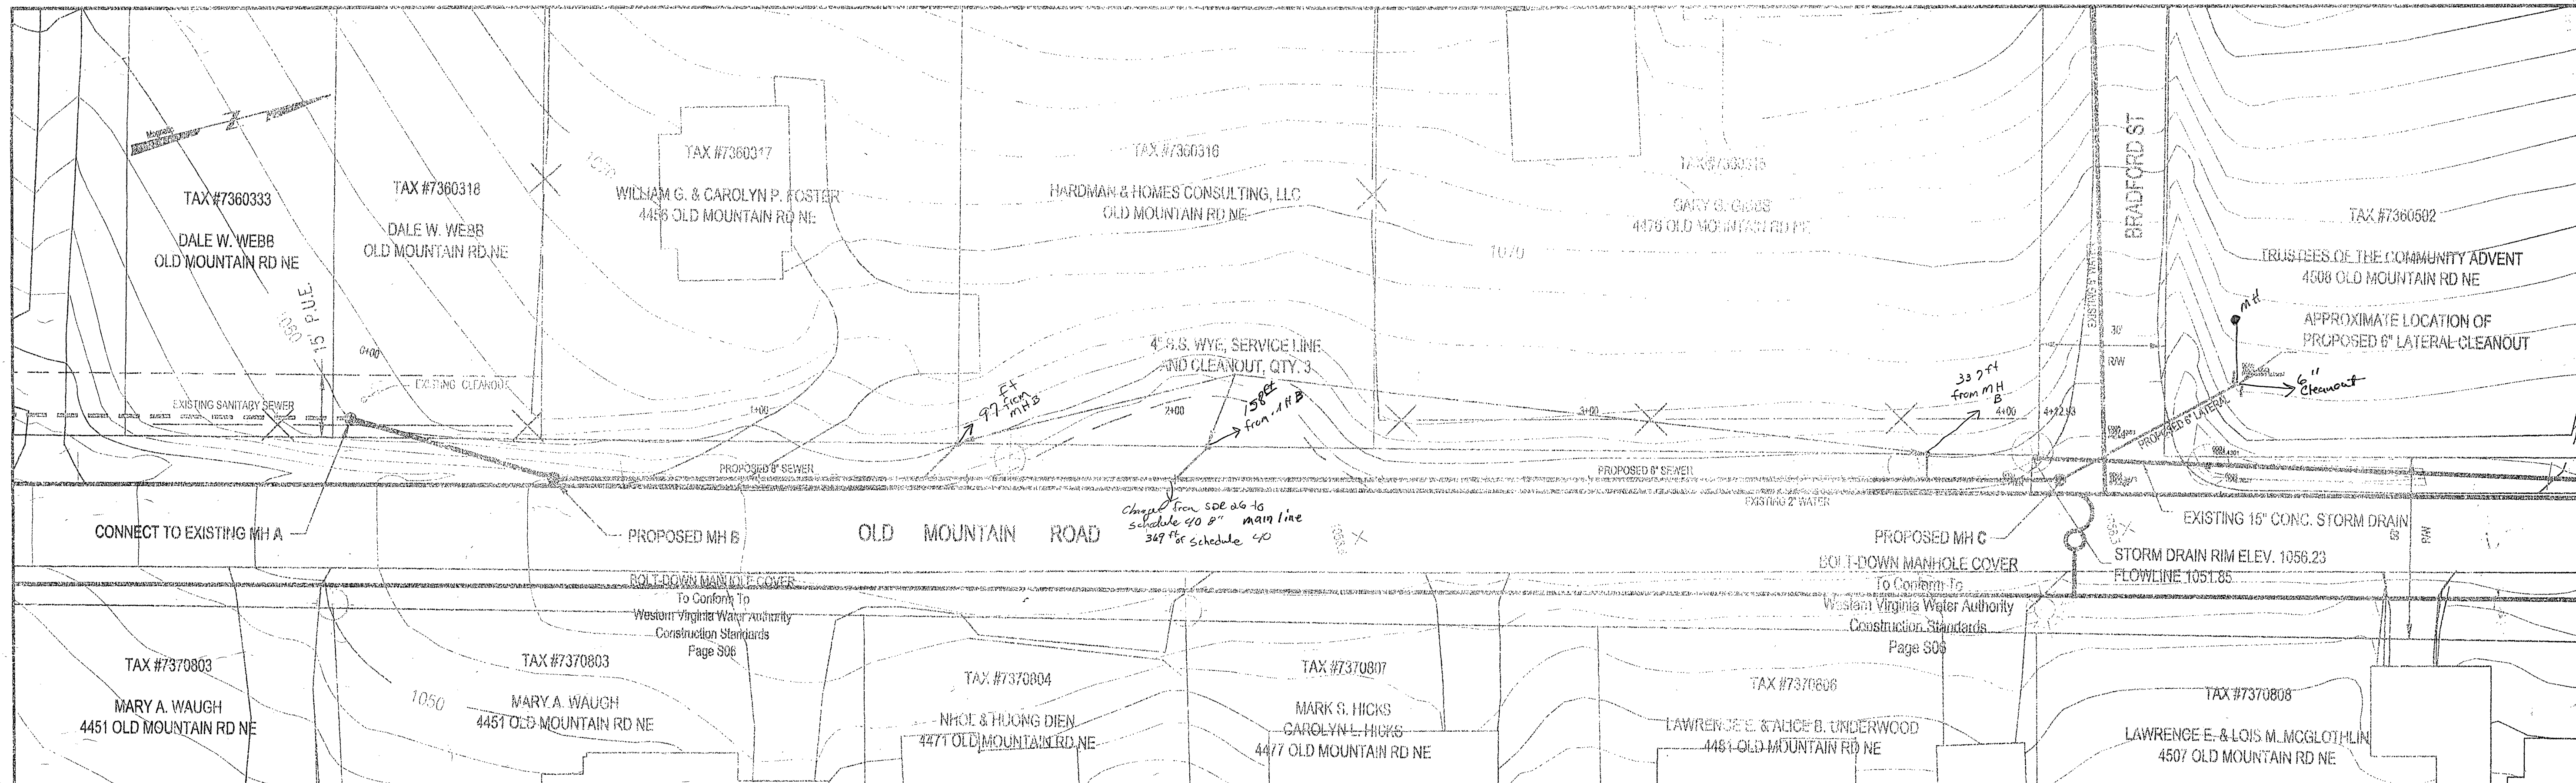

NOTES:

1. ALL WORK SHALL CONFORM TO WESTERN VIRGINIA WATER AUTHORITY DESIGN & CONSTRUCTION STANDARDS LATEST EDITION.

AS - BUILT

SCALE: HOR. 1 IN. = 20 FT.
VERT. 1 IN. = 10 FT.

Drawn By:	JAD
Designed By:	JAD
Checked By:	JGR
Date:	09/11/05
Scale:	AS NOTED
Plan #:	
Sheet:	1 OF 1

WVWA ID# 6GPKZY

Revised 9/29/05
WVWA DATABASE
ID# 6GPKZY