


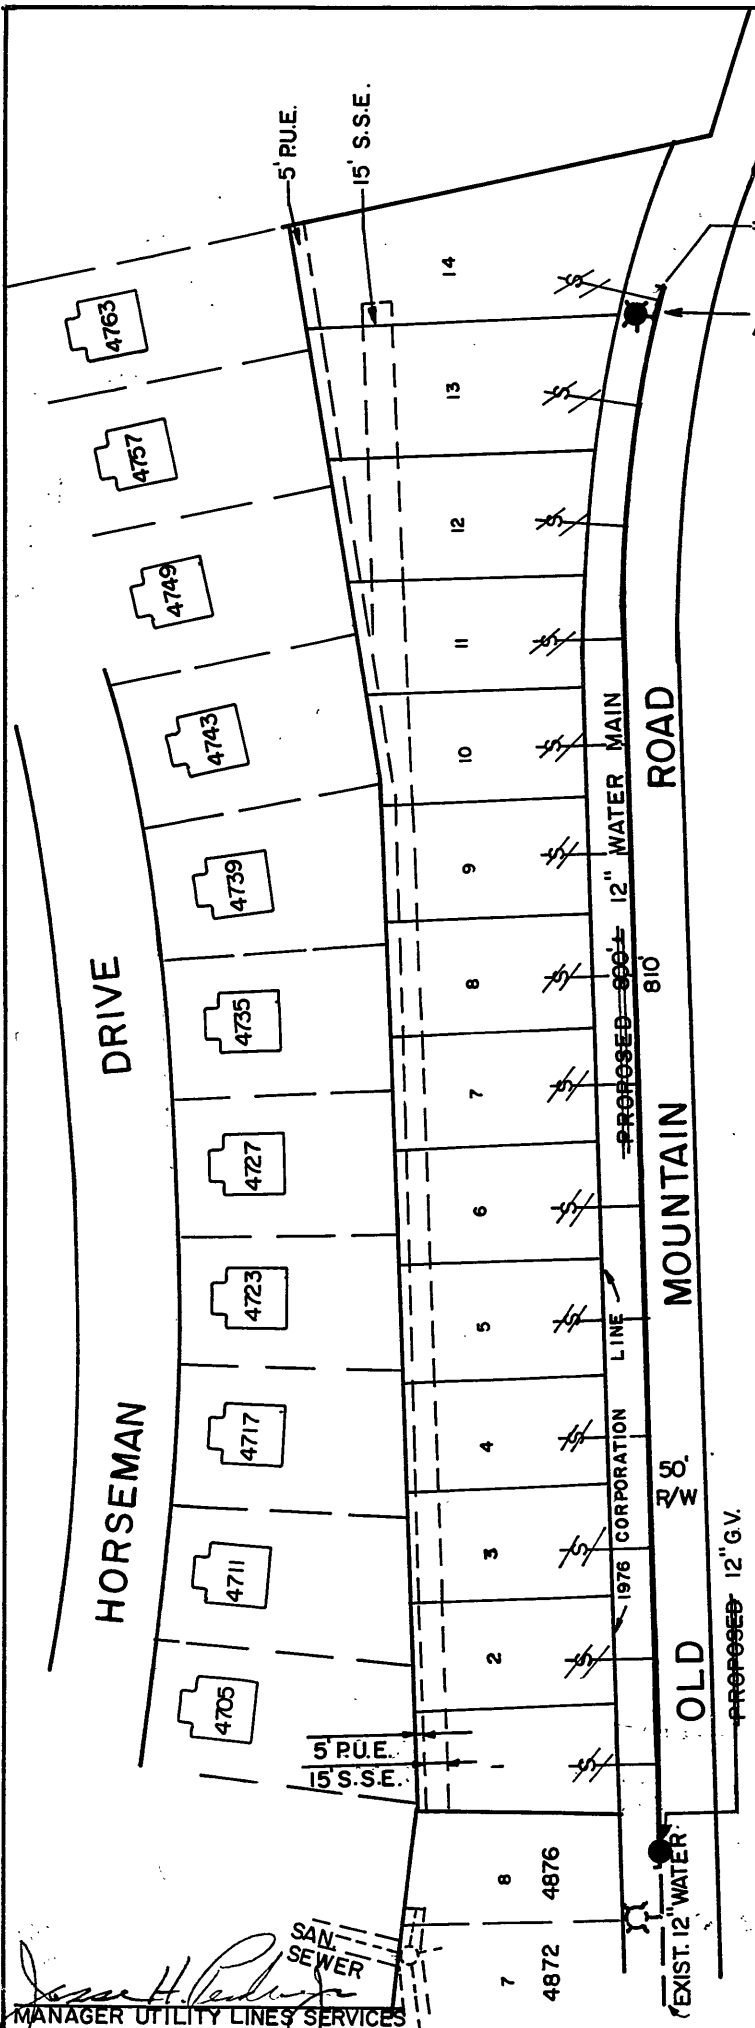

PROPOSED PLUG

INSTALL FIRE HYDRANT & ASSEMBLY

NOTE: ALL UTILITIES TO BE ASCERTAINED IN FIELD PRIOR TO CONSTRUCTION.

MAIN IS 18" OFF PVM'T.

DATE DESIGNED	9-11-91			
DATE COMPILED	9-17-91			
FEET MAIN	SIZE	VALVE/VAULT	BOX	
810'	12"	1	1	
F.H. COMP.	1	4 1/2"	6"	1
F.H. STUB ONLY				
SERV. INS. BY:				
MAIN INS. BY: C.O. DAME				
NO. 3/4" SERV. INS. 6				
CITY OR CO. CITY				
DEPT. INSP. ULS.				

WATER DEPARTMENT
ROANOKE VIRGINIA

OLD MOUNTAIN ROAD, N.E.
4900 BLOCK

SCALE: 1"=100'

DATE: 2-11-91

DIST. MAP: 741

PLAN NO.: 91-03

Int. B.L. 2/12/91
DIRECTOR UTILITIES & OPERATIONS (DATE)
William J. Clark 2/13/91
DIRECTOR OF PUBLIC WORKS (DATE)

James H. Pennington
MANAGER UTILITY LINES SERVICES