

DATE:	03-08-02
REVISIONS	08-08-02
	As-Builts

PIERSON
ENGINEERING
&
SURVEYING



P.O. BOX 311
1324 ROANOKE ROAD
DALEVILLE, VA 24083

(540) 966-3027 TEL
(540) 966-5906 FAX
e-mail: rpierson@bnet.com

WATERLINE PROJECT
FOR
PARSELL & ZEIGLER DEVELOPMENT CORPORATION
ROANOKE COUNTY, VIRGINIA

PLAN SHEET

COMMONWEALTH OF VIRGINIA
8-8-02
RODERICK F. PIERSON
Professional Engineer
NO. 023842
COMMISSION
R9989
SHEET
SH2W
NO. 2 OF 5

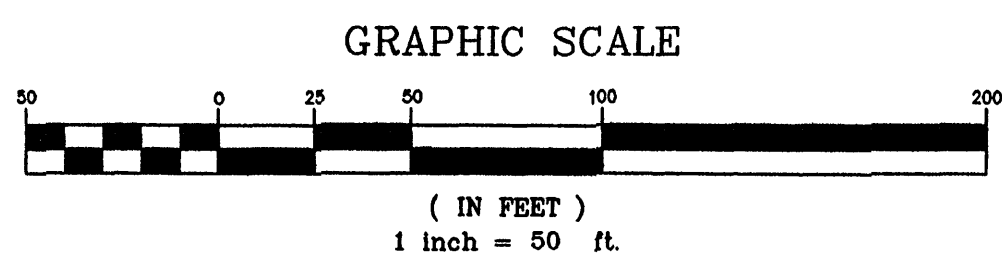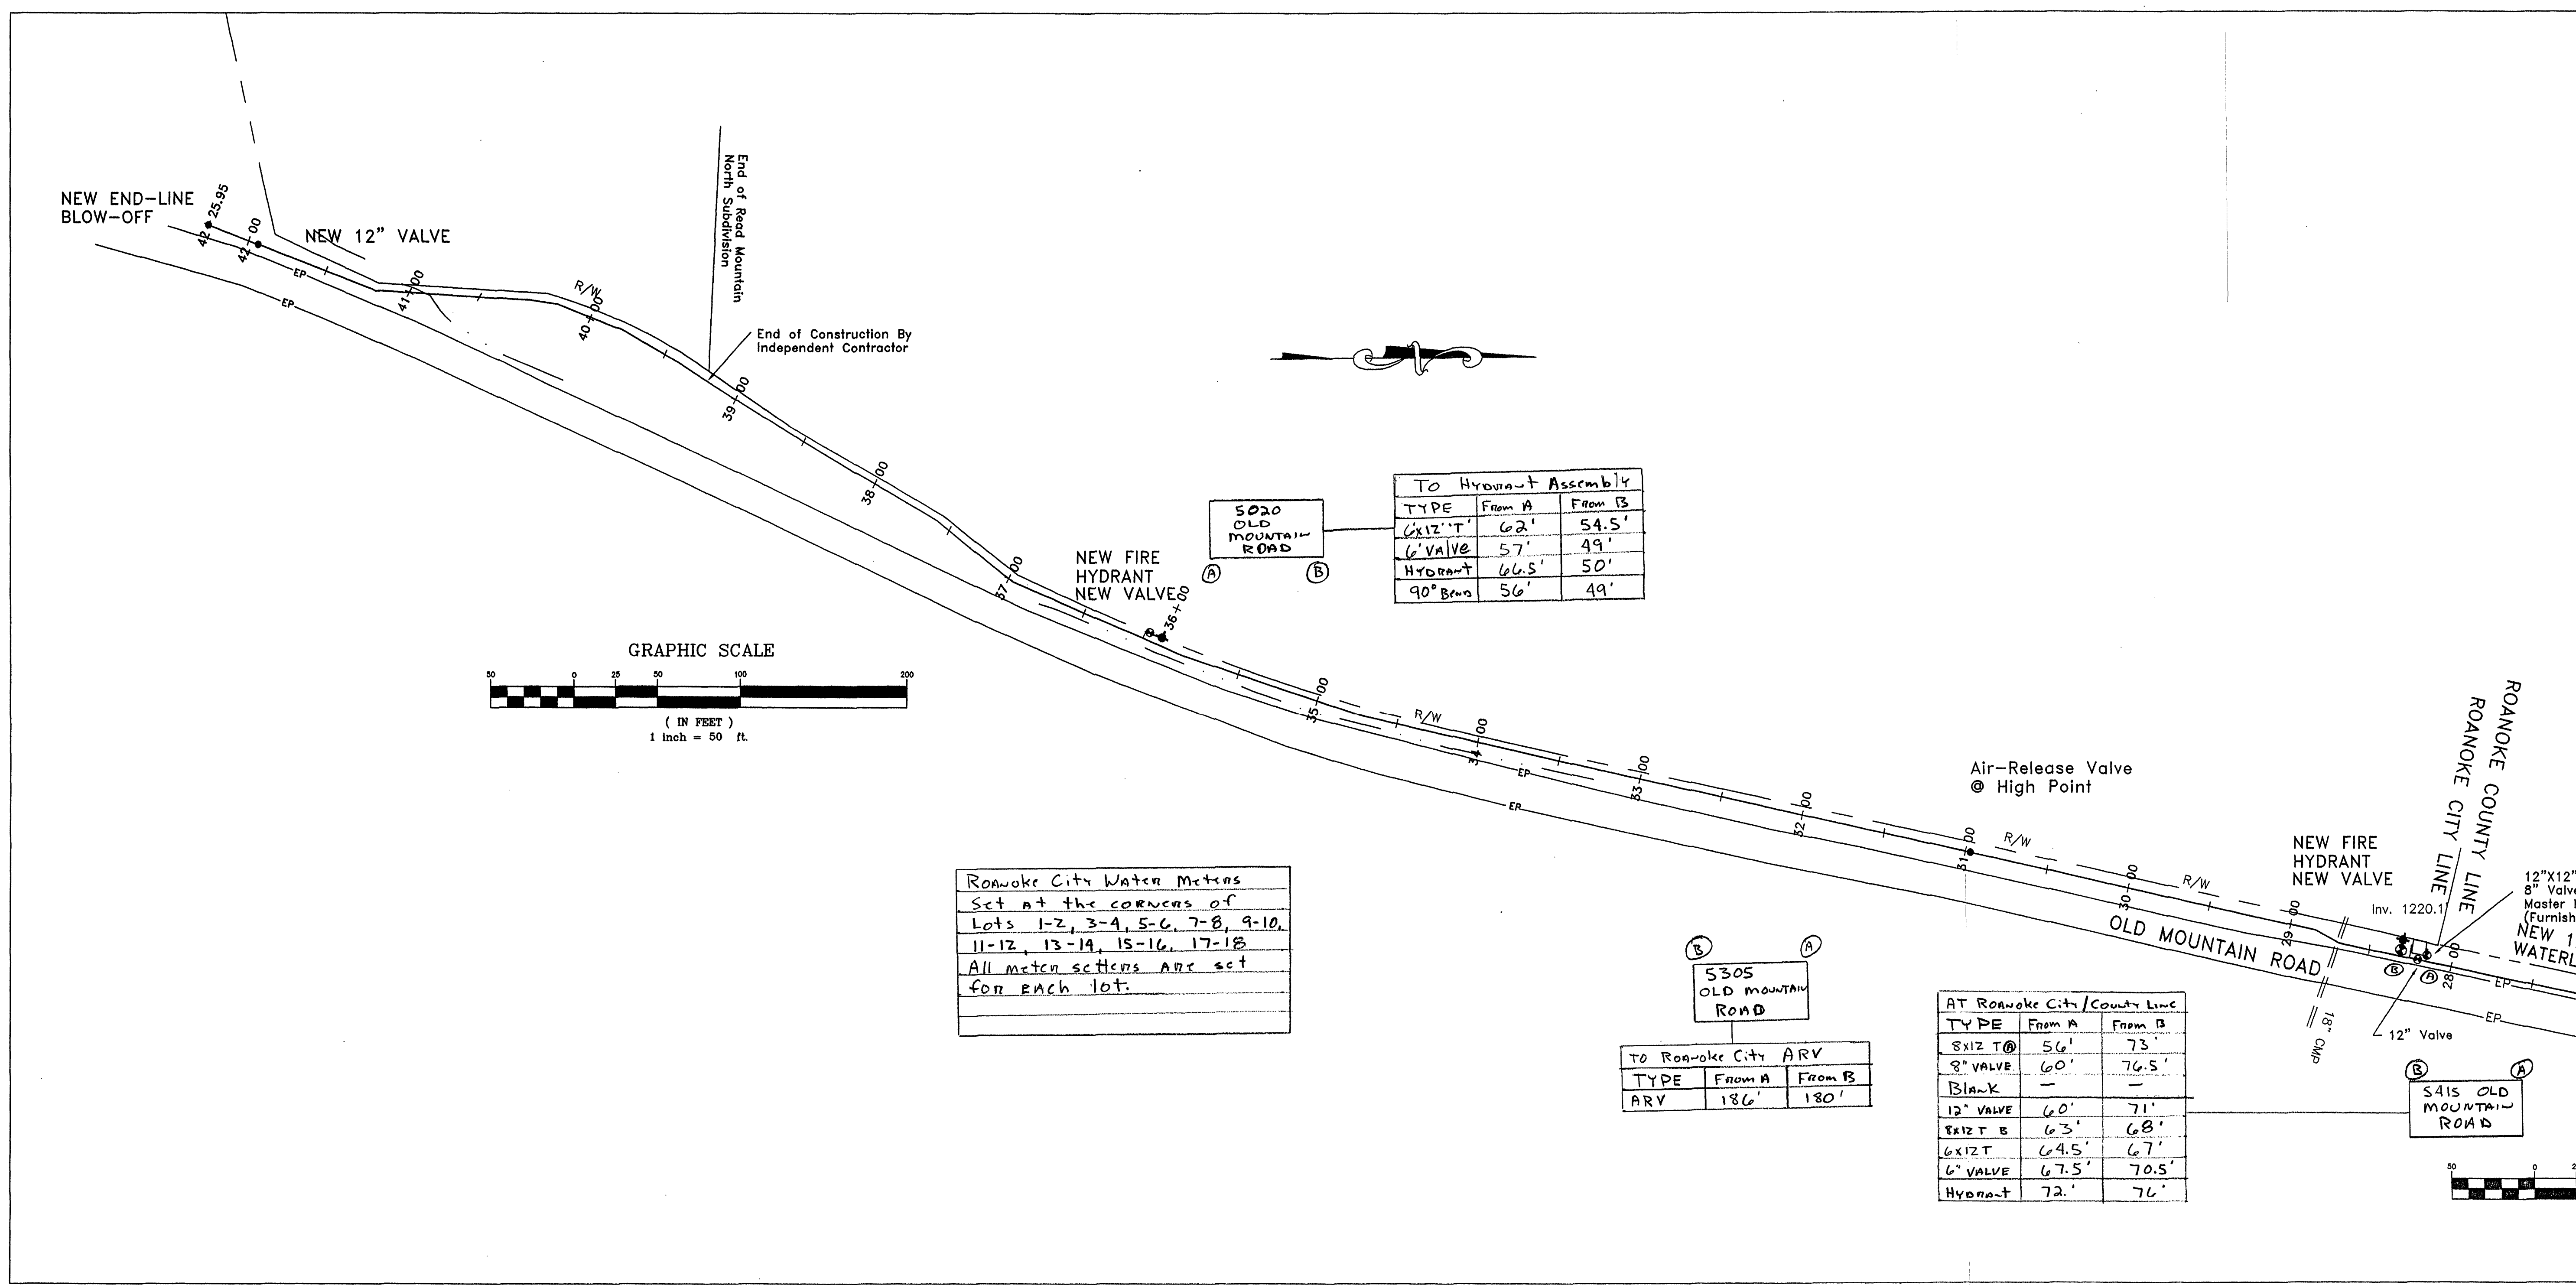

Roanoke City Water Meters
Set at the corners of
Lots 1-2, 3-4, 5-6, 7-8, 9-10,
11-12, 13-14, 15-16, 17-18
All meter settings are set
for each lot.

TO Hydrant Assembly

TYPE	From A	From B
6"x12" T	62'	54.5'
6" VALVE	57'	49'
Hydrant	66.5'	50'
90° Bend	56'	49'

5305 OLD MOUNTAIN ROAD

TYPE	From A	From B
ARV	186'	180'

AT Roanoke City / County Line

TYPE	From A	From B
8"x12" T	56'	73'
8" VALVE	60'	76.5'
Blank	-	-
12" VALVE	60'	71'
8"x12" B	63'	68'
6"x12" T	64.5'	67'
6" VALVE	67.5'	70.5'
Hydrant	72'	76'

