
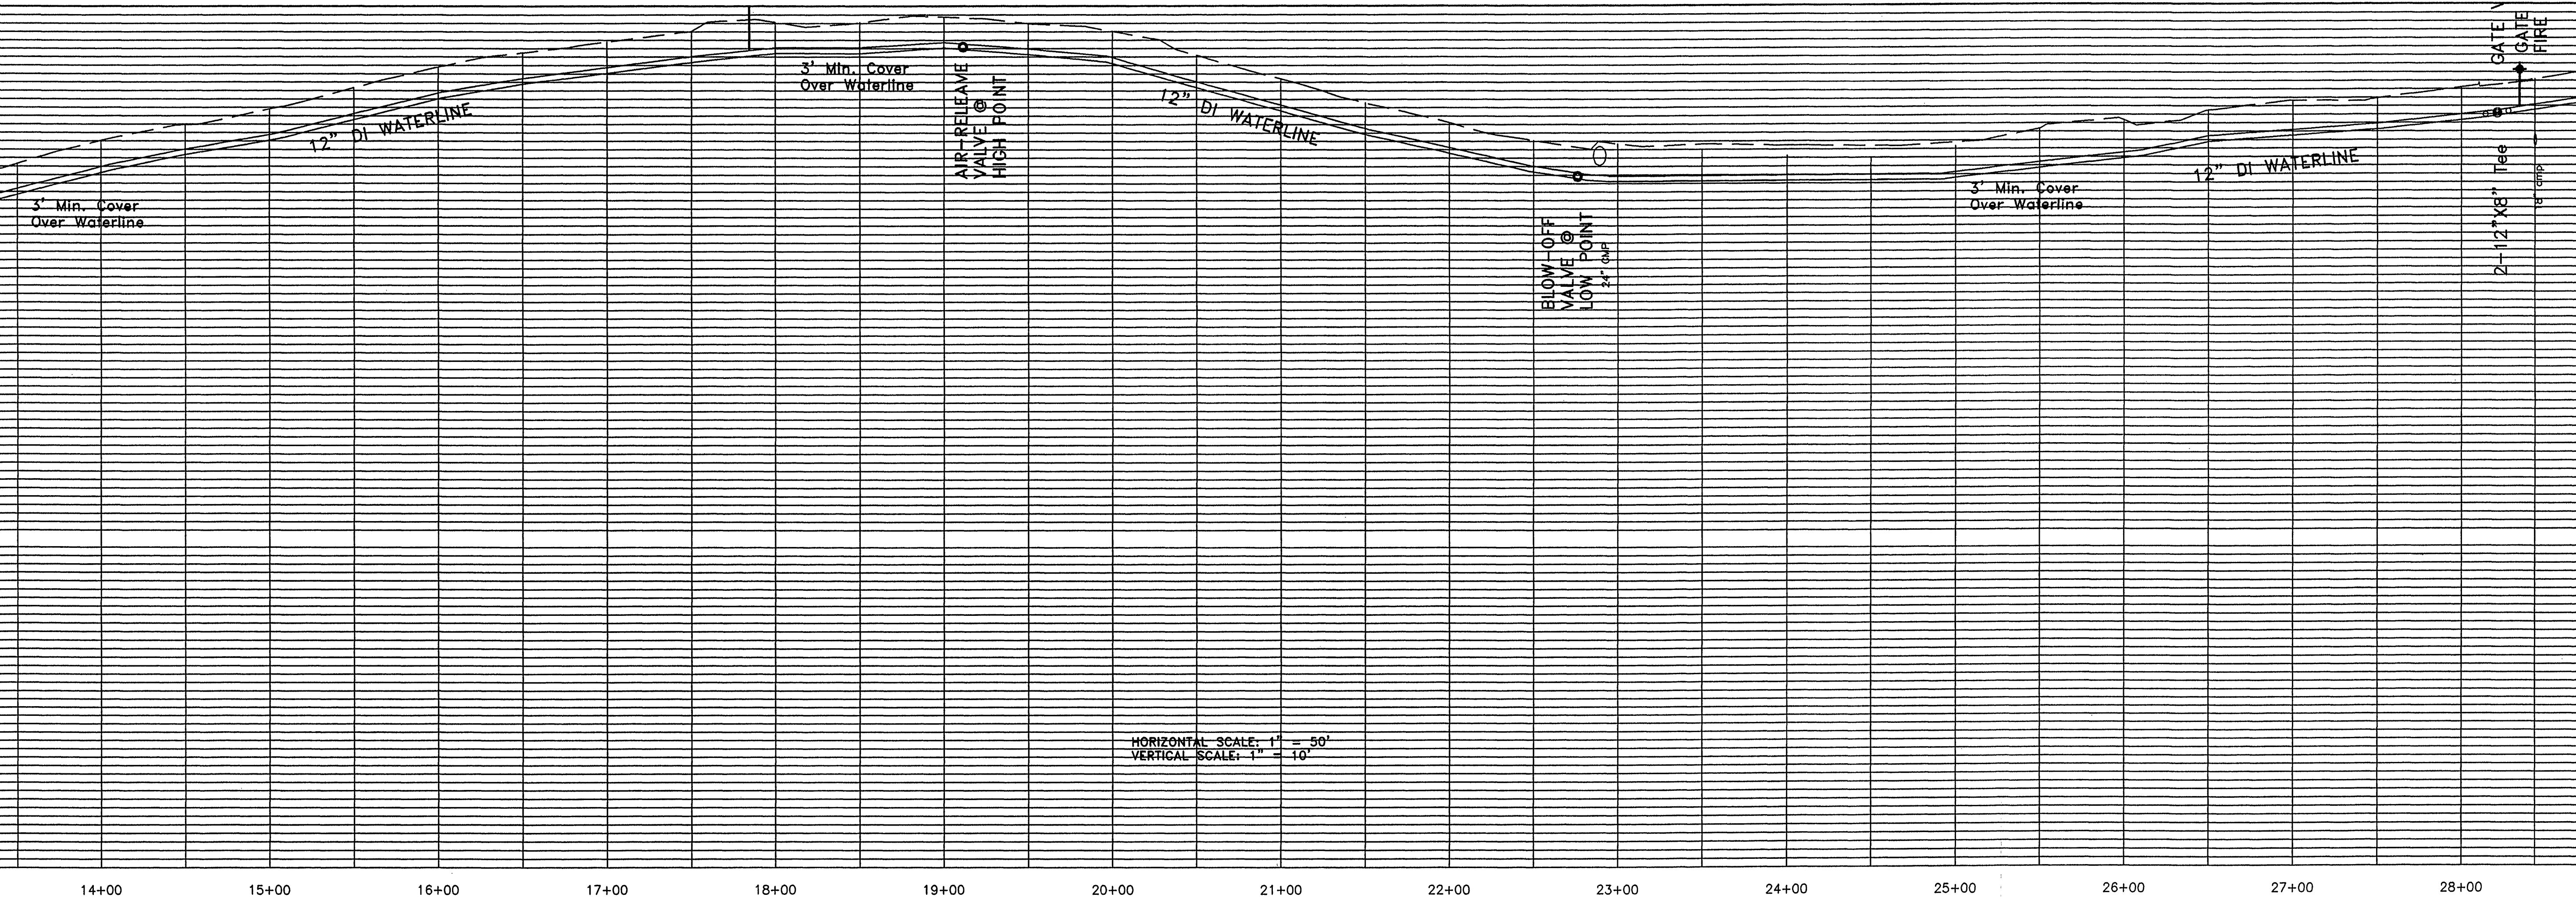


CONTRACTOR TO MAKE CONNECTION
TO EXISTING WATERLINE
COORDINATE THROUGH ROANOKE COUNTY.

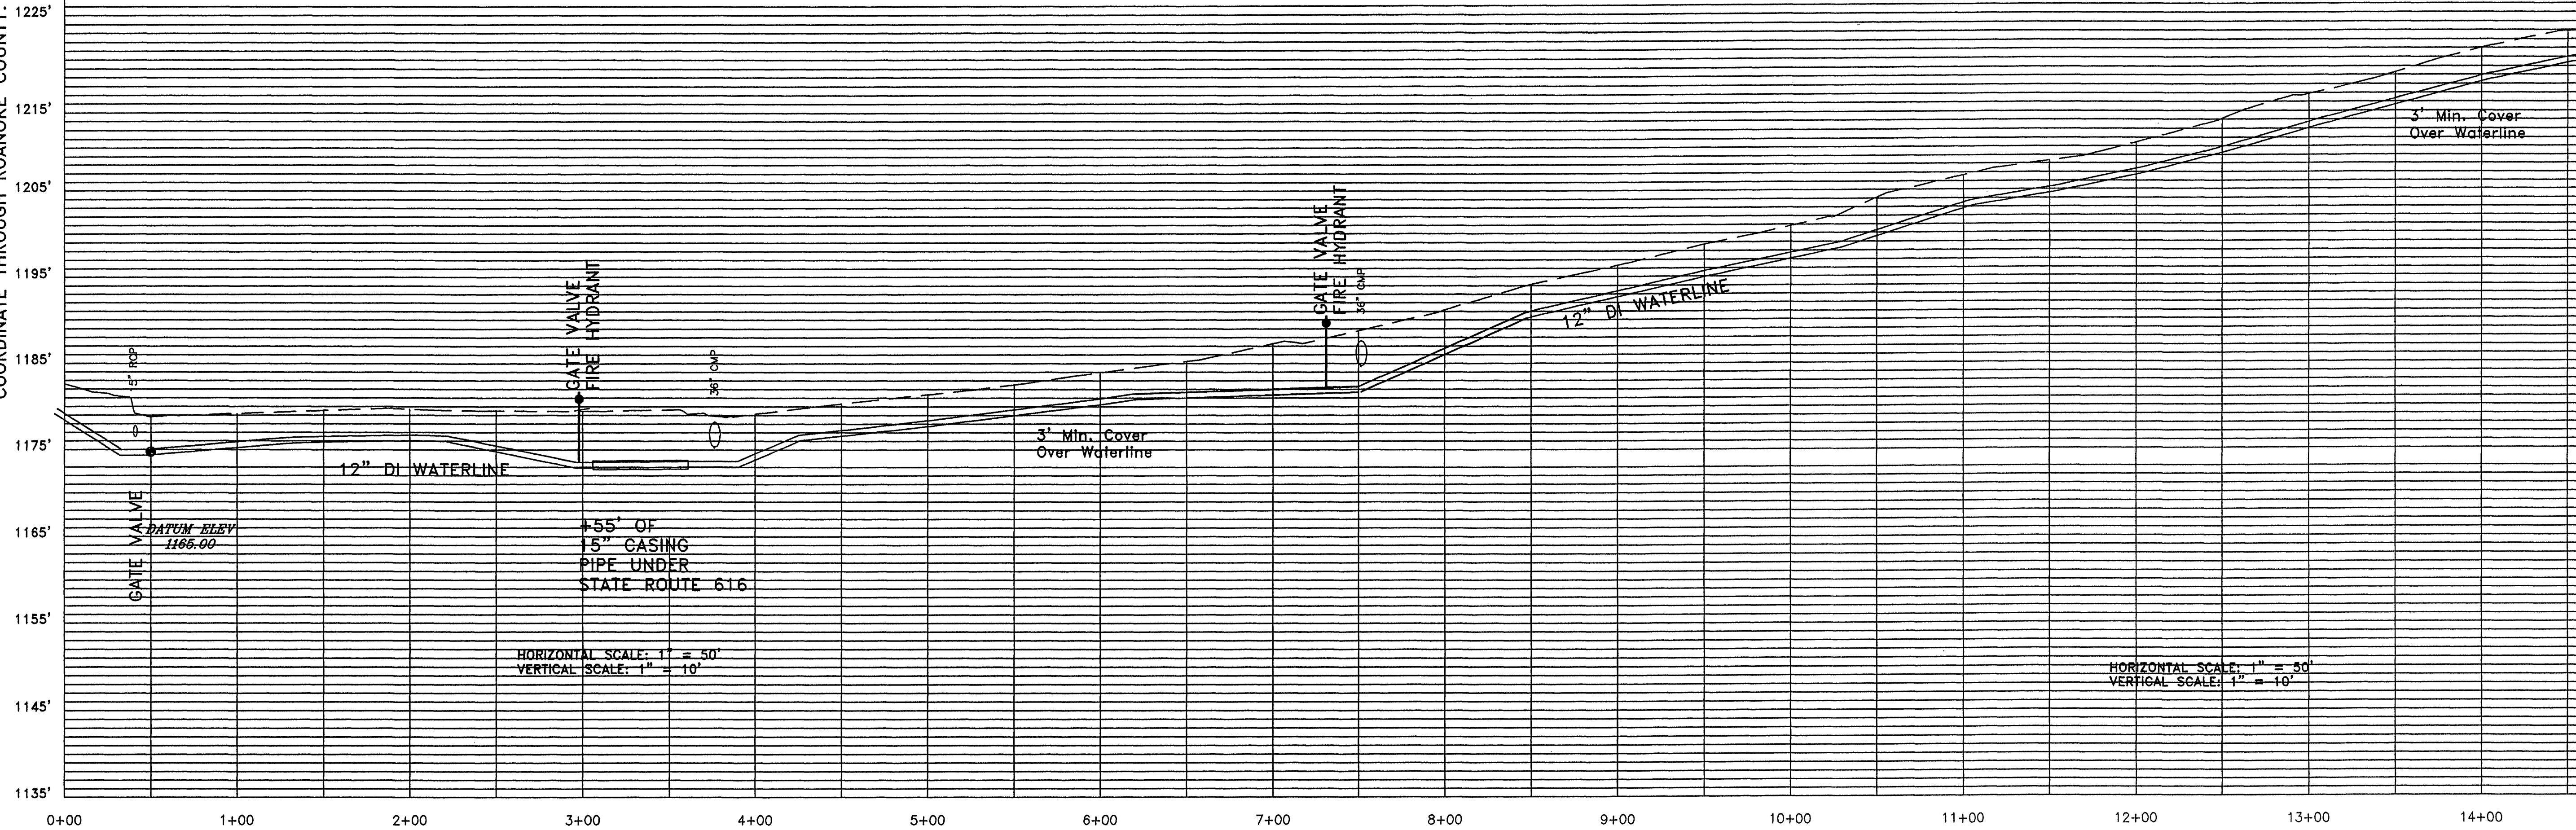

DATE:	03-08-02
REVISIONS	08-08-02
	As-Built


PIERSON
ENGINEERING
&
SURVEYING

P.O. BOX 311
1324 ROANOKE ROAD
DALEVILLE, VA 24083

(540) 966-3027 TEL
(540) 966-5906 FAX
e-mail: rpierson@bnet.com

WATERLINE PROJECT
FOR
PARSELL & ZEIGLER DEVELOPEMENT CORPORATION
ROANOKE COUNTY, VIRGINIA

PROFILE SHEET

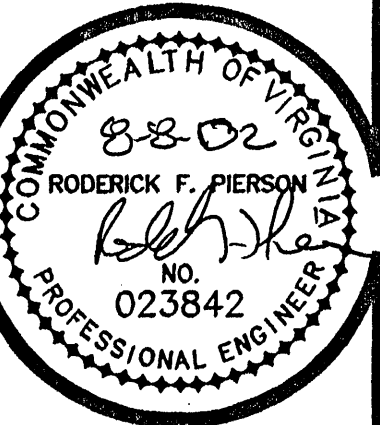

COMMISSION
R9989

SHEET
SH3W

NO. 3 OF 5