


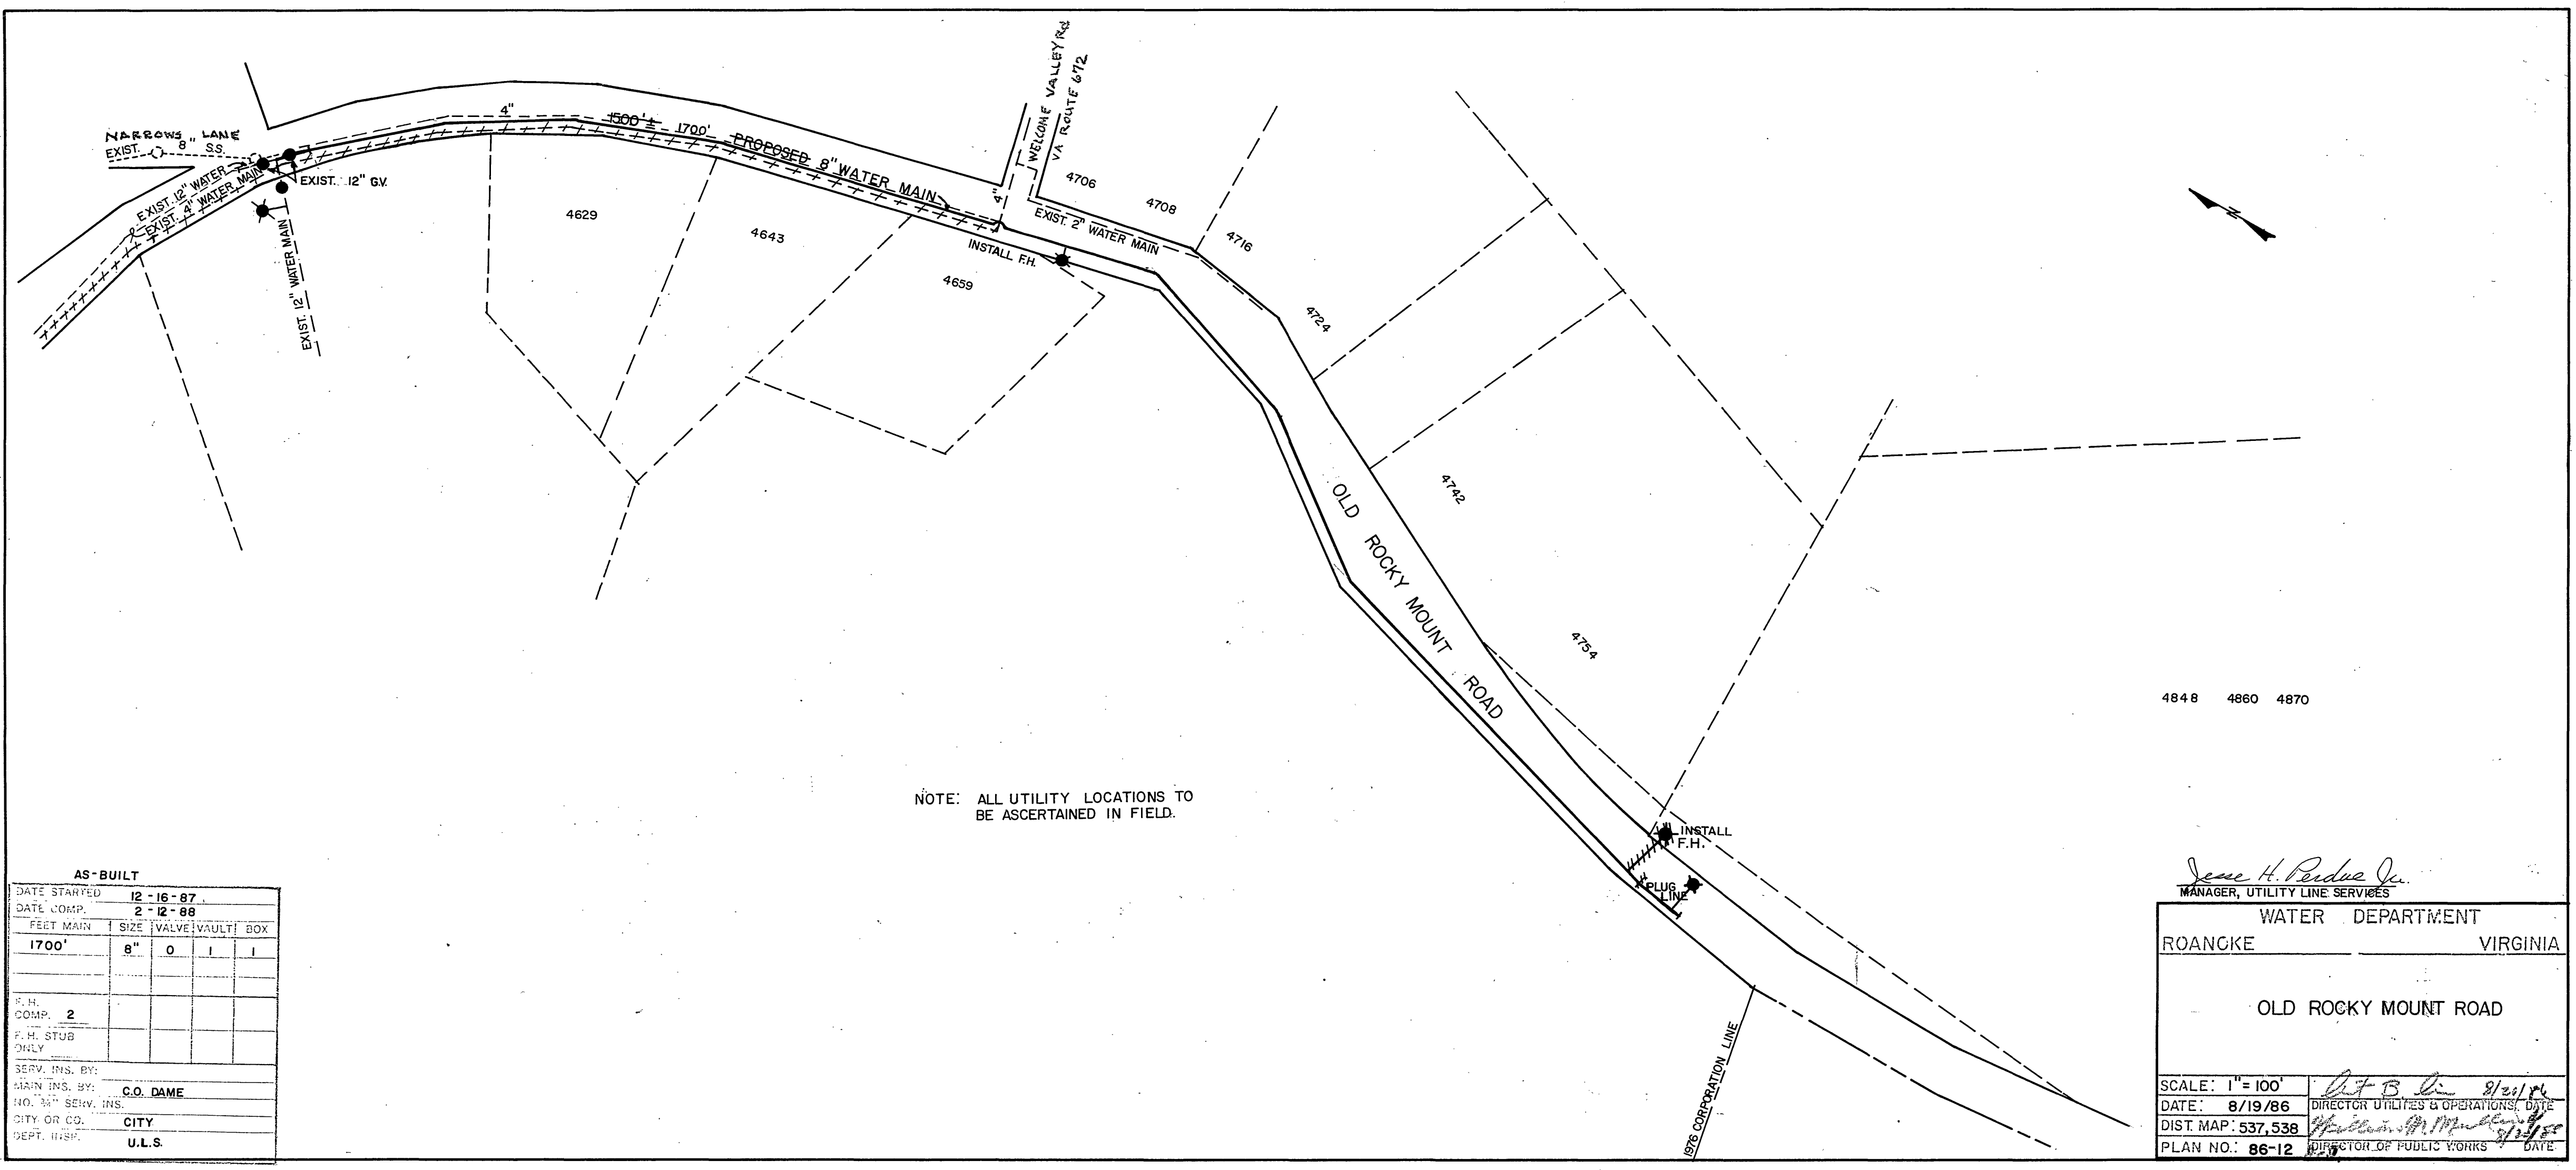

NOTE: ALL UTILITY LOCATIONS TO BE ASCERTAINED IN FIELD.

AS-BUILT					
DATE STARTED		12 - 16 - 87			
DATE COMP.		2 - 12 - 88			
FEET MAIN	SIZE	VALVE	VAULT	BOX	
1700'	8"	0	1	1	
F.H. COMP. 2					
F.H. STUB ONLY					
SERV. INS. BY: C.O. DAME					
NO. 3/4" SERV. INS.					
CITY OR CO.		CITY			
DEPT. INSP.		U.L.S.			

4848 4860 4870

James H. Perdue Jr.
MANAGER, UTILITY LINE SERVICES

WATER DEPARTMENT
ROANKE VIRGINIA

OLD ROCKY MOUNT ROAD

SCALE: 1"=100'	<i>ATB lin 8/20/86</i>
DATE: 8/19/86	DIRECTOR UTILITIES & OPERATIONS, DATE
DIST. MAP: 537,538	<i>William M. ...</i>
PLAN NO.: 86-12	DIRECTOR OF PUBLIC WORKS DATE